


- I. CONCRETE FOR COLLAR WILL NOT BE PAID FOR DIRECTLY, BUT WILL BE CONSIDERED SUBSIDIARY TO THE VARIOUS OTHERS BIDS.
- 2. CONCRETE SHALL BE 5 SACK 3000 PSI

PIPE COLLAR DETAIL

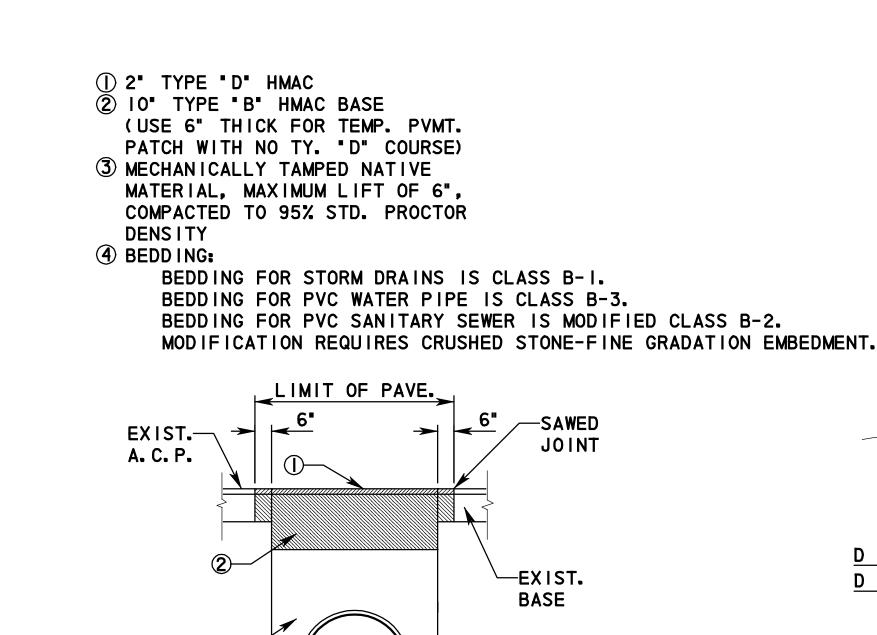

ASPHALT PAVEMENT

CUT AND RESTORE PAVEMENT DETAILS STRUCTURE EXCAVATION (TRENCH)

-LIMITS OF

TRENCH EXCAV.

VARIES 3

D = 42" & LESS 1'-0" D = ABOVE 42" 2'-0"


CLASS "C" BEDDING EXCEPT AS NOTED

\*SEE STANDARD SPECIFICATION ITEM 400, EXCEPT WHERE NEGATIVE PROJECTION IS USED.

## RECORD DRAWING

This drawing is a compilation of the original sealed engineering drawing and modifications by addenda, change orders and information furnished by the contractor. Information shown that was provided by the contractor and others not associated with the design engineer cannot be verified for accuracy or completeness. Original sealed drawing is on file at the office of AECOM Technical Services, Inc., TBPE REG. NO. F-3580

ORIGINAL DRAWING SEALED & SIGNED BY T.H. Gaertner, P.E. TX NO. 37124

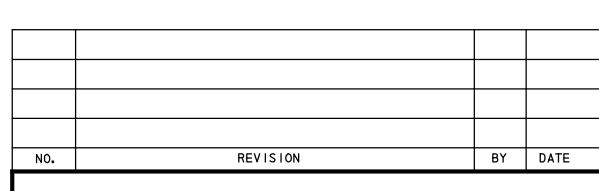

AIRPORT ROAD

MISCELLANEOUS DRAINAGE DETAILS



City of Rockwall, Texas

**AECOM** 

Designed

AECOM TECHNICAL SERVICES, INC. 16000 DALLAS PARKWAY, SUITE 350 DALLAS TEXAS 75248 WWW.AECOM.COM TBPE REG. NO. F-3580

 PW-DAL
 Scale:
 Horz: AS SHOWN Vert: AS SHOWN
 Date
 8/2/2012

 SB
 Checked
 THG
 Project No. 60004153

 FG
 Approved
 THG
 Sheet
 21 of 26

\\usdal|fp002\PW\4328\Airport\_Road\CADD\Sheet\Airport Road\_Record 8/7/2012