



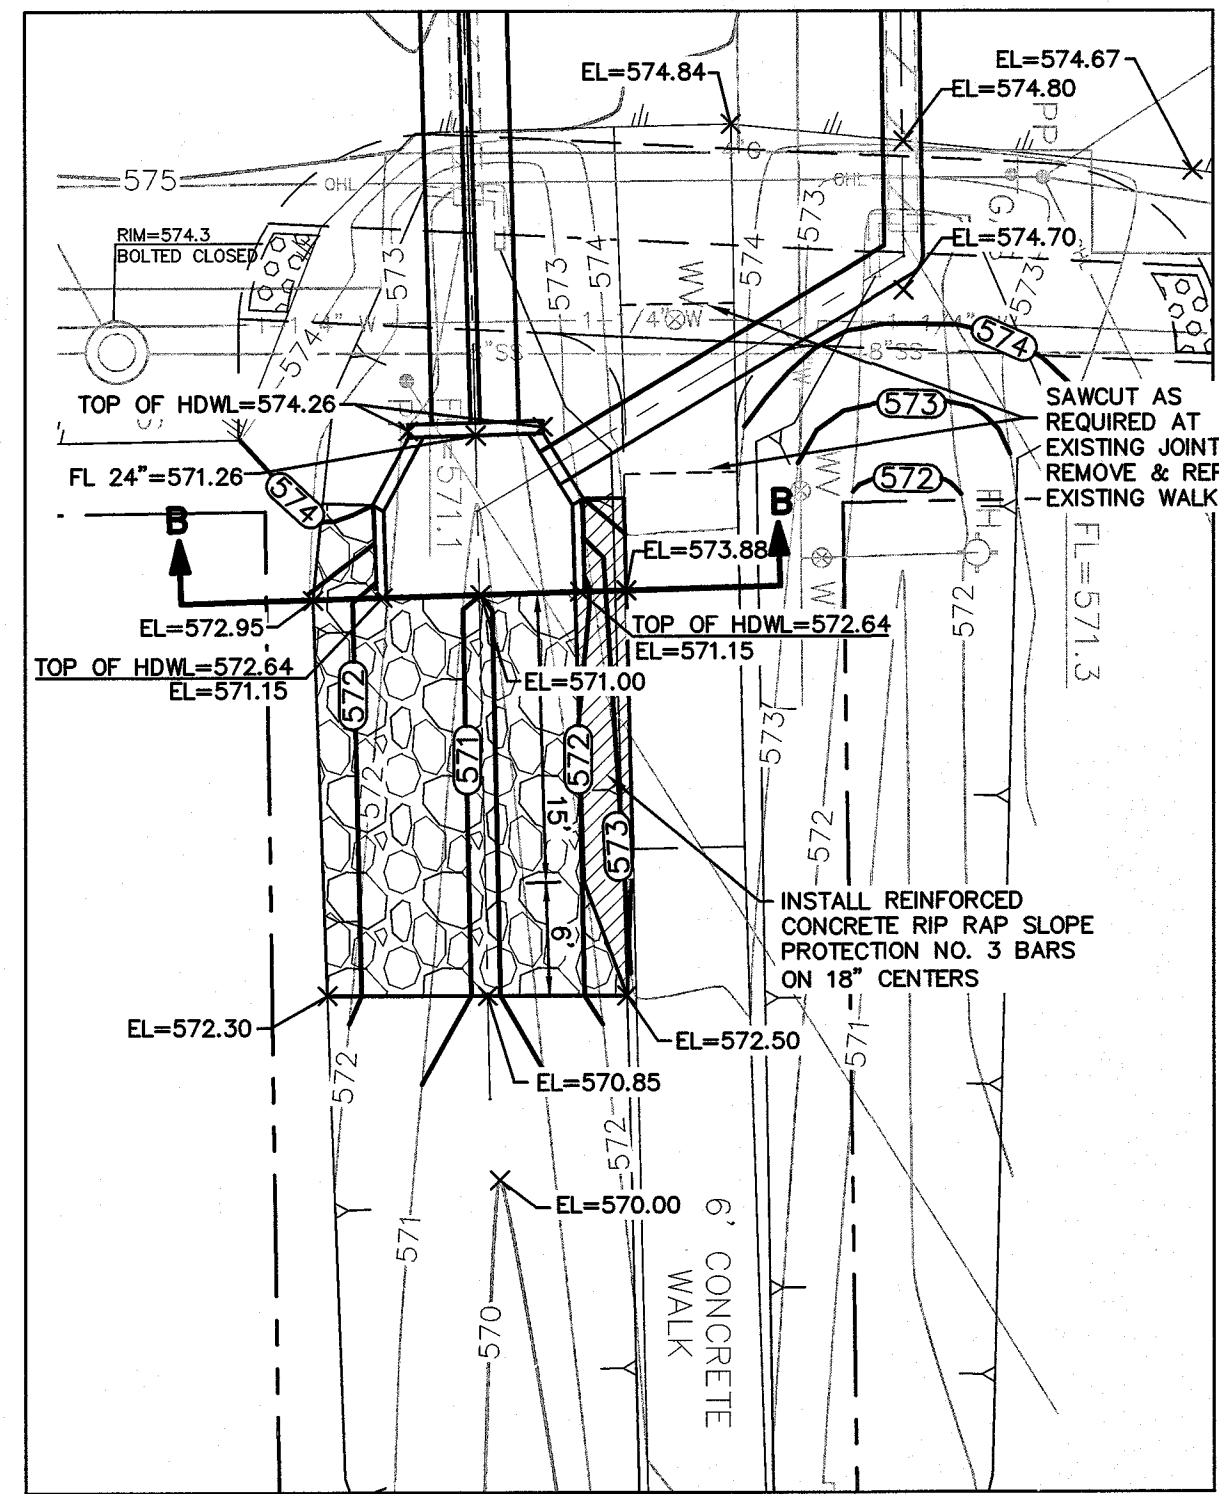

PLAN VIEW
SCALE 1"=10'

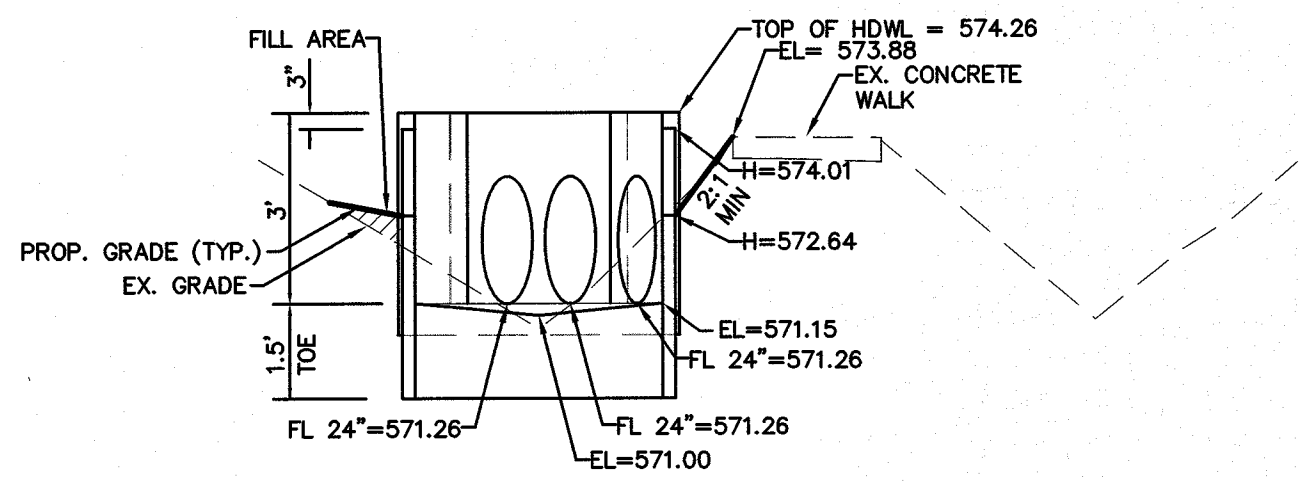

SECTION B-B


3 HEADWALL PLAN & SECTION

NOT TO SCALE

LEGEND			
B.	BOLLARD	FL	FLOOD LIGHT
EM	ELECTRIC METER	FP	FLAG POLE
PP	POWER POLE	SIGN	TRAFFIC SIGN
LS	LIGHT STANDARD	IRS	1/2-INCH IRON ROD
WM	WATER METER	W/PACHECO KOCH" CAP SET	
WV	WATER VALVE	(C.M.)	CONTROLLING MONUMENT
ICV	IRRIGATION CONTROL VALVE	---	PROPERTY LINE
FH	FIRE HYDRANT	---	FENCE
CU	CLEANOUT	---OHL---	OVERHEAD UTILITY LINE
MH	MANHOLE	---	UNDERGROUND ELECTRIC LINE
TSC	TRAFFIC SIGNAL CONTROL	---	UNDERGROUND TELEPHONE LINE
TSP	TRAFFIC SIGNAL POLE	---	UNDERGROUND CABLE LINE
TELE	TELEPHONE BOX	---6" W---	UNDERGROUND WATER LINE
		---6" SS---	UNDERGROUND SANITARY SEWER LINE

BENCH MARK LIST

BM# 1	"+" SET IN BOX ON CURB INLET ON NORTHWEST CORNER OF ALAMO ST. AND GOLIAD ST.	ELEV=574.54
BM# 2	"+" SET IN BOX ON BACK OF CURB ON SOUTH SIDE OF A CURB RETURN TO A PARKING LOT ON EAST SIDE OF FANNIN ST. ±7 FEET SOUTH OF OLIVE ST.	ELEV=573.63
BM# 3	"+" SET IN BOX ON SOUTH WEST CORNER OF GOLIAD ST. AND KAUFMAN ST. ±40 FEET WEST OF C. OF GOLIAD ST. AND ±25 FEET SOUTH OF C. OF KAUFMAN	ELEV=587.41
BM# 4	"+" SET IN BOX ON NORTH EAST CORNER OF N. FANNIN ST. AND KAUFMAN ST. ±15 FEET NORTH OF C. OF KAUFMAN ST. AND ±30 FEET EAST FROM C. OF KAUFMAN ST.	ELEV=578.80
BM# 5	"+" SET IN BOX ON NORTH WEST CORNER OF WASHINGTON ST. ON GOLIAD ST. ±40 FEET WEST OF C. OF GOLIAD ST. AND ±25 FEET NORTH OF C. OF WASHINGTON ST.	ELEV=595.39
BM# 6	"+" SET IN BOX SOUTH EAST CORNER OF WASHINGTON ST. AND FANNIN ST. ±22 FEET OF C. OF FANNIN ST. AND ±45 FEET SOUTH OF C. OF WASHINGTON ST.	ELEV=580.69

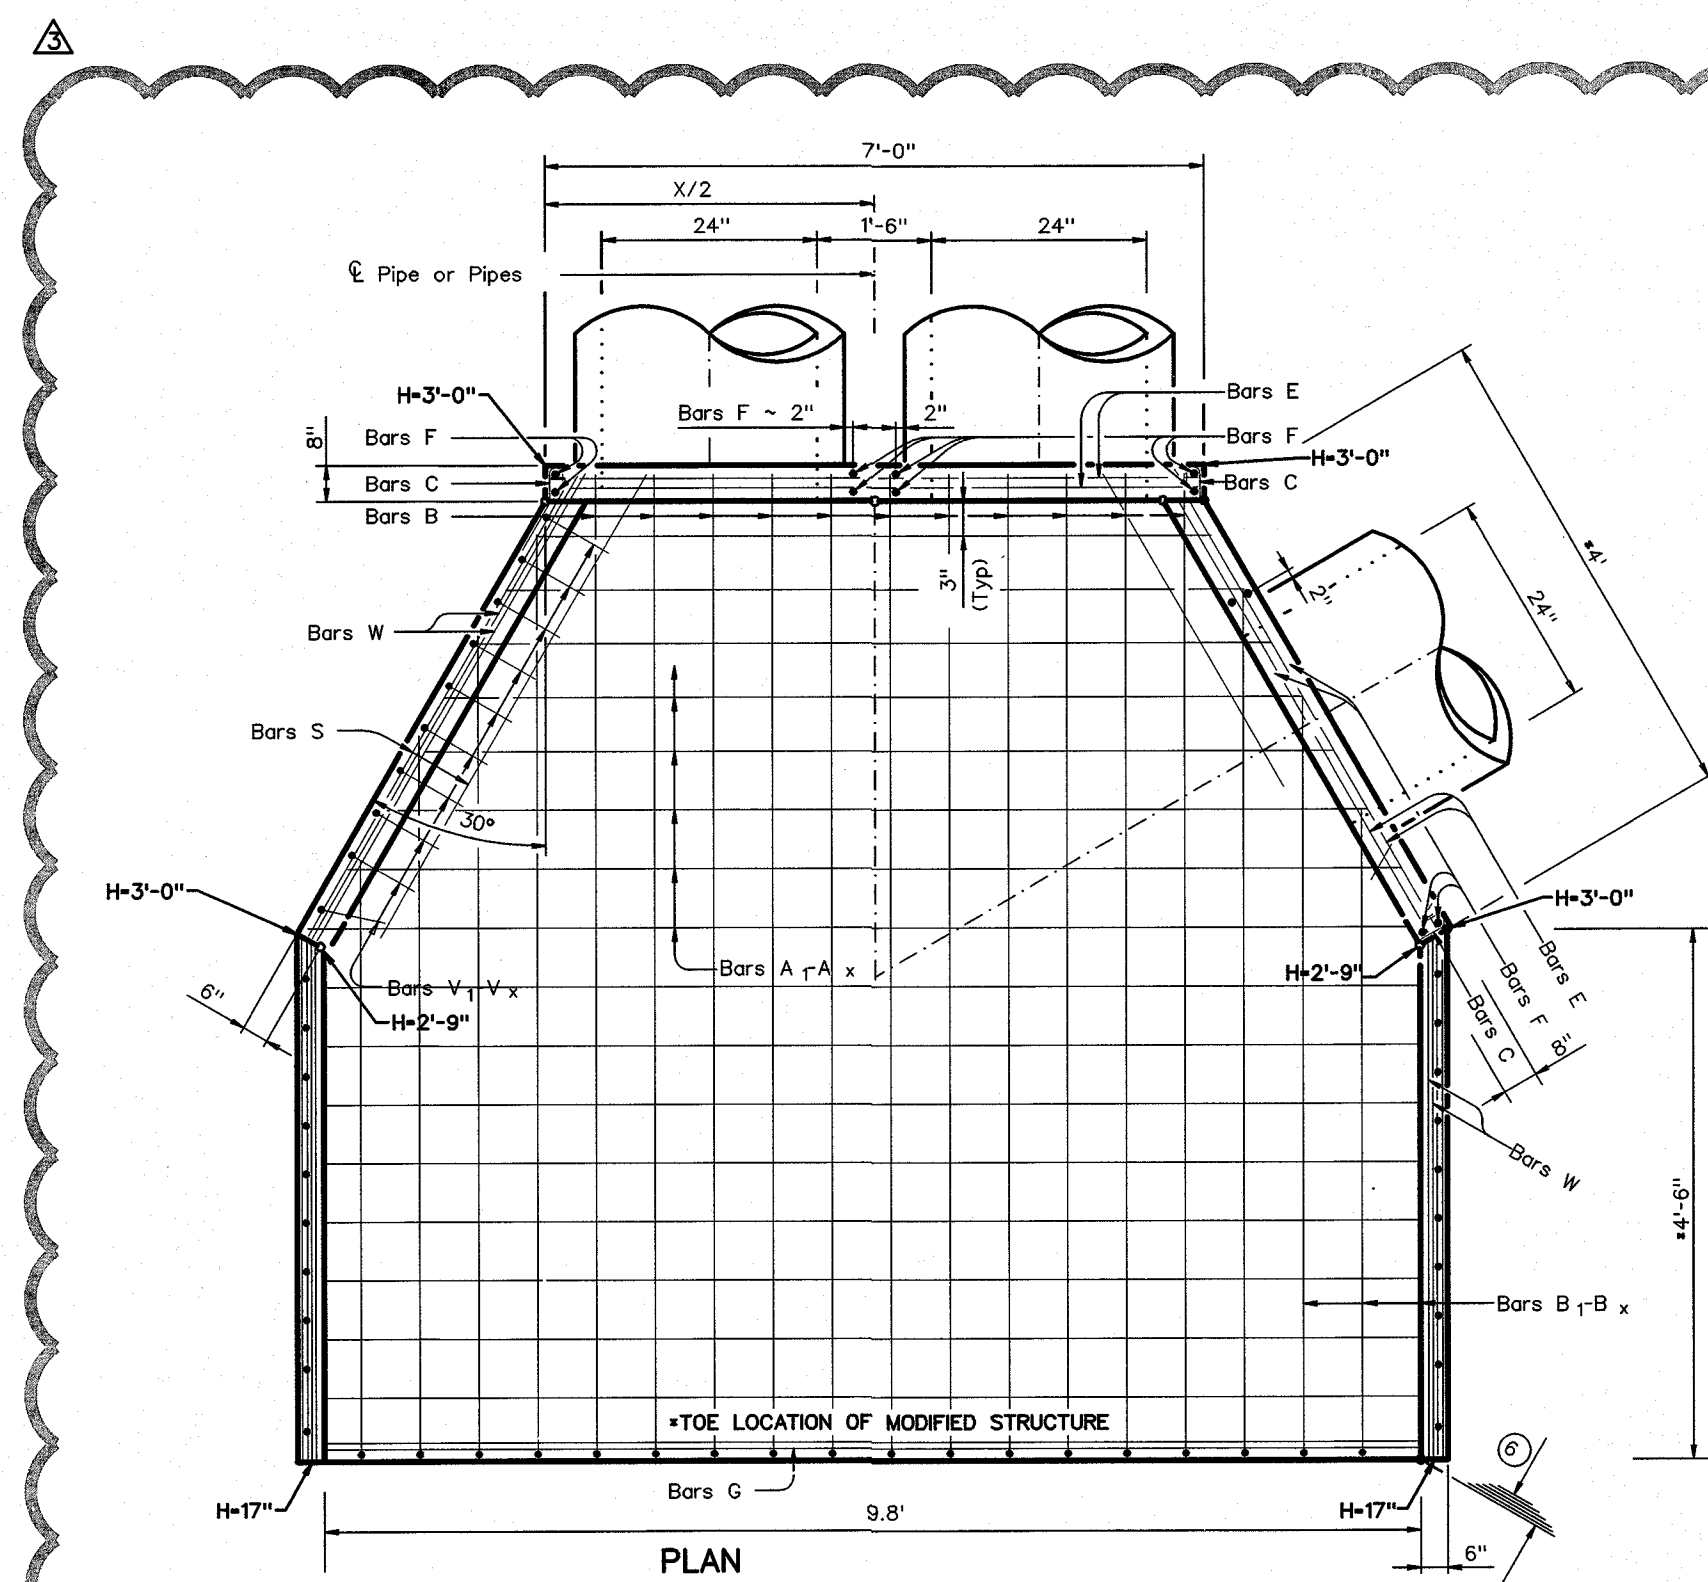




2 MODIFIED TxDOT TYPE "B" CONCRETE HEADWALL

NOT TO SCALE

NOTE: REFER TO TxDOT DETAIL CH-FW-0


NOTE: SEE DETAIL 3, SECTION B-B THIS SHEET

MATCH LINE - SHEET C6-6

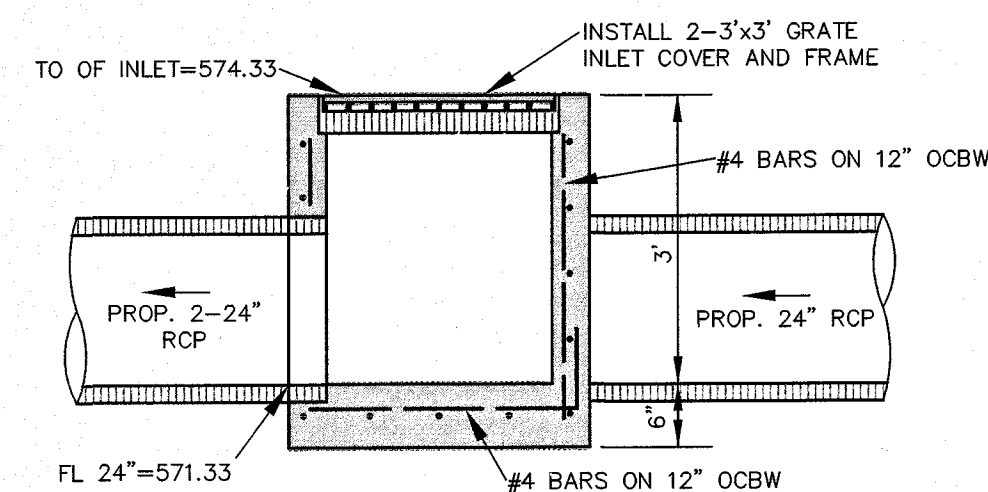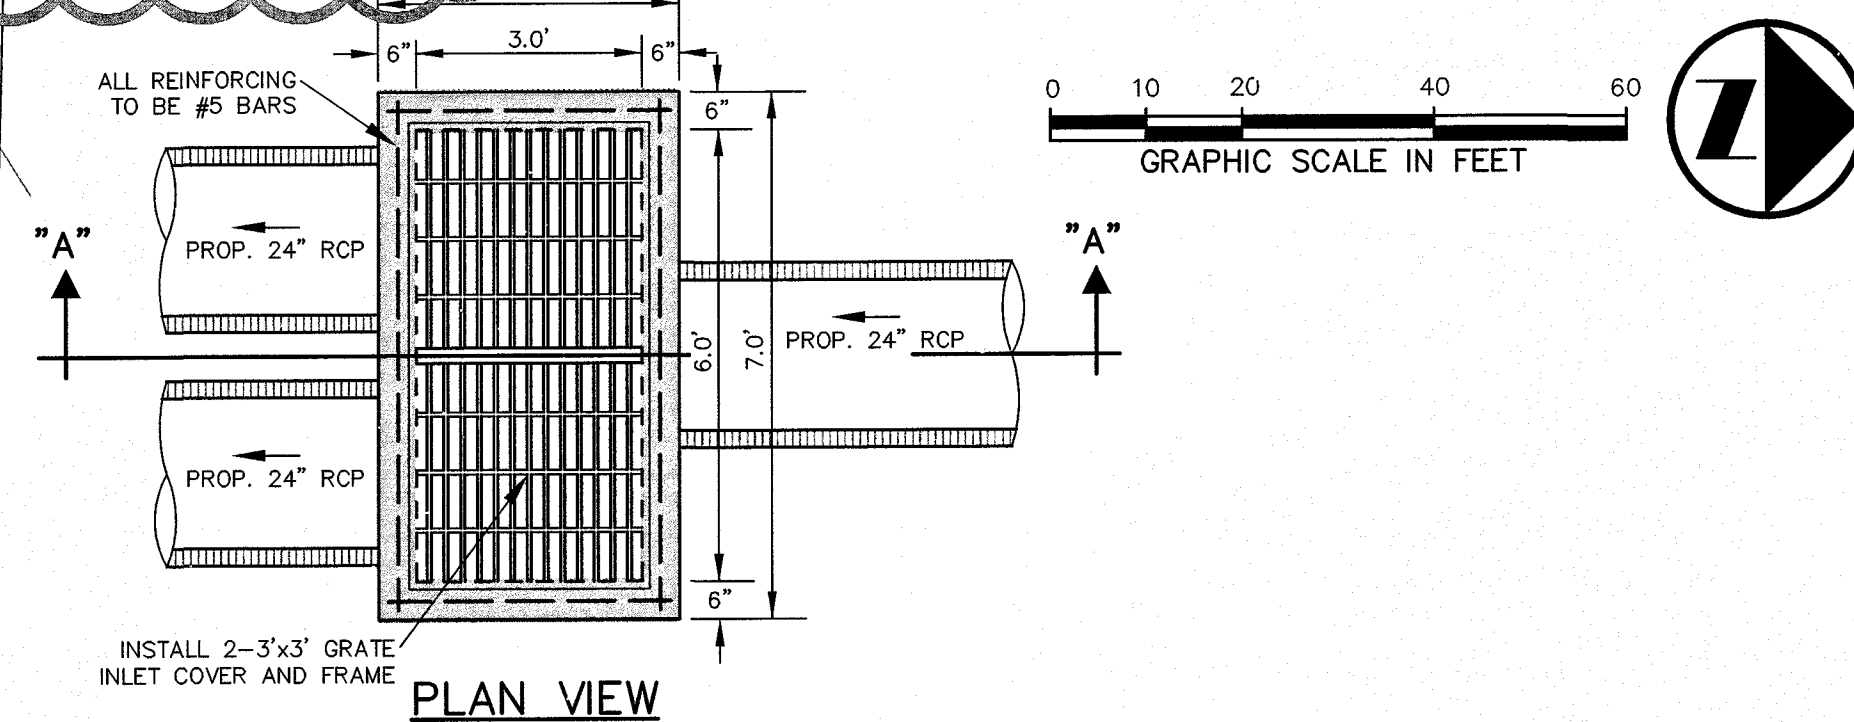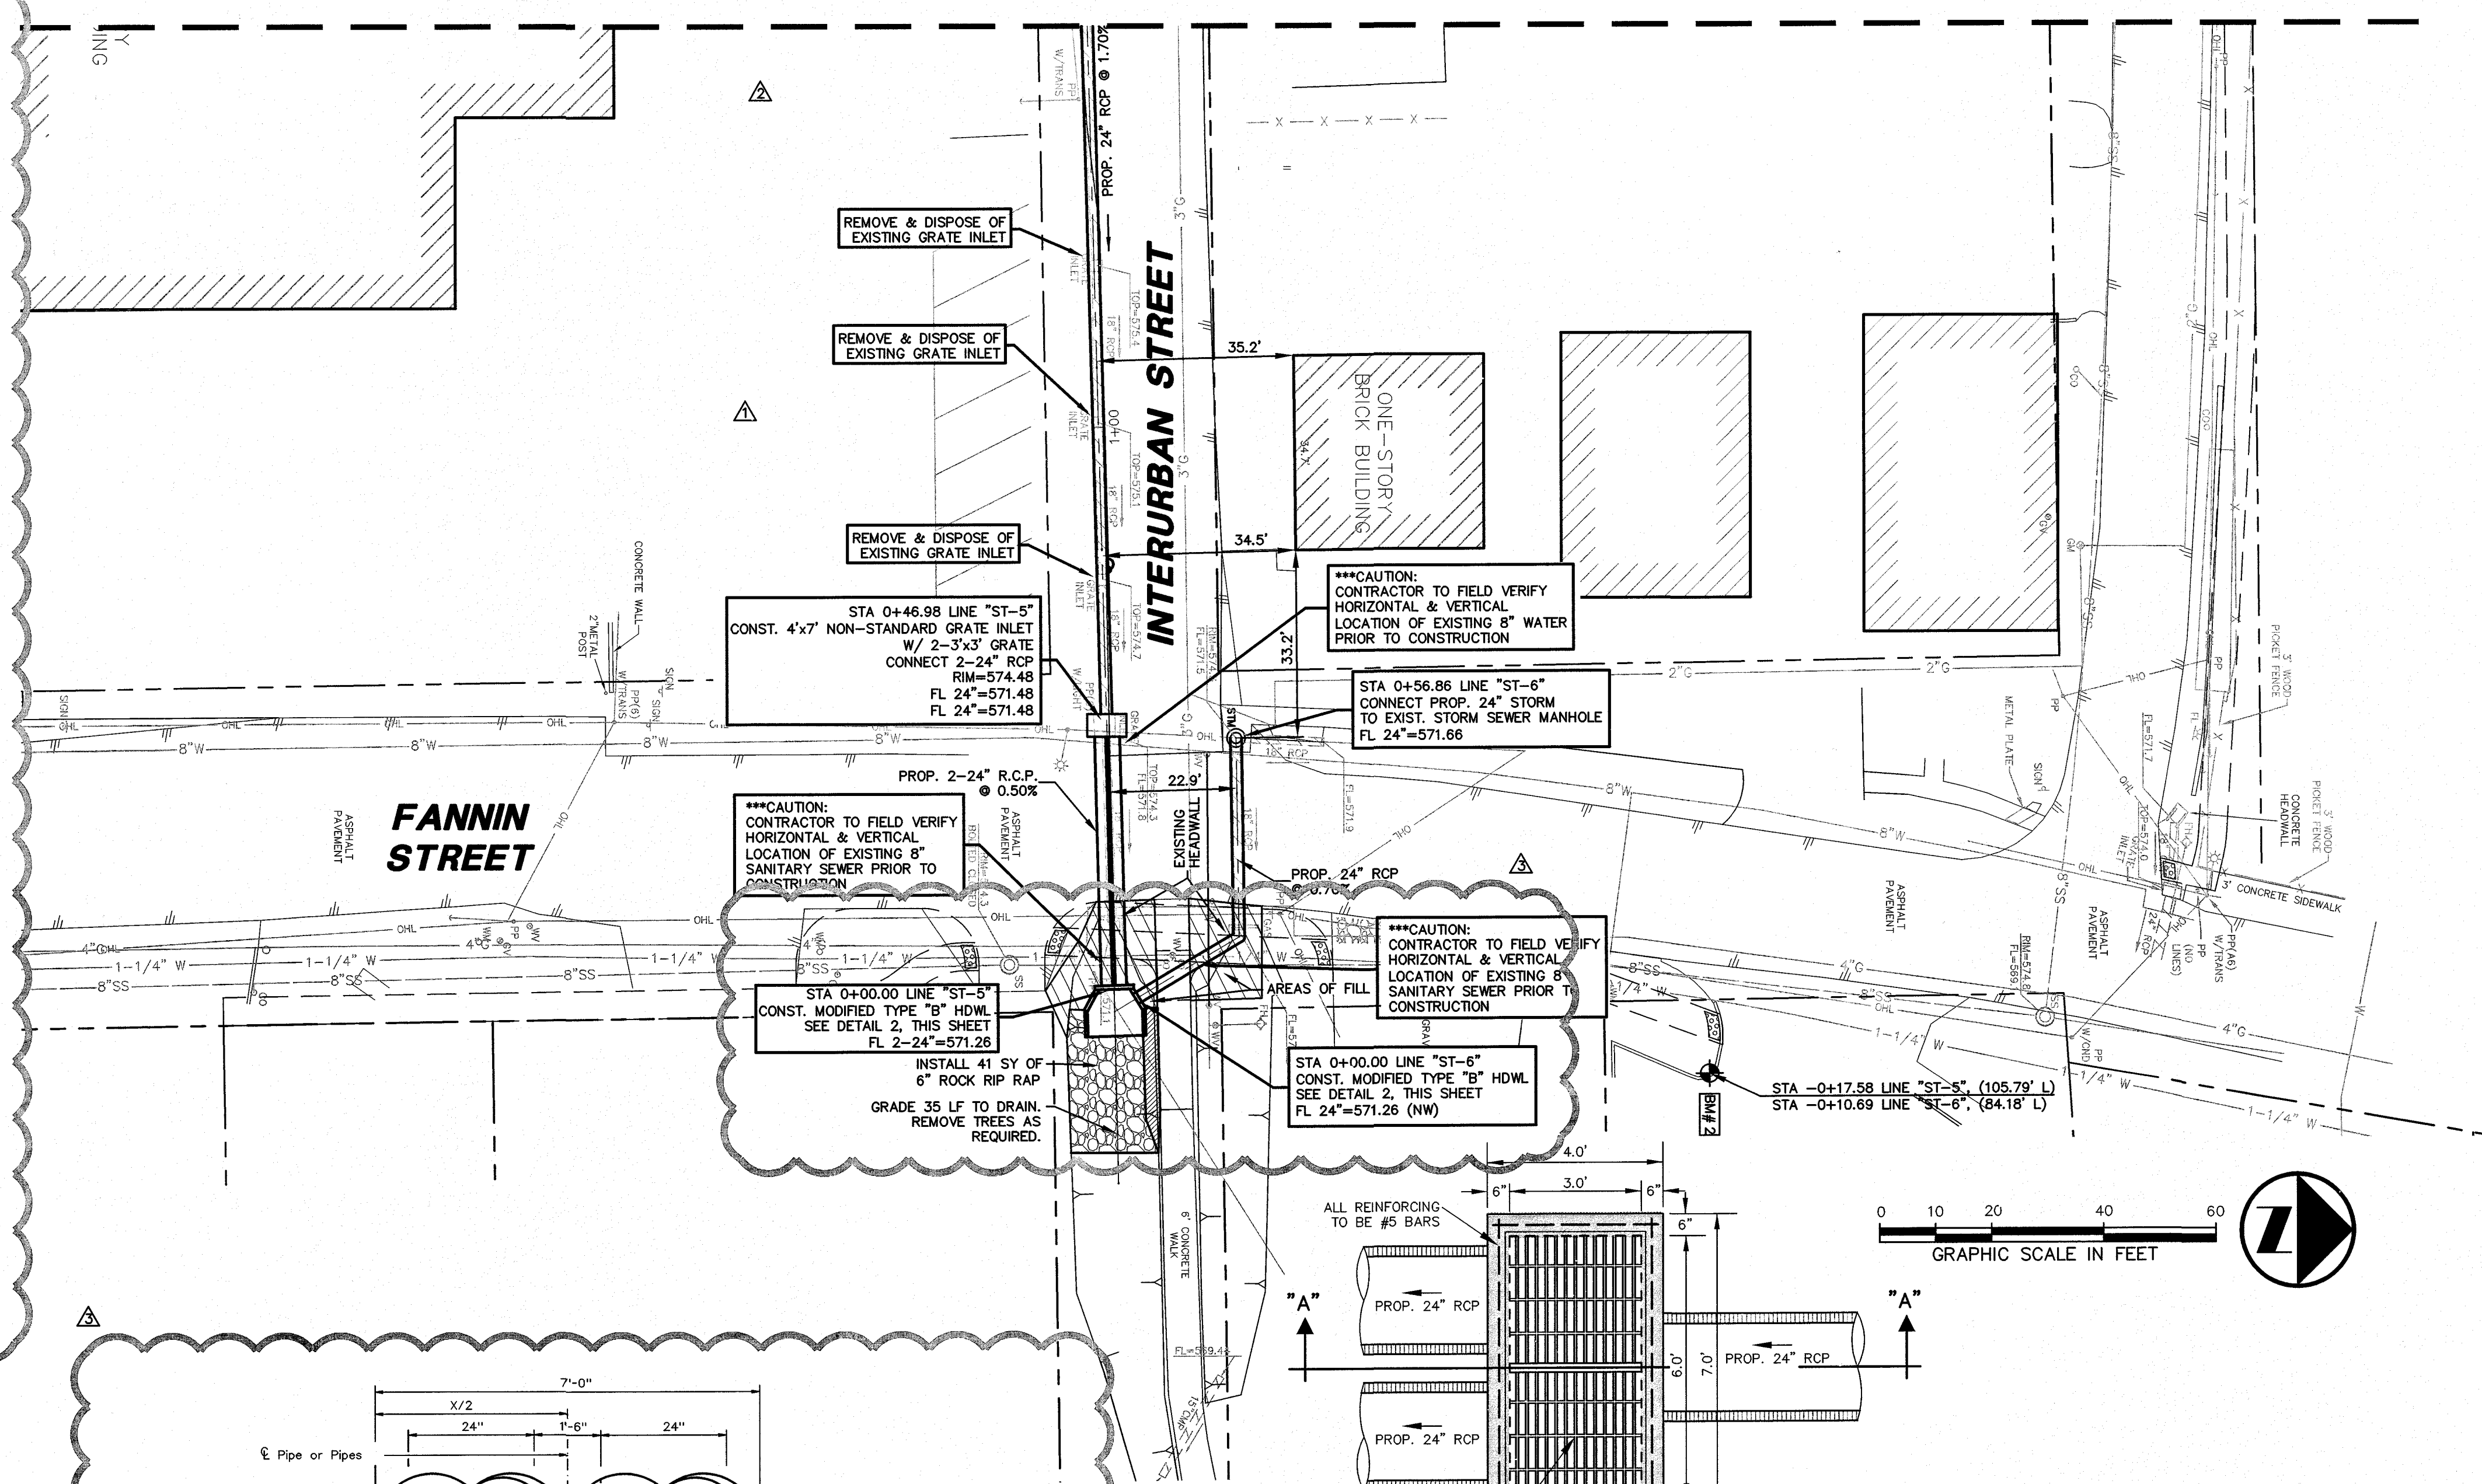


1 4'x7' NON-STANDARD GRATE INLET W/ 2 - 3'x3' GRATE

NOT TO SCALE

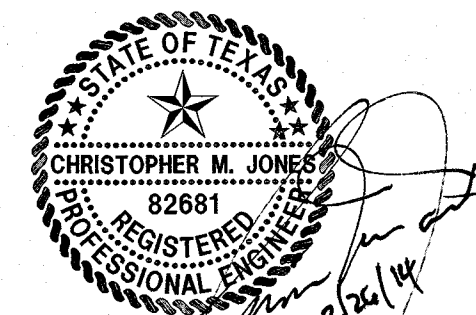

THE SEAL APPEARING ON THIS DOCUMENT WAS AUTHORIZED BY CHRISTOPHER M. JONES, P.E. 82881 ON 02/26/2014. ALTERATION OF A SEALED DOCUMENT WITHOUT PROPER NOTIFICATION TO THE RESPONSIBLE ENGINEER IS AN OFFENSE UNDER THE TEXAS ENGINEERING PRACTICE ACT.

sheet location KEY MAP

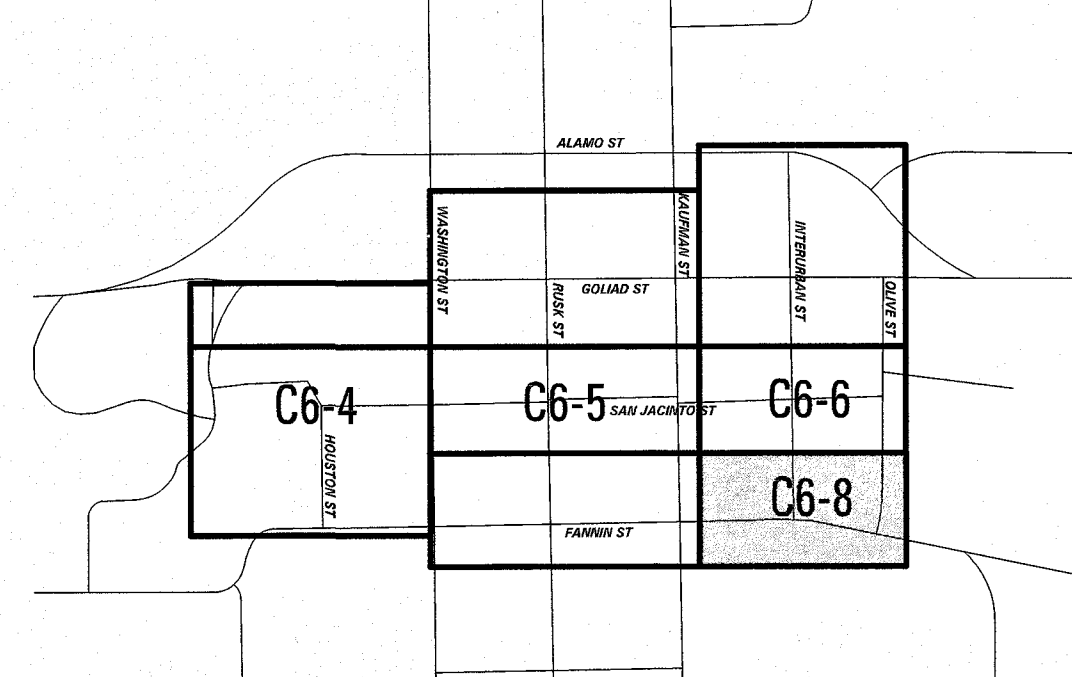

Downtown Rockwall

la terra studio Project # 12024

streetscape improvements

PHASE 2

rockwall, texas

submittals / revisions

no.	date	detail
12/11/13	ADDENDUM #2	
7/11/14	LASI #7	
6/3/15	RFI #166	

la terra studio, inc.

12024
its project number
02.26.2014
date
JHB
drawn by
CMJ
checked by

registration

sheet title
STORM DRAINAGE PLAN
sheet number

C6-8