

THE HARBOR
ROCKWALL, TEXAS

REGISTRATION


NO.	REVISIONS	DATE
1	POST-BID ADDENDUM	01/17/06
2	AS BUILT	11/10/06

SHEET TITLE

LAKE SIDE
EQUIPMENT VAULT
ELECTRICAL

JOB NO. 4830
DATE: JULY 12, 2005
DESIGNED BY: JLS
CHECKED BY: JLS
FILE: 4830.THEHARBOR.ASBUILT.110706
SHEET NUMBER

LW.06C

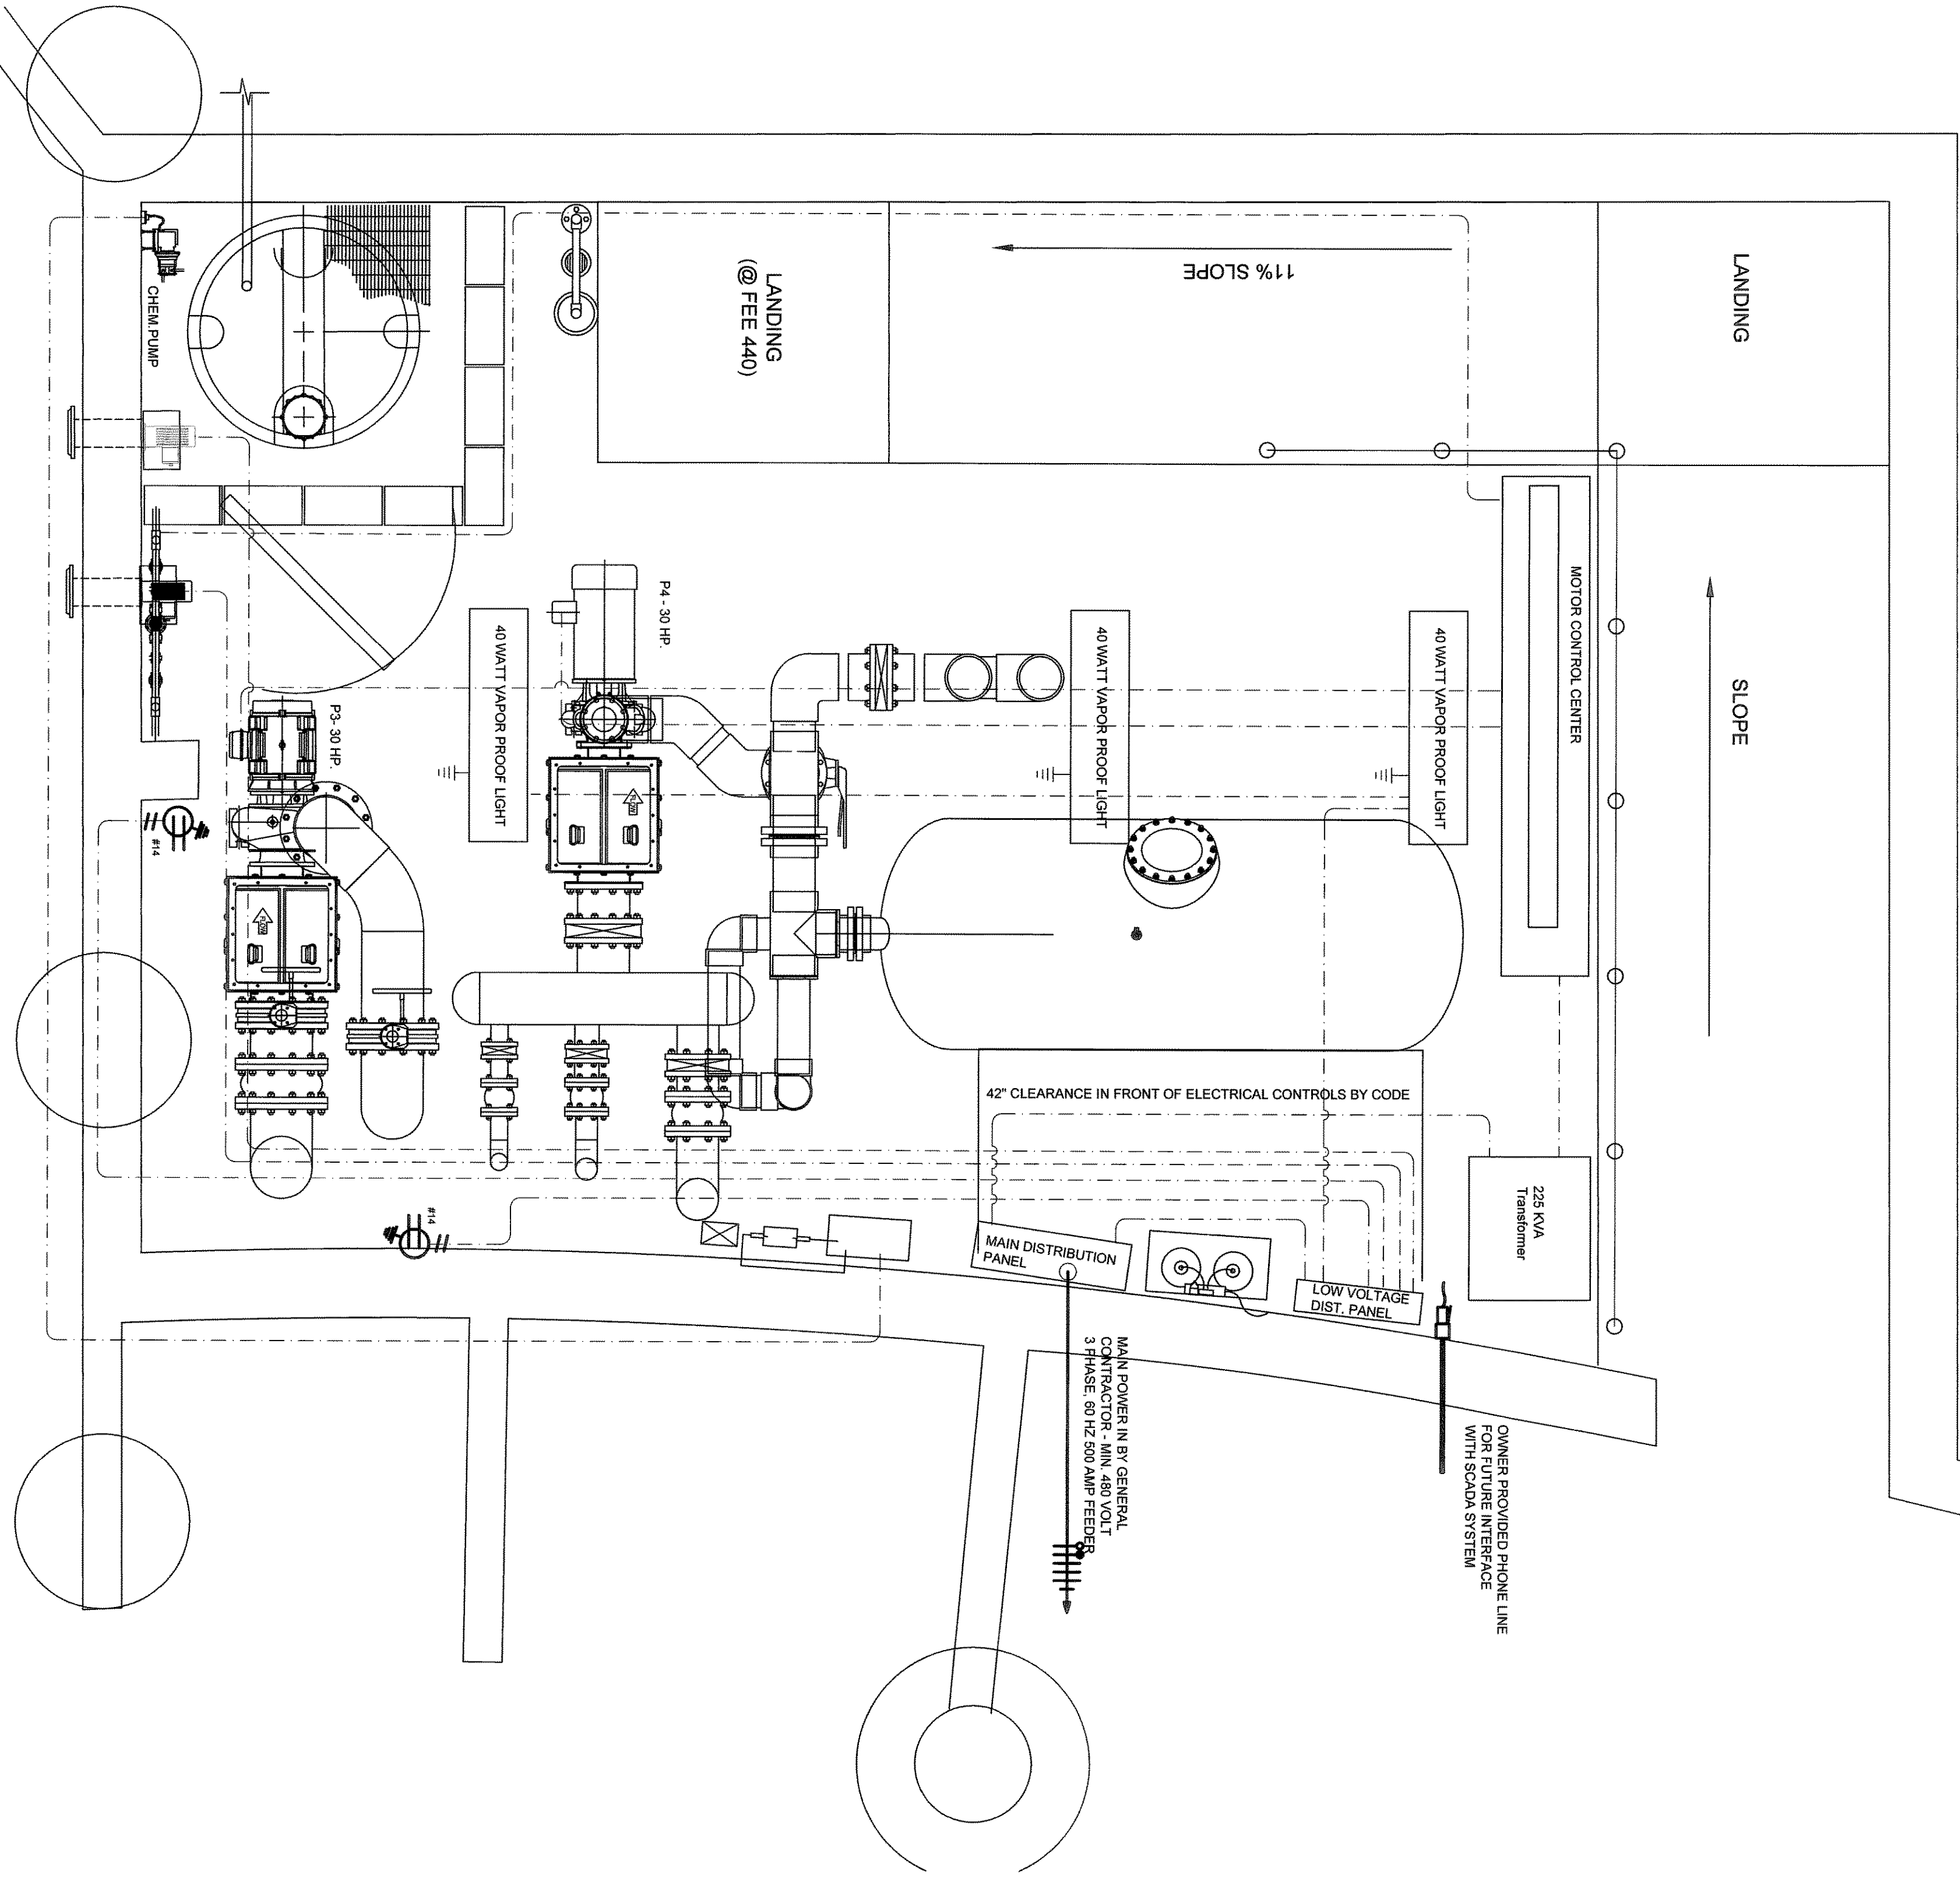


A LAKE SIDE VAULT ELECTRICAL
PLAN

SCALE : 1/2" = 1'-0"

IT SHALL BE THE FOUNTAIN SUB CONTRACTOR'S RESPONSIBILITY TO COORDINATE PLACEMENT OF ALL PIPING AND CONDUITS TO AVOID CONFLICTS WITH THE DRAINAGE SYSTEM SHOWN ON THE DR SERIES DRAWINGS.

B LAKE SIDE OVERALL ELECTRICAL
SCHEMATIC

SCALE : NONE

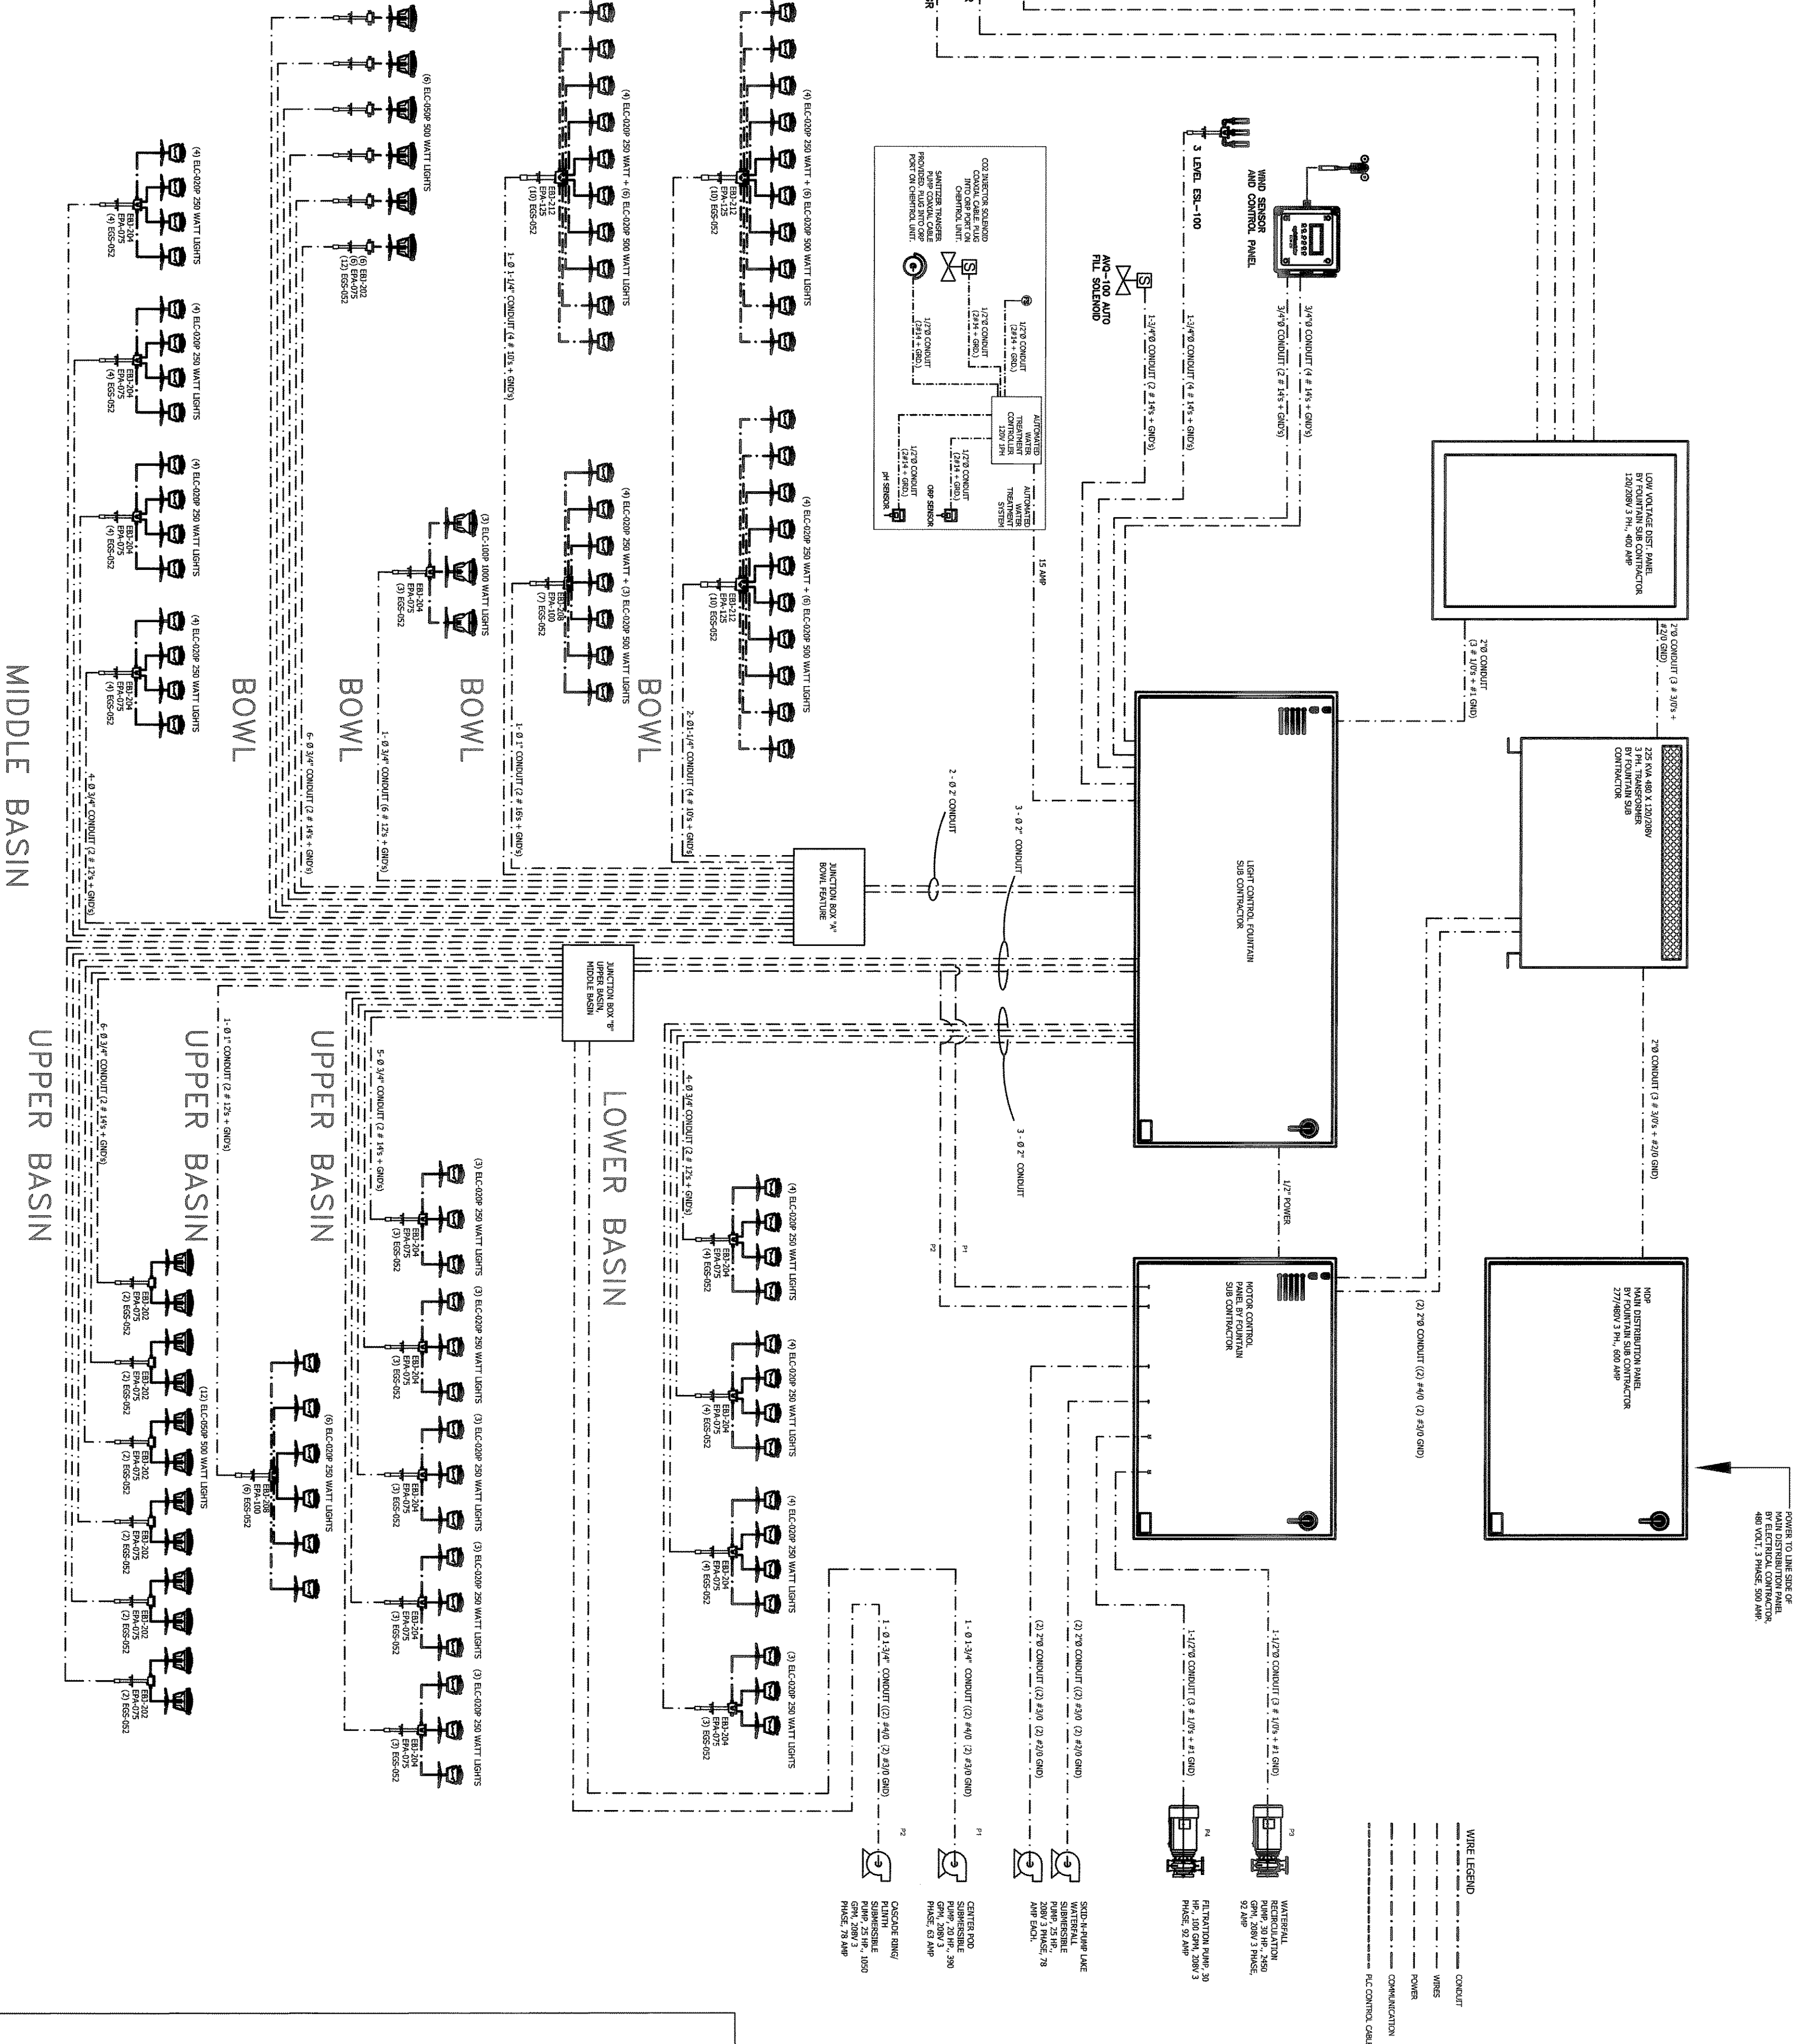

B LAKE SIDE OVERALL ELECTRICAL
SCHEMATIC

SCALE : NONE