
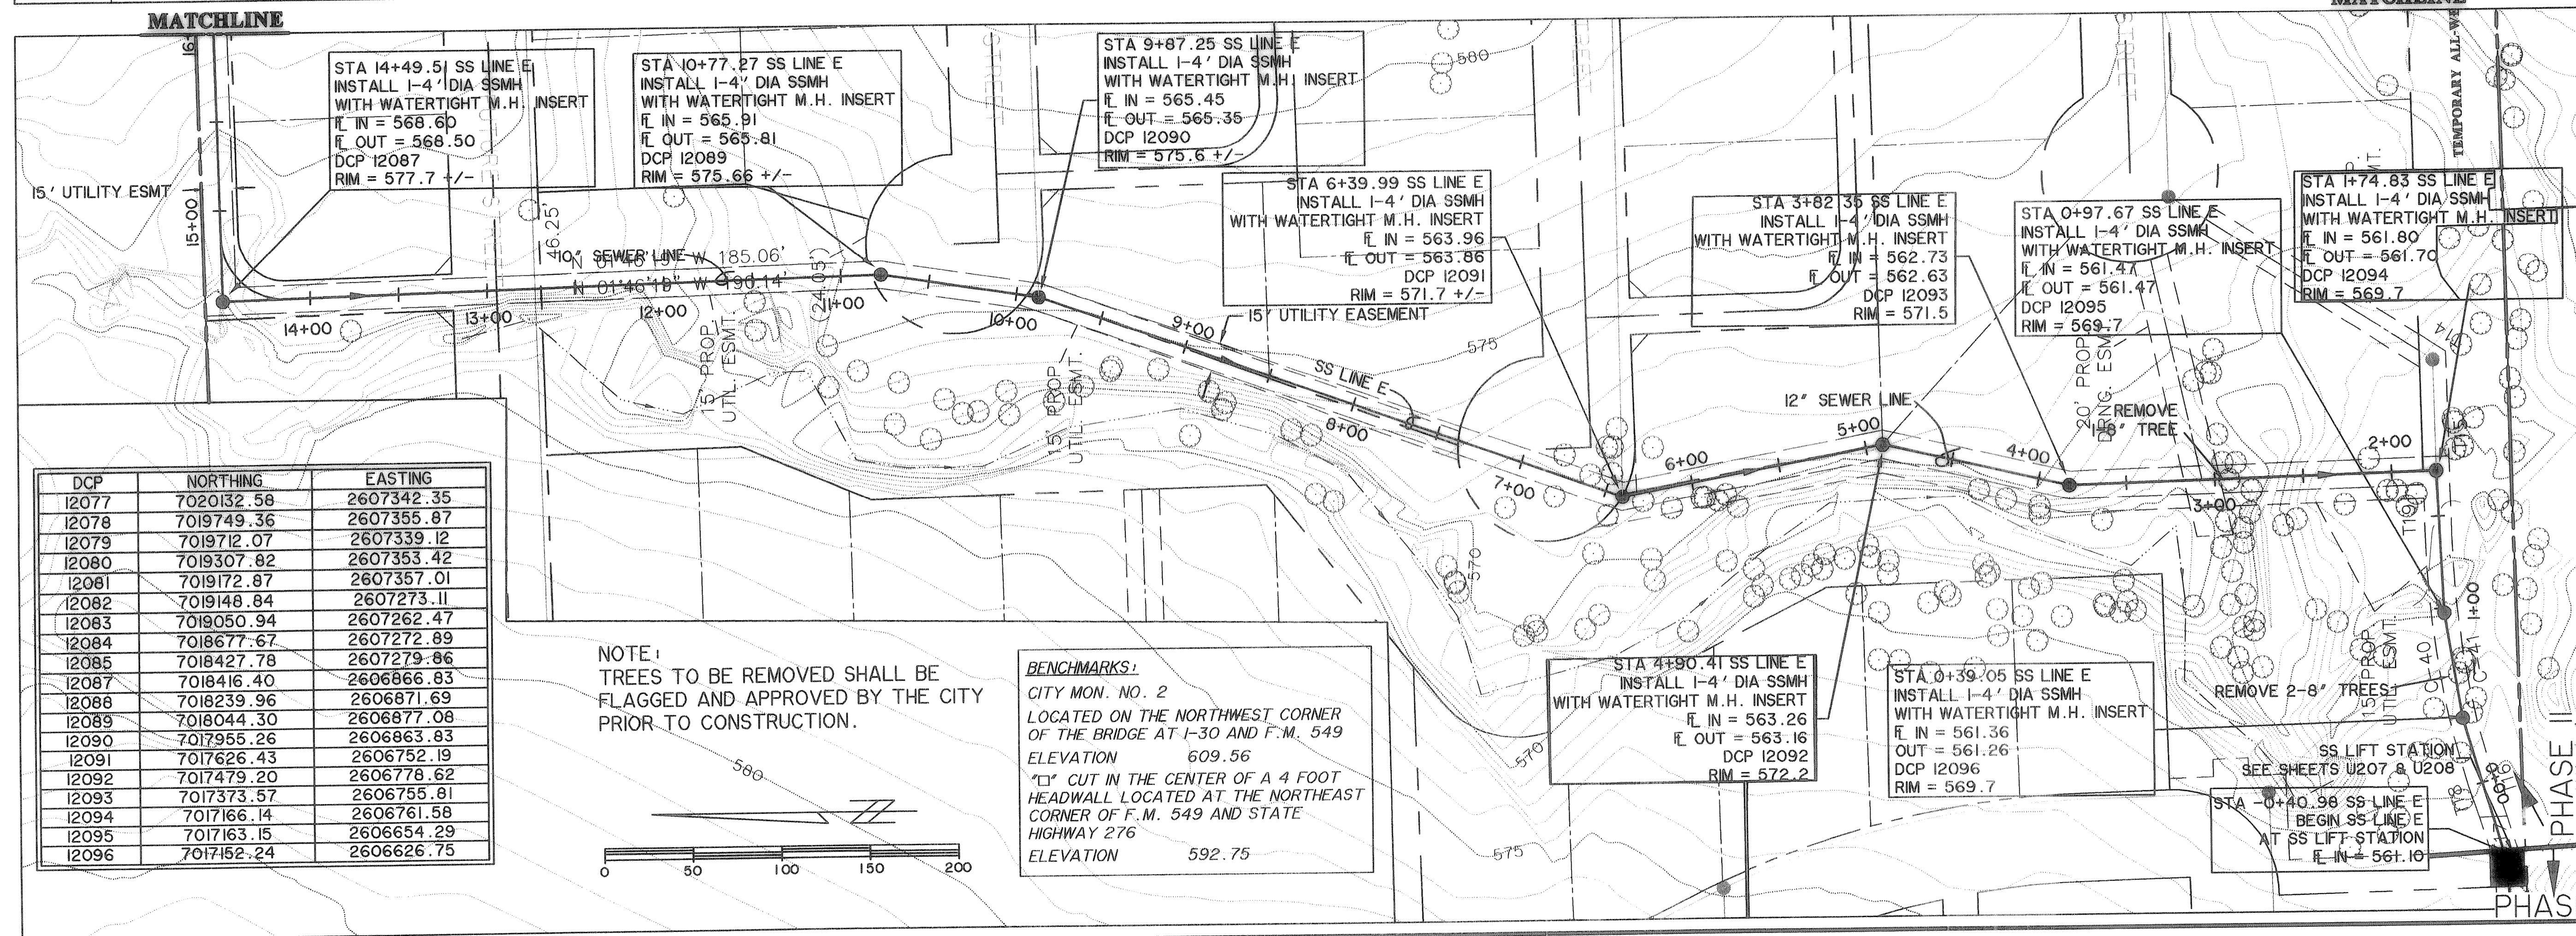


TIME 16:39 FILE: S52.dwg

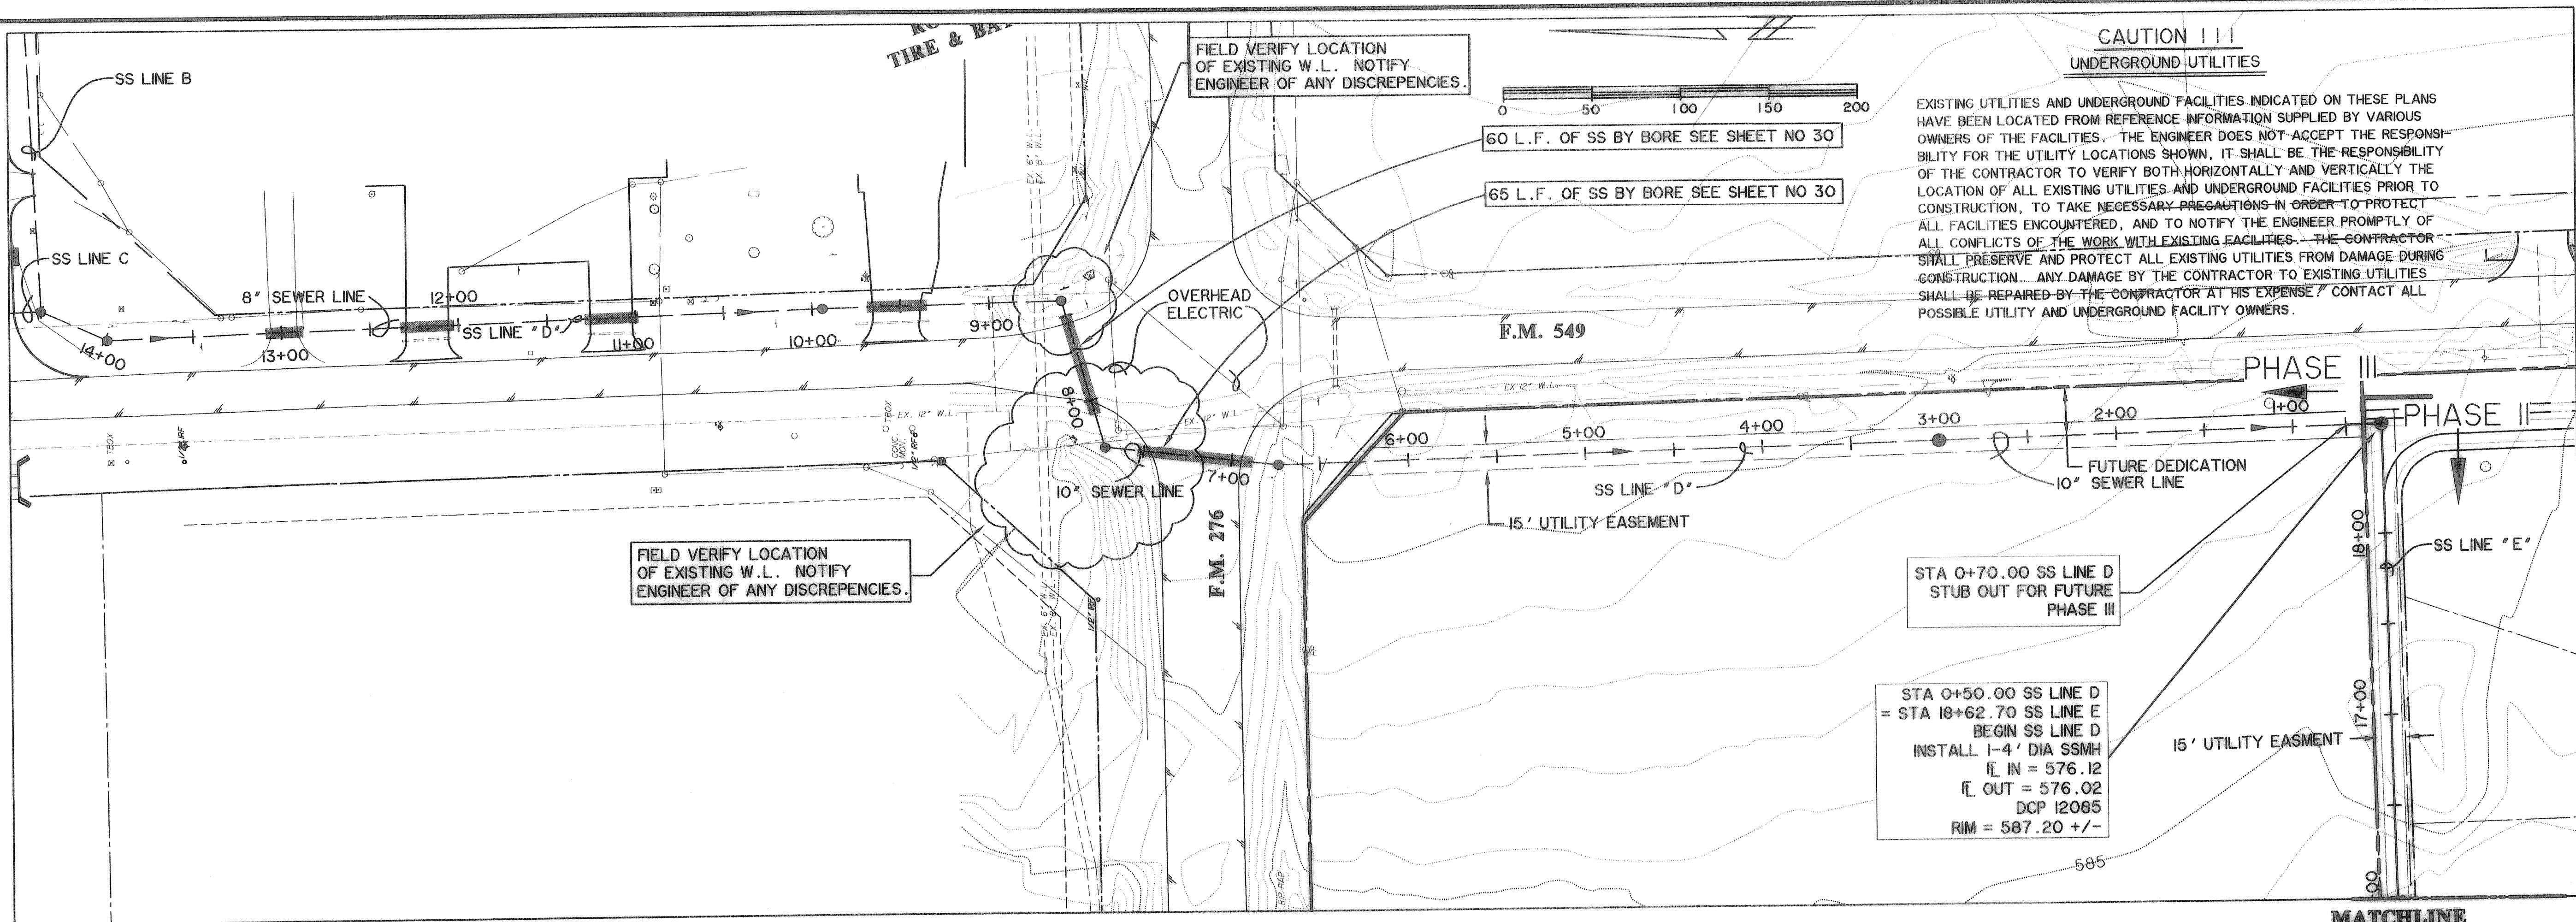

PREPARED BY:

WIER & ASSOCIATES, INC.
ENGINEERS SURVEYORS LAND PLANNERS
4300 BELTWAY PLACE SUITE 130 ARLINGTON, TEXAS 76018 METRO (817)467-7700
1300 U.S. HIGHWAY 287 N. SUITE 101 WIMBLED, TEXAS 76063 METRO (817)477-8700
8721 5th STREET FMSO, TEXAS 75004 METRO (214)387-8800
www.wierassociates.com

LONG BRANCH LIFT
STATION, FORCE MAIN
AND GRAVITY SEWER
TO SERVE LOFLAND
FARMS PHASE 5B

**SANITARY SEWER
LAYOUT
LINES "D" & "E"**

COPYRIGHT ©
WIER & ASSOCIATES, INC.
LAST SHEET EDIT
DATE 10-07-2003
WA# 98041

SHEET NO.
U101