


P:\4328\50004153-205Bypass\CADD\Sheets\Section 1-140-00-To-FM552\Record Drawing 10_7_09\114PavMk-03.dgn
11/11/2009

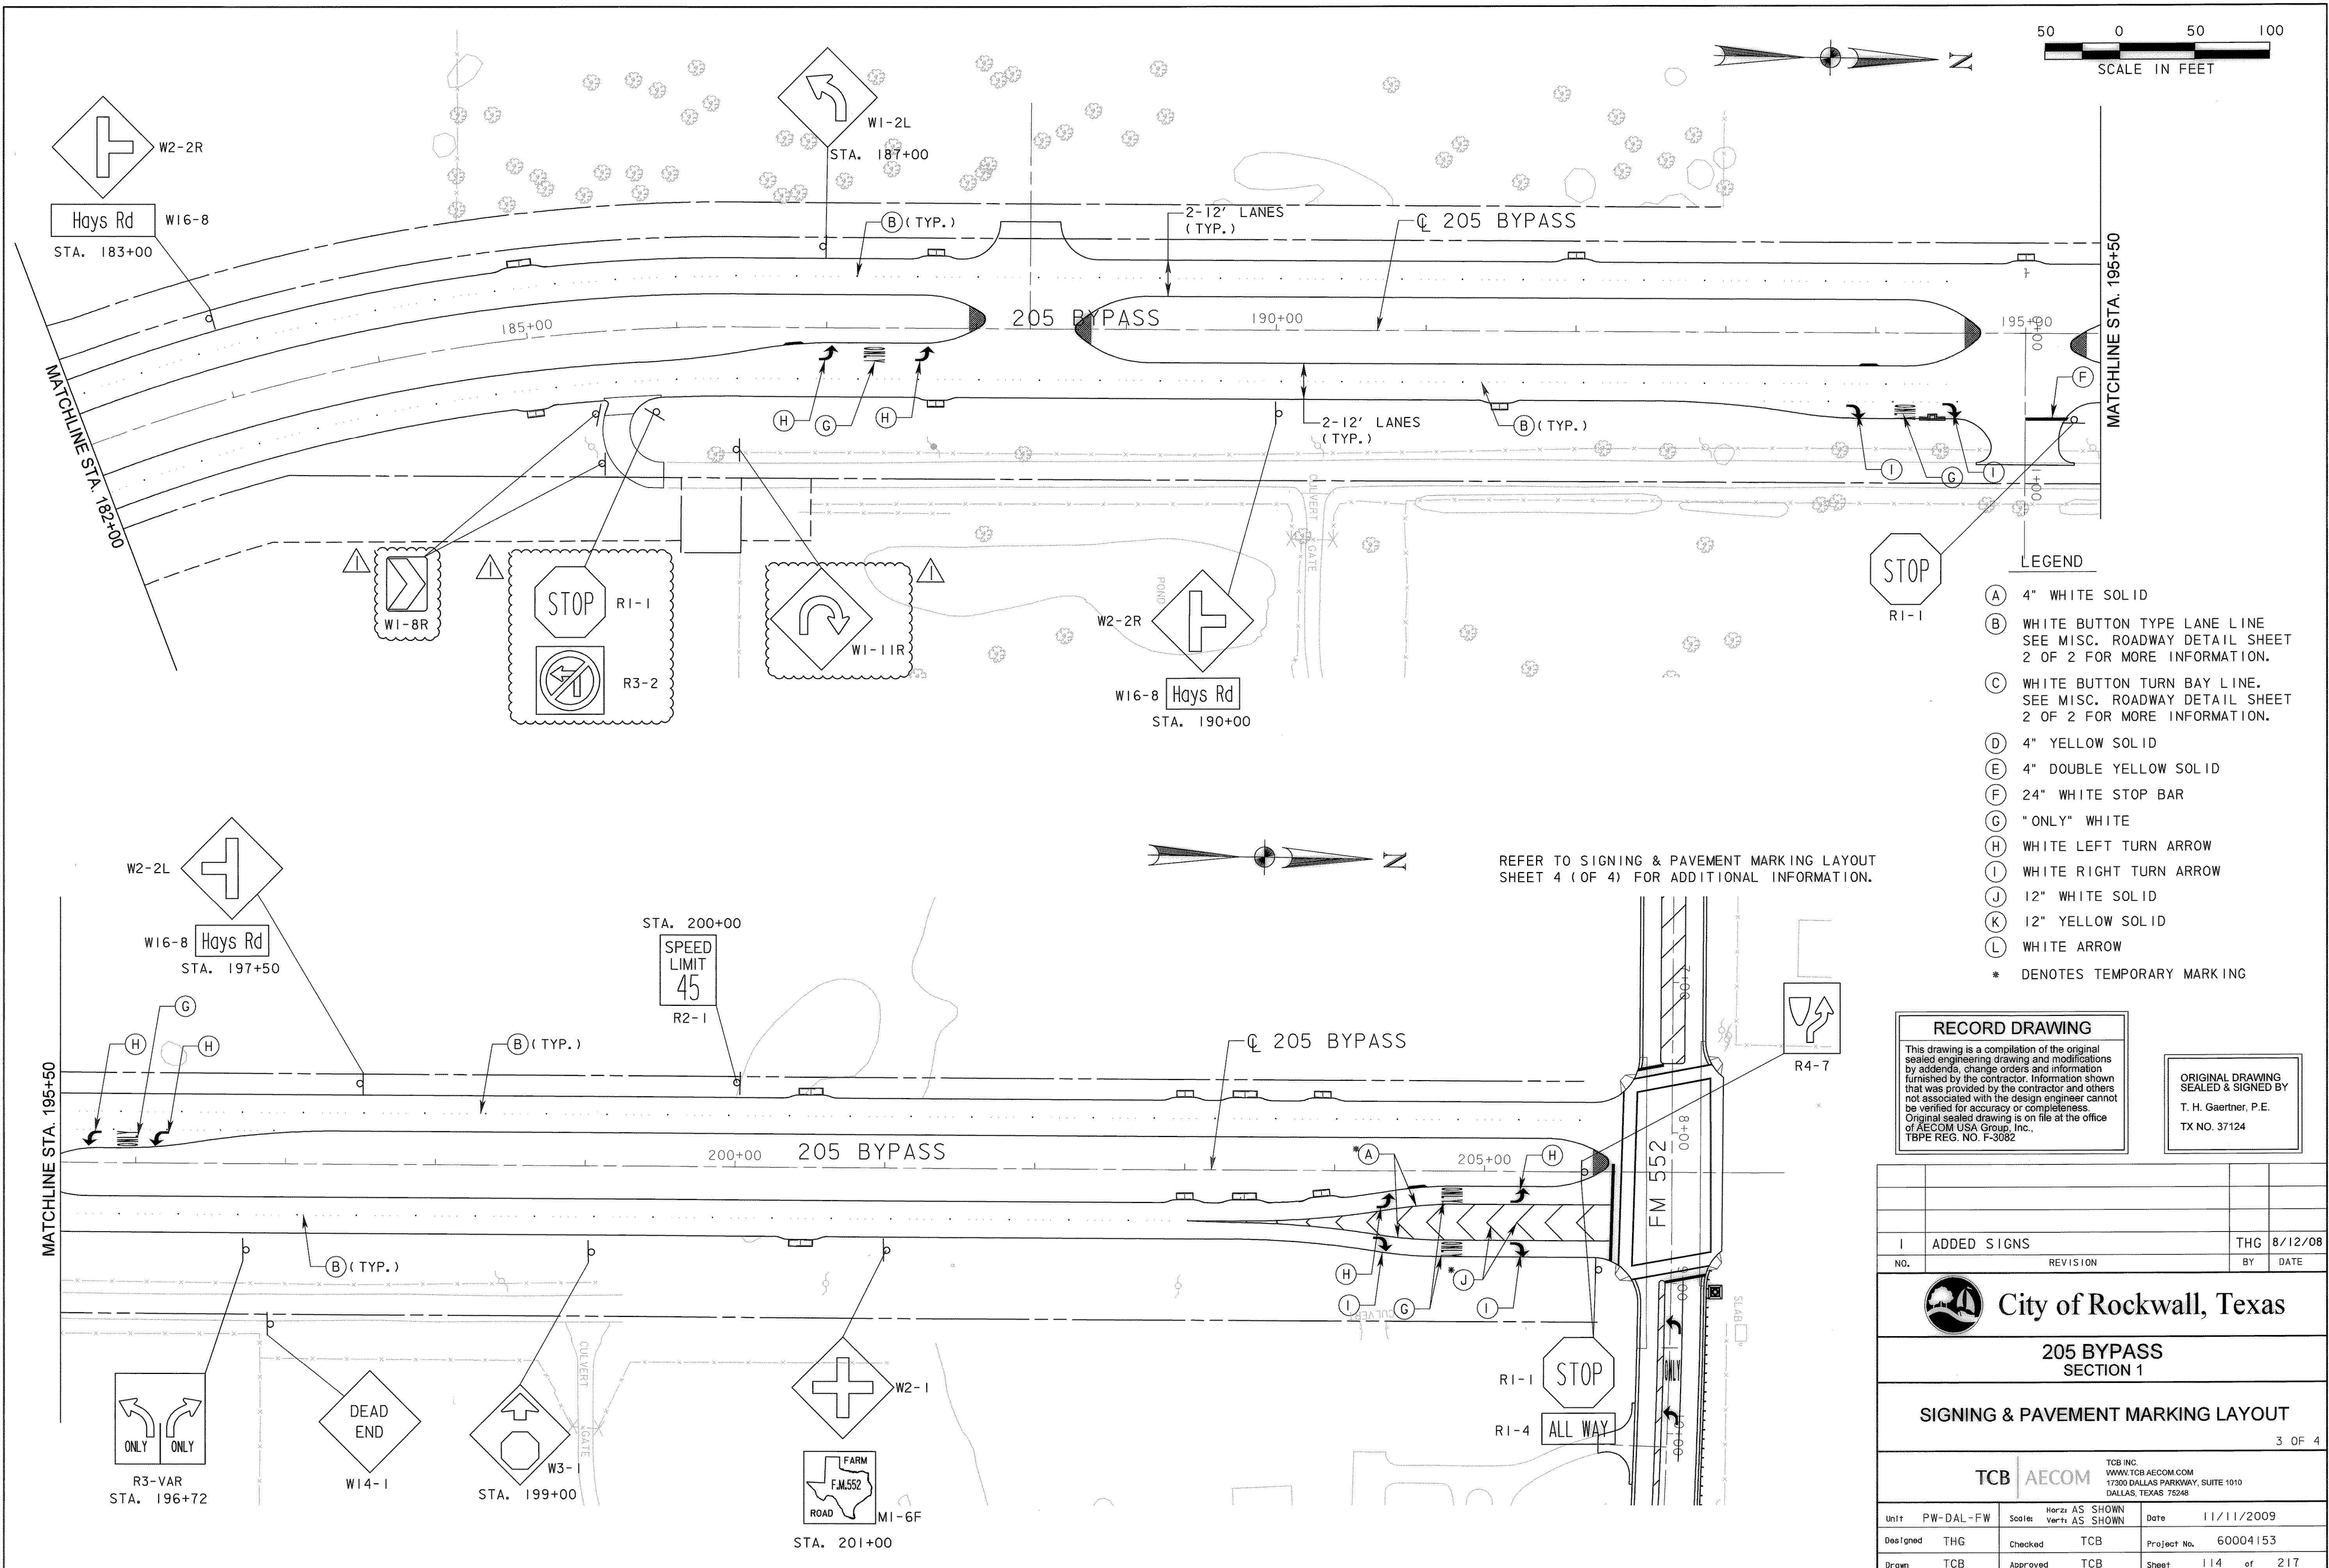

- LEGEND**
- (A) 4" WHITE SOLID
 - (B) WHITE BUTTON TYPE LANE LINE
SEE MISC. ROADWAY DETAIL SHEET 2 OF 2 FOR MORE INFORMATION.
 - (C) WHITE BUTTON TURN BAY LINE.
SEE MISC. ROADWAY DETAIL SHEET 2 OF 2 FOR MORE INFORMATION.
 - (D) 4" YELLOW SOLID
 - (E) 4" DOUBLE YELLOW SOLID
 - (F) 24" WHITE STOP BAR
 - (G) "ONLY" WHITE
 - (H) WHITE LEFT TURN ARROW
 - (I) WHITE RIGHT TURN ARROW
 - (J) 12" WHITE SOLID
 - (K) 12" YELLOW SOLID
 - (L) WHITE ARROW
 - * DENOTES TEMPORARY MARKING

RECORD DRAWING
This drawing is a compilation of the original sealed engineering drawing and modifications by addenda, change orders and information furnished by the contractor. Information shown that was provided by the contractor and others not associated with the design engineer cannot be verified for accuracy or completeness. Original sealed drawing is on file at the office of AECOM USA Group, Inc., TBPE REG. NO. F-3082

ORIGINAL DRAWING
SEALED & SIGNED BY
T. H. Gaertner, P.E.
TX NO. 37124

I	ADDED SIGNS		THG	8/12/08
NO.	REVISION		BY	DATE
 City of Rockwall, Texas				
205 BYPASS SECTION 1				
SIGNING & PAVEMENT MARKING LAYOUT				
3 OF 4				
TCB AECOM TCB INC. WWW.TCB.AECOM.COM 17300 DALLAS PARKWAY, SUITE 1010 DALLAS, TEXAS 75248				
Unit	PW-DAL-FW	Scale: Horiz: AS Vert: AS	SHOWN SHOWN	Date 11/11/2009
Designed	THG	Checked	TCB	Project No. 60004153
Drawn	TCB	Approved	TCB	Sheet 114 of 217