

CIVIL CONSTRUCTION PLANS


# LOT 5, BLOCK A MAVERICK RANCH ADDITION SITE IMPROVEMENTS

JOSEPH STRICKLAND, ABST # 187

CITY OF ROCKWALL  
ROCKWALL COUNTY, TEXAS

**GENERAL NOTES  
(APPLICABLE TO ALL SHEETS)**

1. Excavated material shall be placed as directed by the Owner.
2. Construction shall meet the requirements of the latest revision of the Standards of Design and Standard Details for the City of Rockwall & NCTCOG Standards, 5TH Edition.
3. All fill areas to be density controlled and compacted to 95% density at optimum moisture content. Compacted with sheep foot roller.
4. Pavement thickness and strength shall be as follows:  
Fire Lanes.....6"  
Parking areas.....5"  
Drive Approach within right of way ..8"  
3600 psi at 28 days and reinforced with No.4 bar at 18" centers each way using a 6 sack mix for machine pour and a 6-1/2 sack mix for hand pour.
5. All sidewalks shall be 4" thick 3000 psi reinf. conc. with No. 3 rebar at 24" O.C.E.W. Cement content shall be not less than 5.5 sack per cubic yard
6. All streets shall be constructed with min. 6% lime stabilized subgrade compacted to 95% standard proctor density, lime series needs to be performed to verify.
7. It shall be the responsibility of the Contractor to locate and verify all existing utilities prior to the beginning of construction to insure no conflicts between all utility lines.
8. Where water pipelines either cross or otherwise come within 10 feet of a sanitary sewer pipeline, the sewer pipeline shall be with a minimum working pressure Class 150 psi.
9. All water lines installed to be PVC pipe C900 conforming to AWWA DR14 Standard C-900, fitting shall be mechanical or O-ring.
10. All water lines are to be installed a minimum of 48" deep measured from top of pipe.
11. All storm inlets shall be cast-in-place with a minimum of 4200 psi and 7.0 sack for all structures. No fly ash
12. Utility contractor shall use MEGALUGS when installing the water line and double strap services when installing the services.
13. Water services shall be a minimum of 1" SDR-9 polyethylene pipe installed with two in-line nylon ball cutoff valves inside the meter box. Corporation cock shall be Mueller No. H-15000 w/ straight coupling nut or approved equal. Curb stops shall be Mueller No. H-15174 MK orisael or approved equal.
14. All water lines shall be pressure tested and disinfected in accordance with AWWA C 601.
15. All gate valves shall be Mueller or approved equal and conform to AWWA C-500 specifications. All gate valves shall be iron body, bronze mounted, double disk, parallel seat, non-rising stem, internal wedging type.
16. All fire hydrants shall be located 2' to 6' behind curb line. All fire hydrants shall be Mueller or approved equal.
17. All handicap ramps shall be installed with paving.
18. Contractor is responsible for acquiring NCTCOG and Rockwall Standards and Details.
19. Blue EMS disk to installed at every change in direction, services, and valves on waterlines
20. Green EMS disks to installed at every change in direction, manhole, cleanout, and service on sanitary sewer lines..
21. Floodway monument shall be installed per City of Rockwall detail.
22. All gravity sewer shall be SDR 35, unless otherwise noted and in conformance with City of Rockwall Standards.
23. All City and TxDOT right-of-way to be sodded.
24. Contractor to adjust all proposed utilities to grade.
25. All detention to be constructed in place, stabilized, and functioning per approved plans with sodd or anchor seeded curlex before paving and building can start.

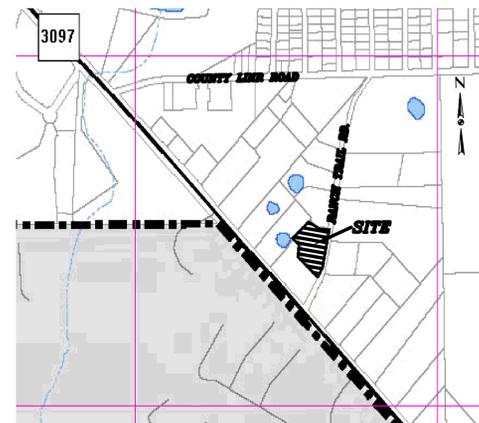

LOCATION MAP  
NTS

**GENERAL NOTES  
(APPLICABLE TO ALL SHEETS)**

1. ALL WORKS ON THIS PROJECT/CONTRACT SHALL COMPLY WITH ALL THE REQUIREMENTS OF CITY OF ROCKWALL AND AUTHORITIES HAVING JURISDICTION.

**SHEET INDEX**

- 1.0 COVER SHEET
- 1.1 FINAL PLAT
- 1.2 GENERAL CONSTRUCTION NOTES
- 2.0 SITE PLAN
- 3.0 DIMENSION CONTROL AND PAVING PLAN
- 4.0 EXISTING AREA DRAINAGE MAP
- 4.1 DRAINAGE AREA MAP, WEIRS 1,2,& 3
- 4.2 DRAINAGE WEIRS 4 & 5
- 5.0 STORMWATER DETENTION CALCULATIONS
- 6.0 GRADING PLAN
- 7.0 UTILITIES PLAN
- 8.0 STORM SEWER PLAN
- 9.0 EROSION CONTROL PLAN
- 10.0 LANDSCAPE PLAN
- 11- 15 CONSTRUCTION DETAILS

**CAUTION!!!**

**UNDERGROUND UTILITIES**

EXISTING UTILITIES AND UNDERGROUND FACILITIES INDICATED ON THESE PLANS HAVE BEEN LOCATED FROM REFERENCE INFORMATION SUPPLIED BY THE VARIOUS OWNERS OF THE FACILITIES. THE ENGINEER DOES NOT ACCEPT THE RESPONSIBILITY FOR THE UTILITY LOCATIONS SHOWN. IT SHALL BE THE RESPONSIBILITY OF THE CONTRACTOR TO VERIFY BOTH HORIZONTALLY AND VERTICALLY THE LOCATION OF ALL EXISTING UTILITIES AND UNDERGROUND FACILITIES PRIOR TO CONSTRUCTION, TO TAKE NECESSARY PRECAUTIONS IN ORDER TO PROTECT ALL FACILITIES ENCOUNTERED, AND TO NOTIFY THE ENGINEER PROMPTLY OF ALL CONFLICTS OF THE WORK WITH EXISTING FACILITIES. THE CONTRACTOR SHALL PRESERVE AND PROTECT ALL EXISTING FACILITIES FROM DAMAGE DURING CONSTRUCTION. ANY DAMAGE BY THE CONTRACTOR TO EXISTING UTILITIES SHALL BE REPAIRED BY THE CONTRACTOR AT HIS/HER EXPENSE.

**NOTE:**

CONTRACTOR TO VERIFY IN THE FIELD THE LOCATION OF ALL EXISTING UTILITIES PRIOR TO CONSTRUCTION. INFORMATION PROVIDED WITHIN THESE PLANS DOES NOT RELIEVE THE CONTRACTOR OF THE FULL AND TOTAL RESPONSIBILITY FOR THE PROTECTION OF EXISTING UTILITIES NOR ANY DAMAGES CAUSED BY SAID CONTRACTOR DURING CONSTRUCTION.



ALL RESPONSIBILITY FOR ADEQUACY OF DESIGN REMAINS WITH THE DESIGN ENGINEER. THE CITY OF ROCKWALL, IN REVIEWING AND RELEASING PLANS FOR CONSTRUCTION, ASSUMES NO RESPONSIBILITY FOR ADEQUACY OR ACCURACY OF DESIGN.

REVISED TO CONFORM TO CONSTRUCTION RECORDS.

*W. Douphrate II*

DATE: 2-17-26

**CIVIL ENGINEER**

**DOUPHRATE & ASSOCIATES, INC.**

ENGINEERING • PROJECT MANAGEMENT • SURVEYING

P.O. BOX 1336 ROCKWALL, TEXAS 75087  
PHONE: (972)771-9004 FAX: (972)771-9005

**SURVEYOR**

**JIM ANDERSON**  
1195 LAKE GLEN CIRCLE  
ROCKWALL, TEXAS 75087  
(214)-548-2042

**OWNER**


**1800 DALROCK, LLC**  
2424 RIDGE RD  
ROCKWALL, TEXAS 75087  
(469)-298-1594

THE SEAL APPEARING ON THIS DOCUMENT WAS AUTHORIZED BY W.L. DOUPHRATE II, TEXAS P.E. NO. 60102, F-886, ON AUG 26, 2019



LOT 5, BLOCK A, MAVERICK RANCH ADDITION



ILLIAN  
 LYNNE  
 JAMES  
 YVONNE  
 WAYNE  
 RUSSELL  
 KIMBERLY  
 RENEE

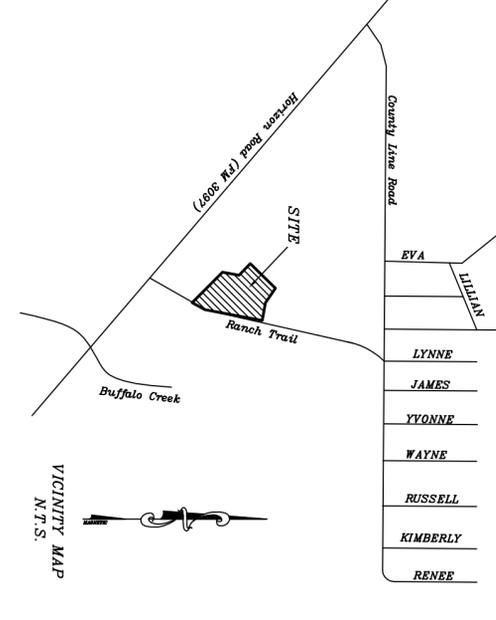

**LEGEND:**  
 IRP = Iron Rod Found  
 IRS = Iron Rod Set with yellow plastic cap "RIS 5664"  
 O.P.R.C.T. = Official Public Records of Rockwall County, Texas  
 P.R.C.T. = Plat Records of Rockwall County, Texas  
 (CM) = Control Monument

LINE	LENGTH	BEARING
L6	10.00'	S79°46'50"E
L7	20.00'	N0°13'10"E
L8	10.00'	S79°46'50"E
L9	109.08'	N79°49'17"W
L10	129.88'	S51°53'58"W
L11	13.83'	S10°13'10"W
L12	20.00'	S79°46'50"E
L13	6.22'	N10°13'10"E
L14	45.11'	N57°53'58"E
L15	22.42'	N10°13'10"E
L16	129.05'	N10°13'10"E
L23	12.29'	N36°10'02"W
L24	13.50'	S89°32'59"W
L25	22.83'	N30°23'40"E
L26	20.00'	N55°43'40"W
L27	56.94'	S30°23'40"W
L28	88.46'	N79°49'17"W
L29	18.54'	S77°40'43"W
L30	15.54'	S55°10'43"W
L31	18.69'	N65°37'25"E
L32	13.47'	S43°08'33"E
L33	5.27'	S22°46'58"E
L34	8.76'	S30°49'47"E
L35	15.98'	S80°53'24"E
L36	18.28'	S86°09'17"E
L37	16.95'	N49°05'50"W
L38	27.32'	N65°07'38"W
L39	21.94'	N02°09'41"W
L40	40.73'	N04°53'11"W
L41	9.84'	N02°16'10"E
L42	13.61'	N01°35'07"E
L43	21.70'	N03°45'16"E
L44	17.65'	N03°27'20"E
L45	81.10'	N80°19'17"W
L46	10.10'	N80°19'17"W
L47	44.00'	S10°01'18"W
L48	38.29'	S04°37'40"E
L49	20.07'	N54°11'14"E
L50	11.64'	S08°11'08"W
L51	18.33'	S02°01'03"W
L52	10.56'	S30°58'01"E
L53	58.23'	N10°44'16"E
L54	37.06'	N03°28'22"E
L55	15.73'	S28°45'53"W
L56	10.16'	S17°13'48"W
L57	7.18'	S36°46'02"W
L58	3.93'	S18°25'30"W
L59	3.27'	N87°15'35"W
L60	14.55'	S02°36'49"W
L61	25.24'	S40°13'54"W
L62	9.75'	S79°31'24"E
L63	10.37'	S79°31'24"E

CURVE	LENGTH	RADIUS	DELTA	CHORD	CHORD
C1	11.46'	23.08'	28°26'43"	S84°50'29"W	11.34'
C2	100.49'	64.00'	89°57'34"	S55°11'56"W	90.48'
C3	56.87'	44.00'	74°03'39"	S26°48'39"E	53.00'
C4	10.64'	20.50'	29°43'43"	S48°57'46"E	10.52'
C5	17.84'	20.00'	51°06'53"	N89°22'59"W	17.26'
C6	25.86'	20.00'	74°04'46"	N26°49'13"W	24.09'
C7	62.80'	40.00'	89°57'34"	N56°11'56"E	56.55'
C8	16.25'	20.00'	46°33'31"	S56°32'37"E	15.81'
C9	38.22'	64.50'	33°57'03"	S06°45'27"E	37.66'
C10	47.26'	64.36'	42°04'17"	S10°47'52"E	46.20'
C11	2.65'	2.00'	75°55'10"	N75°24'59"W	2.46'
C12	7.87'	42.57'	10°35'20"	S42°45'04"E	7.86'
C13	40.22'	25.24'	91°18'32"	S06°02'37"E	36.09'

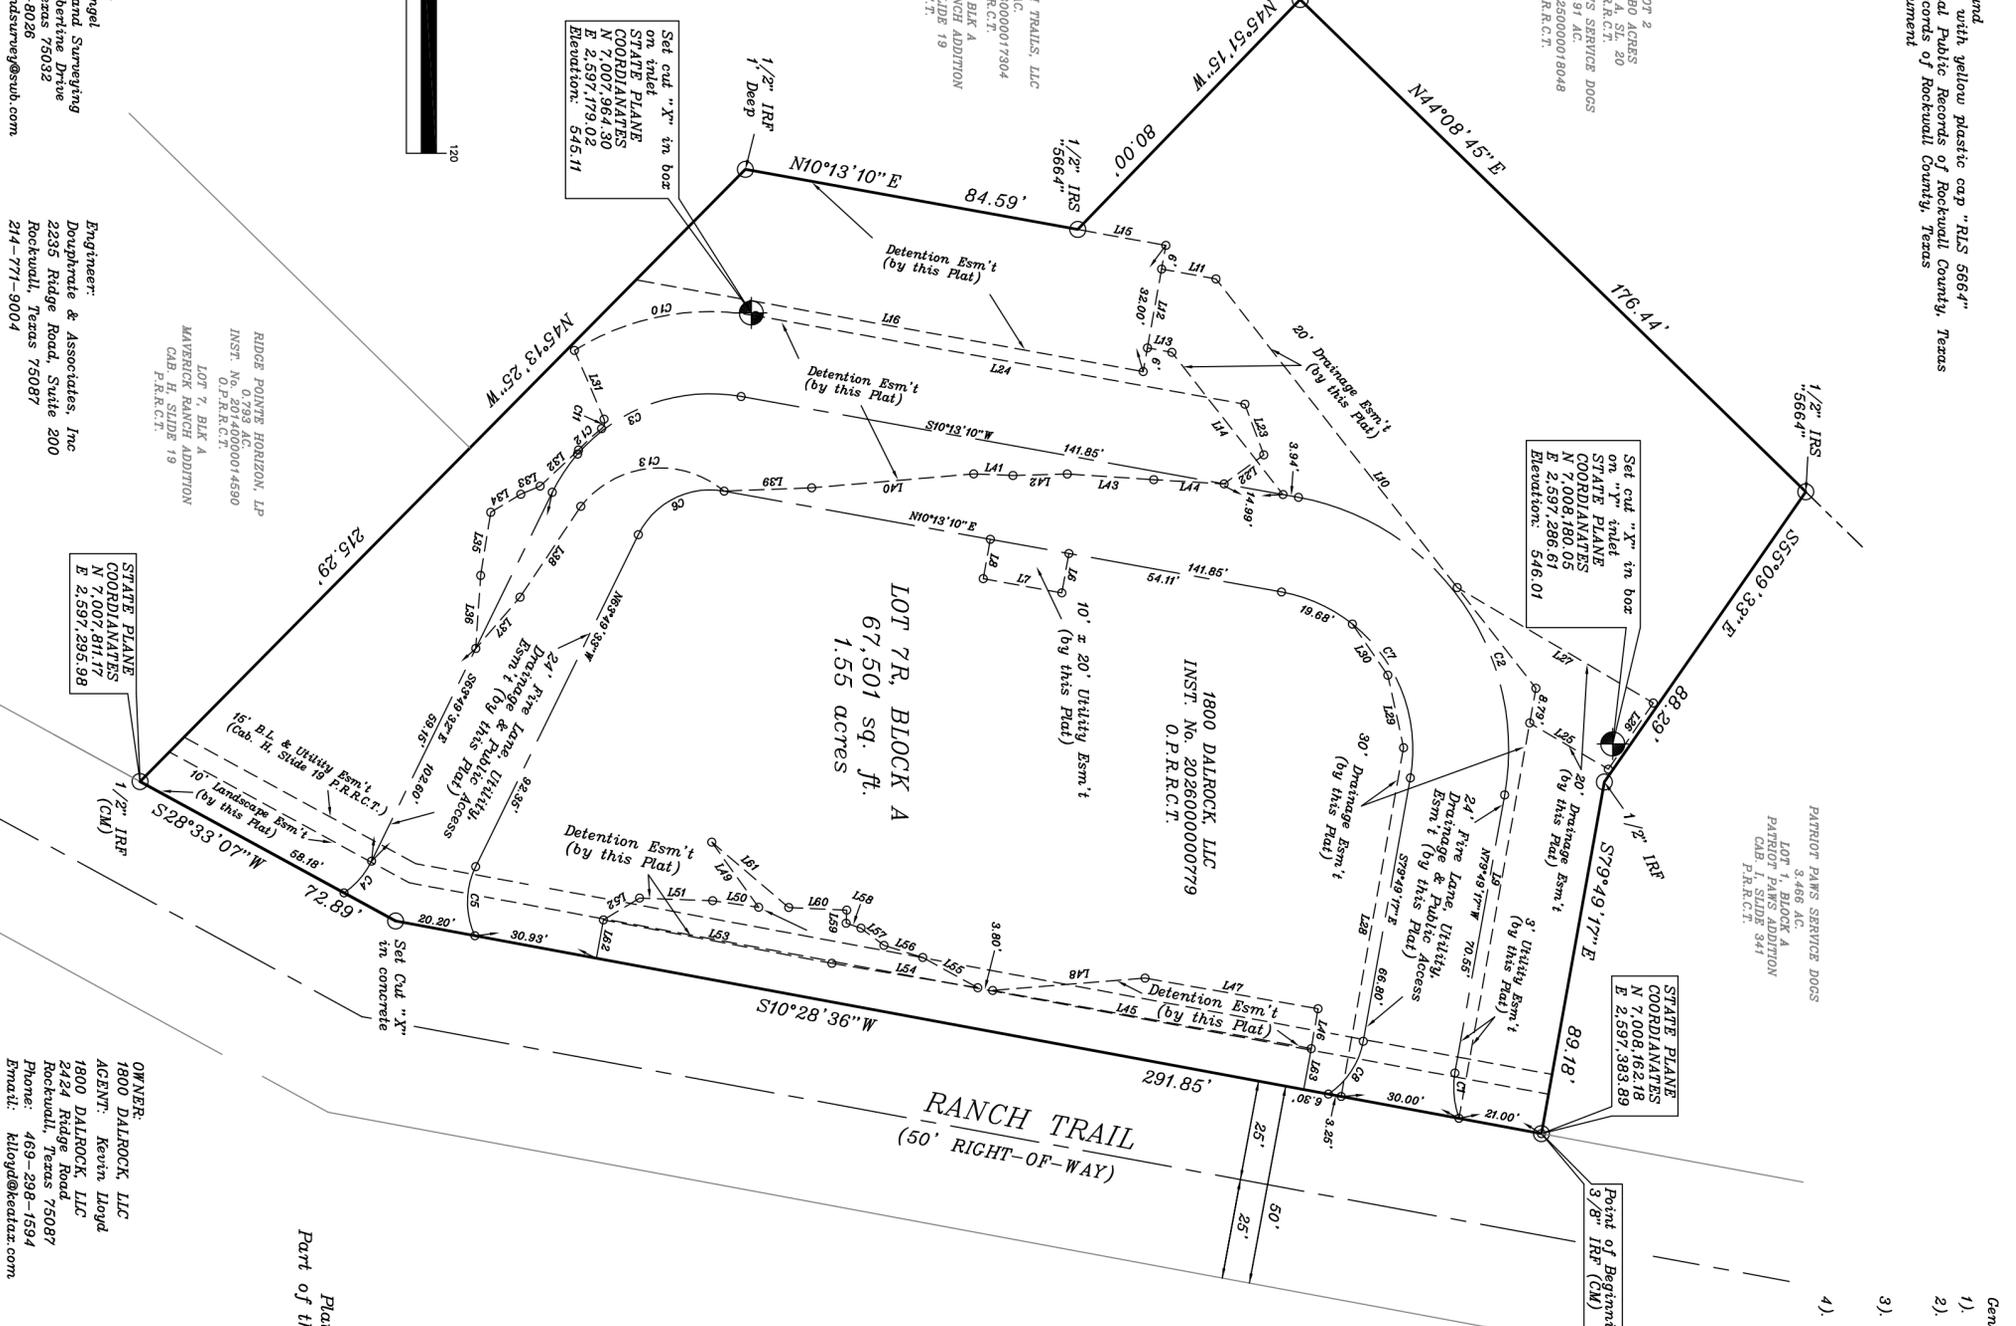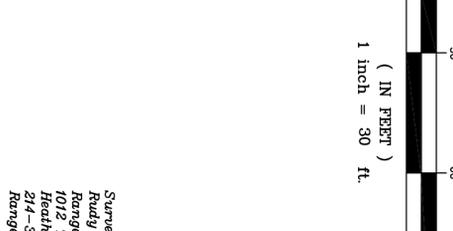

**FINAL PLAT**  
**LOT 7R, BLOCK A**  
 A REPLAT OF  
**LOT 7, BLOCK A**  
**MAVERICK RANCH ADDITION**  
 Document No. 2020000019968  
 Records of Rockwall County, Texas  
 Part of the William Ford Survey, Abstract No. 80  
**CITY OF ROCKWALL**  
**ROCKWALL COUNTY, TEXAS**

SHEET 1 OF 2  
 Date: 02-16-2026  
 CITY CASE No. \_\_\_\_\_

- General Notes:**
- 1) The purpose of this plat is to create easements.
  - 2) The Coordinates (SIC TXNC 4202) shown hereon North American Datum of 1983 on Grid Coordinate Values, no scale and no projection.
  - 3) According to the F.I.R.M. in Map No. 4839700401, This property does lie in Zone X and does not lie with the 100 year flood zone.
  - 4) Property owner shall be responsible for all maintenance, Repair and Replacement of all Drainage and Detention Basements on site.

Note: Basis of Bearings  
 Northern line of Lots 7 & 8  
 Block A, Maverick Ranch Addition  
 Inst. No. 2020000021169 O.P.R.C.T.

**Surveyor:**  
 Rudy Rungel  
 Rungel Land Surveying  
 1012 Timberline Drive  
 Rockwall, Texas 75082  
 214-325-8028  
 Rungelrlandsurvey@sub.com

**Engineer:**  
 Douglas & Associates, Inc  
 2235 Ridge Road, Suite 200  
 Rockwall, Texas 75087  
 214-771-8004

**OWNER:**  
 1800 DALROCK, LLC  
 AGENT: Kevin Lloyd  
 1800 DALROCK, LLC  
 2424 Ridge Road 75087  
 Rockwall, Texas 75087  
 Phone: 469-298-1594  
 Email: klloyd@keatiz.com

STATE OF TEXAS  
COUNTY OF ROCKWALL

OWNERS CERTIFICATE

Whereas, 1800 DALROCK, LLC is the owner of a 1.55 acre tract of land being Lot 7, Block A of the MAVERICK RANCH ADDITION, a replat of Lot 5, Block A as recorded in Document No. 20200000019968 of the Plat Records of Rockwall County, Texas

Being all of said Lot 7, Block A and being situated in the William W. Ford Survey, Abstract No. 80, City of Rockwall, Rockwall County, Texas;

BEGINNING at a  $\frac{3}{4}$ " iron rod found for the northeast corner of said Lot 5, Block A, said point also being the southeast corner of Lot 1, Block A of the PATRIOT PALS addition as recorded in Cabinet 1, Slide 341 of the Plat Records of Rockwall County, Texas and said point being on the west right-of-way line of Ranch Trail (50' wide right-of-way);

THENCE South 10°28'36" West along the said west right-of-way line, a distance of 291.85' to a set out "x" in concrete for a corner. THENCE South 28°33'07" West continuing along said west right-of-way line, a distance of 72.89' to a  $\frac{1}{2}$ " iron rod found for a corner, said point also being the northeast corner of Lot 7, Block A of the MAVERICK RANCH addition as recorded in Instrument No. 2020000002169 of the Official Public Records of Rockwall County, Texas;

THENCE North 45°13'25" West leaving said west right-of-way line and along the north line of Lots 7 & 8, Block A of said MAVERICK RANCH Addition, a distance of 215.29' to a  $\frac{1}{2}$ " iron rod found for a corner;

THENCE North 10°13'10" East along the northeastern line of said Lot 8, a distance of 84.59' to a  $\frac{1}{2}$ " iron rod set with a yellow plastic cap stamped "RLS 5664" for a corner;

THENCE North 45°51'15" West along the northern line of said Lot 8, a distance of 80.00' to a  $\frac{1}{2}$ " iron rod set with a yellow plastic cap stamped "RLS 5664" for a corner, said point also being on the easterly line of Lot 2 of the Rancho Acres Addition, an addition to the City of Rockwall as recorded in Cabinet 4, Slide 20 of the Plat Records of Rockwall County, Texas;

THENCE North 44°08'45" East along the easterly line of said Lot 2, a distance of 176.44' to a  $\frac{1}{2}$ " iron rod set with a yellow plastic cap stamped "RLS 5664" for a corner, said point being an ell corner of Lot 1, Block A of said PATRIOT PALS addition, THENCE South 55°09'33" East along the southerly line of said PATRIOT PALS addition, a distance of 88.29' to a  $\frac{1}{2}$ " iron rod found for a corner.

THENCE South 79°49'17" East a distance of 89.18' to the POINT OF BEGINNING and containing 1.55 acres or 67,501 square feet of land. OWNER'S CERTIFICATE.

NOW, THEREFORE, KNOW ALL MEN BY THESE PRESENTS:

That 1800 DALROCK, LLC, the undersigned owner of the land shown on this plat, and designated herein as Lot 7R, Block A, MAVERICK RANCH Addition, a subdivision of the City of Rockwall, Texas, and whose name is subscribed hereto, hereby dedicate to the use of the public forever all streets, alleys, paths, water courses, drains, easements and public places thereon shown on the purpose and consideration therein expressed. I further certify that all other parties who have a mortgage or lien interest in the Lot 9, Block A, MAVERICK RANCH subdivision have been notified and signed this plat. I understand and do hereby reserve the easement strips shown on this plat for the purposes stated and for the mutual use and accommodation of all utilities desiring to use or using same. I also understand the following:

1. No buildings shall be constructed or placed upon, over, or across the utility easements as described herein.
2. Any public utility shall have the right to remove and keep removed all or part of any buildings, fences, trees, shrubs, or other growths or improvements which in any way endanger or interfere with construction, maintenance or efficiency of their respective system on any of these easement strips; and any public utility shall at all times have the right of ingress or egress to, from and upon said easement strips for purpose of construction, reconstruction, inspecting, patrolling, maintaining, and either adding to or removing all or part of their respective system without the necessity of, at any time, procuring the permission of anyone.
3. The City of Rockwall will not be responsible for any claims of any nature resulting from or occasioned by the establishment of grade of steers in the subdivision.
4. The developer and subdivision engineer shall bear total responsibility for storm drain improvements.
5. The developer shall be responsible for the necessary facilities to provide drainage patterns and drainage controls such that properties within the drainage area are not adversely affected by the storm drainage from the development.
6. No house dwelling unit, or other structure shall be constructed on any lot in this addition by the owner or any other person until the developer and/or owner has complied with all requirements of the Subdivision Regulations of the City of Rockwall regarding improvements with respect to the entire block on the street or streets on which the property abuts, including the actual installation of streets with the required base and paving, curb and gutter, water and sewer, drainage structures, storm structures, storm sewer, and alleys, all according to the specifications of the City of Rockwall; or Until an escrow deposit sufficient to pay for the cost of such improvements, as determined by the city's engineer and/or city administrator compiled on a private commercial rate basis, has been made by the city secretary, accompanied by an agreement signed by the developer and/or owner, authorizing the city to make such improvements at prevailing private commercial rates, or have the same made by a contractor and pay for the same out of the escrow deposit, should the developer and/or owner fail or refuse to install the required improvements within the time specified in such a written agreement, but in no case shall the city be obligated to make such improvements itself. Such deposit may be used by the owner and/or developer to progress payments as the work progresses in making such improvements by making certified requests to the city secretary, supported by evidence of work done, or Until the developer and/or owner files a corporate surety bond with the city secretary in a sum equal to the cost of such improvements for the designated area, guaranteeing the installation thereof within the time stated in the bond, which time shall be fixed by the city council of the City of Rockwall.
7. Property owners are responsible for maintenance, repair, and replacement of all retaining walls and drainage and detention systems in easements.

I further acknowledge that the dedications and/or erection's made herein are proportional to the impact of the Subdivision upon the public services required in order that the development will comport with the present and future growth needs of the City. I, my successors and assigns hereby waive any claim, damage, or cause of action that I may have as a result of dedication of easements made herein.

FOR: 1800 DALROCK, LLC

By: \_\_\_\_\_  
FOR: \_\_\_\_\_ (LIEN HOLDER)

By: \_\_\_\_\_ NAME: \_\_\_\_\_

TITLE: \_\_\_\_\_

NOTARY CERTIFICATE

STATE OF \_\_\_\_\_

COUNTY OF \_\_\_\_\_

Before me, the undersigned authority, a Notary Public in and for the said County and State on this day personally appeared \_\_\_\_\_ known to me to be the person whose name is subscribed to the foregoing instrument and acknowledged to me that he/she executed the same for the purposes and considerations therein expressed and in the capacity therein stated and as the act and deed therein stated. Given under my hand and seal of office, this \_\_\_\_\_ day of \_\_\_\_\_, 2026.

Notary Signature \_\_\_\_\_

GENERAL NOTES

1. Selling a portion of this addition by metes and bounds is unlawful and a violation of the Subdivision Ordinance of the City of Rockwall and Chapter 212, Municipal Regulation of Subdivision and Property Development, of the Texas Local Government Code, and shall be subject to the City of Rockwall withholding utilities and building permits.
2. It shall be the policy of the City of Rockwall to withhold issuing building permits until all streets, water, sewer and storm drainage systems have been accepted by the City. The approval of the subdivision plat by the City of Rockwall does not constitute any representation, assurance or guarantee that any building within such subdivision plat shall be approved, authorized, or permit issued, nor shall such approval constitute any representation, assurance or guarantee by the City of Rockwall of the adequacy and availability for water and sanitary sewer for personal use and fire protection within such subdivision plat, as required under the Subdivision Ordinance of the City of Rockwall.
3. The property owner shall be responsible for maintaining, repairing and replacing and shall bear sole liability of all systems within the drainage and detention easements.
4. All Fire Lanes will be constructed, maintained, repaired and replaced by the property owner. Fire lanes shall be constructed in accordance with the approval of Civil Engineering Plans for both on-site and off-site Fire Lane improvements.
5. All decorative signage, post, or lights installed in public right-of-way shall be installed, maintained, repaired, and replaced by the Homeowner's Association (HOA).

APPROVAL CERTIFICATE

APPROVED:

I hereby certify that the above and foregoing plat of an addition to the City of Rockwall, Texas, was approved by the City Council of the City of Rockwall on the \_\_\_\_\_ day of \_\_\_\_\_, 2026.

This approval shall be invalid unless the approved plat for such addition is recorded in the office of the County Clerk of Rockwall, County, Texas, within one hundred and eighty (90) days from said date of final approval.

MAYOR OF THE CITY OF ROCKWALL \_\_\_\_\_ PLANNING AND ZONING CHAIRMAN  
CITY SECRETARY \_\_\_\_\_ CITY ENGINEER

SURVEYOR'S CERTIFICATE

NOW, THEREFORE KNOW ALL MEN BY THESE PRESENTS:

That I Rudy Rangel, do hereby certify that this plat was prepared from an actual and accurate survey of the land, and that the corner monuments shown thereon were properly placed under my personal supervision.

GIVEN UNDER MY HAND AND SEAL THIS \_\_\_\_\_ DAY \_\_\_\_\_, 2026.

RUDDY RANGEL  
REGISTERED PROFESSIONAL LAND SURVEYOR  
STATE OF TEXAS NO. 5664  
TBP15 No. 10077100

NOTARY CERTIFICATE

STATE OF \_\_\_\_\_  
COUNTY OF \_\_\_\_\_

Before me, the undersigned authority, a Notary Public in and for the said County and State on this day personally appeared \_\_\_\_\_ known to me to be the person whose name is subscribed to the foregoing instrument and acknowledged to me that he/she executed the same for the purposes and considerations therein expressed and in the capacity therein stated and as the act and deed therein stated.

Given under my hand and seal of office, this \_\_\_\_\_ day of \_\_\_\_\_, 2026.

Notary Signature \_\_\_\_\_

FINAL PLAT  
LOT 7R, BLOCK A  
A REPLAT OF  
LOT 7, BLOCK A  
MAVERICK RANCH ADDITION  
Document No. 20200000019968  
Plat Records of Rockwall County, Texas  
Part of the William Ford Survey, Abstract No. 80  
CITY OF ROCKWALL  
ROCKWALL COUNTY, TEXAS

Surveyor:  
Rudy Rangel  
Rangel Land Surveying  
1012 Timberline Drive  
Heath, Texas 75032  
214-325-8026  
Rangelandsurvey@sub.com


Engineer:  
Douphrate & Associates, Inc  
2255 Ridge Road, Suite 200  
Rockwall, Texas 75087  
214-771-9004

OWNER:  
1800 DALROCK, LLC  
AGENT: Kevin Lloyd  
1800 DALROCK, LLC  
2424 Ridge Road  
Rockwall, Texas 75087  
Phone: 469-298-1594  
Email: klloyd@keatex.com

SHEET 2 OF 2  
Date: 02-16-2026

CITY CASE No. \_\_\_\_\_



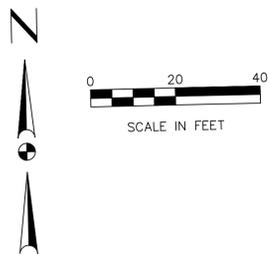

KUMAR ATUL  
2.27 AC.  
RAINBO ACRES  
CAB. A. SL. 20  
P.R.R.C.T.

CURVE TABLE					
CURVE	DELTA	RADIUS	TANGENT	LENGTH	BEARING
C1	74°04'00"	32.00'	24.14'	41.37'	N26°48'50"W
C2	89°57'34"	52.00'	51.96'	81.64'	N55°11'56"E

PATRIOT PAWS SERVICE DOGS  
3.466 AC.  
LOT 1, BLOCK A  
PATRIOT DOGS ADDITION  
VOL. 2014, PG. 0000006979

- LEGEND:
- ⊗ WATER MAIN VALVE
  - ⊕ FIRE HYDRANT
  - SSCO SANITARY SEWER CLEAN-OUT
  - ⊙ SANITARY SEWER MANHOLE
  - ⊖ POWER POLE
  - IRF IRON ROD FOUND
  - WM WATER METER
  - CLF = Chainlink Fence
  - OHL OVERHEAD POWER
  - UGE UNDERGROUND ELECTRIC

BC= BACK OF CURB  
PAVED AREA WITHIN RIGHT OF WAY SHALL BE  
8" 3600 PSI W/ MINIMUM OF 6.5 SACK MIX  
SEE TYP PAVEMENT SECTION DETAIL FOR FIRE, TRUCK, & ROW THIS SHEET

NOTE: FOR PAVING DESIGNS SEE COVER SHEET GENERAL NOTES  
LINE ITEM NO 4 FOR FIRE LANE, RIGHT OF WAY, AND PARKING PAVING  
LINE ITEM NO 5 FOR SIDEWALK PAVING

CURB CUT FOR  
DETENTION WEIR NO 1  
SEE SH 4.1 FOR DETAILS

ALL RESPONSIBILITY FOR ADEQUACY OF DESIGN REMAINS  
WITH THE DESIGN ENGINEER. THE CITY OF ROCKWALL, IN  
REVIEWING AND RELEASING PLANS FOR CONSTRUCTION,  
ASSUMES NO RESPONSIBILITY FOR ADEQUACY OR  
ACCURACY OF DESIGN.

CURB CUT FOR  
DETENTION WEIR NO 2  
SEE SH 4.1 FOR DETAILS

INSTALL 2' WIDE 4" INVERTED CONC. PILOT FLUME  
SEE DETAIL ON DIMENSION CONTROL SHEET

1.550 AC.  
67,502 SQ. FT.

REVISED TO CONFORM TO CONSTRUCTION RECORDS.  
DATE: 2-17-26

CASE NO. SP 2024-003



DOUPHRATE & ASSOCIATES, INC.  
ENGINEERING + PROJECT MANAGEMENT + SURVEYING  
2235 RIDGE RD., # 200 ROCKWALL, TEXAS 75087  
PHONE: (972)771-9004 FAX: (972)771-9005

DIMENSION CONTROL AND PAVING PLAN  
LOT 5, BLOCK A  
MAVERICK RANCH ADDITION  
CITY ROCKWALL  
ROCKWALL COUNTY, TEXAS

REVISION	WLD.
CHECKED	G.C.W.
DRAWN	
SCALE	1" = 20'
DATE	MAY 5, 2024
PROJECT	23028
	30

### TYPICAL PAVING SECTION

**SIDEWALK:**  
4" - 3000 PSI 5.5 Sack Concrete Pvmt w/ #3 Bars at 24" O.C.E.W.  
4" COMPACTED SUBGRADE

**PARKING AREAS:**  
5"-3000 PSI 5.5 Sack Concrete Pvmt w/ #3 Bars at 24" O.C.E.W.  
6" Subgrade compacted at 98% Standard Proctor Density at or Near Optimum Moisture Content.

**FIRE, TRUCK LANES, & ROW :**  
6" - 3,600 PSI 6.5 Sack Concrete Pavement with #3 Bars at 24" O.C.E.W.  
6" Lime Stabilized Subgrade compacted at 98% Standard Proctor Density at or Near Optimum Moisture Content.


**DUMPSTER:**  
7" - 3,600 PSI 6.5 Sack Concrete Pvmt with #3 Bars at 24" O.C.E.W.  
6" Lime Stabilized Subgrade compacted at 98% Standard Proctor Density at or Near Optimum Moisture Content.

DUMPSTER WITH SELF LATCHING  
SCREENING ENCLOSURE & OIL WATER SEPARATOR  
PAVED AREA WITHIN 15'X15' DUMPSTER PAD SHALL BE  
7" 3600 PSI W/ MINIMUM OF 6.5 SACK MIX

TEXAS RANCH TRAILS, LLC  
PART OF LOT 6, BLK A  
1.32 AC.  
VOL. 2016, PG. 0000017304

RIDGE POINTE HORIZON, LP  
0.793 AC.  
PART OF LOT 6, BLK A  
MAVERICK RANCH  
VOL. 2014, PG. 0000014590

SPC TXNC 4202  
N 7007811.27  
E 2597295.72

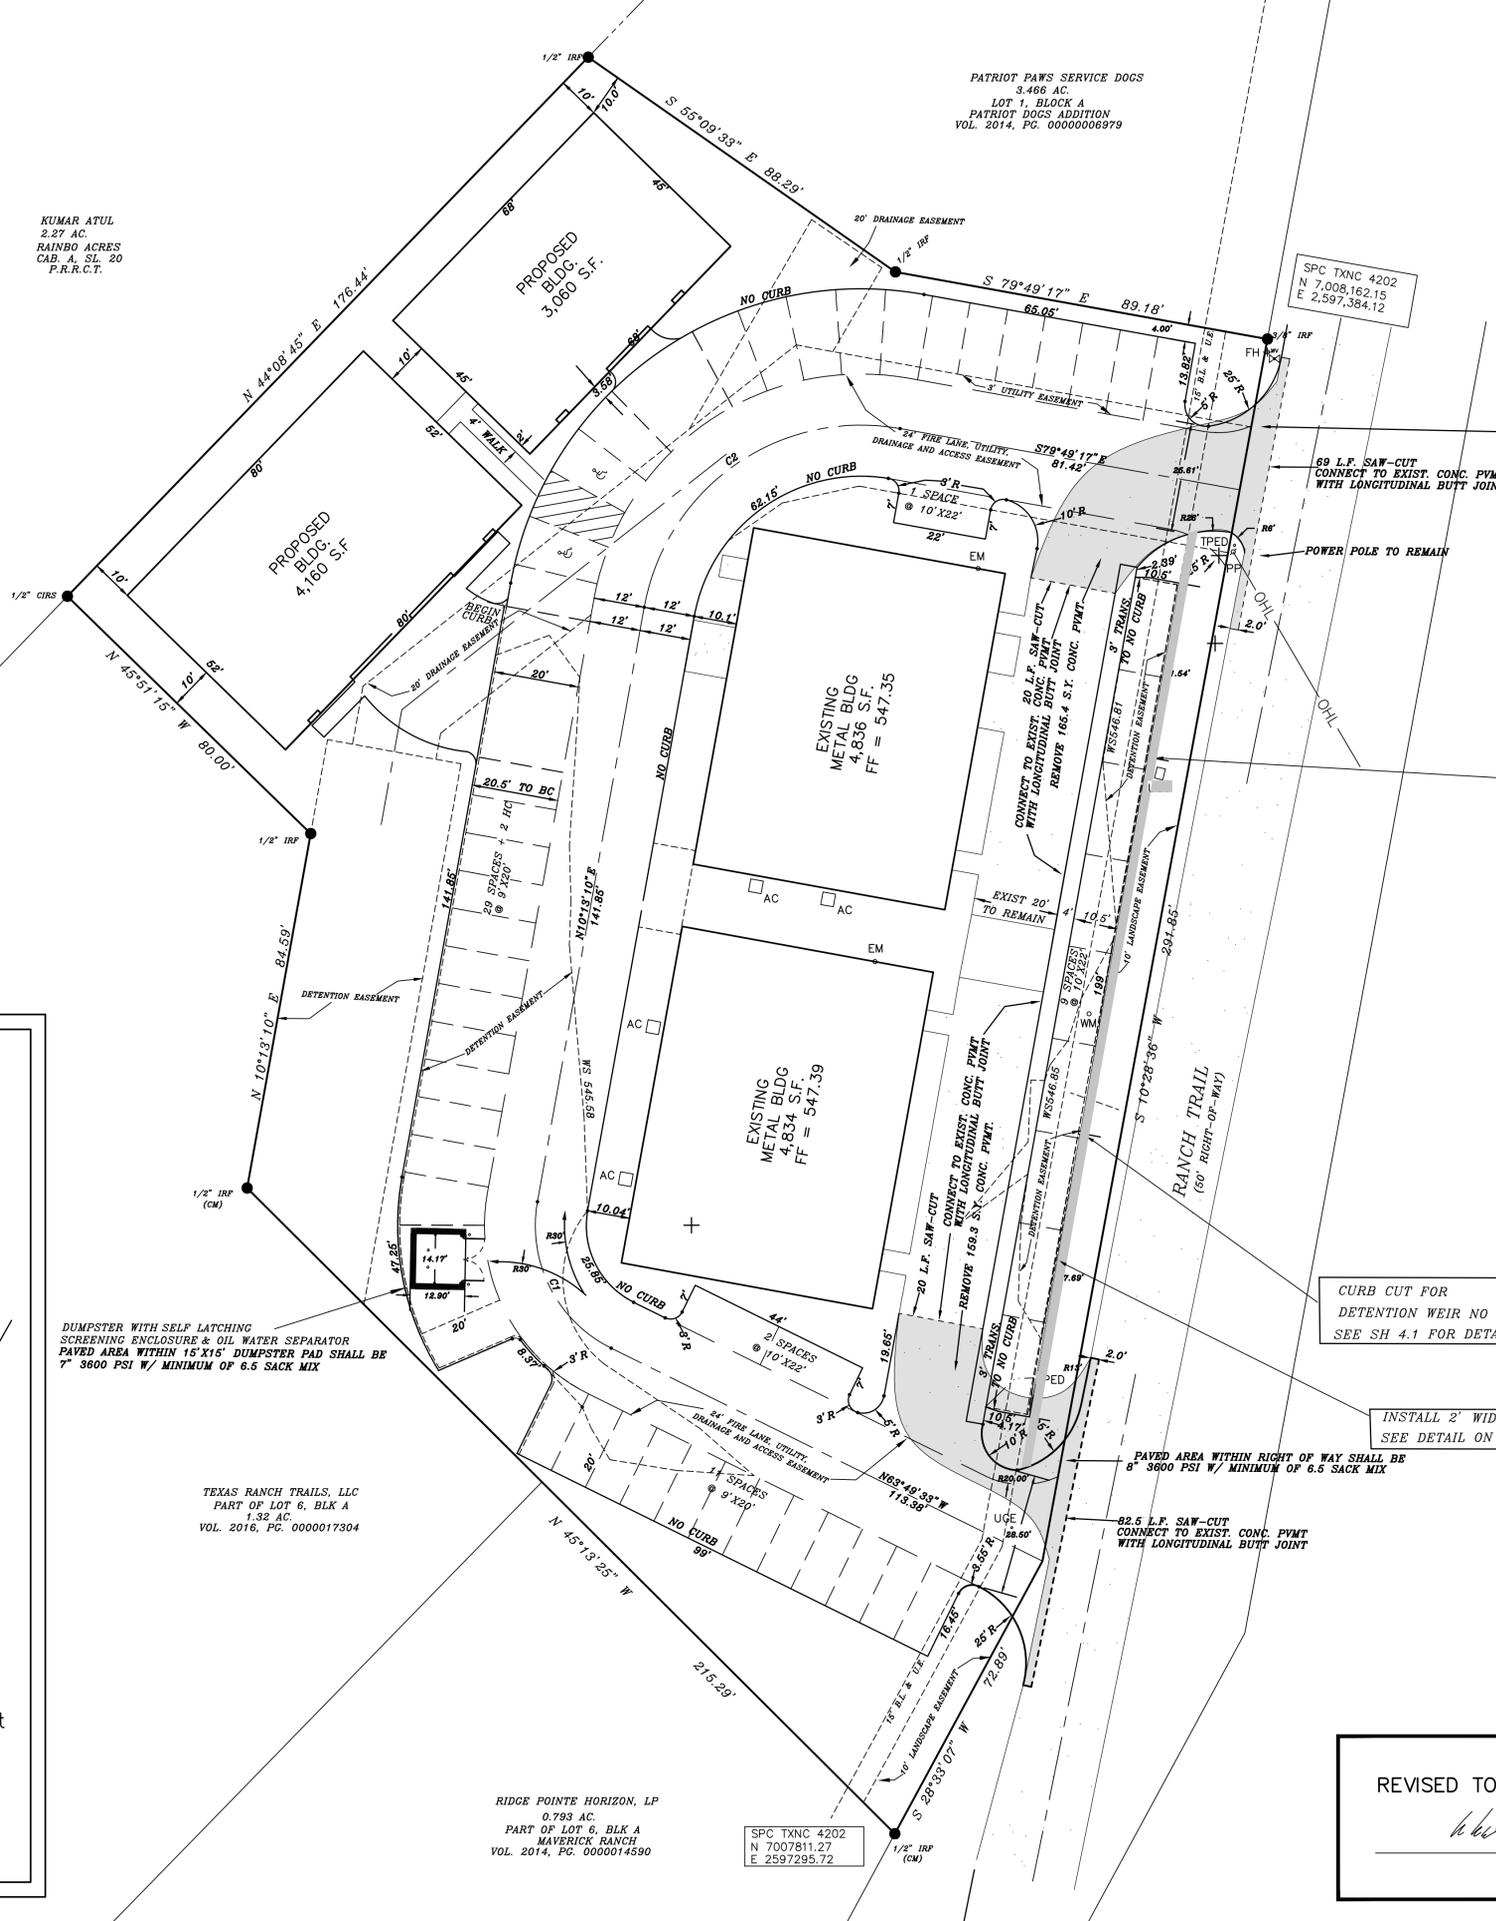



0 40 80  
SCALE IN FEET

1.550 AC.  
67,502 SQ. FT.

KUMARATUL  
2.97 AC.  
RAINING ACRES  
CAB. & SL. 20  
P.L.C.T.

PATRIOT PAWS SERVICE DOGS  
8.486 AC.  
LOT 1, BLOCK A  
PATRIOT DOGS ADDITION  
VOL. 2014, P.C. 0000008978

TEXAS RANCH TRAILS, LLC  
PART OF LOT 9, BLK. A  
1.52 AC.  
VOL. 2016, P.C. 000017304

RIDGE POINTS HORIZON, LP  
0.792 AC.  
PART OF LOT 6, BLK. A  
MAVERICK RANCH  
VOL. 2014, P.C. 000014880

POI-2

POI-1

EXISTING METABOLIC METABOLIC  
4,834 SQ. FT.  
FF = 547.35

EXISTING METABOLIC METABOLIC  
4,836 SQ. FT.  
FF = 547.35

EXISTING METABOLIC METABOLIC  
4,834 SQ. FT.  
FF = 547.39

EXISTING METABOLIC METABOLIC  
4,836 SQ. FT.  
FF = 547.35

PRE-CONSTRUCTION DRAINAGE TABLE

DRAINAGE AREA NO.	ACRES	T.C.	C	I 100 YR.	Q 100 YR.	SUM Q 100 YR.	COMMENTS
1	0.71	10	0.35	9.8	2.44	2.44	
2	0.24	"	0.90	"	2.12	4.56*	*POI-2 ALLOWED DISCHARGED
3	0.32	"	0.90	"	2.78	2.78	
4	0.07	"	0.35	"	0.24	3.02	
5	0.10	"	0.35	"	0.34	3.36	
6	0.14	"	0.35	"	0.48	3.84*	*POI-1 ALLOWED DISCHARGED

PRE- CONSTRUCTION CONDITIONS TOTAL ALLOWABLE RELEASE RATE FOR POI-1= 3.84 CFS  
PRE- CONSTRUCTION CONDITIONS TOTAL ALLOWABLE RELEASE RATE FOR POI-2= 4.56 CFS

ALL RESPONSIBILITY FOR ADEQUACY OF DESIGN REMAINS WITH THE DESIGN ENGINEER. THE CITY OF ROCKWALL, IN REVIEWING AND RELEASING PLANS FOR CONSTRUCTION, ASSUMES NO RESPONSIBILITY FOR ADEQUACY OR ACCURACY OF DESIGN.

REVISED TO CONFORM TO CONSTRUCTION RECORDS.

*W.D. [Signature]* DATE: 2-17-26




THE SEAL APPEARING ON THIS DOCUMENT WAS AUTHORIZED BY W.D. DOUPHRADE II, TEXAS P.E. NO. 60102, F-886, ON MAY 5, 2024.

**DOUPHRADE & ASSOCIATES, INC.**  
ENGINEERING-PROJECT MANAGEMENT SURVEYING  
2235 RIDGE RD., # 200 ROCKWALL, TEXAS 75087  
PHONE: (972)771-9004 FAX: (972)771-9005

EXISTING DRAINAGE AREA MAP  
LOT 5, BLOCK A  
MAVERICK RANCH ADDITION  
CITY ROCKWALL  
ROCKWALL COUNTY, TEXAS

REVISION	WLD.
CHECKED	GCV.
DRAWN	
SCALE	1" = 30'H
DATE	MAY, 2024
PROJECT	23028
	40

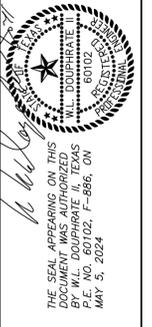

DOUPHRATE & ASSOCIATES, INC.  
 ENGINEERING - PROJECT MANAGEMENT - SURVEYING  
 2235 RIDGE RD., # 200 ROCKWALL, TEXAS 75087  
 PHONE: (972)771-9004 FAX: (972)771-9005

DRAINAGE AREA MAP / WEIR DETAILS 1 & 2  
 LOT 5, BLOCK A  
 MAVERICK RANCH ADDITION  
 CITY ROCKWALL  
 ROCKWALL COUNTY, TEXAS

REVISION  
 W.L.D.  
 CHECKED  
 GCW.  
 DRAWN  
 SCALE  
 1" = 30'H  
 1" = V  
 DATE  
 MAY, 2024  
 PROJECT  
 23028  
 41

- LEGEND:
- ⊕ WATER MAIN VALVE
  - ⊕ FIRE HYDRANT
  - SSCO SANITARY SEWER CLEAN-OUT
  - ⊕ SANITARY SEWER MANHOLE
  - ⊕ POWER POLE
  - IRF IRON ROD FOUND
  - WM WATER METER
  - CLF = Chainlink Fence
  - OHL OVERHEAD POWER
  - UGE UNDERGROUND ELECTRIC

REVISED TO CONFORM TO CONSTRUCTION RECORDS.  
 DATE: 2-17-26

ALL RESPONSIBILITY FOR ADEQUACY OF DESIGN REMAINS WITH THE DESIGN ENGINEER. THE CITY OF ROCKWALL, IN REVIEWING AND RELEASING PLANS FOR CONSTRUCTION, ASSUMES NO RESPONSIBILITY FOR ADEQUACY OR ACCURACY OF DESIGN.

POST-CONSTRUCTION DRAINAGE TABLE


DRAINAGE AREA NO.	ACRES	T.C.	C	I 100 YR.	Q 100 YR.	SUM Q 100 YR.	COMMENTS
1	0.02	10	0.9	9.8	0.18	0.18	DETAINED WEIR 1
2	0.02	"	0.9	"	0.18	0.36	DETAINED WEIR 2
3	0.004	"	0.9	"	0.04	0.36	(BYPASS)
4	0.03	"	0.9	"	0.26	0.63	(BYPASS)
5	0.09	"	0.9	"	0.79	1.42	(BYPASS)
6	0.03	"	0.9	"	0.26	1.68	(BYPASS)
7	0.04	"	0.9	"	0.35	2.03	(BYPASS)
8	0.11	"	0.9	"	0.97	3.00	PASS THROUGH (BYPASS)
9	0.13	"	0.9	"	1.15	4.15	PASS THROUGH (BYPASS)
10	0.18	"	0.9	"	1.59	1.59	PASS THROUGH (BYPASS)
11	0.24	"	0.9	"	3.00	4.59	DETAINED AT WEIR 4
12	0.23	"	0.9	"	0.26	4.85	DETAINED AT WEIR 4
13	0.60	"	0.9	"	5.29	10.14	DETAINED AT WEIR 5

PRE- CONSTRUCTION EXIST CONDITIONS TOTAL ALLOWABLE RELEASE RATE FOR POI-1= 3.84 CFS  
 TOTAL DETAINED FOR POI-1 = 4.15 CFS ( DEVELOPED AREAS 1-9) - 3.84 (RELEASE ALLOWED) = .31 CFS  
 WEIR NO 1 AND WEIR NO 2 WILL EACH DETAIN .16 CFS  
 THEREFORE ALLOWABLE RELEASE RATE FOR WEIR NO 1 (AREAS 8 & 1) = 1.15- .16= .99 CFS  
 ALLOWABLE RELEASE RATE FOR WEIR NO 2 (AREAS 9 & 2) = 1.33- .16= 1.17 CFS

PRE- CONSTRUCTION CONDITIONS TOTAL ALLOWABLE RELEASE RATE FOR POI-2= 4.56 CFS  
 TOTAL DETAINED FOR POI-2 = 10.14 CFS (DEVELOPED AREAS 10,11,12, & 13)- 4.56(RELEASE ALLOWED)= 5.58 CFS  
 THEREFORE COMBINED ALLOWABLE RELEASE RATE FOR WEIR NOs 4 & 5 (AREAS 10-13) = 4.56 cfs

DETENTION WEIR NO 1

DETENTION WEIR NO 2

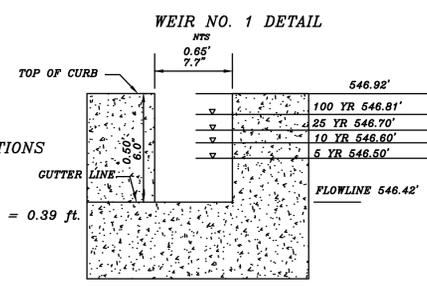


WEIR NO. 1 CALCULATIONS  
 Rectangular Suppressed Weir  
 $Q = 3.33 h_1^{3/2} L$   
 $h_1 = \text{Height of Weir} = 4.7 \text{ in.} = 0.39 \text{ ft.}$   
 $L = \text{Length of Weir}$   
 $.99 = 3.33 (.39)^{1.5} L$   
 $L = 1.23 \text{ ft.} = 14.8 \text{ in.}$

AREAS DETAINED 1 & 8  
 AREAS PREDEVELOPED PASS THROUGH 8  
 DETENTION REQUIRED - 274 cf  
 DETENTION PROVIDED - 274 cf  
 Q DETAINED THRU WEIR= .16 cfs

STORAGE VOLUME STAGE

STORM	d	ELEVATION	VOLUME	Qallowable	Qactual
5 YR	0.08	546.5 ft	102.5 cf	.67 cfs	.67 cfs
10 YR	0.18	546.6 ft	108.7 cf	.79 cfs	.79 cfs
25 YR	0.29	546.7 ft	135.0 cf	.90 cfs	.90 cfs
100 YR	0.39	546.8 ft	202.0 cf	.99 cfs	.99 cfs

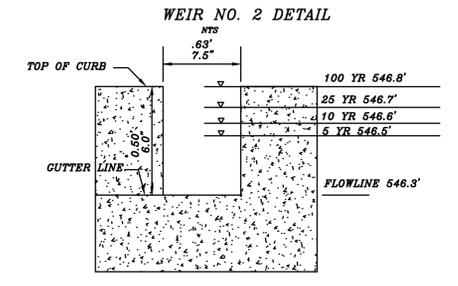


WEIR NO. 2 CALCULATIONS  
 Rectangular Suppressed Weir  
 $Q = 3.33 h_1^{3/2} L$   
 $h_1 = \text{Height of Weir} = 6.0 \text{ in.} = 0.5 \text{ ft.}$   
 $L = \text{Length of Weir}$   
 $1.17 = 3.33 (.50)^{1.5} L$   
 $L = .99 \text{ ft.} = 11.9 \text{ in.}$

AREAS DETAINED 2 & 9  
 AREAS PREDEVELOPED PASS THROUGH 9  
 DETENTION REQUIRED - 292 cf  
 DETENTION PROVIDED - 292 cf  
 Q DETAINED THRU WEIR= .16 CFS

STORAGE VOLUME STAGE

STORM	d	ELEVATION	VOLUME	Qallowable	Qactual
5 YR	0.20	546.5 ft	126.6 cf	.76 cfs	.76 cfs
10 YR	0.30	546.6 ft	133.0 cf	.90 cfs	.90 cfs
25 YR	0.40	546.7 ft	167.0 cf	1.0 cfs	1.0 cfs
100 YR	0.50	546.8 ft	246.5 cf	1.17 cfs	1.17 cfs

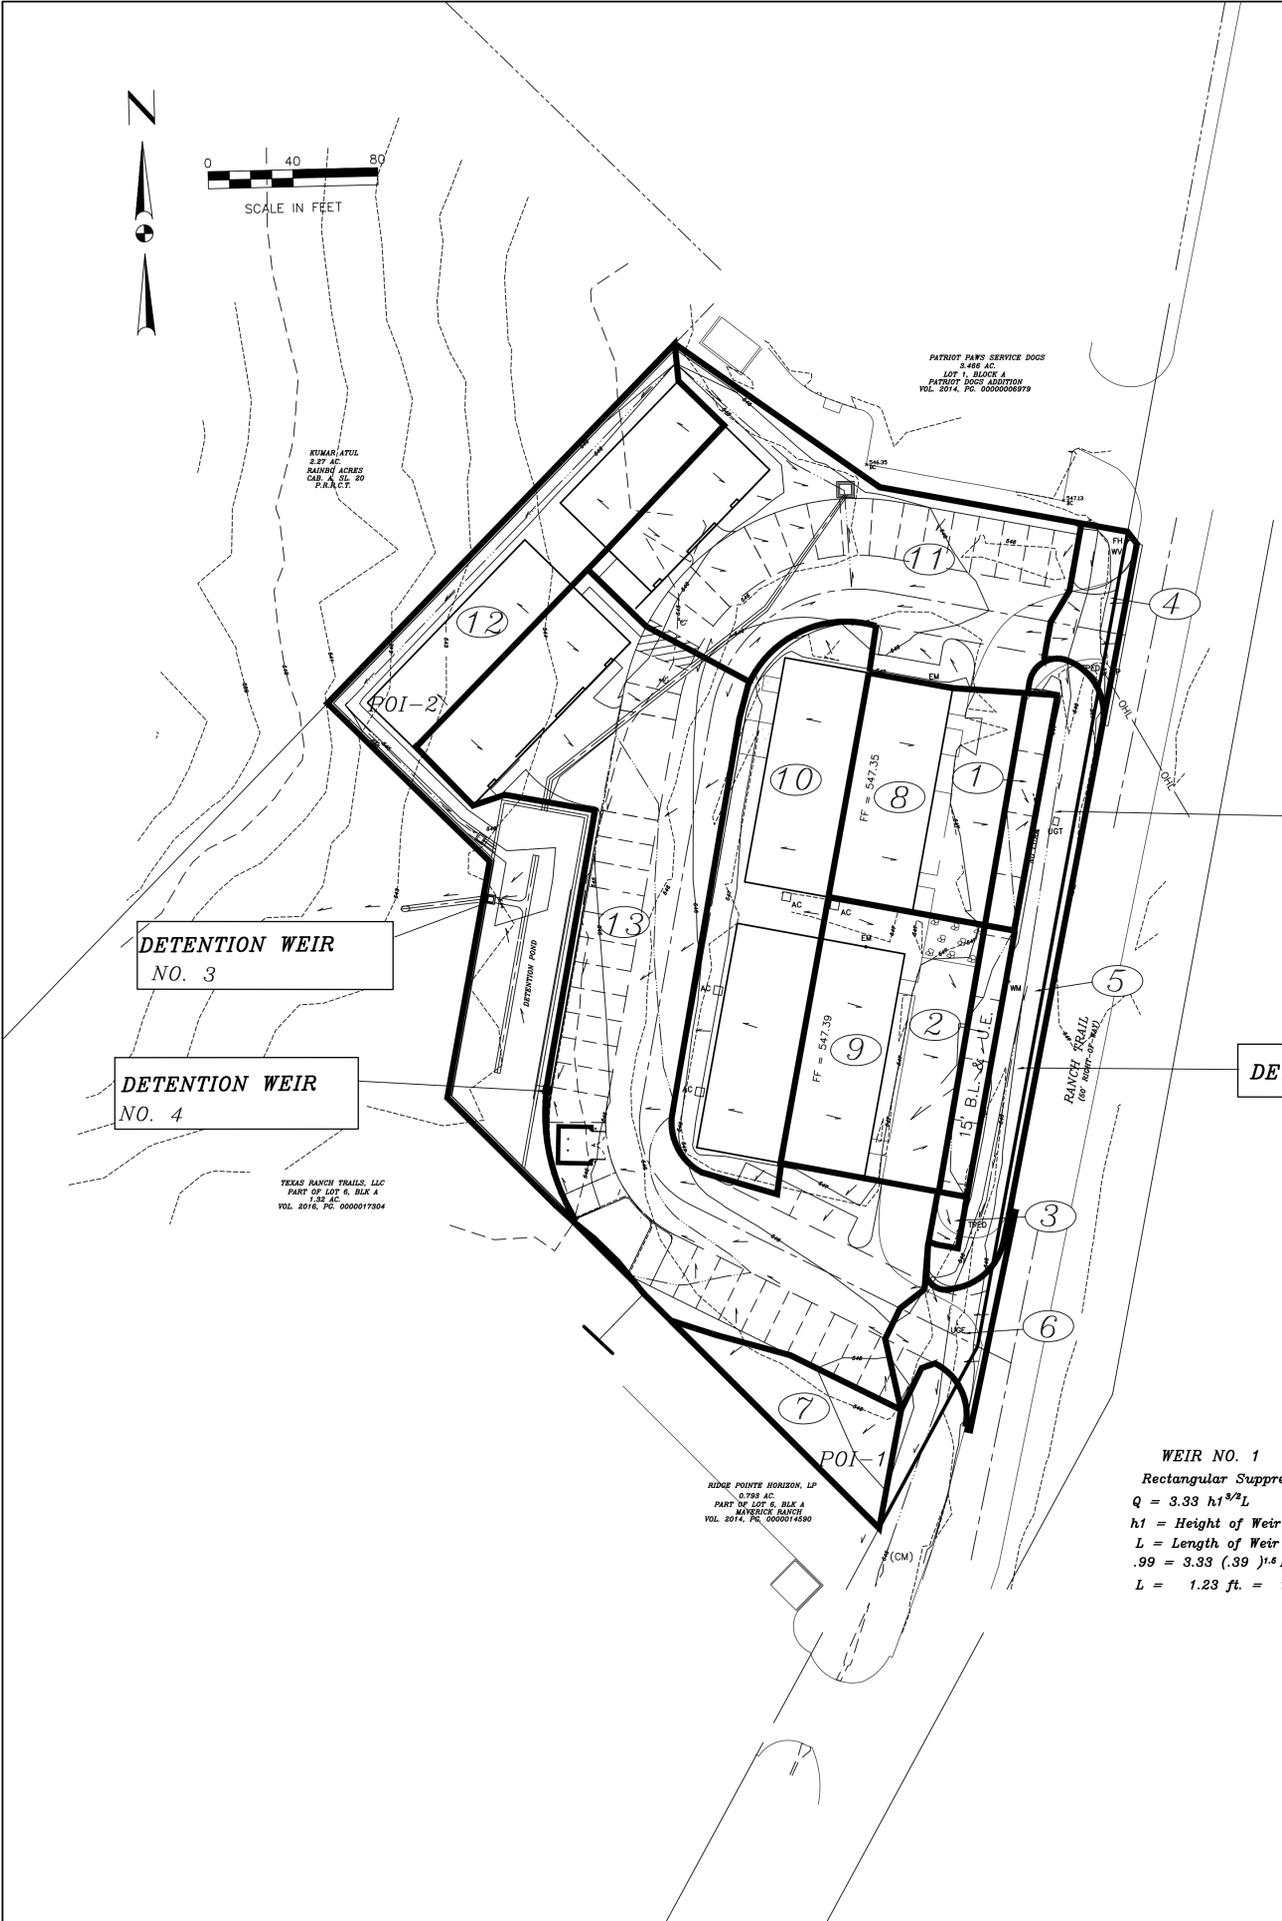

SCALE IN FEET  
 0 40 80



PATRIOT PAWS SERVICE DOGS  
 3.468 AC.  
 ADD. 1. BLOCK A  
 PATRIOT DOGS ADDITION  
 VOL. 2014, P.C. 0000006979

KUMAR-ATUL  
 2.87 AC.  
 RAINBOW ACRES  
 SUB. A, SEC. 20  
 P.R.A.C.T.

TEXAS RANCH TRAILS, LLC  
 PART OF LOT 6, BLK A  
 1.58 AC.  
 VOL. 2016, P.C. 000017304

RIDGE POINTE HORIZON, LP  
 0.793 AC.  
 PART OF LOT 6, BLK A  
 MAVERICK RANCH  
 VOL. 2014, P.C. 000014890

WEIR NO 3 DETAIL

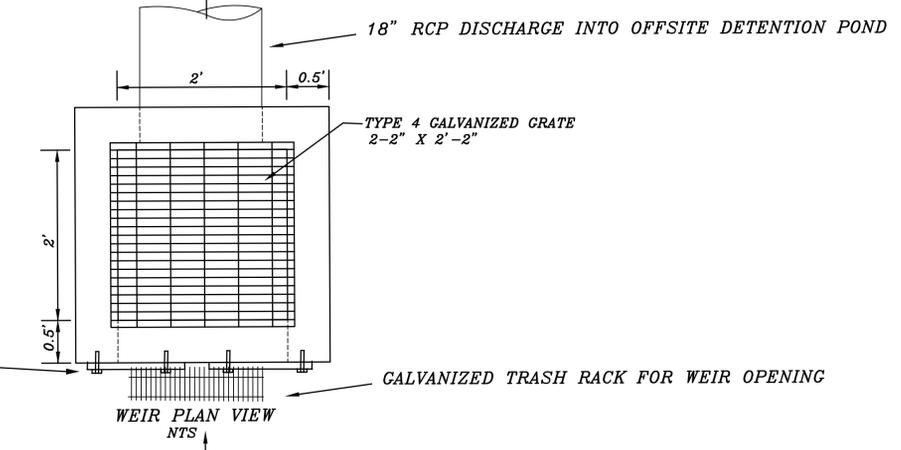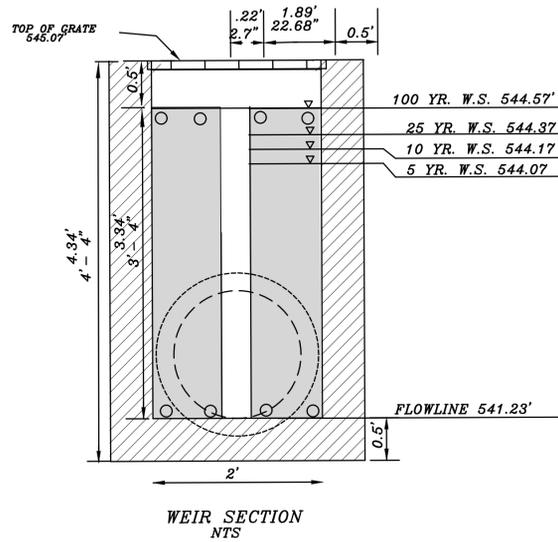

DETENTION REQUIRED - 1698 cf BYPASSED (AT WEIR 4) + 3592 cf (DA 11 & 12) = 5290 cf  
 DETENTION PROVIDED - 9315 cf

ALLOWABLE Q DISCHARGE THRU WEIR = 4.56 cfs

DETENTION POND NO. 3 OVER DETAINS 1698 cf FOR VOLUME OVERFLOW AT WEIR 4

WEIR NO 3 CALCULATIONS

Rectangular Suppressed Weir

$$Q = 3.33 h^{1.5} (L)$$

Q = Exist. Conditions Flowrate = 4.56 cfs  
 h1 = Height of Weir at 100 yr elev = 3.34' = 3' ft - 4" in.  
 L = Length of Weir



$$4.56 = 3.33 (3.34)^{1.5} (L)$$

$$L = 0.22 \text{ ft.} = 2.7 \text{ in.}$$

STORM	d	ELEVATION	VOLUME	Qallowable	Qactual
5 YR	2.84	544.07ft	1845 cf	1.81 cfs	1.81 cfs
10 YR	2.94	544.17ft	2082 cf	2.13 cfs	2.13 cfs
25 YR	3.14	544.37ft	2593 cf	2.43 cfs	2.43 cfs
100 YR	3.34	544.57ft	5290 cf	4.56 cfs	4.56 cfs

ALL RESPONSIBILITY FOR ADEQUACY OF DESIGN REMAINS WITH THE DESIGN ENGINEER. THE CITY OF ROCKWALL, IN REVIEWING AND RELEASING PLANS FOR CONSTRUCTION, ASSUMES NO RESPONSIBILITY FOR ADEQUACY OR ACCURACY OF DESIGN.

CURB INLET / WEIR NO. 4 DETAIL

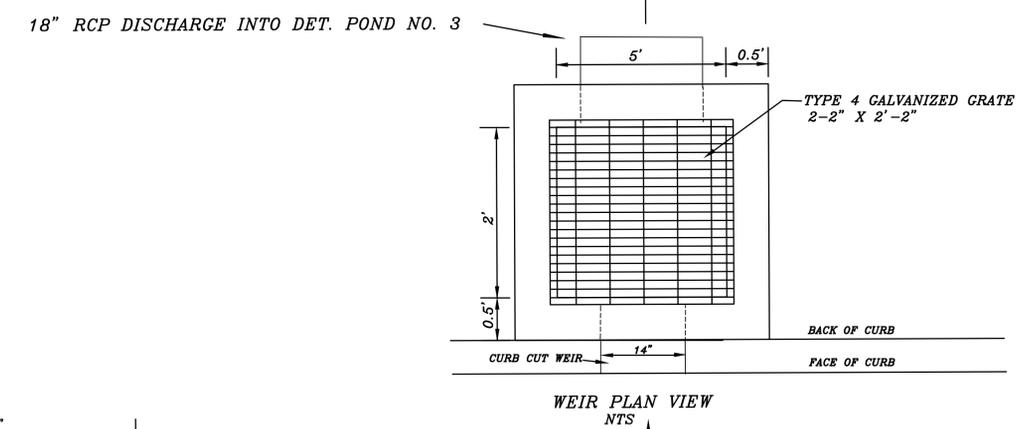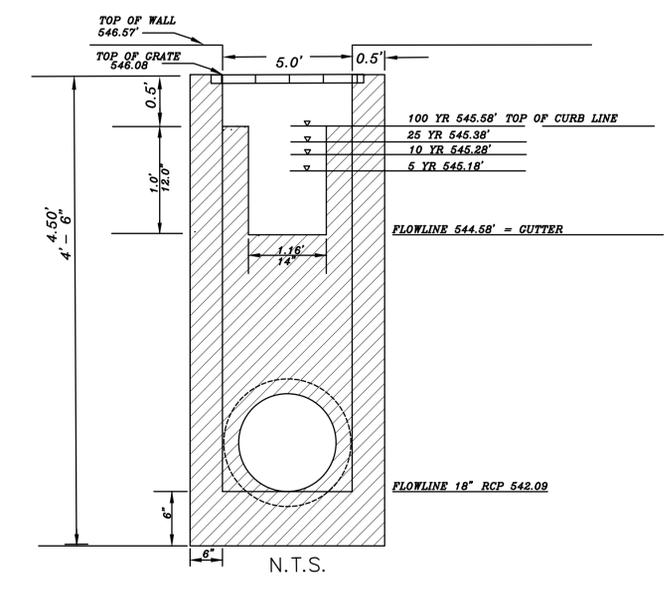

DETENTION REQUIRED - 3858 cf (DA 10 & 13)  
 DETENTION PROVIDED - 2160 cf  
 DETENTION VOLUME BYPASSED - 1698 cf  
 Q BYPASSED = 1698/3858 X 6.88 cfs (Developed Flow) = 3.03 cfs  
 Q DETAINED THRU WEIR = 6.88 - 3.03 = 3.85 cfs

DETENTION POND NO. 3 OVER DETAINS 1698 cf FOR VOLUME OVERFLOW AT WEIR 4

WEIR NO. 4 CALCULATIONS

Rectangular Suppressed Weir


$$Q = 3.33 h^{1.5} (L - 2h1)$$

Q = Exist. Conditions Flowrate Allowed = 4.05 cfs  
 h1 = Height of Weir = 12 in. = 1.0 ft.  
 L = Length of Weir

$$3.85 = 3.33 (1.00)^{1.5} (L)$$

$$L = 1.16 \text{ ft.} = 13.9 \text{ in.}$$

STORM	d	ELEVATION	VOLUME	Qallowable	Qactual
5 YR	0.60	545.2 ft	1360 cf	2.52cfs	2.52cfs
10 YR	0.70	545.3 ft	1555 cf	2.98cfs	2.98cfs
25 YR	0.80	545.4 ft	1928 cf	3.39cfs	3.39 cfs
100 YR	1.00	545.6 ft	2160 cf	4.0cfs	3.85cfs

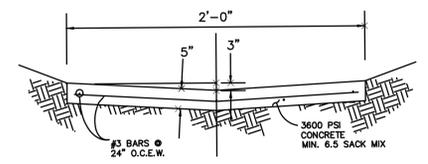

2' CONC. PILOT CHANNEL BOTTOM  
 FOR DET POND NO. 3  
 SEE GRADING SHT 6.0

REVISED TO CONFORM TO CONSTRUCTION RECORDS.  
 DATE: 2-17-26



DOUPHRATE & ASSOCIATES, INC.  
 ENGINEERING PROJECT MANAGEMENT SURVEYING  
 2235 RIDGE RD., # 200 ROCKWALL, TEXAS 75087  
 PHONE: (972)771-9004 FAX: (972)771-9005

WEIR DETAILS 3 & 4, CONC. PILOT FLUME  
 LOT 5, BLOCK A  
 MAVERICK RANCH ADDITION  
 CITY ROCKWALL  
 ROCKWALL COUNTY, TEXAS

REVISION  
 WLD.  
 CHECKED  
 GCW.  
 DRAWN  
 SCALE  
 1" = 30'  
 DATE  
 MAY, 2024  
 PROJECT  
 23028  
 4.2

**RANCH TRAIL  
5 YR STORM CALCULATIONS**

Present Conditions  
Q=CIA

A =	0.13	Areas 1 & 8 Detained
C =	0.777	Composite C Factor = .777
Tc =	10	
I5 =	6.1	
Q5 =	0.616161	

Future Conditions (Developed)		Offsite Conditions (Undeveloped)		Bypass	
A =	0.13	A =	0	A =	0
Aadj =	0.13				
C =	0.9	C =	0.9	C =	0.9
Tc =	10	Tc =	10	Tc =	10
I5 =	6.1	I5 =	6.1	I5 =	6.1
Q5 =	0.7137	Q5 =	0	Q5 =	0

Flow for Storm Durations (Developed)				Flow for Storm Durations (Offsite)			
Time	I	C	Q	Time	I	C	Q
10 min	6.1	0.9	0.7137	10 min	6.1	0.9	0
15 min	5.5	0.9	0.6435	15 min	5.5	0.9	0
20 min	5	0.9	0.585	20 min	5	0.9	0
30 min	4	0.9	0.468	30 min	4	0.9	0
40 min	3.4	0.9	0.3978	40 min	3.4	0.9	0
50 min	2.9	0.9	0.3393	50 min	2.9	0.9	0
60 min	2.6	0.9	0.3042	60 min	2.6	0.9	0
70 min	2.4	0.9	0.2808	70 min	2.4	0.9	0
80 min	2.2	0.9	0.2574	80 min	2.2	0.9	0
90 min	2	0.9	0.234	90 min	2	0.9	0
100 min	1.8	0.9	0.2106	100 min	1.8	0.9	0
110 min	1.7	0.9	0.1989	110 min	1.7	0.9	0

**Storage Calculations**

Time	Inflow	Outflow	Storage
10 min	428.22	369.6966	58.5234
15 min	579.15	462.1208	117.0293
20 min	702	554.5449	147.4551
30 min	842.4	739.3932	103.0068
40 min	954.72	924.2415	30.4785
50 min	1017.9	1109.09	-91.1898
60 min	1095.12	1293.938	-198.818
70 min	1179.36	1478.786	-299.426
80 min	1235.52	1663.635	-428.115
90 min	1263.6	1848.483	-584.883
100 min	1263.6	2033.331	-769.731
110 min	1193.4	2218.18	-1024.78

**RANCH TRAIL  
10 YR STORM CALCULATIONS**

Present Conditions  
Q=CIA

A =	0.13	Areas 1 & 8 Detained
C =	0.777	Composite C Factor = .777
Tc =	10	
I10 =	7.2	
Q10 =	0.727272	

Future Conditions (Developed)		Offsite Conditions (Undeveloped)		Bypass	
A =	0.13	A =	0	A =	0
Aadj =	0.13				
C =	0.9	C =	0.5	C =	0.9
Tc =	10	Tc =	10	Tc =	10
I10 =	7.2	I10 =	7.2	I10 =	7.2
Q10 =	0.8424	Q10 =	0	Q10 =	0

Flow for Storm Durations (Developed)				Flow for Storm Durations (Offsite)			
Time	I	C	Q	Time	I	C	Q
10 min	7.2	0.9	0.8424	10 min	7.2	0.5	0
15 min	6.5	0.9	0.7605	15 min	6.5	0.5	0
20 min	5.8	0.9	0.6786	20 min	5.8	0.5	0
30 min	4.7	0.9	0.5499	30 min	4.7	0.5	0
40 min	4	0.9	0.468	40 min	4	0.5	0
50 min	3.5	0.9	0.4095	50 min	3.5	0.5	0
60 min	3	0.9	0.351	60 min	3	0.5	0
70 min	2.7	0.9	0.3159	70 min	2.7	0.5	0
80 min	2.5	0.9	0.2925	80 min	2.5	0.5	0
90 min	2.3	0.9	0.2691	90 min	2.3	0.5	0
100 min	2.2	0.9	0.2574	100 min	2.2	0.5	0
110 min	1.9	0.9	0.2223	110 min	1.9	0.5	0

**Storage Calculations**

Time	Inflow	Outflow	Storage
10 min	505.44	436.3632	69.0768
15 min	684.45	545.454	138.996
20 min	814.32	654.5448	159.7752
30 min	989.82	872.7264	117.0936
40 min	1123.2	1090.908	32.292
50 min	1228.5	1309.09	-80.5896
60 min	1263.6	1527.271	-263.671
70 min	1326.78	1745.453	-418.673
80 min	1404	1963.634	-559.634
90 min	1453.14	2181.816	-728.676
100 min	1544.4	2399.998	-855.598
110 min	1333.8	2618.179	-1284.38

**RANCH TRAIL  
25 YR STORM CALCULATIONS**

Present Conditions  
Q=CIA

A =	0.13	Areas 1 & 8 Detained
C =	0.777	Composite C Factor = .777
Tc =	10	
I25 =	8.2	
Q25 =	0.828282	

Future Conditions (Developed)		Offsite Conditions (Undeveloped)		Bypass	
A =	0.13	A =	0	A =	0
Aadj =	0.13				
C =	0.9	C =	0.5	C =	0.9
Tc =	10	Tc =	10	Tc =	10
I25 =	8.2	I25 =	8.2	I25 =	8.2
Q25 =	0.9594	Q25 =	0	Q25 =	0

Flow for Storm Durations (Developed)				Flow for Storm Durations (Offsite)			
Time	I	C	Q	Time	I	C	Q
10 min	8.2	0.9	0.9594	10 min	8.2	0.5	0
15 min	7.5	0.9	0.8775	15 min	7.5	0.5	0
20 min	6.7	0.9	0.7839	20 min	6.7	0.5	0
30 min	5.5	0.9	0.6435	30 min	5.5	0.5	0
40 min	4.7	0.9	0.5499	40 min	4.7	0.5	0
50 min	4	0.9	0.468	50 min	4	0.5	0
60 min	3.5	0.9	0.4095	60 min	3.5	0.5	0
70 min	3.2	0.9	0.3744	70 min	3.2	0.5	0
80 min	2.7	0.9	0.3159	80 min	2.7	0.5	0
90 min	2.5	0.9	0.2925	90 min	2.5	0.5	0
100 min	2.4	0.9	0.2808	100 min	2.4	0.5	0
110 min	2.3	0.9	0.2691	110 min	2.3	0.5	0

**Storage Calculations**

Time	Inflow	Outflow	Storage
10 min	575.64	496.9692	78.6708
15 min	789.75	621.2115	168.5385
20 min	940.68	745.4538	195.2262
30 min	1158.3	993.9384	164.3616
40 min	1319.76	1242.423	77.337
50 min	1404	1490.908	-86.9076
60 min	1474.2	1739.392	-265.192
70 min	1572.48	1987.877	-415.397
80 min	1516.32	2236.361	-720.041
90 min	1579.5	2484.846	-905.346
100 min	1684.8	2733.331	-1048.53
110 min	1614.6	2981.815	-1367.22

**RANCH TRAIL  
100 YR STORM CALCULATIONS**

Present Conditions  
Q=CIA

A =	0.13	Areas 1 & 8 Detained
C =	0.777	Composite C Factor = .777
Tc =	10	
I100 =	9.8	
Q100 =	0.989898	

Future Conditions (Developed)		Offsite Conditions (Undeveloped)		Bypass	
A =	0.13	A =	0	A =	0
Aadj =	0.13				
C =	0.9	C =	0.5	C =	0.9
Tc =	10	Tc =	10	Tc =	10
I100 =	9.8	I100 =	9.8	I100 =	9.8
Q100 =	1.1466	Q100 =	0	Q100 =	0

Flow for Storm Durations (Developed)				Flow for Storm Durations (Offsite)			
Time	I	C	Q	Time	I	C	Q
10 min	9.8	0.9	1.1466	10 min	9.8	0.5	0
15 min	9	0.9	1.053	15 min	9	0.5	0
20 min	8.3	0.9	0.9711	20 min	8.3	0.5	0
30 min	6.9	0.9	0.8073	30 min	6.9	0.5	0
40 min	5.8	0.9	0.6786	40 min	5.8	0.5	0
50 min	5	0.9	0.585	50 min	5	0.5	0
60 min	4.5	0.9	0.5265	60 min	4.5	0.5	0
70 min	4	0.9	0.468	70 min	4	0.5	0
80 min	3.7	0.9	0.4329	80 min	3.7	0.5	0
90 min	3.5	0.9	0.4095	90 min	3.5	0.5	0
100 min	3.4	0.9	0.3978	100 min	3.3	0.5	0
110 min	3.2	0.9	0.3744	110 min	2.9	0.5	0

**Storage Calculations**

Time	Inflow	Outflow	Storage
10 min	687.96	593.9388	94.0212
15 min	947.7	742.4235	205.2765
20 min	1165.32	890.9082	274.4118
30 min	1453.14	1187.878	265.2624
40 min	1628.64	1484.847	143.793
50 min	1755	1781.816	-26.8164
60 min	1895.4	2078.786	-183.386
70 min	1965.6	2375.755	-410.155
80 min	2077.92	2672.725	-594.805
90 min	2211.3	2969.694	-758.394
100 min	2386.8	3266.663	-879.863
110 min	2246.4	3563.633	-1317.23



THE SEAL APPEARING ON THIS DOCUMENT WAS AUTHORIZED BY W.L. DOUPHRAE II TEXAS P.E. NO. 60102, EXPIRES ON DATE: MAY 3, 2024

**DOUPHRAE & ASSOCIATES, INC.**  
ENGINEERING - PROJECT MANAGEMENT - SURVEYING  
2235 RIDGE RD., # 200 ROCKWALL, TEXAS 75087  
PHONE: (972)771-8004 FAX: (972)771-8005

**DRAINAGE DETENTION CALCULATIONS WEIR NO 1**  
RANCH TRAIL OFFICES  
CITY OF ROCKWALL  
ROCKWALL COUNTY, TEXAS

REVISION  
**W.L.D.**  
CHECKED  
**GC.W.**  
DRAWN  
SCALE  
1" = 50' H  
1" = 10' V  
DATE  
**MAY, 2024**  
PROJECT  
**23028**  
50

REVISED TO CONFORM TO CONSTRUCTION RECORDS.  
*W.L. Douphrate* DATE: 2-17-26

**RANCH TRAIL  
5 YR STORM CALCULATIONS**

Present Conditions  
Q=CIA

A =	0.15	Areas 2 & 9 Detained
C =	0.796	Composite C Factor = .796
Tc =	10	
I5 =	6.1	
Q5 =	0.72834	

Future Conditions (Developed)			Offsite Conditions (Undeveloped)			Bypass		
A =	0.15		A =	0		A =	0	
Aadj =	0.15							
C =	0.9		C =	0.5		C =	0.9	
Tc =	10		Tc =	10		Tc =	10	
I5 =	6.1		I5 =	6.1		I5 =	6.1	
Q5 =	0.8235		Q5 =	0		Q5 =	0	

Flow for Storm Durations (Developed)				Flow for Storm Durations (Offsite)			
Time	I	C	Q	Time	I	C	Q
10 min	6.1	0.9	0.8235	10 min	6.1	0.5	0
15 min	5.5	0.9	0.7425	15 min	5.5	0.5	0
20 min	5	0.9	0.675	20 min	5	0.5	0
30 min	4	0.9	0.54	30 min	4	0.5	0
40 min	3.4	0.9	0.459	40 min	3.4	0.5	0
50 min	2.9	0.9	0.3915	50 min	2.9	0.5	0
60 min	2.6	0.9	0.351	60 min	2.6	0.5	0
70 min	2.4	0.9	0.324	70 min	2.4	0.5	0
80 min	2.2	0.9	0.297	80 min	2.2	0.5	0
90 min	2	0.9	0.27	90 min	2	0.5	0
100 min	1.8	0.9	0.243	100 min	1.8	0.5	0
110 min	1.7	0.9	0.2295	110 min	1.7	0.5	0

Storage Calculations

Time	Inflow	Storage	Outflow
10 min	494.1	57.096	437.004
15 min	668.25	121.995	546.255
20 min	810	154.494	655.506
30 min	972	97.992	874.008
40 min	1101.6	9.09	1092.51
50 min	1174.5	-136.512	1311.012
60 min	1263.6	-265.914	1529.514
70 min	1360.8	-387.216	1748.016
80 min	1425.6	-540.918	1966.518
90 min	1458	-727.02	2185.02
100 min	1458	-945.522	2403.522
110 min	1377	-1245.02	2622.024

**RANCH TRAIL  
10 YR STORM CALCULATIONS**

Present Conditions  
Q=CIA

A =	0.15	Areas 2 & 9 Detained
C =	0.796	Composite C Factor = .796
Tc =	10	
I10 =	7.2	
Q10 =	0.85968	

Future Conditions (Developed)			Offsite Conditions (Undeveloped)			Bypass		
A =	0.15		A =	0		A =	0	
Aadj =	0.15							
C =	0.9		C =	0.5		C =	0.9	
Tc =	10		Tc =	10		Tc =	10	
I10 =	7.2		I10 =	7.2		I10 =	7.2	
Q10 =	0.972		Q10 =	0		Q10 =	0	

Flow for Storm Durations (Developed)				Flow for Storm Durations (Offsite)			
Time	I	C	Q	Time	I	C	Q
10 min	7.2	0.9	0.972	10 min	7.2	0.5	0
15 min	6.5	0.9	0.8775	15 min	6.5	0.5	0
20 min	5.8	0.9	0.783	20 min	5.8	0.5	0
30 min	4.7	0.9	0.6345	30 min	4.7	0.5	0
40 min	4	0.9	0.54	40 min	4	0.5	0
50 min	3.5	0.9	0.4725	50 min	3.5	0.5	0
60 min	3	0.9	0.405	60 min	3	0.5	0
70 min	2.7	0.9	0.3645	70 min	2.7	0.5	0
80 min	2.5	0.9	0.3375	80 min	2.5	0.5	0
90 min	2.3	0.9	0.3105	90 min	2.3	0.5	0
100 min	2.2	0.9	0.297	100 min	2.2	0.5	0
110 min	1.9	0.9	0.2565	110 min	1.9	0.5	0

Storage Calculations

Time	Inflow	Storage	Outflow
10 min	583.2	67.392	515.808
15 min	789.75	144.99	644.76
20 min	939.6	165.888	773.712
30 min	1142.1	110.484	1031.616
40 min	1296	6.48	1289.52
50 min	1417.5	-129.924	1547.424
60 min	1458	-347.328	1805.328
70 min	1530.9	-532.332	2063.232
80 min	1620	-701.136	2321.136
90 min	1676.7	-902.34	2579.04
100 min	1782	-1054.94	2836.944
110 min	1539	-1555.85	3094.848

**RANCH TRAIL  
25 YR STORM CALCULATIONS**

Present Conditions  
Q=CIA

A =	0.15	Areas 2 & 9 Detained
C =	0.796	Composite C Factor = .796
Tc =	10	
I25 =	8.2	
Q25 =	0.97908	

Future Conditions (Developed)			Offsite Conditions (Undeveloped)			Bypass		
A =	0.15		A =	0		A =	0	
Aadj =	0.15							
C =	0.9		C =	0.5		C =	0.9	
Tc =	10		Tc =	10		Tc =	10	
I25 =	8.2		I25 =	8.2		I25 =	8.2	
Q25 =	1.107		Q25 =	0		Q25 =	0	

Flow for Storm Durations (Developed)				Flow for Storm Durations (Offsite)			
Time	I	C	Q	Time	I	C	Q
10 min	8.2	0.9	1.107	10 min	8.2	0.5	0
15 min	7.5	0.9	1.0125	15 min	7.5	0.5	0
20 min	6.7	0.9	0.9045	20 min	6.7	0.5	0
30 min	5.5	0.9	0.7425	30 min	5.5	0.5	0
40 min	4.7	0.9	0.6345	40 min	4.7	0.5	0
50 min	4	0.9	0.54	50 min	4	0.5	0
60 min	3.5	0.9	0.4725	60 min	3.5	0.5	0
70 min	3.2	0.9	0.432	70 min	3.2	0.5	0
80 min	2.7	0.9	0.3645	80 min	2.7	0.5	0
90 min	2.5	0.9	0.3375	90 min	2.5	0.5	0
100 min	2.4	0.9	0.324	100 min	2.4	0.5	0
110 min	2.3	0.9	0.3105	110 min	2.3	0.5	0

Storage Calculations

Time	Inflow	Storage	Outflow
10 min	664.2	76.752	587.448
15 min	911.25	176.94	734.31
20 min	1085.4	204.228	881.172
30 min	1336.5	161.604	1174.896
40 min	1522.8	54.18	1468.62
50 min	1620	-142.344	1762.344
60 min	1701	-355.068	2056.068
70 min	1814.4	-535.392	2349.792
80 min	1749.6	-893.916	2643.516
90 min	1822.5	-1114.74	2937.24
100 min	1944	-1286.96	3230.964
110 min	1863	-1661.69	3524.688

**RANCH TRAIL  
100 YR STORM CALCULATIONS**

Present Conditions  
Q=CIA

A =	0.15	Areas 2 & 9 Detained
C =	0.796	Composite C Factor = .796
Tc =	10	
I100 =	9.8	
Q100 =	1.17012	

Future Conditions (Developed)			Offsite Conditions (Undeveloped)			Bypass		
A =	0.15		A =	0		A =	0	
Aadj =	0.15							
C =	0.9		C =	0.5		C =	0.9	
Tc =	10		Tc =	10		Tc =	10	
I100 =	9.8		I100 =	9.8		I100 =	9.8	
Q100 =	1.323		Q100 =	0		Q100 =	0	

Flow for Storm Durations (Developed)				Flow for Storm Durations (Offsite)			
Time	I	C	Q	Time	I	C	Q
10 min	9.8	0.9	1.323	10 min	9.8	0.5	0
15 min	9	0.9	1.215	15 min	9	0.5	0
20 min	8.3	0.9	1.1205	20 min	8.3	0.5	0
30 min	6.9	0.9	0.9315	30 min	6.9	0.5	0
40 min	5.8	0.9	0.783	40 min	5.8	0.5	0
50 min	5	0.9	0.675	50 min	5	0.5	0
60 min	4.5	0.9	0.6075	60 min	4.5	0.5	0
70 min	4	0.9	0.54	70 min	4	0.5	0
80 min	3.7	0.9	0.4995	80 min	3.7	0.5	0
90 min	3.5	0.9	0.4725	90 min	3.5	0.5	0
100 min	3.4	0.9	0.459	100 min	3.4	0.5	0
110 min	3.2	0.9	0.432	110 min	2.9	0.5	0

Storage Calculations

Time	Inflow	Storage	Outflow
10 min	793.8	91.728	702.072
15 min	1093.5	215.91	877.59
20 min	1344.6	291.492	1053.108
30 min	1676.7	272.556	1404.144
40 min	1879.2	124.02	1755.18
50 min	2025	-81.216	2106.216
60 min	2187	-270.252	2457.252
70 min	2268	-540.288	2808.288
80 min	2397.6	-761.724	3159.324
90 min	2551.5	-958.86	3510.36
100 min	2754	-1107.4	3861.396
110 min	2592	-1620.43	4212.432

REVISED TO CONFORM TO CONSTRUCTION RECORDS.  
 DATE: 2-17-26



THE SEAL APPEARING ON THIS DOCUMENT WAS AUTHORIZED BY W.L. DOUPHRATE II, TEXAS P.E. NO. 67022, F-886, ON DATE: MAY 3, 2024

**DOUPHRATE & ASSOCIATES, INC.**  
 ENGINEERING - PROJECT MANAGEMENT - SURVEYING  
 2235 RIDGE RD., # 200 ROCKWALL, TEXAS 75087  
 PHONE: (972)771-9004 FAX: (972)771-9005

**DRAINAGE DETENTION CALCULATIONS WEIR NO 2**  
 RANCH TRAIL OFFICES  
 CITY OF ROCKWALL  
 ROCKWALL COUNTY, TEXAS

REVISION  
**W.L.D.**  
 CHECKED  
**GC.W.**  
 DRAWN  
 SCALE  
 1" = 50' H  
 1" = 100' V  
 DATE  
**MAY, 2024**  
 PROJECT  
**23028**  
 51

RANCH TRAIL  
5 YR STORM CALCULATIONS  
Present Conditions  
Q=CIA

A =	0.004	Area 20 Detained
C =	0.35	
Tc =	10	
I5 =	6.1	
Q5 =	0.00854	

Future Conditions (Developed)			Offsite Conditions (Undeveloped)			Bypass		
A =	0.004		A =	0		A =	0	
Aadj =	0.004							
C =	0.9		C =	0.5		C =	0.9	
Tc =	10		Tc =	10		Tc =	10	
I5 =	6.1		I5 =	6.1		I5 =	6.1	
Q5 =	0.02196		Q5 =	0		Q5 =	0	

Flow for Storm Durations (Developed)				Flow for Storm Durations (Offsite)			
Time	I	C	Q	Time	I	C	Q
10 min	6.1	0.9	0.02196	10 min	6.1	0.5	0
15 min	5.5	0.9	0.0198	15 min	5.5	0.5	0
20 min	5	0.9	0.018	20 min	5	0.5	0
30 min	4	0.9	0.0144	30 min	4	0.5	0
40 min	3.4	0.9	0.01224	40 min	3.4	0.5	0
50 min	2.9	0.9	0.01044	50 min	2.9	0.5	0
60 min	2.6	0.9	0.00936	60 min	2.6	0.5	0
70 min	2.4	0.9	0.00864	70 min	2.4	0.5	0
80 min	2.2	0.9	0.00792	80 min	2.2	0.5	0
90 min	2	0.9	0.0072	90 min	2	0.5	0
100 min	1.8	0.9	0.00648	100 min	1.8	0.5	0
110 min	1.7	0.9	0.00612	110 min	1.7	0.5	0

Storage Calculations

10 min			
Inflow	13.176	Storage	8.052
Outflow	5.124		
15 min			
Inflow	17.82	Storage	11.415
Outflow	6.405		
20 min			
Inflow	21.6	Storage	13.914
Outflow	7.686		
30 min			
Inflow	25.92	Storage	15.672
Outflow	10.248		
40 min			
Inflow	29.376	Storage	16.566
Outflow	12.81		
50 min			
Inflow	31.32	Storage	15.948
Outflow	15.372		
60 min			
Inflow	33.696	Storage	15.762
Outflow	17.934		
70 min			
Inflow	36.288	Storage	15.792
Outflow	20.496		
80 min			
Inflow	38.016	Storage	14.958
Outflow	23.058		
90 min			
Inflow	38.88	Storage	13.26
Outflow	25.62		
100 min			
Inflow	38.88	Storage	10.698
Outflow	28.182		
110 min			
Inflow	36.72	Storage	5.976
Outflow	30.744		

RANCH TRAIL  
10 YR STORM CALCULATIONS  
Present Conditions  
Q=CIA

A =	0.004	Area 20 Detained
C =	0.35	
Tc =	10	
I10 =	7.2	
Q10 =	0.01008	

Future Conditions (Developed)			Offsite Conditions (Undeveloped)			Bypass		
A =	0.004		A =	0		A =	0	
Aadj =	0.004							
C =	0.9		C =	0.5		C =	0.9	
Tc =	10		Tc =	10		Tc =	10	
I10 =	7.2		I10 =	7.2		I10 =	7.2	
Q10 =	0.02592		Q10 =	0		Q10 =	0	

Flow for Storm Durations (Developed)				Flow for Storm Durations (Offsite)			
Time	I	C	Q	Time	I	C	Q
10 min	7.2	0.9	0.02592	10 min	7.2	0.5	0
15 min	6.5	0.9	0.0234	15 min	6.5	0.5	0
20 min	5.8	0.9	0.02088	20 min	5.8	0.5	0
30 min	4.7	0.9	0.01692	30 min	4.7	0.5	0
40 min	4	0.9	0.0144	40 min	4	0.5	0
50 min	3.5	0.9	0.0126	50 min	3.5	0.5	0
60 min	3	0.9	0.0108	60 min	3	0.5	0
70 min	2.7	0.9	0.00972	70 min	2.7	0.5	0
80 min	2.5	0.9	0.009	80 min	2.5	0.5	0
90 min	2.3	0.9	0.00828	90 min	2.3	0.5	0
100 min	2.2	0.9	0.00792	100 min	2.2	0.5	0
110 min	1.9	0.9	0.00684	110 min	1.9	0.5	0

Storage Calculations

10 min			
Inflow	15.552	Storage	9.504
Outflow	6.048		
15 min			
Inflow	21.06	Storage	13.5
Outflow	7.56		
20 min			
Inflow	25.056	Storage	15.984
Outflow	9.072		
30 min			
Inflow	30.456	Storage	18.36
Outflow	12.096		
40 min			
Inflow	34.56	Storage	19.44
Outflow	15.12		
50 min			
Inflow	37.8	Storage	19.656
Outflow	18.144		
60 min			
Inflow	38.88	Storage	17.712
Outflow	21.168		
70 min			
Inflow	40.824	Storage	16.632
Outflow	24.192		
80 min			
Inflow	43.2	Storage	15.984
Outflow	27.216		
90 min			
Inflow	44.712	Storage	14.472
Outflow	30.24		
100 min			
Inflow	47.52	Storage	14.256
Outflow	33.264		
110 min			
Inflow	41.04	Storage	4.752
Outflow	36.288		

RANCH TRAIL  
25 YR STORM CALCULATIONS  
Present Conditions  
Q=CIA

A =	0.004	Area 20 Detained
C =	0.35	
Tc =	10	
I25 =	8.2	
Q25 =	0.01148	

Future Conditions (Developed)			Offsite Conditions (Undeveloped)			Bypass		
A =	0.004		A =	0		A =	0	
Aadj =	0.004							
C =	0.9		C =	0.5		C =	0.9	
Tc =	10		Tc =	10		Tc =	10	
I25 =	8.2		I25 =	8.2		I25 =	8.2	
Q25 =	0.02952		Q25 =	0		Q25 =	0	

Flow for Storm Durations (Developed)				Flow for Storm Durations (Offsite)			
Time	I	C	Q	Time	I	C	Q
10 min	8.2	0.9	0.02952	10 min	8.2	0.5	0
15 min	7.5	0.9	0.027	15 min	7.5	0.5	0
20 min	6.7	0.9	0.02412	20 min	6.7	0.5	0
30 min	5.5	0.9	0.0198	30 min	5.5	0.5	0
40 min	4.7	0.9	0.01692	40 min	4.7	0.5	0
50 min	4	0.9	0.0144	50 min	4	0.5	0
60 min	3.5	0.9	0.0126	60 min	3.5	0.5	0
70 min	3.2	0.9	0.01152	70 min	3.2	0.5	0
80 min	2.7	0.9	0.00972	80 min	2.7	0.5	0
90 min	2.5	0.9	0.009	90 min	2.5	0.5	0
100 min	2.4	0.9	0.00864	100 min	2.4	0.5	0
110 min	2.3	0.9	0.00828	110 min	2.3	0.5	0

Storage Calculations

10 min			
Inflow	17.712	Storage	10.824
Outflow	6.888		
15 min			
Inflow	24.3	Storage	15.69
Outflow	8.61		
20 min			
Inflow	28.944	Storage	18.612
Outflow	10.332		
30 min			
Inflow	35.64	Storage	21.864
Outflow	13.776		
40 min			
Inflow	40.608	Storage	23.388
Outflow	17.22		
50 min			
Inflow	43.2	Storage	22.536
Outflow	20.664		
60 min			
Inflow	45.36	Storage	21.252
Outflow	24.108		
70 min			
Inflow	48.384	Storage	20.832
Outflow	27.552		
80 min			
Inflow	46.656	Storage	15.66
Outflow	30.996		
90 min			
Inflow	48.6	Storage	14.16
Outflow	34.44		
100 min			
Inflow	51.84	Storage	13.956
Outflow	37.884		
110 min			
Inflow	49.68	Storage	8.352
Outflow	41.328		

RANCH TRAIL  
100 YR STORM CALCULATIONS  
Present Conditions  
Q=CIA

A =	0.004	Area 20 Detained
C =	0.35	
Tc =	10	
I100 =	9.8	
Q100 =	0.01372	

Future Conditions (Developed)			Offsite Conditions (Undeveloped)			Bypass		
A =	0.004		A =	0		A =	0	
Aadj =	0.004							
C =	0.9		C =	0.5		C =	0.9	
Tc =	10		Tc =	10		Tc =	10	
I100 =	9.8		I100 =	9.8		I100 =	9.8	
Q100 =	0.03528		Q100 =	0		Q100 =	0	

Flow for Storm Durations (Developed)				Flow for Storm Durations (Offsite)			
Time	I	C	Q	Time	I	C	Q
10 min	9.8	0.9	0.03528	10 min	9.8	0.5	0
15 min	9	0.9	0.0324	15 min	9	0.5	0
20 min	8.3	0.9	0.02988	20 min	8.3	0.5	0
30 min	6.9	0.9	0.02484	30 min	6.9	0.5	0
40 min	5.8	0.9	0.02088	40 min	5.8	0.5	0
50 min	5	0.9	0.018	50 min	5	0.5	0
60 min	4.5	0.9	0.0162	60 min	4.5	0.5	0
70 min	4	0.9	0.0144	70 min	4	0.5	0
80 min	3.7	0.9	0.01332	80 min	3.7	0.5	0
90 min	3.5	0.9	0.0126	90 min	3.5	0.5	0
100 min	3.4	0.9	0.01224	100 min	3.3	0.5	0
110 min	3.2	0.9	0.01152	110 min	2.9	0.5	0

Storage Calculations

10 min			
Inflow	21.168	Storage	12.936
Outflow	8.232		
15 min			
Inflow	29.16	Storage	18.87
Outflow	10.29		
20 min			
Inflow	35.856	Storage	23.508
Outflow	12.348		
30 min			
Inflow	44.712	Storage	28.248
Outflow	16.464		
40 min			
Inflow	50.112	Storage	29.532
Outflow	20.58		
50 min			
Inflow	54	Storage	29.304
Outflow	24.696		
60 min			
Inflow	58.32	Storage	29.508
Outflow	28.812		
70 min			
Inflow	60.48	Storage	27.552
Outflow	32.928		
80 min			
Inflow	63.936	Storage	26.892
Outflow	37.044		
90 min			
Inflow	68.04	Storage	26.88
Outflow	41.16		
100 min			
Inflow	73.44	Storage	28.164
Outflow	45.276		
110 min			
Inflow	69.12	Storage	19.728
Outflow	49.392		

REVISED TO CONFORM TO CONSTRUCTION RECORDS.  
  
 DATE: 2-17-26



THE SEAL APPEARING ON THIS DOCUMENT WAS AUTHORIZED BY W.L. DOUPHRATE II, TEXAS P.E. NO. 67022, F-886, ON DATE: MAY 3, 2024

**DOUPHRATE & ASSOCIATES, INC.**  
 ENGINEERING - PROJECT MANAGEMENT - SURVEYING  
 2235 RIDGE RD., # 200 ROCKWALL, TEXAS 75087  
 PHONE: (972)771-9004 FAX: (972)771-9005

**DRAINAGE DETENTION CALCULATIONS WEIR NO 3**  
 RANCH TRAIL OFFICES  
 CITY OF ROCKWALL  
 ROCKWALL COUNTY, TEXAS

REVISION  
**W.L.D.**  
 CHECKED  
**GC.W.**  
 DRAWN  
 SCALE  
 1" = 50' H  
 1" = 100' V  
 DATE  
**MAY, 2024**  
 PROJECT  
**23028**  
 52

RANCH TRAIL  
5 YR STORM CALCULATIONS  
Present Conditions  
Q=CIA

A =	0.47	Areas = 11 & 12 Detained
C =	0.35	
Tc =	10	
I5 =	6.1	
Q5 =	1.00345	

Future Conditions (Developed)	Offsite Conditions (Undeveloped)	Bypass
A = 0.47	A = 0.78	A = 0
Aadj = 0.47		
C = 0.9	C = 0.53	C = 0.9
Tc = 10	Tc = 10	Tc = 10
I5 = 6.1	I5 = 6.1	I5 = 6.1
Q5 = 2.5803	Q5 = 2.52174	Q5 = 0

Flow for Storm Durations (Developed)				Flow for Storm Durations (Offsite)			
Time	L	C	Q	Time	L	C	Q
10 min	6.1	0.9	2.5803	10 min	6.1	0.53	2.52174
15 min	5.5	0.9	2.3265	15 min	5.5	0.53	2.2737
20 min	5	0.9	2.115	20 min	5	0.53	2.067
30 min	4	0.9	1.692	30 min	4	0.53	1.6536
40 min	3.4	0.9	1.4382	40 min	3.4	0.53	1.40556
50 min	2.9	0.9	1.2267	50 min	2.9	0.53	1.19886
60 min	2.6	0.9	1.0998	60 min	2.6	0.53	1.07484
70 min	2.4	0.9	1.0152	70 min	2.4	0.53	0.99216
80 min	2.2	0.9	0.9306	80 min	2.2	0.53	0.90948
90 min	2	0.9	0.846	90 min	2	0.53	0.8268
100 min	1.8	0.9	0.7614	100 min	1.8	0.53	0.74412
110 min	1.7	0.9	0.7191	110 min	1.7	0.53	0.70278

Storage Calculations

Time	Inflow	Storage	Outflow
10 min	3061.224	946.11	2115.114
15 min	4140.18	1496.288	2643.893
20 min	5018.4	1845.729	3172.671
30 min	6022.08	1791.852	4230.228
40 min	6825.024	1537.239	5287.785
50 min	7276.68	931.338	6345.342
60 min	7828.704	425.805	7402.899
70 min	8430.912	-29.544	8460.456
80 min	8832.384	-685.629	9518.013
90 min	9033.12	-1542.45	10575.57
100 min	9033.12	-2600.01	11633.13
110 min	8531.28	-4159.4	12690.68

RANCH TRAIL  
10 YR STORM CALCULATIONS  
Present Conditions  
Q=CIA

A =	0.47	Areas = 11 & 12 Detained
C =	0.35	
Tc =	10	
I10 =	7.2	
Q10 =	1.1844	

Future Conditions (Developed)	Offsite Conditions (Undeveloped)	Bypass
A = 0.47	A = 0.78	A = 0
Aadj = 0.47		
C = 0.9	C = 0.53	C = 0.9
Tc = 10	Tc = 10	Tc = 10
I10 = 7.2	I10 = 7.2	I10 = 7.2
Q10 = 3.0456	Q10 = 2.97648	Q10 = 0

Flow for Storm Durations (Developed)				Flow for Storm Durations (Offsite)			
Time	L	C	Q	Time	L	C	Q
10 min	7.2	0.9	3.0456	10 min	7.2	0.53	2.97648
15 min	6.5	0.9	2.7495	15 min	6.5	0.53	2.6871
20 min	5.8	0.9	2.4534	20 min	5.8	0.53	2.39772
30 min	4.7	0.9	1.9881	30 min	4.7	0.53	1.94298
40 min	4	0.9	1.692	40 min	4	0.53	1.6536
50 min	3.5	0.9	1.4805	50 min	3.5	0.53	1.4469
60 min	3	0.9	1.269	60 min	3	0.53	1.2402
70 min	2.7	0.9	1.1421	70 min	2.7	0.53	1.11618
80 min	2.5	0.9	1.0575	80 min	2.5	0.53	1.0335
90 min	2.3	0.9	0.9729	90 min	2.3	0.53	0.95082
100 min	2.2	0.9	0.9306	100 min	2.2	0.53	0.90948
110 min	1.9	0.9	0.8037	110 min	1.9	0.53	0.78546

Storage Calculations

Time	Inflow	Storage	Outflow
10 min	3613.248	1116.72	2496.528
15 min	4892.94	1772.28	3120.66
20 min	5821.344	2076.552	3744.792
30 min	7075.944	2082.888	4993.056
40 min	8029.44	1788.12	6241.32
50 min	8782.2	1292.616	7489.584
60 min	9033.12	295.272	8737.848
70 min	9484.776	-501.336	9986.112
80 min	10036.8	-1197.58	11234.38
90 min	10388.09	-2094.55	12482.64
100 min	11040.48	-2690.42	13730.9
110 min	9534.96	-5444.21	14979.17

RANCH TRAIL  
25 YR STORM CALCULATIONS  
Present Conditions  
Q=CIA

A =	0.47	Areas = 11 & 12
C =	0.35	
Tc =	10	
I25 =	8.2	
Q25 =	1.3489	

Future Conditions (Developed)	Offsite Conditions (Undeveloped)	Bypass
A = 0.47	A = 0.78	A = 0
Aadj = 0.47		
C = 0.9	C = 0.53	C = 0.9
Tc = 10	Tc = 10	Tc = 10
I25 = 8.2	I25 = 8.2	I25 = 8.2
Q25 = 3.4686	Q25 = 3.38988	Q25 = 0

Flow for Storm Durations (Developed)				Flow for Storm Durations (Offsite)			
Time	L	C	Q	Time	L	C	Q
10 min	8.2	0.9	3.4686	10 min	8.2	0.53	3.38988
15 min	7.5	0.9	3.1725	15 min	7.5	0.53	3.1005
20 min	6.7	0.9	2.8341	20 min	6.7	0.53	2.76978
30 min	5.5	0.9	2.3265	30 min	5.5	0.53	2.2737
40 min	4.7	0.9	1.9881	40 min	4.7	0.53	1.94298
50 min	4	0.9	1.692	50 min	4	0.53	1.6536
60 min	3.5	0.9	1.4805	60 min	3.5	0.53	1.4469
70 min	3.2	0.9	1.3536	70 min	3.2	0.53	1.32288
80 min	2.7	0.9	1.1421	80 min	2.7	0.53	1.11618
90 min	2.5	0.9	1.0575	90 min	2.5	0.53	1.0335
100 min	2.4	0.9	1.0152	100 min	2.4	0.53	0.99216
110 min	2.3	0.9	0.9729	110 min	2.3	0.53	0.95082

Storage Calculations

Time	Inflow	Storage	Outflow
10 min	4115.088	1271.82	2843.268
15 min	5645.7	2091.615	3554.085
20 min	6724.656	2459.754	4264.902
30 min	8280.36	2593.824	5686.536
40 min	9434.592	2326.422	7108.17
50 min	10036.8	1506.996	8529.804
60 min	10538.64	587.202	9951.438
70 min	11241.22	-131.856	11373.07
80 min	10839.74	-1954.96	12794.71
90 min	11291.4	-2924.94	14216.34
100 min	12044.16	-3593.81	15637.97
110 min	11542.32	-5517.29	17059.61

RANCH TRAIL  
100 YR STORM CALCULATIONS  
Present Conditions  
Q=CIA

A =	0.47	Areas = 11 & 12 Detained
C =	0.35	
Tc =	10	
I100 =	9.8	
Q100 =	1.6121	

Future Conditions (Developed)	Offsite Conditions (Undeveloped)	Bypass
A = 0.47	A = 0.78	A = 0
Aadj = 0.47		
C = 0.9	C = 0.53	C = 0.9
Tc = 10	Tc = 10	Tc = 10
I100 = 9.8	I100 = 9.8	I100 = 9.8
Q100 = 4.1454	Q100 = 4.05132	Q100 = 0

Flow for Storm Durations (Developed)				Flow for Storm Durations (Offsite)			
Time	L	C	Q	Time	L	C	Q
10 min	9.8	0.9	4.1454	10 min	9.8	0.53	4.05132
15 min	9	0.9	3.807	15 min	9	0.53	3.7206
20 min	8.3	0.9	3.5109	20 min	8.3	0.53	3.43122
30 min	6.9	0.9	2.9187	30 min	6.9	0.53	2.85246
40 min	5.8	0.9	2.4534	40 min	5.8	0.53	2.39772
50 min	5	0.9	2.115	50 min	5	0.53	2.067
60 min	4.5	0.9	1.9035	60 min	4.5	0.53	1.8603
70 min	4	0.9	1.692	70 min	4	0.53	1.6536
80 min	3.7	0.9	1.5851	80 min	3.7	0.53	1.52958
90 min	3.5	0.9	1.4805	90 min	3.5	0.53	1.4469
100 min	3.4	0.9	1.4382	100 min	3.3	0.53	1.36422
110 min	3.2	0.9	1.3536	110 min	2.9	0.53	1.19886

Storage Calculations

Time	Inflow	Storage	Outflow
10 min	4918.032	1519.98	3398.052
15 min	6774.84	2527.275	4247.565
20 min	8330.544	3233.466	5097.078
30 min	10388.09	3591.984	6796.104
40 min	11642.69	3147.558	8495.13
50 min	12546	2351.844	10194.16
60 min	13549.68	1656.498	11893.18
70 min	14051.52	459.312	13592.21
80 min	14854.46	-436.77	15291.23
90 min	15807.96	-1182.3	16990.26
100 min	16814.52	-1874.77	18689.29
110 min	15314.76	-5073.55	20388.31

REVISED TO CONFORM TO CONSTRUCTION RECORDS.  
 DATE: 2-17-26



THE SEAL APPEARING ON THIS DOCUMENT WAS AUTHORIZED BY W.L. DOUPHRATE II, TEXAS P.E. NO. 60102, F-886, ON DATE: MAY 3, 2024

**DOUPHRATE & ASSOCIATES, INC.**  
 ENGINEERING - PROJECT MANAGEMENT - SURVEYING  
 2235 RIDGE RD., # 200 ROCKWALL, TEXAS 75087  
 PHONE: (972)771-9004 FAX: (972)771-9005

**DRAINAGE DETENTION CALCULATIONS WEIR NO 3**  
 RANCH TRAIL OFFICES  
 CITY OF ROCKWALL  
 ROCKWALL COUNTY, TEXAS

REVISION  
**W.L.D.**  
 CHECKED  
**GC.W.**  
 DRAWN  
 SCALE  
 1" = 20' H  
 1" = 10' V  
 DATE  
**MAY, 2024**  
 PROJECT  
**23028**  
 53

RANCH TRAIL  
5 YR STORM CALCULATIONS  
Present Conditions  
Q=CIA

A =	0.78	Areas 10 & 13 Detained
C =	0.53	COMPOSITE C = .53
Tc =	10	
I5 =	6.1	
Q5 =	2.52174	

Future Conditions (Developed)    Offsite Conditions (Undeveloped)    Bypass

A =	0.52	A =	0.18	A =	0
Aadj =	0.52				
C =	0.9	C =	0.71	C =	0.9
Tc =	10	Tc =	10	Tc =	10
I5 =	6.1	I5 =	6.1	I5 =	6.1
Q5 =	2.8548	Q5 =	0.77958	Q5 =	0

Flow for Storm Durations (Developed)				Flow for Storm Durations (Offsite)			
Time	L	C	Q	Time	L	C	Q
10 min	6.1	0.9	2.8548	10 min	6.1	0.71	0.77958
15 min	5.5	0.9	2.574	15 min	5.5	0.71	0.7029
20 min	5	0.9	2.34	20 min	5	0.71	0.639
30 min	4	0.9	1.872	30 min	4	0.71	0.5112
40 min	3.4	0.9	1.5912	40 min	3.4	0.71	0.43452
50 min	2.9	0.9	1.3572	50 min	2.9	0.71	0.37062
60 min	2.6	0.9	1.2168	60 min	2.6	0.71	0.33228
70 min	2.4	0.9	1.1232	70 min	2.4	0.71	0.30672
80 min	2.2	0.9	1.0296	80 min	2.2	0.71	0.28116
90 min	2	0.9	0.936	90 min	2	0.71	0.2556
100 min	1.8	0.9	0.8424	100 min	1.8	0.71	0.23004
110 min	1.7	0.9	0.7956	110 min	1.7	0.71	0.21726

Storage Calculations

10 min	Inflow	2180.628	Storage	704.184	Outflow	1476.444
15 min	Inflow	2949.21	Storage	1103.655	Outflow	1845.555
20 min	Inflow	3574.8	Storage	1360.134	Outflow	2214.666
30 min	Inflow	4289.76	Storage	1336.872	Outflow	2952.888
40 min	Inflow	4861.728	Storage	1170.618	Outflow	3691.11
50 min	Inflow	5183.46	Storage	754.128	Outflow	4429.332
60 min	Inflow	5576.688	Storage	409.134	Outflow	5167.554
70 min	Inflow	6005.664	Storage	99.888	Outflow	5905.776
80 min	Inflow	6291.648	Storage	-352.35	Outflow	6643.998
90 min	Inflow	6434.64	Storage	-947.58	Outflow	7382.22
100 min	Inflow	6434.64	Storage	-1685.8	Outflow	8120.442
110 min	Inflow	6077.16	Storage	-2781.5	Outflow	8858.664

RANCH TRAIL  
10 YR STORM CALCULATIONS  
Present Conditions  
Q=CIA

A =	0.78	Areas 10 & 13 Detained
C =	0.53	COMPOSITE C = .53
Tc =	10	
I10 =	7.2	
Q10 =	2.97648	

Future Conditions (Developed)    Offsite Conditions (Undeveloped)    Bypass

A =	0.52	A =	0.18	A =	0
Aadj =	0.52				
C =	0.9	C =	0.71	C =	0.9
Tc =	10	Tc =	10	Tc =	10
I10 =	7.2	I10 =	7.2	I10 =	7.2
Q10 =	3.3696	Q10 =	0.92016	Q10 =	0

Flow for Storm Durations (Developed)				Flow for Storm Durations (Offsite)			
Time	L	C	Q	Time	L	C	Q
10 min	7.2	0.9	3.3696	10 min	7.2	0.71	0.92016
15 min	6.5	0.9	3.042	15 min	6.5	0.71	0.8307
20 min	5.8	0.9	2.7144	20 min	5.8	0.71	0.74124
30 min	4.7	0.9	2.1996	30 min	4.7	0.71	0.60066
40 min	4	0.9	1.872	40 min	4	0.71	0.5112
50 min	3.5	0.9	1.638	50 min	3.5	0.71	0.4473
60 min	3	0.9	1.404	60 min	3	0.71	0.3834
70 min	2.7	0.9	1.2636	70 min	2.7	0.71	0.34506
80 min	2.5	0.9	1.17	80 min	2.5	0.71	0.3195
90 min	2.3	0.9	1.0764	90 min	2.3	0.71	0.29394
100 min	2.2	0.9	1.0296	100 min	2.2	0.71	0.28116
110 min	1.9	0.9	0.8892	110 min	1.9	0.71	0.24282

Storage Calculations

10 min	Inflow	2573.856	Storage	831.168	Outflow	1742.688
15 min	Inflow	3485.43	Storage	1307.07	Outflow	2178.36
20 min	Inflow	4146.768	Storage	1532.736	Outflow	2614.032
30 min	Inflow	5040.468	Storage	1555.092	Outflow	3485.376
40 min	Inflow	5719.68	Storage	1362.96	Outflow	4356.72
50 min	Inflow	6255.9	Storage	1027.836	Outflow	5228.064
60 min	Inflow	6434.64	Storage	335.232	Outflow	6099.408
70 min	Inflow	6756.372	Storage	-214.38	Outflow	6970.752
80 min	Inflow	7149.6	Storage	-692.496	Outflow	7842.096
90 min	Inflow	7399.836	Storage	-1313.6	Outflow	8713.44
100 min	Inflow	7864.56	Storage	-1720.22	Outflow	9584.784
110 min	Inflow	6792.12	Storage	-3664.01	Outflow	10456.13

RANCH TRAIL  
25 YR STORM CALCULATIONS  
Present Conditions  
Q=CIA

A =	0.78	Areas 10 & 13 Detained
C =	0.53	COMPOSITE C = .53
Tc =	10	
I25 =	8.2	
Q25 =	3.38988	

Future Conditions (Developed)    Offsite Conditions (Undeveloped)    Bypass

A =	0.52	A =	0.18	A =	0
Aadj =	0.52				
C =	0.9	C =	0.71	C =	0.9
Tc =	10	Tc =	10	Tc =	10
I25 =	8.2	I25 =	8.2	I25 =	8.2
Q25 =	3.8376	Q25 =	1.04796	Q25 =	0

Flow for Storm Durations (Developed)				Flow for Storm Durations (Offsite)			
Time	L	C	Q	Time	L	C	Q
10 min	8.2	0.9	3.8376	10 min	8.2	0.71	1.04796
15 min	7.5	0.9	3.51	15 min	7.5	0.71	0.9585
20 min	6.7	0.9	3.1356	20 min	6.7	0.71	0.85626
30 min	5.5	0.9	2.574	30 min	5.5	0.71	0.7029
40 min	4.7	0.9	2.1996	40 min	4.7	0.71	0.60066
50 min	4	0.9	1.872	50 min	4	0.71	0.5112
60 min	3.5	0.9	1.638	60 min	3.5	0.71	0.4473
70 min	3.2	0.9	1.4976	70 min	3.2	0.71	0.40896
80 min	2.7	0.9	1.2636	80 min	2.7	0.71	0.34506
90 min	2.5	0.9	1.17	90 min	2.5	0.71	0.3195
100 min	2.4	0.9	1.1232	100 min	2.4	0.71	0.30672
110 min	2.3	0.9	1.0764	110 min	2.3	0.71	0.29394

Storage Calculations

10 min	Inflow	2931.336	Storage	946.608	Outflow	1984.728
15 min	Inflow	4021.65	Storage	1540.74	Outflow	2480.91
20 min	Inflow	4790.232	Storage	1813.14	Outflow	2977.092
30 min	Inflow	5898.42	Storage	1928.964	Outflow	3969.456
40 min	Inflow	6720.624	Storage	1758.804	Outflow	4961.82
50 min	Inflow	7149.6	Storage	1195.416	Outflow	5954.184
60 min	Inflow	7507.08	Storage	560.532	Outflow	6946.548
70 min	Inflow	8007.552	Storage	68.64	Outflow	7938.912
80 min	Inflow	7721.568	Storage	-1209.71	Outflow	8931.276
90 min	Inflow	8043.3	Storage	-1880.34	Outflow	9923.64
100 min	Inflow	8579.52	Storage	-2336.48	Outflow	10916
110 min	Inflow	8222.04	Storage	-3686.33	Outflow	11908.37

RANCH TRAIL  
100 YR STORM CALCULATIONS  
Present Conditions  
Q=CIA

A =	0.78	Areas 10 & 13 (Detained)
C =	0.53	COMPOSITE C = .53
Tc =	10	
I100 =	9.8	
Q100 =	4.05132	

Future Conditions (Developed)    Offsite Conditions (Undeveloped)    Bypass

A =	0.78	A =	0	A =	0
Aadj =	0.78				
C =	0.9	C =	0.9	C =	0.9
Tc =	10	Tc =	10	Tc =	10
I100 =	9.8	I100 =	9.8	I100 =	9.8
Q100 =	6.8796	Q100 =	0	Q100 =	0

Flow for Storm Durations (Developed)				Flow for Storm Durations (Offsite)			
Time	L	C	Q	Time	L	C	Q
10 min	9.8	0.9	6.8796	10 min	9.8	0.9	0
15 min	9	0.9	6.318	15 min	9	0.9	0
20 min	8.3	0.9	5.8266	20 min	8.3	0.9	0
30 min	6.9	0.9	4.8438	30 min	6.9	0.9	0
40 min	5.8	0.9	4.0716	40 min	5.8	0.9	0
50 min	5	0.9	3.51	50 min	5	0.9	0
60 min	4.5	0.9	3.159	60 min	4.5	0.9	0
70 min	4	0.9	2.808	70 min	4	0.9	0
80 min	3.7	0.9	2.5974	80 min	3.7	0.9	0
90 min	3.5	0.9	2.457	90 min	3.5	0.9	0
100 min	3.4	0.9	2.3868	100 min	3.3	0.9	0
110 min	3.2	0.9	2.2464	110 min	2.9	0.9	0

Storage Calculations

10 min	Inflow	4127.76	Storage	1696.968	Outflow	2430.792
15 min	Inflow	5686.2	Storage	2647.71	Outflow	3038.49
20 min	Inflow	6991.92	Storage	3345.732	Outflow	3646.188
30 min	Inflow	8718.84	Storage	3857.256	Outflow	4861.584
40 min	Inflow	9771.84	Storage	3694.86	Outflow	6076.98
50 min	Inflow	10530	Storage	3237.624	Outflow	7292.376
60 min	Inflow	11372.4	Storage	2864.628	Outflow	8507.772
70 min	Inflow	11793.6	Storage	2070.432	Outflow	9723.168
80 min	Inflow	12467.52	Storage	1528.956	Outflow	10938.56
90 min	Inflow	13267.8	Storage	1113.84	Outflow	12153.96
100 min	Inflow	14320.8	Storage	951.444	Outflow	13369.36
110 min	Inflow	13478.4	Storage	-1106.35	Outflow	14584.75

REVISED TO CONFORM TO CONSTRUCTION RECORDS.  
 DATE: 2-17-26




THE SEAL APPEARING ON THIS DOCUMENT WAS AUTHORIZED BY W.L. DOUPHRATE II, TEXAS P.E. NO. 60102, F-886, ON DATE: MAY 3, 2024


**DOUPHRATE & ASSOCIATES, INC.**  
 ENGINEERING - PROJECT MANAGEMENT - SURVEYING  
 2235 RIDGE RD., # 200 ROCKWALL, TEXAS 75087  
 PHONE: (972)771-9004 FAX: (972)771-9005

**DRAINAGE DETENTION CALCULATIONS WEIR NO 4**  
 RANCH TRAIL OFFICES  
 CITY OF ROCKWALL  
 ROCKWALL COUNTY, TEXAS

REVISION  
**W.L.D.**  
 CHECKED  
**GC.W.**  
 DRAWN  
 SCALE  
 1" = 50' H  
 1" = 10' V  
 DATE  
**MAY, 2024**  
 PROJECT  
**23028**  
 54

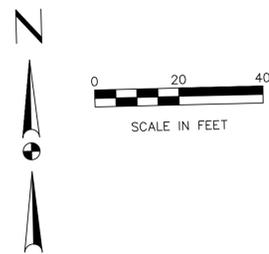

- LEGEND:**
- ⊗ WATER MAIN VALVE
  - ⊕ FIRE HYDRANT
  - SSCO SANITARY SEWER CLEAN-OUT
  - ⊙ SANITARY SEWER MANHOLE
  - ⊖ POWER POLE
  - IRF IRON ROD FOUND
  - WM WATER METER
  - CLF = Chainlink Fence
  - OHL — OVERHEAD POWER
  - UGE — UNDERGROUND ELECTRIC

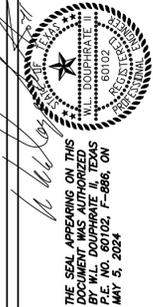

**DOUPHRATE & ASSOCIATES, INC.**  
 ENGINEERING - PROJECT MANAGEMENT - SURVEYING  
 2235 RIDGE RD., # 200 ROCKWALL, TEXAS 75087  
 PHONE: (972)771-9004 FAX: (972)771-9005

**GRADING PLAN  
 LOT 5, BLOCK A  
 MAVERICK RANCH ADDITION  
 CITY ROCKWALL  
 ROCKWALL COUNTY, TEXAS**


REVISION	W.L.D.
CHECKED	G.C.W.
DRAWN	
SCALE	1" = 20' H 1" = 20' V
DATE	MAY, 2024
PROJECT	23028
	6.0

CONSTRUCT 2' WIDE REINFORCED CONC DRAINAGE FLUME. SEE SHEET 4.2 FOR DETAIL

INSTALL 6" INTEGRAL CURB WITH CONC FLUME AT 45 DEG BEND

DETENTION WEIR NO 3

RETAINING WALL SECTION A-A  
 DETENTION WEIR NO 4

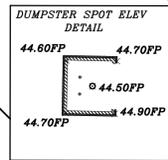


TEXAS RANCH TRAILS, LLC  
 PART OF LOT 6, BLK A  
 1.32 AC.  
 VOL. 2016, PG. 0000017304

RIDGE POINTE HORIZON, LP  
 0.793 AC.  
 PART OF LOT 6, BLK A  
 MAVERICK RANCH  
 VOL. 2014, PG. 0000014590

PATRIOT PAWS SERVICE DOGS  
 3.466 AC.  
 LOT 1, BLOCK A  
 PATRIOT DOGS ADDITION  
 VOL. 2014, PG. 0000006979

RETAINING WALL CROSS SECTION DETAIL A-A  
 TYPICAL ( BOTTOM OF WALL ELEV MAY VARIE )

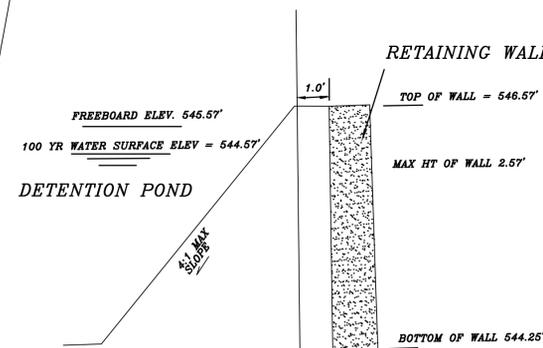

NOTE: ALL WALLS TO BE ROCK OR STONE CONTRACTOR TO PROVIDE ENGINEERING DESIGN TO CITY FOR REVIEW AND APPROVAL PRIOR TO COMMENCEMENT OF CONSTRUCTION

ALL RESPONSIBILITY FOR ADEQUACY OF DESIGN REMAINS WITH THE DESIGN ENGINEER. THE CITY OF ROCKWALL, IN REVIEWING AND RELEASING PLANS FOR CONSTRUCTION, ASSUMES NO RESPONSIBILITY FOR ADEQUACY OR ACCURACY OF DESIGN.


INSTALL 2' WIDE 4" INVERTED CONC. PILOT FLUME SEE DETAIL ON DIMENSION CONTROL SHEET

INSTALL 10' WIDE VALLEY GUTTER

REVISED TO CONFORM TO CONSTRUCTION RECORDS.

DATE: 2-17-26

1.550 AC.  
 67,502 SQ. FT.

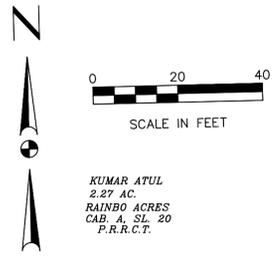

KUMAR ATUL  
2.27 AC.  
RAINBO ACRES  
C&B A, SL. 20  
P.R.R.C.T.

PATRIOT PAWS SERVICE DOGS  
3.466 AC.  
LOT 1, BLOCK A  
PATRIOT DOGS ADDITION  
VOL. 2014, PG. 0000006979

- LEGEND:
- ⊗ WATER MAIN VALVE
  - ⊕ FIRE HYDRANT
  - SSCO SANITARY SEWER CLEAN-OUT
  - ⊙ SANITARY SEWER MANHOLE
  - ⊖ POWER POLE
  - IRF IRON ROD FOUND
  - WM WATER METER
  - CLF = Chainlink Fence
  - OHL — OVERHEAD POWER
  - UGE — UNDERGROUND ELECTRIC




DOUPHRA  
& ASSOCIATES, INC.  
ENGINEERING - PROJECT MANAGEMENT - SURVEYING  
2235 RIDGE RD., # 200 ROCKWALL, TEXAS 75087  
PHONE: (972)771-9004 FAX: (972)771-9005

PROPOSED UTILITIES  
LOT 5, BLOCK A  
MAVERICK RANCH ADDITION  
CITY ROCKWALL  
ROCKWALL COUNTY, TEXAS

TEXAS RANCH TRAILS, LLC  
PART OF LOT 6, BLK A  
1.32 AC.  
VOL. 2016, PG. 0000017304

RIDGE POINTE HORIZON, LP  
0.793 AC.  
PART OF LOT 6, BLK A  
MAVERICK RANCH  
VOL. 2014, PG. 0000014590


NOTE: ALL SANITARY SEWER MANHOLES CONSTRUCTED TO BE RAVEN LINED OR APPROVED EQUAL

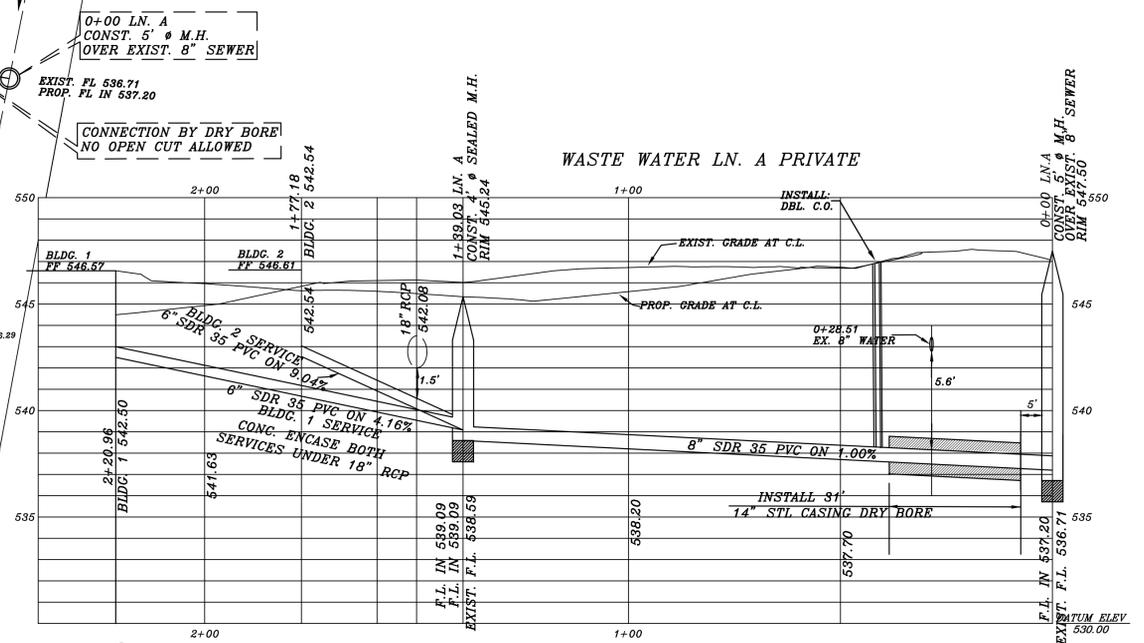

ALL RESPONSIBILITY FOR ADEQUACY OF DESIGN REMAINS WITH THE DESIGN ENGINEER. THE CITY OF ROCKWALL, IN REVIEWING AND RELEASING PLANS FOR CONSTRUCTION, ASSUMES NO RESPONSIBILITY FOR ADEQUACY OR ACCURACY OF DESIGN.

REVISED TO CONFORM TO CONSTRUCTION RECORDS.  
*W. Douglas Douphrate* DATE: 2-17-26

REVISION	W.L.D.
CHECKED	
DRAWN	GCW.
SCALE	1" = 20'H 1" = 4'V
DATE	MAY, 2024
PROJECT	23028
	7.0

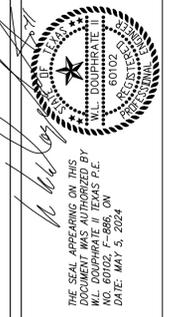





**DOUPHRADE & ASSOCIATES, INC.**  
 ENGINEERING • PROJECT MANAGEMENT • SURVEYING  
 2235 RIDGE RD., # 200 ROCKWALL, TEXAS 75087  
 PHONE: (972)771-9004 FAX: (972)771-9005

**PROPOSED STORM SEWER  
 LOT 5, BLOCK A  
 MAVERICK RANCH ADDITION**  
 CITY ROCKWALL  
 ROCKWALL COUNTY, TEXAS


REVISION	W.L.D.
CHECKED	GC.W.
DRAWN	
SCALE	1" = 20'H 1" = 4'V
DATE	MAY, 2024
PROJECT	23028
	80

ALL RESPONSIBILITY FOR ADEQUACY OF DESIGN REMAINS WITH THE DESIGN ENGINEER. THE CITY OF ROCKWALL, IN REVIEWING AND RELEASING PLANS FOR CONSTRUCTION, ASSUMES NO RESPONSIBILITY FOR ADEQUACY OR ACCURACY OF DESIGN.

- LEGEND:**
- ⊕ WATER MAIN VALVE
  - ⊕ FIRE HYDRANT
  - SSCO SANITARY SEWER CLEAN-OUT
  - ⊙ SANITARY SEWER MANHOLE
  - ⊗ POWER POLE
  - IRF IRON ROD FOUND
  - WM WATER METER
  - CLF = Chainlink Fence
  - OHL = OVERHEAD POWER
  - UGE = UNDERGROUND ELECTRIC

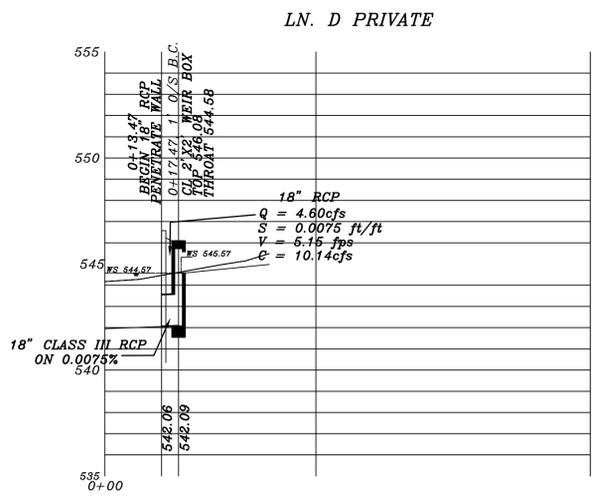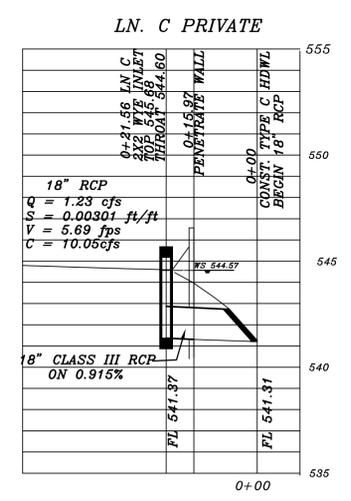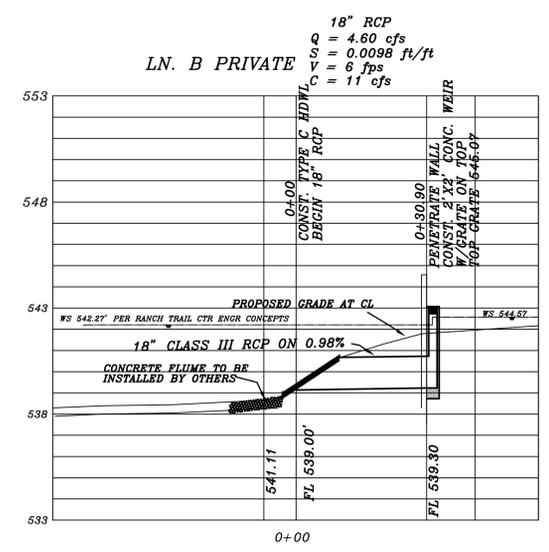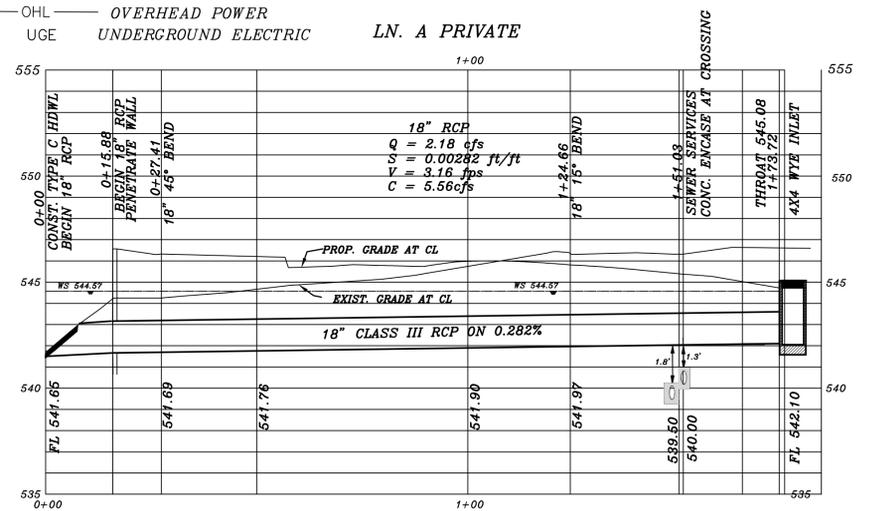

REVISED TO CONFORM TO CONSTRUCTION RECORDS.  
 DATE: 2-17-26

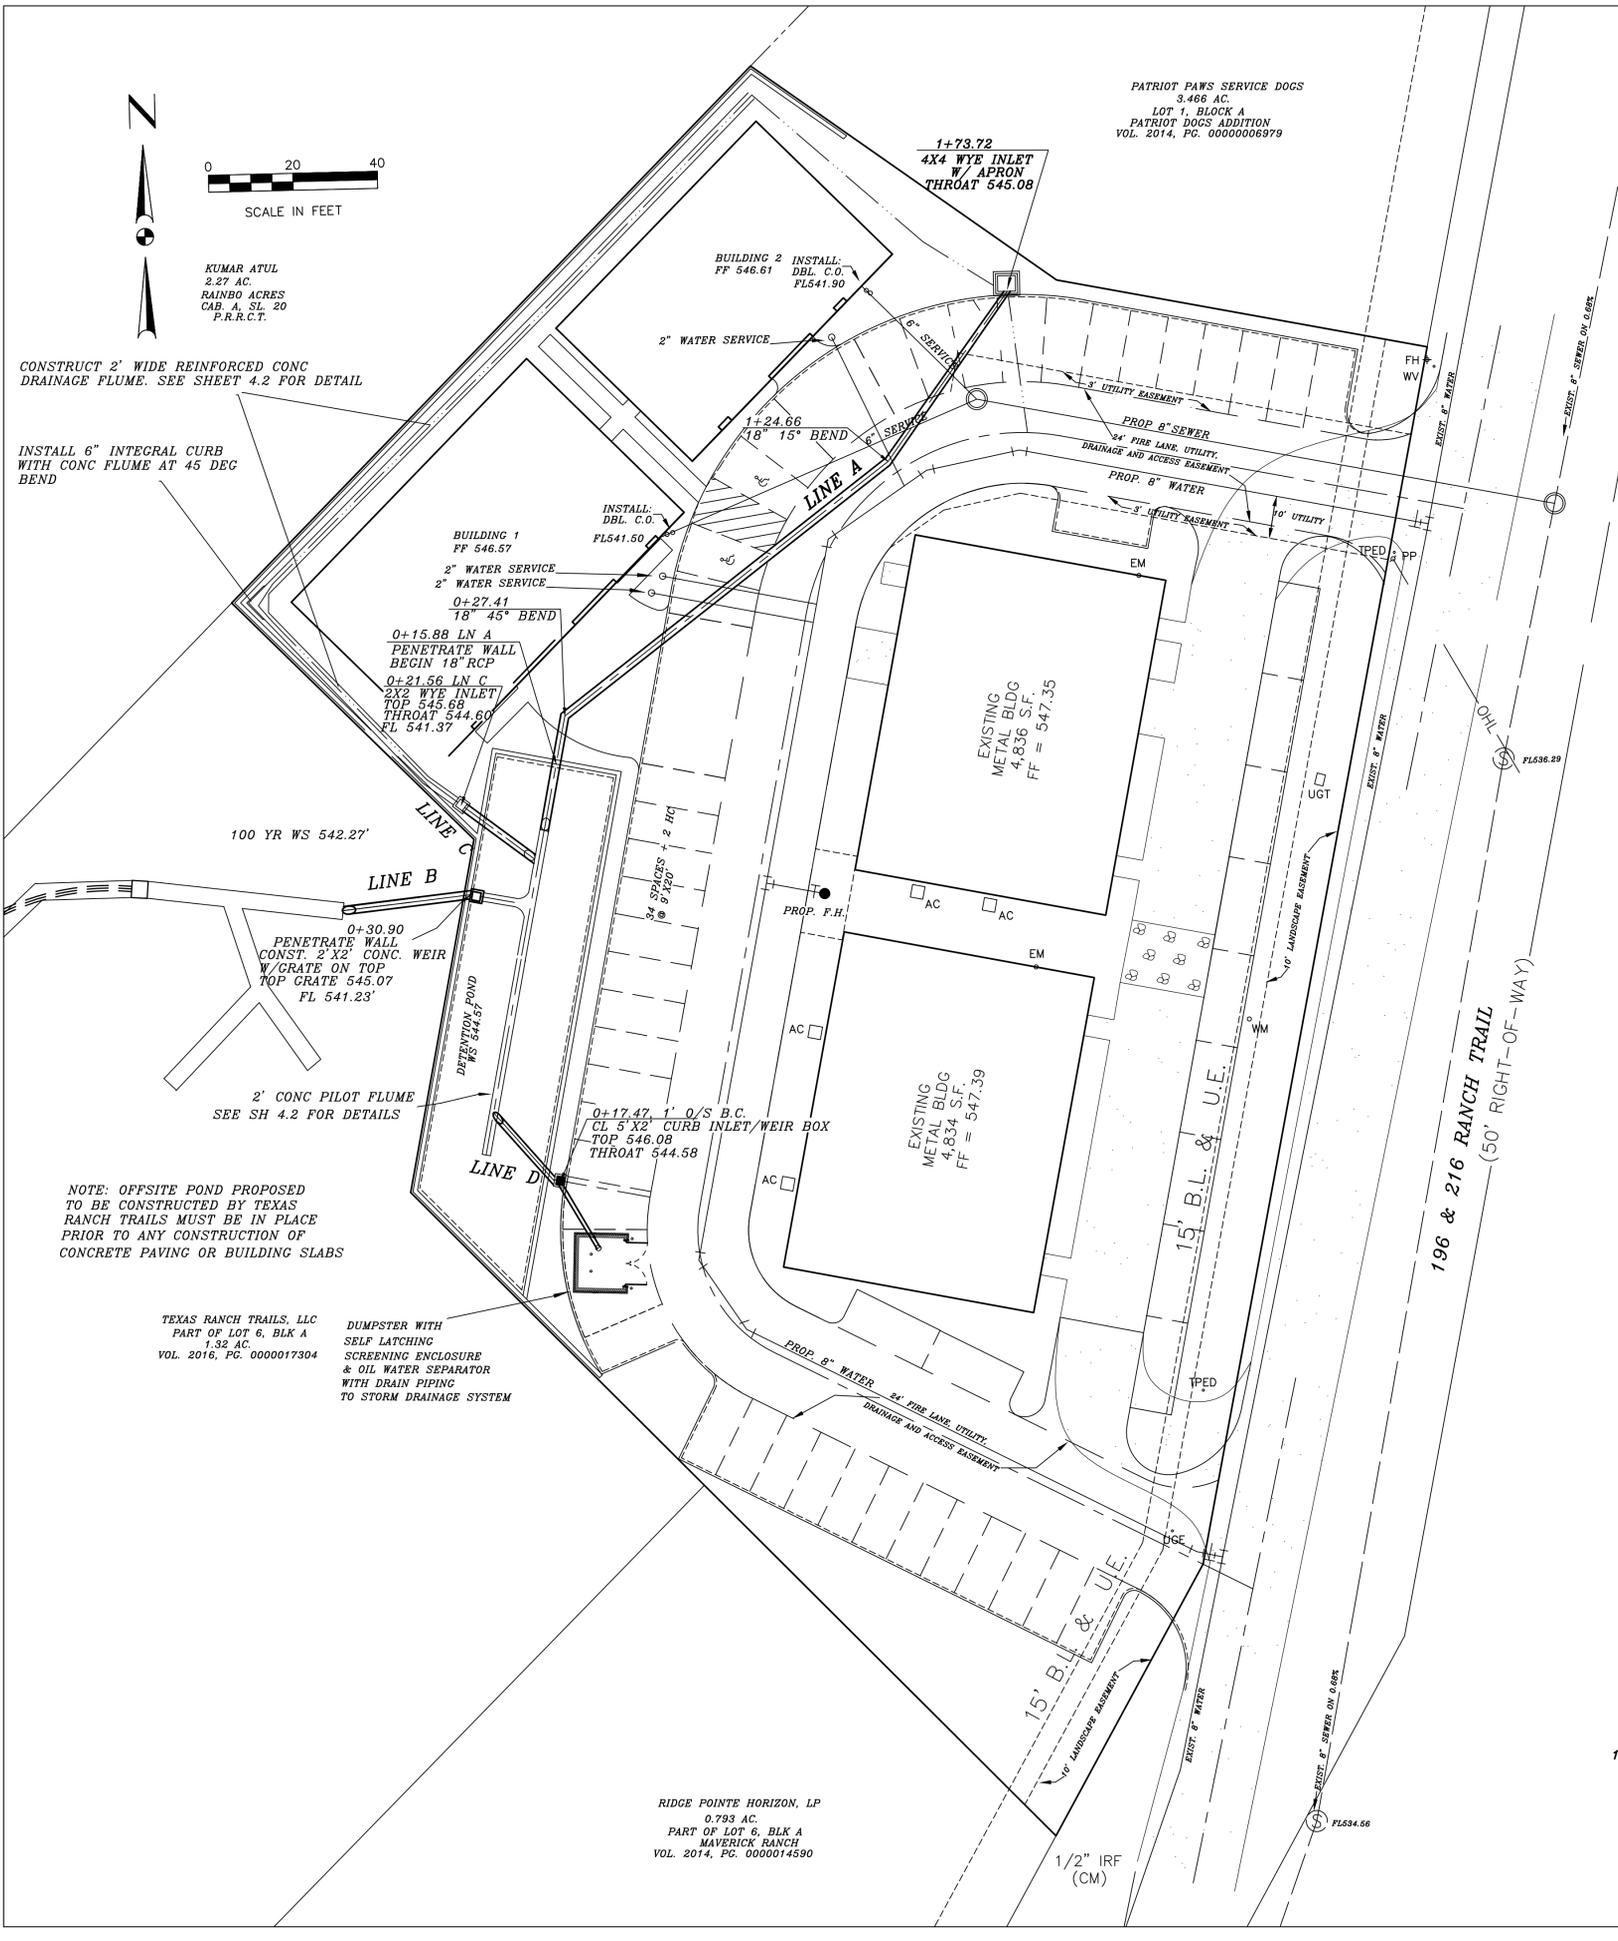

PATRIOT PAWS SERVICE DOGS  
 3.466 AC.  
 LOT 1, BLOCK A  
 PATRIOT DOGS ADDITION  
 VOL. 2014, PG. 0000006979

KUMAR ATUL  
 2.27 AC.  
 RAINBO ACRES  
 CAB. A, SL. 20  
 P.F.R.C.T.

CONSTRUCT 2' WIDE REINFORCED CONC DRAINAGE FLUME. SEE SHEET 4.2 FOR DETAIL

INSTALL 6" INTEGRAL CURB WITH CONC FLUME AT 45 DEG BEND

BUILDING 1  
 FF 546.57  
 2" WATER SERVICE

0+15.88 LN A  
 PENETRATE WALL  
 BEGIN 18" RCP

0+21.56 LN C  
 2X2 WYE INLET  
 TOP 545.68  
 THROAT 544.60  
 FL 541.37

100 YR WS 542.27'

0+30.90  
 PENETRATE WALL  
 CONST. 2 X2' CONC. WEIR  
 W/GRATE ON TOP  
 TOP GRATE 545.07  
 FL 541.23'

2' CONC PILOT FLUME  
 SEE SH 4.2 FOR DETAILS

NOTE: OFFSITE POND PROPOSED TO BE CONSTRUCTED BY TEXAS RANCH TRAILS MUST BE IN PLACE PRIOR TO ANY CONSTRUCTION OF CONCRETE PAVING OR BUILDING SLABS

TEXAS RANCH TRAILS, LLC  
 PART OF LOT 6, BLK A  
 1.32 AC.  
 VOL. 2016, PG. 0000017304

DUMPSTER WITH SELF LATCHING SCREENING ENCLOSURE & OIL WATER SEPARATOR WITH DRAIN PIPING TO STORM DRAINAGE SYSTEM

RIDGE POINTE HORIZON, LP  
 0.793 AC.  
 PART OF LOT 6, BLK A  
 MAVERICK RANCH  
 VOL. 2014, PG. 0000014590



**DOUPHRATE & ASSOCIATES, INC.**  
 ENGINEERING - PROJECT MANAGEMENT - SURVEYING  
 2235 RIDGE RD., # 200 ROCKWALL, TEXAS 75087  
 PHONE: (972) 771-9004 FAX: (972) 771-9005

**EROSION CONTROL PLAN**  
**LOT 5, BLOCK A**  
**MAVERICK RANCH ADDITION**  
 CITY OF ROCKWALL  
 ROCKWALL COUNTY, TEXAS

REVISION	WLD.
CHECKED	G.C.W.
DRAWN	
SCALE	1" = 20'
DATE	MAY 2024
PROJECT	23028
	9.0

**STANDARDS FOR SILT FENCE**

**DEFINITION**

TEMPORARY BARRIER FENCE MADE OF BURLAP OR POLYPROPYLENE MATERIAL WHICH IS WATER PERMEABLE BUT WILL TRAP WATER - BORNE SEDIMENT.

**PURPOSE**

TO INTERCEPT AND DETAIN WATER - BORNE SEDIMENT FROM UNPROTECTED AREAS OF LIMITED EXTENT.

**CONDITIONS WHERE PRACTICE APPLIES**

SILT FENCE IS USED DURING THE PERIOD OF CONSTRUCTION NEAR THE PERIMETER OF A DISTURBED AREA TO INTERCEPT SEDIMENT WHILE ALLOWING WATER TO PERCOLATE THROUGH. THIS FENCE SHALL REMAIN IN PLACE UNTIL THE DISTURBED AREA IS PERMANENTLY STABILIZED. SILT FENCE SHOULD NOT BE USED WHERE THERE IS A CONCENTRATION OF WATER IN A CHANNEL OR OTHER DRAINAGE WAY.

**DESIGN CRITERIA**

SILT FENCE IS CONSTRUCTED NEAR THE PERIMETER OF A DISTURBED SITE WITHIN THE DEVELOPING AREA. IT IS NOT TO BE CONSTRUCTED OUTSIDE THE PROPERTY LINES WITHOUT OBTAINING A LETTER OF PERMISSION FROM THE AFFECTED ADJACENT PROPERTY OWNERS.

A DESIGN IS NOT REQUIRED FOR THE INSTALLATION OF THE SILT FENCE. HOWEVER, THE FOLLOWING CRITERIA SHALL BE OBSERVED:

- HEIGHT - 30 INCHES MINIMUM HEIGHT MEASURED FROM EXISTING OR GRADED GROUND.
- MATERIAL - BURLAP, POLYPROPYLENE FABRIC, OR NYLON REINFORCED WITH POLYESTER NETTING. THE MULLEN BURST STRENGTH SHALL BE GREATER THAN 150 PSI. THE EDGES SHALL BE TREATED TO PREVENT UNRAVELING.
- SUPPORT - STEEL FENCE POSTS SPACED A MAXIMUM OF 8 FEET APART. WOVEN WIRE WILL BE USED TO SUPPORT THE MATERIAL.

**OUTLET**

SILT FENCE SHALL BE PLACED AND CONSTRUCTED IN SUCH A MANNER THAT RUNOFF FROM A DISTURBED SURFACE OR EXPOSED UPLAND AREA SHALL BE INTERCEPTED, SEDIMENT TRAPPED, AND THE SURFACE RUNOFF ALLOWED TO PERCOLATE THROUGH THE STRUCTURE. SILT FENCE SHALL BE PLACED IN SUCH A MANNER THAT SURFACE RUNOFF WHICH PERCOLATES THROUGH WILL FLOW ONTO AN UNDISTURBED STABILIZED AREA OR STABILIZED OUTLET.

- NOTES:**
- SHOULD WORK CEASE FOR A PERIOD OF 21 DAYS PERMANENT STABILIZATION SHALL BE INSTALLED.
  - SHOULD THE CONTRACTOR STORE ANY FUEL OR OTHER HAZARDOUS MATERIAL ON-SITE THIS PLAN WILL BE MODIFIED TO REFLECT PROTECTION MEASURES.

**EROSION CONTROL GENERAL NOTES**

- STEEL POSTS WHICH SUPPORT THE SILT FENCE SHALL BE INSTALLED ON A SLIGHT ANGLE TOWARD THE ANTICIPATED RUNOFF SOURCE.
- THE TOE OF THE SILT FENCE SHALL BE TRENCHED IN WITH A SPADE OR MECHANICAL TO THE LINE OF FLOW.
- FOR THE SILT FENCE TO BE LAID IN THE GROUND AND BACKFILLED, SILT FENCE SHOULD BE SECURELY FASTENED TO EACH STEEL SUPPORT POST OR TO WOVEN WIRE, WHICH IS IN TURN ATTACHED TO THE STEEL FENCE POSTS.
- INSPECTION SHALL BE FREQUENT AND REPAIR OR REPLACEMENT SHALL BE MADE PROMPTLY AS NEEDED.

BLOCK OR IMPEDE STORM FLOW OR DRAINAGE. SEDIMENT TRAPPED BY THIS PRACTICE SHALL BE DISPOSED OF IN AN APPROVED SITE IN A MANNER THAT WILL NOT CONTRIBUTE TO ADDITIONAL SILTATION.

- DISPOSED OF IN AN APPROVED SPOIL SITE OR AS IN NO. 7 ABOVE.
- EROSION PROTECTION WILL BE DELETED OR ADDED PER THE CITY OF ROCKWALL.
- THE CONTRACTOR SHALL COMPLY WITH ALL APPLICABLE FEDERAL, STATE, AND LOCAL EROSION, CONSERVATION, AND SILTATION ORDINANCES. THE CONTRACTOR SHALL REMOVE ALL TEMPORARY EROSION CONTROL DEVICES UPON COMPLETION OF PERMANENT DRAINAGE FACILITIES AND THE ESTABLISHMENT OF A STAND OF GRASS OR OTHER GROWTH TO PREVENT EROSION.
- ALL SEEDING AND FERTILIZATION OF DISTURBED AREAS WILL BE THE RESPONSIBILITY OF THE GRADING CONTRACTOR.

**STORM DRAIN INLET PROTECTION CONSTRUCTION SPECIFICATIONS**



- STEEL FRAME IS TO BE CONSTRUCTED OF SUITABLE MATERIAL.
- WIRE MESH MUST BE OF SUFFICIENT STRENGTH TO SUPPORT FILTER FABRIC, AND STONE FOR CURB INLETS, WITH WATER FULLY IMPOUNDED AGAINST IT.
- FILTER CLOTH MUST BE OF A TYPE APPROVED FOR THIS PURPOSE; RESISTANT TO SUNLIGHT WITH SIEVE SIZE, E05, 40-85, TO ALLOW SUFFICIENT PASSAGE OF WATER AND REMOVAL OF SEDIMENT.
- STONE IS TO BE 2" IN SIZE AND CLEAN, SINCE FINES WOULD CLOG THE CLOTH.
- THE ASSEMBLY SHALL BE PLACED SO THAT THE END SPACERS ARE A MINIMUM 1" BEYOND BOTH ENDS OF THE THROAT OPENING.
- FORM THE WIRE MESH AND FILTER CLOTH TO THE CONCRETE GUTTER AND AGAINST THE FACE OF CURB ON BOTH SIDES OF THE INLET. PLACE CLEAN 2" STONE OVER THE WIRE MESH AND FILTER FABRIC IN SUCH A MANNER AS TO PREVENT WATER FROM ENTERING THE INLET UNDER OR AROUND THE FILTER CLOTH.
- THIS TYPE OF PROTECTION MUST BE INSPECTED FREQUENTLY AND THE FILTER CLOTH AND STONE REPLACED WHEN CLOGGED WITH SEDIMENT.
- ASSURE THAT STORM FLOW DOES NOT BYPASS INLET BY INSTALLING TEMPORARY EARTH OR ASPHALT DIKES DIRECTING FLOW INTO INLET.

- NOTE:**
- SILTATION FENCE SHALL BE PLACED AROUND INLETS DURING CONSTRUCTION.**
  - 75%-80% OF ALL DISTURBED AREAS TO HAVE MINIMUM 1" STAND OF GRASS (NOT RYE OR WEEDS) PRIOR TO CITY ACCEPTANCE.**

ALL RESPONSIBILITY FOR ADEQUACY OF DESIGN REMAINS WITH THE DESIGN ENGINEER. THE CITY OF ROCKWALL, IN REVIEWING AND RELEASING PLANS FOR CONSTRUCTION, ASSUMES NO RESPONSIBILITY FOR ADEQUACY OR ACCURACY OF DESIGN.

LOT ACREAGE 1.55 ACRES  
 LIMIT OF DISTURBANCE SHOWN AS PERIMETER OF SILT FENCE

REVISED TO CONFORM TO CONSTRUCTION RECORDS.  
 \_\_\_\_\_ DATE: 2-17-26

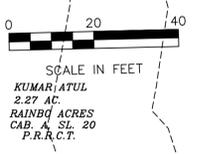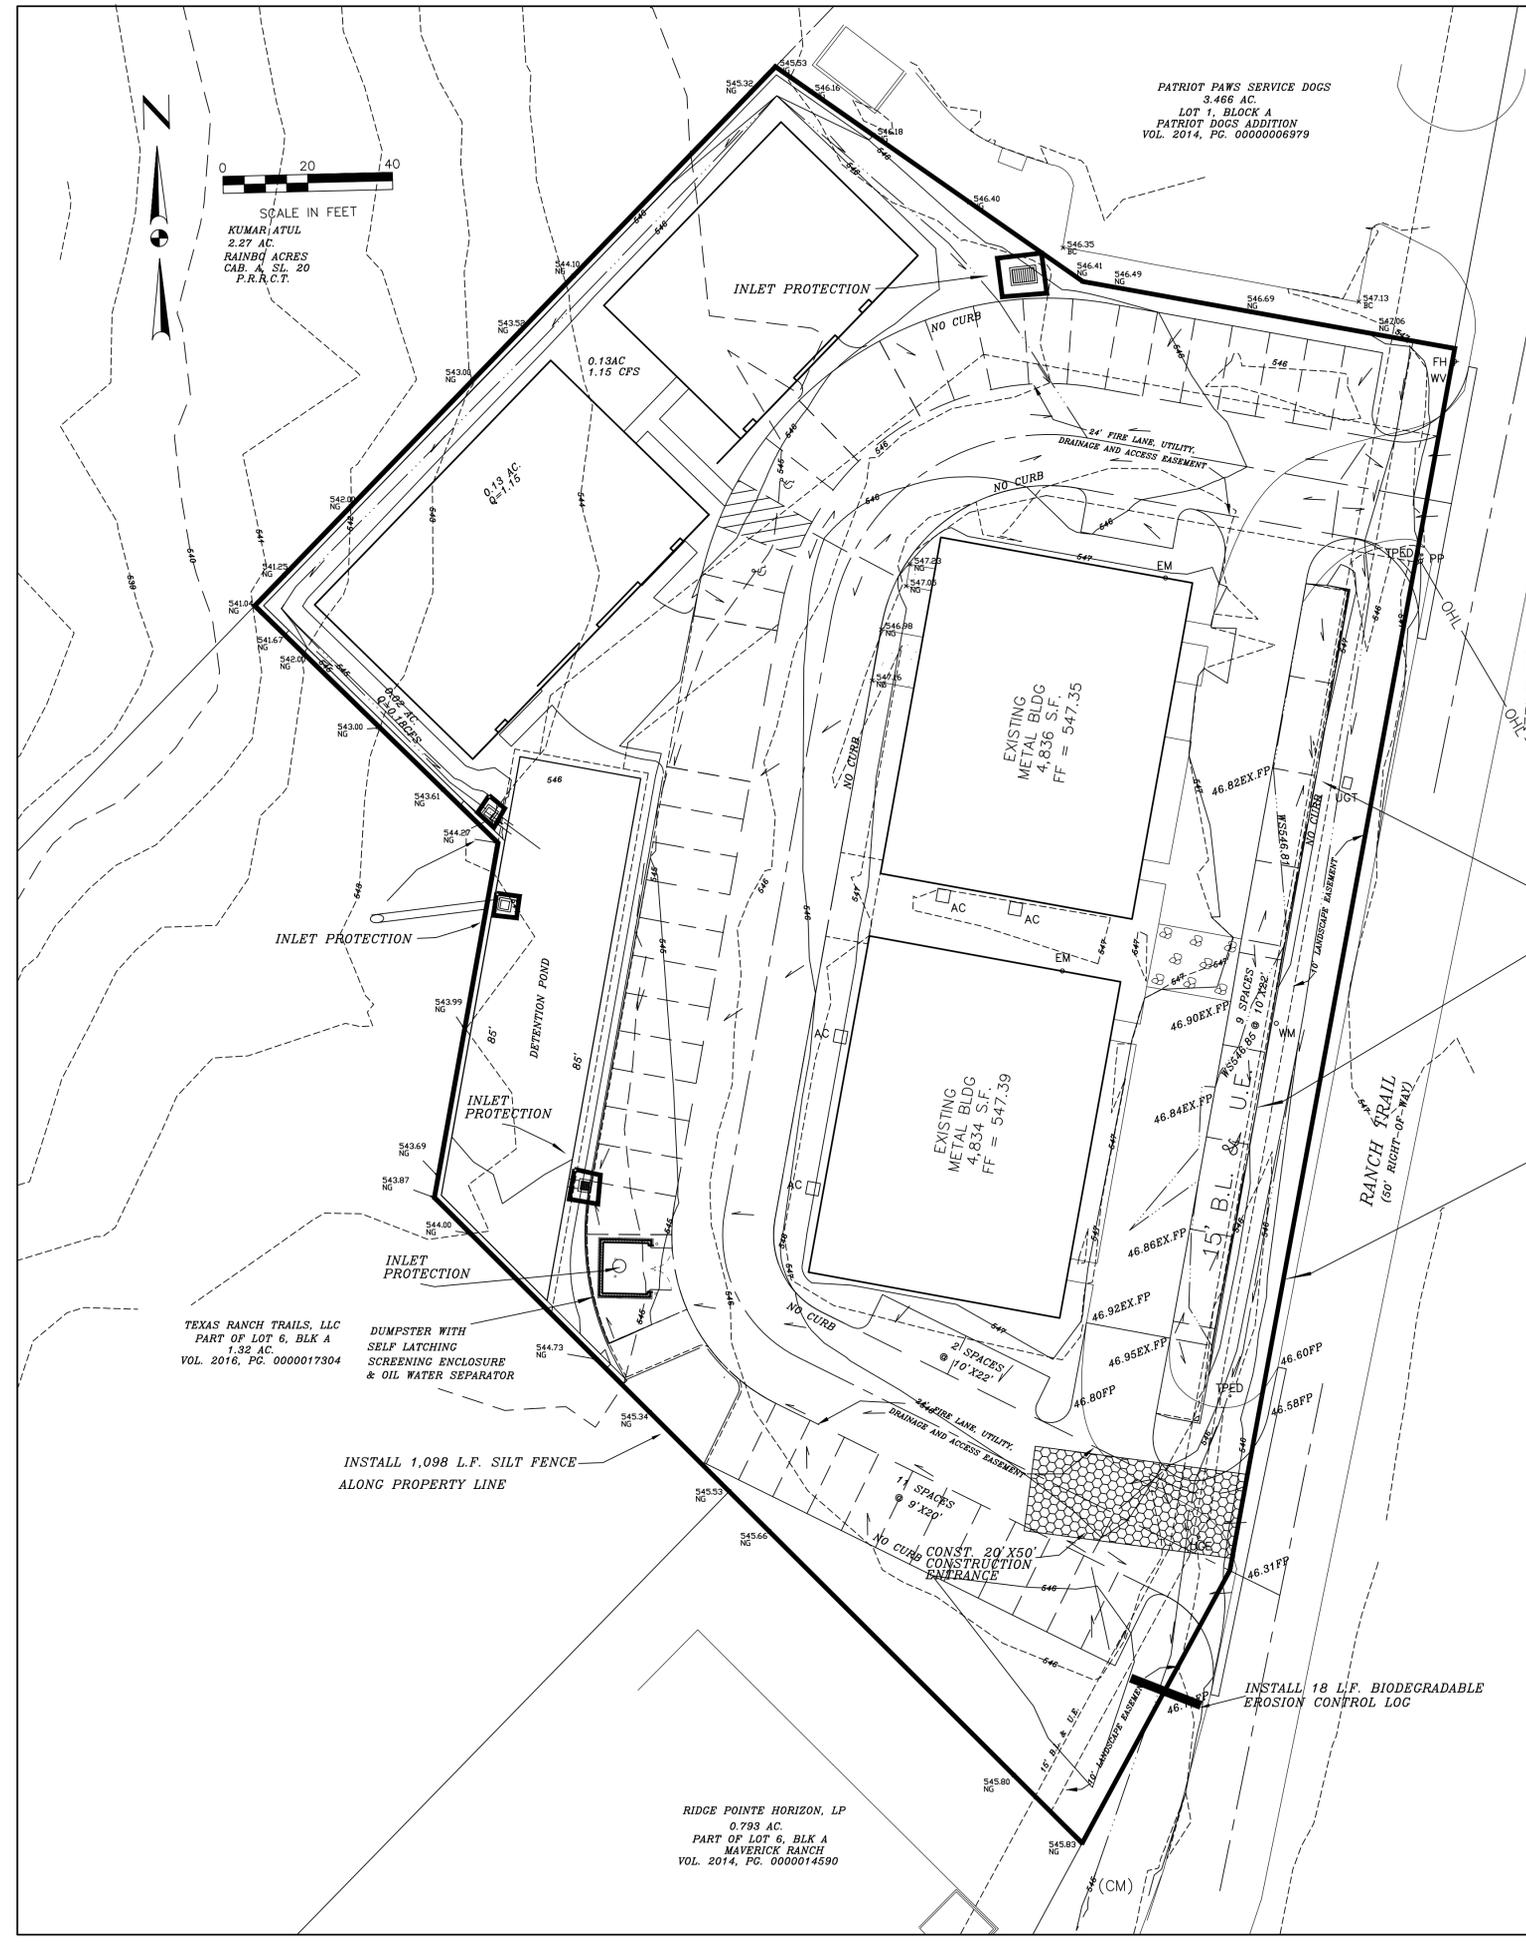

PATRIOT PAWS SERVICE DOGS  
 3.466 AC.  
 LOT 1, BLOCK A  
 PATRIOT DOGS ADDITION  
 VOL. 2014, PG. 0000006979

TEXAS RANCH TRAILS, LLC  
 PART OF LOT 6, BLK A  
 1.32 AC.  
 VOL. 2016, PG. 0000017304

DUMPSTER WITH  
 SELF LATCHING  
 SCREENING ENCLOSURE  
 & OIL WATER SEPARATOR

INSTALL 1,098 L.F. SILT FENCE  
 ALONG PROPERTY LINE

RIDGE POINTE HORIZON, LP  
 0.793 AC.  
 PART OF LOT 6, BLK A  
 MAVERICK RANCH  
 VOL. 2014, PG. 0000014590

INSTALL 18 L.F. BIODEGRADABLE  
 EROSION CONTROL LOG



THE SEAL APPEARING ON THIS DOCUMENT WAS AUTHORIZED BY W.L. DOUPHRATE, A TEXAS PROFESSIONAL ENGINEER, LICENSE NO. 60102, F-686, ON 04/29/2024.

**DOUPHRATE & ASSOCIATES, INC.**  
ENGINEERING-PROJECT MANAGEMENT SURVEYING  
2235 RIDGE RD., # 200 ROCKWALL, TEXAS 75087  
PHONE: (972)771-9004 FAX: (972)771-9005

**LANDSCAPING PLAN**  
**LOT 7, BLOCK A**  
**MAVERICK RANCH ADDITION**  
CITY ROCKWALL  
ROCKWALL COUNTY, TEXAS

REVISION	WLD.
CHECKED	
DRAWN	GCW.
SCALE	1" = 20' H 1" = 1' V
DATE	JAN 29, 2024
PROJECT	23028
	20

REVISED TO CONFORM TO CONSTRUCTION RECORDS.  
*W.L. Douphrate* DATE: 2-17-26

NOTE: ALL TREE LANDSCAPING TO BE PLANTED 10' FROM ANY UTILITIES

APPROVED:  
I hereby certify the above and foregoing site plan for a development in the City of Rockwall, Texas, was approved by the Planning & Zoning Commission of the City of Rockwall on the \_\_\_\_\_ day of \_\_\_\_\_, 2024.  
WITNESS OUR HANDS, this \_\_\_\_\_ day of \_\_\_\_\_, 2024.  
\_\_\_\_\_  
Planning & Zoning Commission, Chairman      Director of Planning and Zoning

ALL RESPONSIBILITY FOR ADEQUACY OF DESIGN REMAINS WITH THE DESIGN ENGINEER. THE CITY OF ROCKWALL, IN REVIEWING AND RELEASING PLANS FOR CONSTRUCTION, ASSUMES NO RESPONSIBILITY FOR ADEQUACY OR ACCURACY OF DESIGN.

**SITE DATA SUMMARY**



ZONING	C (COMMERCIAL)
PROPOSED USE	BUSINESS OFFICES
LOT AREA	1.550 ACRES
BUILDING SQUARE FOOTAGE	16,890 SQ. FT.
BUILDING FOOTPRINT	16,890 SQ. FT.
BUILDING HEIGHT	28 FT.
LOT COVERAGE	25.02%
PARKING REQUIRED	1 SPACE/300 S.F. = 57 SPACES
HANDICAP PARKING REQ'D	2 SPACE
PARKING PROVIDED	51 SPACES
HANDICAP PARKING PROVIDED	2 SPACE
INTERIOR LANDSCAPING REQ'D	15% OF TOTAL SITE (10,124 SQ.FT.)
INTERIOR LANDSCAPING PROVIDED	31,900 SQ. FT.
TOTAL SQUARE FOOTAGE OF IMPERVIOUS SURFACE	35,602 SQ. FT.

SITE NOTES:  
1. PARKING SPACES ARE 9'X20'  
2. ALL GROUND MOUNTED HVAC UNITS TO BE SCREENED WITH LANDSCAPING 1.550 AC.  
3. EXTERIOR LIGHTING TO BE WALL PACKS 67,502 SQ. FT.  
SEE BUILDING ELEVATIONS

**OWNER**  
1800 DALROCK, LLC  
2424 RIDGE RD  
ROCKWALL, TEXAS 75087  
(469)-298-1594

**SURVEYOR**  
FINCHER LAND SURVEYING, PLLC  
3213 INTERSTATE HIGHWAY 30, #107  
MEAGUIE, TEXAS 75150  
(903)-944-6397  
Texas Firm No. 10194258

CASE NO. SP 2024-003

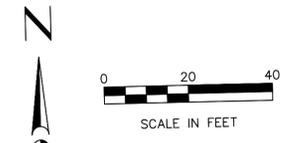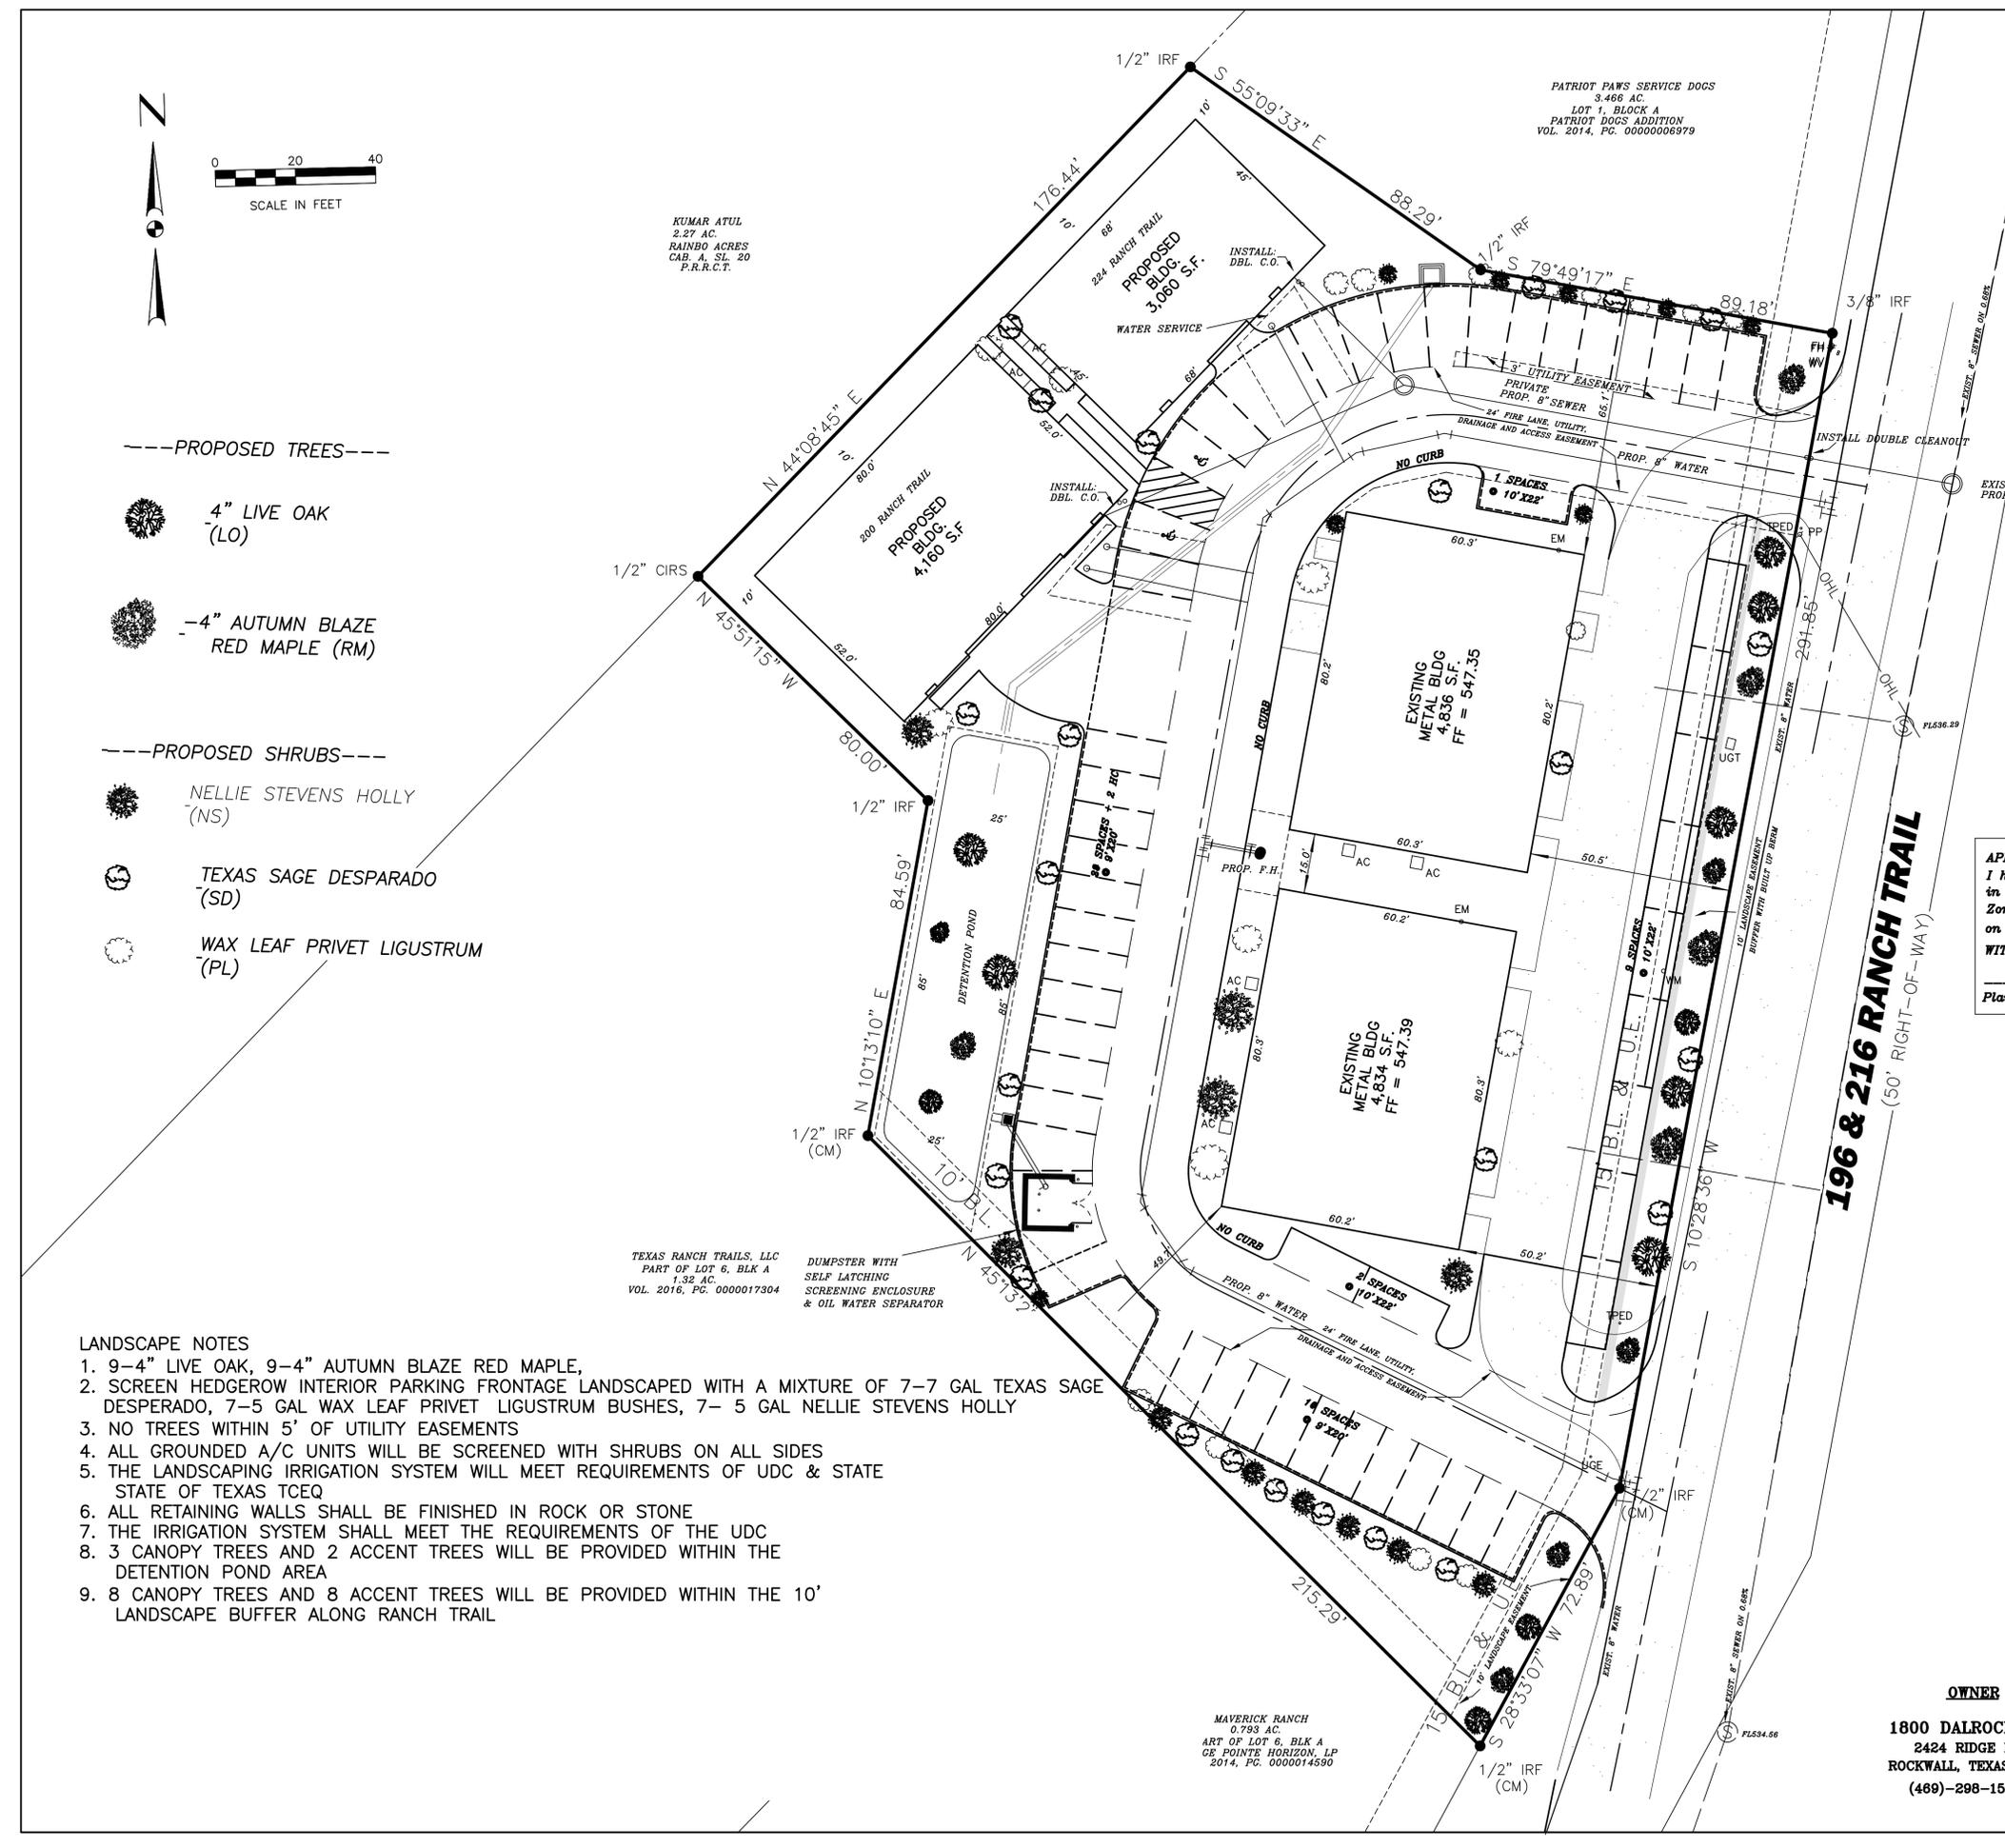

- PROPOSED TREES---
- 4" LIVE OAK (LO)
  - 4" AUTUMN BLAZE RED MAPLE (RM)
- PROPOSED SHRUBS---
- NELLIE STEVENS HOLLY (NS)
  - TEXAS SAGE DESPARADO (SD)
  - WAX LEAF PRIVET LIGUSTRUM (PL)

- LANDSCAPE NOTES**
- 9-4" LIVE OAK, 9-4" AUTUMN BLAZE RED MAPLE,
  - SCREEN HEDGEROW INTERIOR PARKING FRONTAGE LANDSCAPED WITH A MIXTURE OF 7-7 GAL TEXAS SAGE DESPERADO, 7-5 GAL WAX LEAF PRIVET LIGUSTRUM BUSHES, 7- 5 GAL NELLIE STEVENS HOLLY
  - NO TREES WITHIN 5' OF UTILITY EASEMENTS
  - ALL GROUND MOUNTED A/C UNITS WILL BE SCREENED WITH SHRUBS ON ALL SIDES
  - THE LANDSCAPING IRRIGATION SYSTEM WILL MEET REQUIREMENTS OF UDC & STATE OF TEXAS TCEQ
  - ALL RETAINING WALLS SHALL BE FINISHED IN ROCK OR STONE
  - THE IRRIGATION SYSTEM SHALL MEET THE REQUIREMENTS OF THE UDC
  - 3 CANOPY TREES AND 2 ACCENT TREES WILL BE PROVIDED WITHIN THE DETENTION POND AREA
  - 8 CANOPY TREES AND 8 ACCENT TREES WILL BE PROVIDED WITHIN THE 10' LANDSCAPE BUFFER ALONG RANCH TRAIL

KUMAR ATUL  
2.27 AC.  
RAINBO ACRES  
CAB. A, SL. 20  
P.R.A.C.T.

TEXAS RANCH TRAILS, LLC  
PART OF LOT 6, BLK A  
1.32 AC.  
VOL. 2016, PG. 0000017304

DUMPSTER WITH  
SELF LATCHING  
SCREENING ENCLOSURE  
& OIL WATER SEPARATOR

MAVERICK RANCH  
0.793 AC.  
ART OF LOT 6, BLK A  
CE POINTE HORIZON, LP  
2014, PG. 0000014590

PATRIOT PAWS SERVICE DOGS  
3.466 AC.  
LOT 1, BLOCK A  
PATRIOT DOGS ADDITION  
VOL. 2014, PG. 0000006979