



Revised 04/10

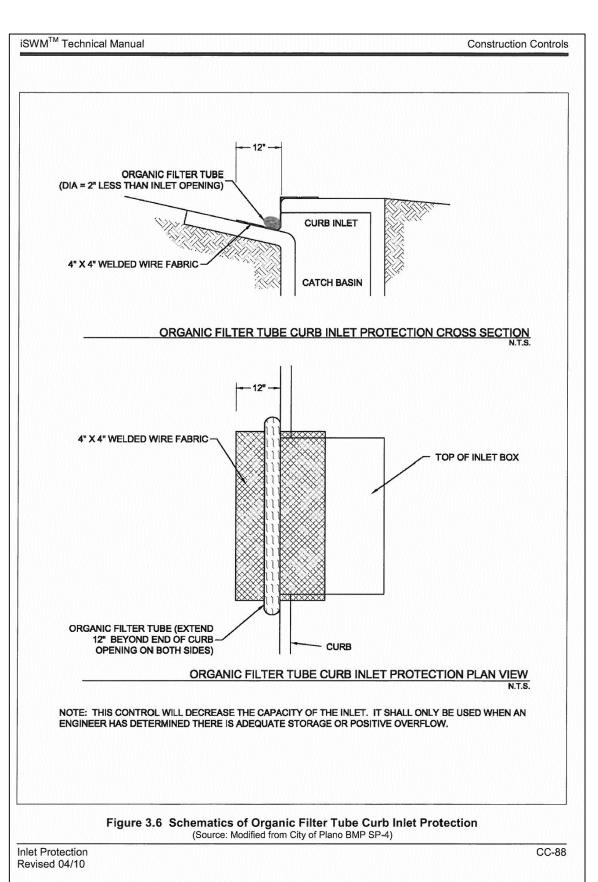

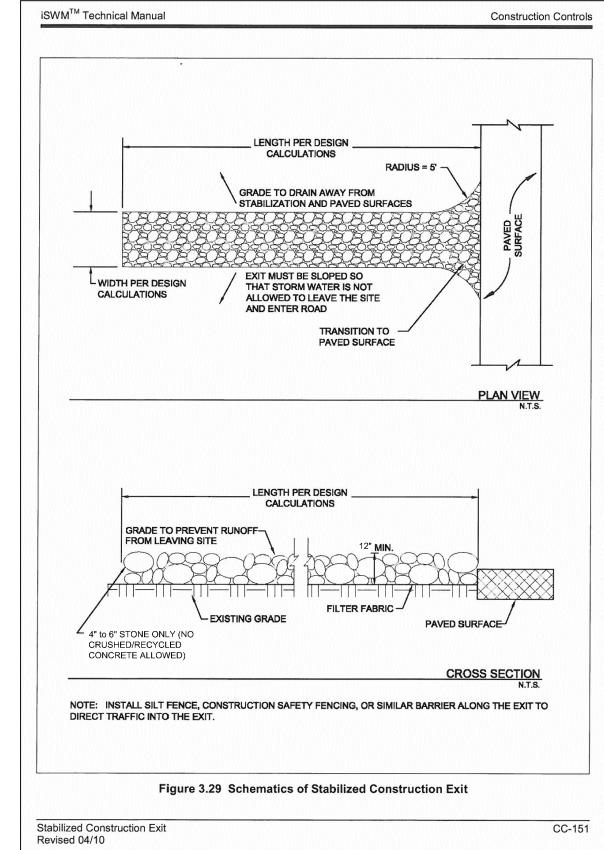

## RECORD DRAWING

THIS RECORD DRAWING TO THE BEST OF OUR KNOWLEDGED BURGESS AND NIPLE, INC. 3 SUGAR CREEK CENTER BOULEVARD, SUITE 610 SUGAR LAND, TEXAS 77478, HEREBY STATES THIS PLAN IS AS=BUILT. THIS INFORMATION PROVIDED IS BASED ON SURVEYIGN AT THE SITE AND INFORMATION PROVIDED BY THE CONTRACTOR.

THOMAS A. LUNZMAN P.E. DATE

JOB NUMBER: 56211

DESIGNED BY: TAL

DRAWN BY: NRM/TAL

APPROVED BY: TAL

CHECKED BY: JTR

DATE: 01/29/2019

SCALE: NONE

SHEET NUMBER: OF

C.22 23

CTCOG E

THOMAS A. LUNZMAN

122259

CENSE

ONAL ENGINEERS

NUMBER: 56211

GNED BY: TAL