
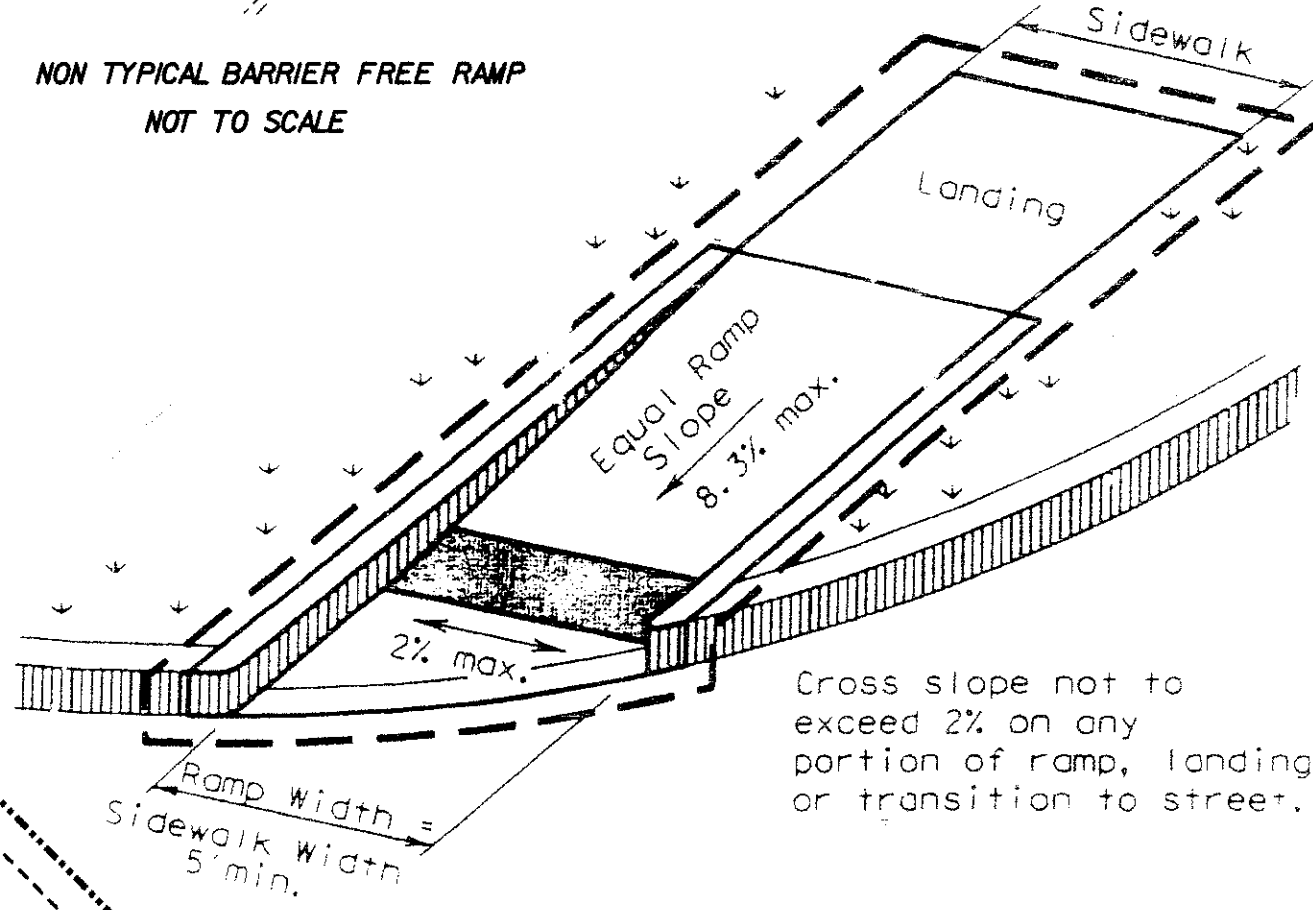
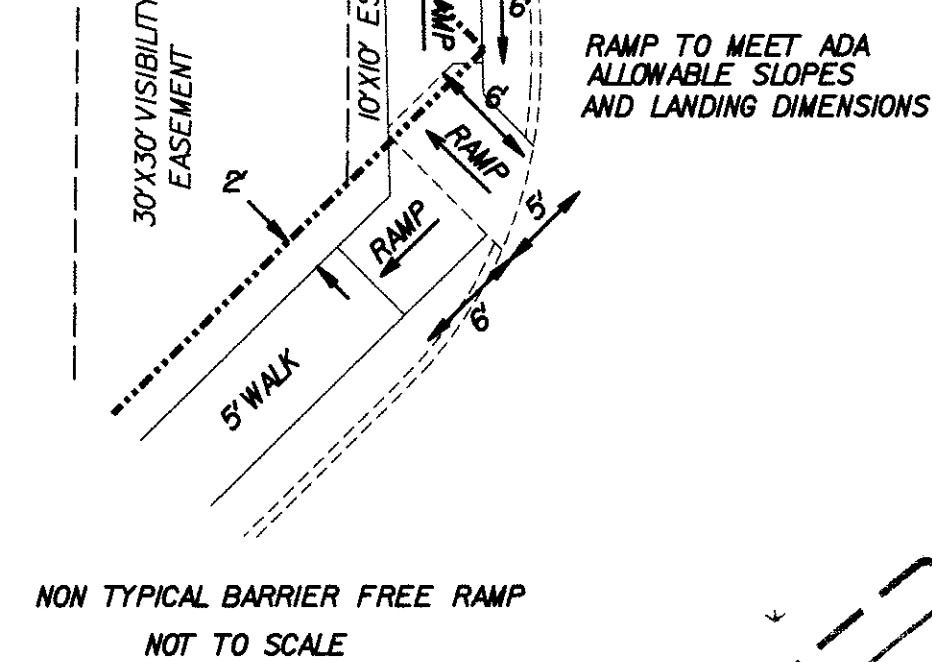
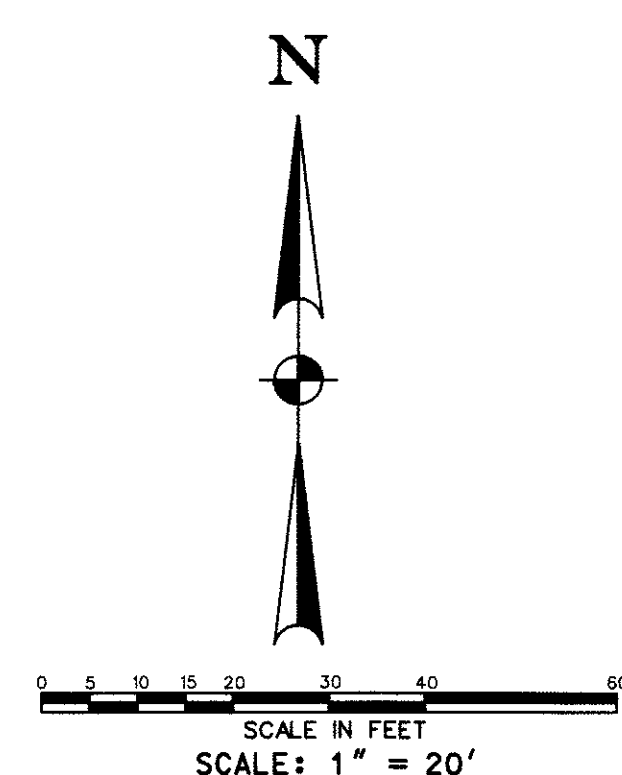
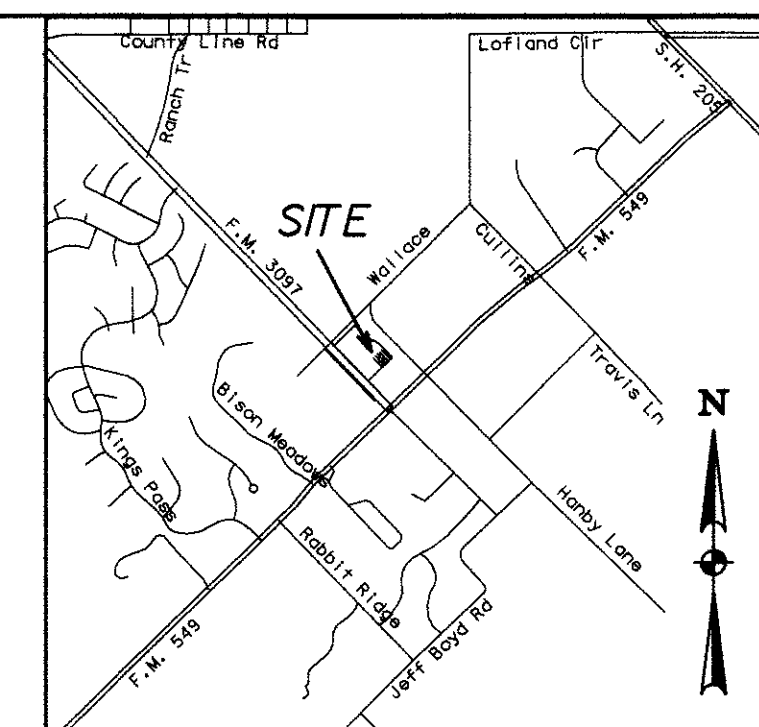


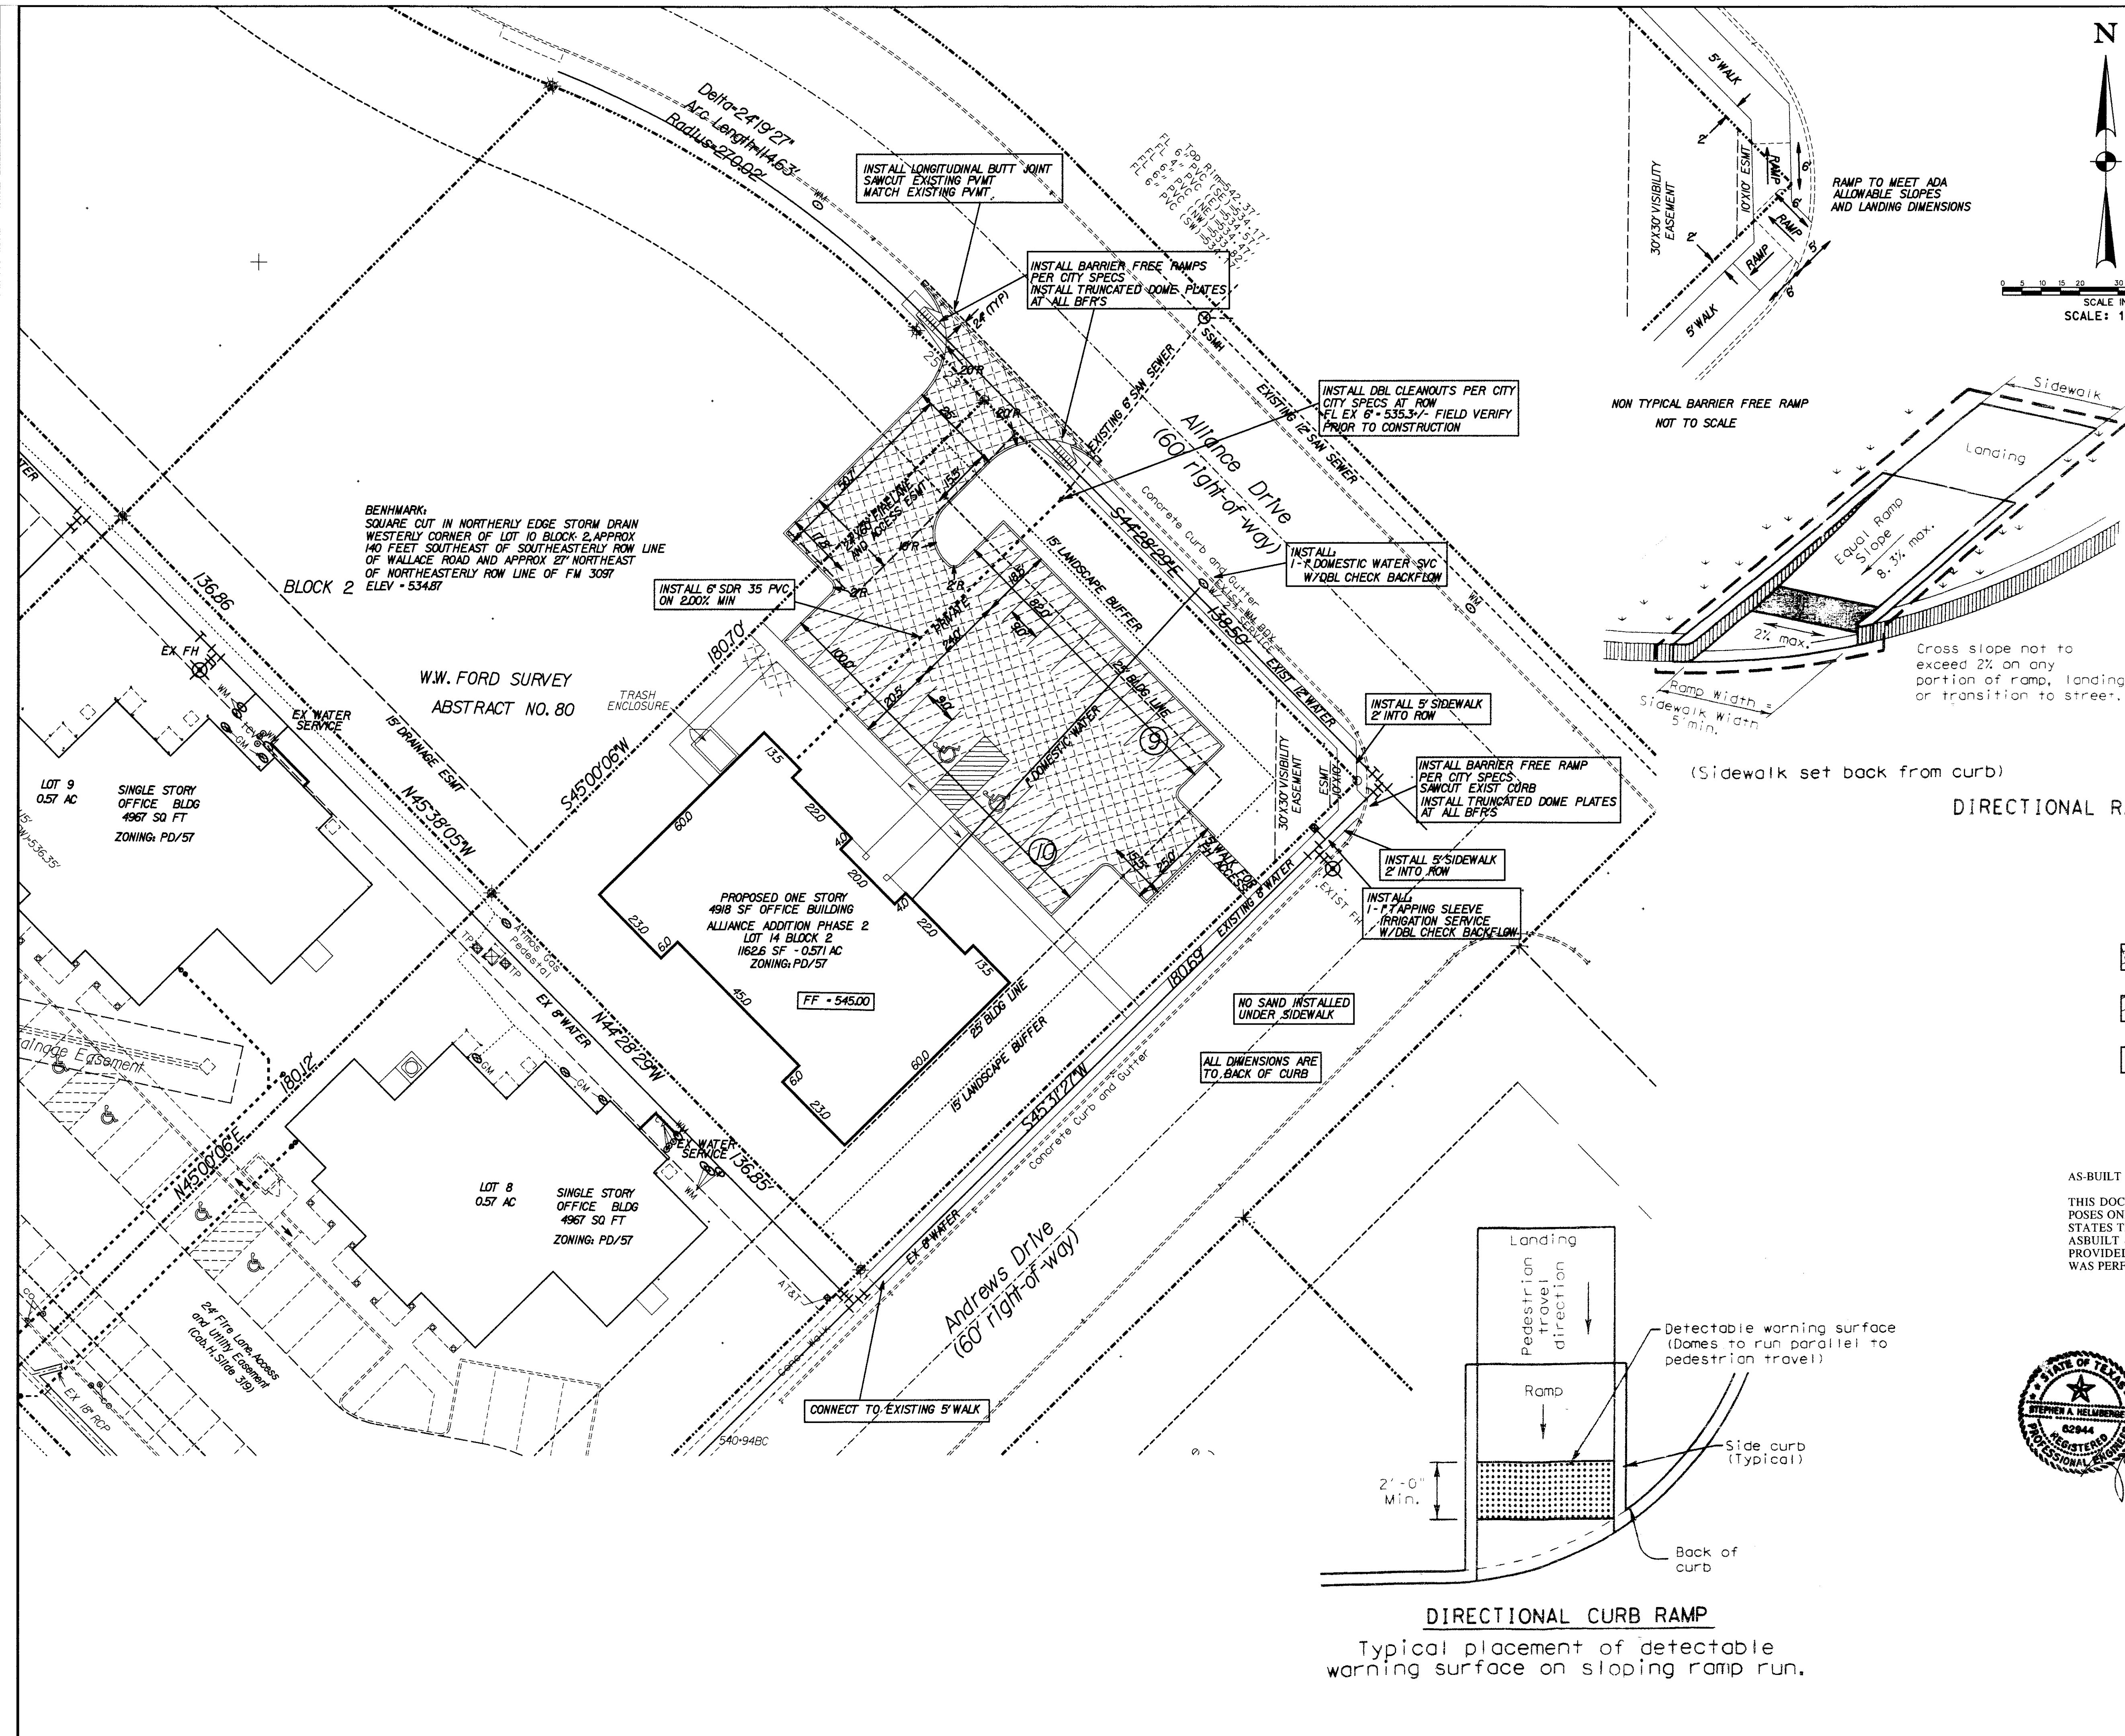

LINE LEGEND:


---	PROPERTY LINE
---	DRAINAGE FLOW
---	PROPOSED WATER LINE
---	ROAD CENTER LINE
---	PROPOSED STORM SEWER
---	PROPOSED STREET
---	EXISTING CONTOUR LINE
---	PROPOSED CONTOUR LINE
---	BUILDING SETBACK LINE
---	DRAINAGE EASEMENT
---	DRAINAGE DIVIDE LINE
---	ROW LOT LINE
---	PROPOSED FENCE

DIRECTIONAL RAMPS

- FIRELANE PAVEMENT AND DUMPSTER
6" 3600 PSI CONCRETE MIN 6.5 SACK WITH NO. 4 BARS ON 18" CENTERS BOTH WAYS ON 6" THICK LIME STABILIZED SUBGRADE
- PARKING LOT PAVEMENT
5" 3600 PSI CONCRETE MIN 6.5 SACK WITH NO. 3 BARS ON 18" CENTERS BOTH WAYS ON COMPACTED SUBGRADE
- SIDEWALK PAVEMENT
4" 3600 PSI CONCRETE MIN 6.5 SACK WITH NO. 4 BARS ON 18" CENTERS BOTH WAYS

AS-BUILT DRAWING 07-05-17

THIS DOCUMENT IS SUBMITTED AS AN "AS-BUILT DRAWING" FOR RECORD PURPOSES ONLY. TO THE BEST OF OUR KNOWLEDGE HELMBERGER ASSOCIATES, INC. STATES THAT THIS PLAN IS AS-BUILT. THIS INFORMATION IS BASED ON LIMITED AS-BUILT SURVEYING AT THE SITE PROVIDED BY OTHERS AND INFORMATION PROVIDED BY THE OWNER/CONTRACTOR. CONSTRUCTION SUPERVISION WAS PERFORMED BY OTHERS. TBPE FIRM NO. 000756

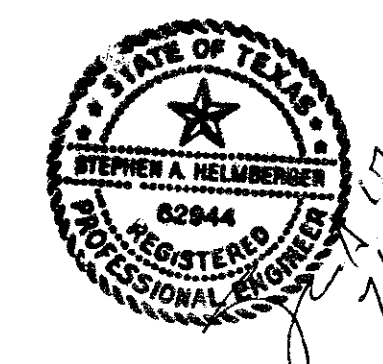

OWNER:
RANDALL NOE ENTERPRISES INC.
P.O. BOX 369
ROCKWALL, TEXAS 75087
MR. ROB WHITTLE
(972) 771-5253

ENGINEER:
HELMBERGER ASSOCIATES, INC.
1525 BOZMAN ROAD
WYLLIE, TEXAS 75098
MR. STEPHEN A. HELMBERGER, P.E.
(972) 442-7459

PAVING AND UTILITY PLAN

LOT 13 BLOCK 2 - ALLIANCE ADDITION PH 2
RANDALL NOE ENTERPRISES INC.
CITY OF ROCKWALL, TEXAS

DESIGN	DRAWN	DATE	SCALE	NOTES	FILE	NO.
HELM.	CADD	JUNE 2015	1"=20'	PBB	1507	C2

DIRECTIONAL CURB RAMP
Typical placement of detectable warning surface on sloping ramp run.