

CIVIL CONSTRUCTION PLANS

BARRETT HEIGHTS

SITE IMPROVEMENTS

GREEN VALLEY SUBDIVISION LOTS 1 & 2

CITY OF ROCKWALL

ROCKWALL COUNTY, TEXAS

GENERAL NOTES
(APPLICABLE TO ALL SHEETS)

- Excavated material shall be placed as directed by the Owner.
- Construction shall meet the requirements of the latest revision of the Standards of Design and Standard Details for the City of Rockwall & NTCOG Standards, 5TH Edition.
- All fill areas to be density controlled and compacted to 95% density at optimum moisture content. Compacted with sheep foot roller.
- Pavement thickness and strength shall be as follows:
Fire Lanes.....7"
Parking areas.....5"
3600 psi at 28 days and reinforced with No. 4 bar at 18" centers each way using a 6 sack mix for machine pour and a 6-1/2 sack mix for hand pour.
- All street subgrade shall be moisture controlled and compacted to 95% standard proctor density.
- It shall be the responsibility of the Contractor to locate and verify all existing utilities prior to the beginning of construction to insure no conflicts between all utility lines.
- Where water pipelines either cross or otherwise come within 9 feet of a sanitary sewer pipeline, the sewer pipeline shall be with a minimum working pressure Class 150 psi.
- All water lines installed to be PVC pipe C900 conforming to AWWA DRI4 Standard C-900, fitting shall be mechanical or O-ring.
- All water lines are to be installed a minimum of 48" deep measured from top of pipe.
- All storm inlets shall be cast-in-place with a minimum of 4200 psi and 7.0 sack for all structures.
- Utility contractor shall use MEGALUGS when installing the water line and double strap services when installing the services.
- Water services shall be a minimum of 1" SDR-9 polyethelene pipe installed with two in-line nylon ball cutoff valves inside the meter box. Corporation cock shall be Mueller No. H-15000 w/ straight coupling nut or approved equal. Curb stops shall be Mueller No. H-15174 MK oriseal or approved equal.
- All water lines shall be pressure tested and disinfected in accordance with AWWA C 601.
- All gate valves shall be Mueller or approved equal and conform to AWWA C-500 specifications. All gate valves shall be iron body, bronze mounted, double disk, parallel seat, non-rising stem, internal wedging type.
- All fire hydrants shall be located 2' to 6' behind curb line. All fire hydrants shall be Mueller or approved equal.
- All handicap ramps shall be installed with paving.
- Contractor is responsible for acquiring NTCOG and Rockwall Standards and Details.
- Blue EMS disk to installed at every change in direction, services, and valves on waterlines
- Green EMS disks to installed at every change in direction, manhole, cleanout, and service on sanitary sewer lines.
- Floodway monument shall be installed per City of Rockwall detail.
- All gravity sewer shall be SDR 35, unless otherwise noted and in conformance with City of Rockwall Standards.
- All TxDOT & CITY right-of-way to be sodded.
- Contractor to adjust all proposed utilities to grade.



CAUTION!!!

UNDERGROUND UTILITIES

EXISTING UTILITIES AND UNDERGROUND FACILITIES INDICATED ON THESE PLANS HAVE BEEN LOCATED FROM REFERENCE INFORMATION SUPPLIED BY THE VARIOUS OWNERS OF THE FACILITIES. THE ENGINEER DOES NOT ACCEPT THE RESPONSIBILITY FOR THE UTILITY LOCATIONS SHOWN. IT SHALL BE THE RESPONSIBILITY OF THE CONTRACTOR TO VERIFY BOTH HORIZONTALLY AND VERTICALLY THE LOCATION OF ALL EXISTING UTILITIES AND UNDERGROUND FACILITIES PRIOR TO CONSTRUCTION, TO TAKE NECESSARY PRECAUTIONS IN ORDER TO PROTECT ALL FACILITIES ENCOUNTERED, AND TO NOTIFY THE ENGINEER PROMPTLY OF ALL CONFLICTS OF THE WORK WITH EXISTING FACILITIES. THE CONTRACTER SHALL PRESERVE AND PROTECT ALL EXISTING FACILITIES FROM DAMAGE DURING CONSTRUCTION. ANY DAMAGE BY THE CONTRACTER TO EXISTING UTILITIES SHALL BE REPAIRED BY THE CONTRACTOR AT HIS/HER EXPENSE.

NOTE:

CONTRACTOR TO VERIFY IN THE FIELD THE LOCATION OF ALL EXISTING UTILITIES PRIOR TO CONSTRUCTION. INFORMATION PROVIDED WITHIN THESE PLANS DOES NOT RELIEVE THE CONTRACTOR OF THE FULL AND TOTAL RESPONSIBILITY FOR THE PROTECTION OF EXISTING UTILITIES NOR ANY DAMAGES CAUSED BY SAID CONTRACTOR DURING CONSTRUCTION.

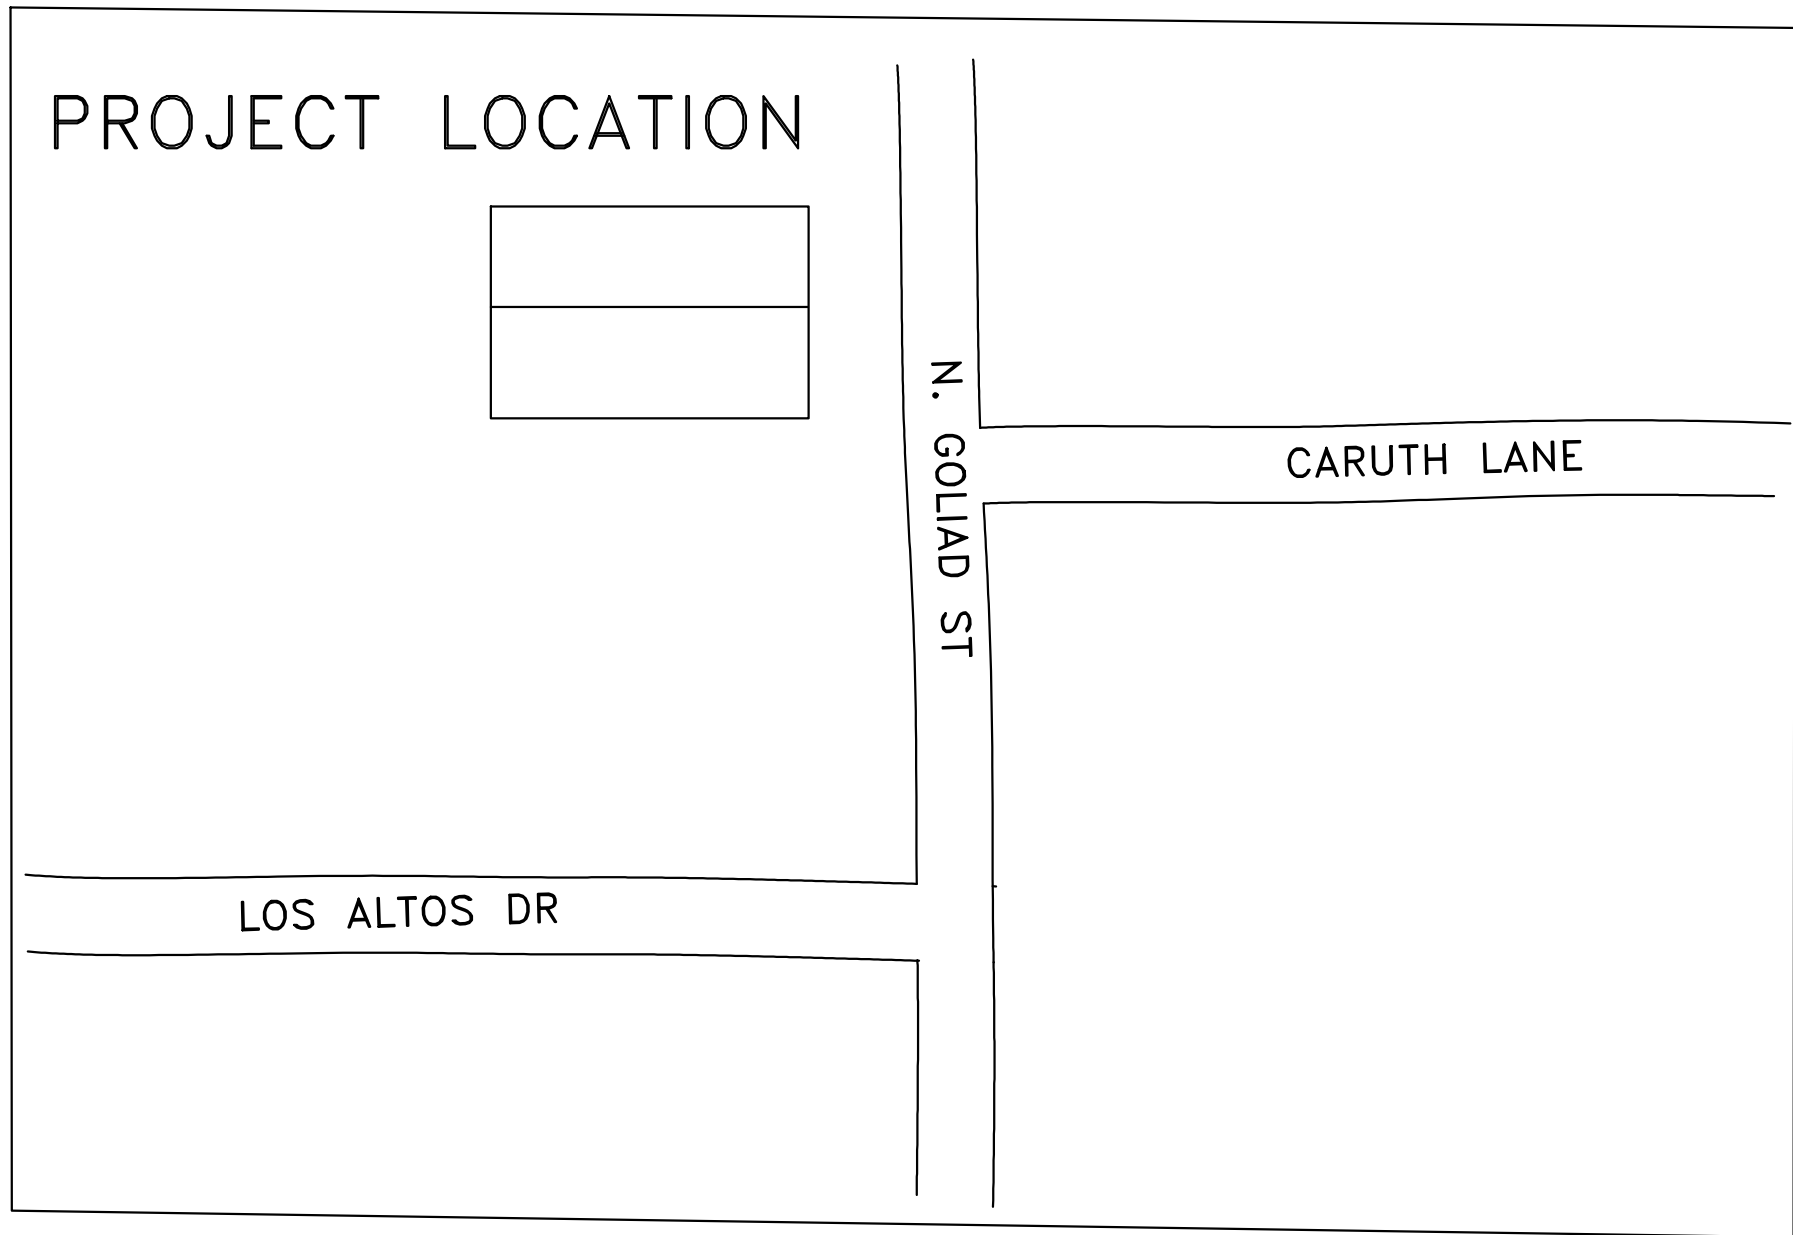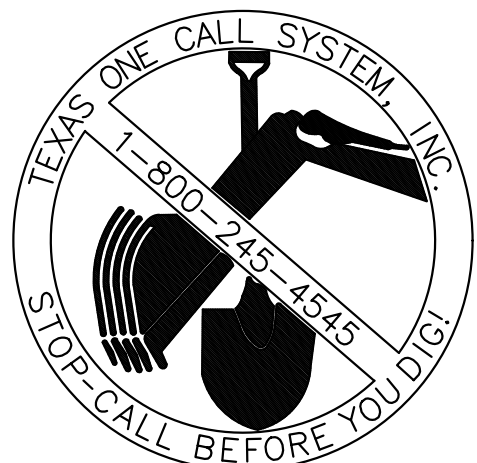

LOCATION MAP
NTS

GENERAL NOTES
(APPLICABLE TO ALL SHEETS)





- ALL WORKS ON THIS PROJECT/CONTRACT SHALL COMPLY WITH ALL THE REQUIREMENTS OF CITY OF ROCKWALL AND AUTHORITIES HAVING JURISDICTION.

SHEET INDEX

- COVER SHEET
- FINAL PLAT
- CITY OF ROCKWALL GENERAL CONSTRUCTION NOTES
- SITE & LANDSCAPING PLAN
- TREE PRESERVATION PLAN
- DIMENSION CONTROL PLAN
- DRAINAGE AREA MAP
- STORMWATER DETENTION CALCULATIONS
- WEIR DETAIL, DRAINAGE PILOT FLUME DETAIL
- GRADING PLAN
- EROSION CONTROL PLAN
- EROSION CONTROL DETAILS
- PAVING DETAILS


REVISED TO CONFORM TO CONSTRUCTION RECORDS.

W.L. Douphrate II DATE: 6-15-24

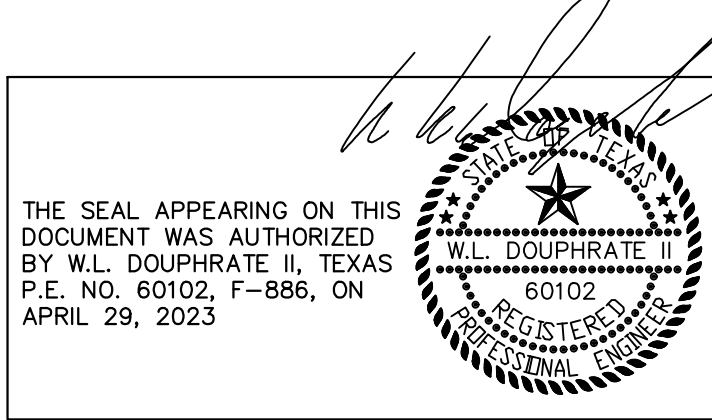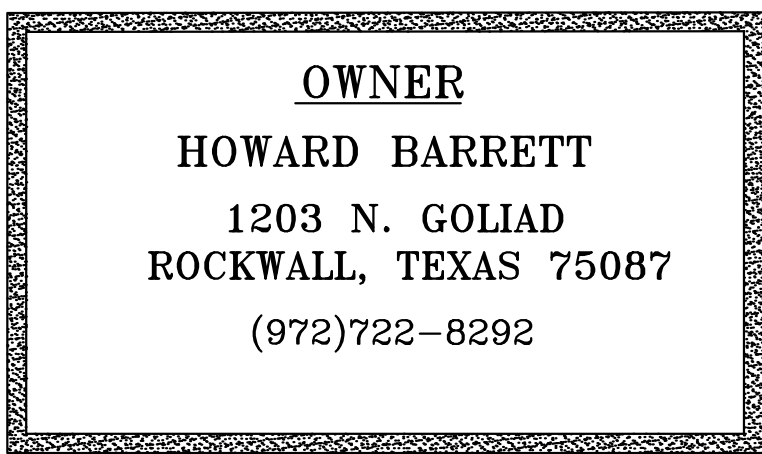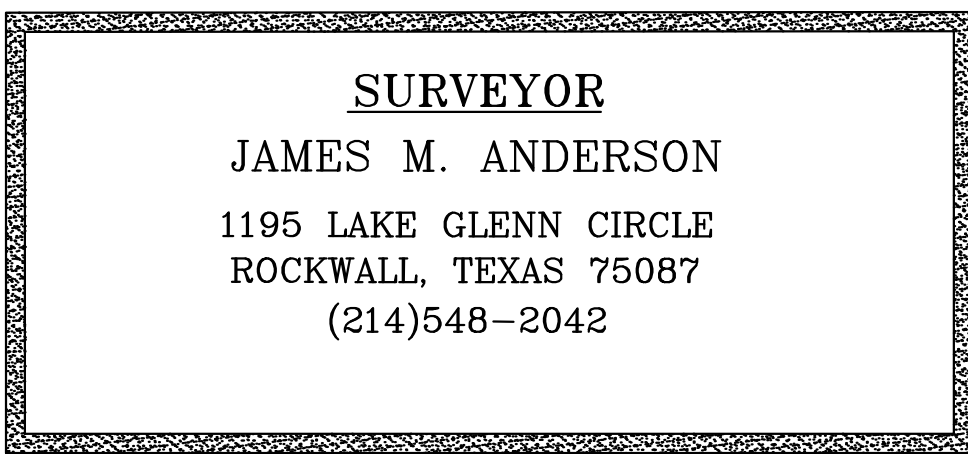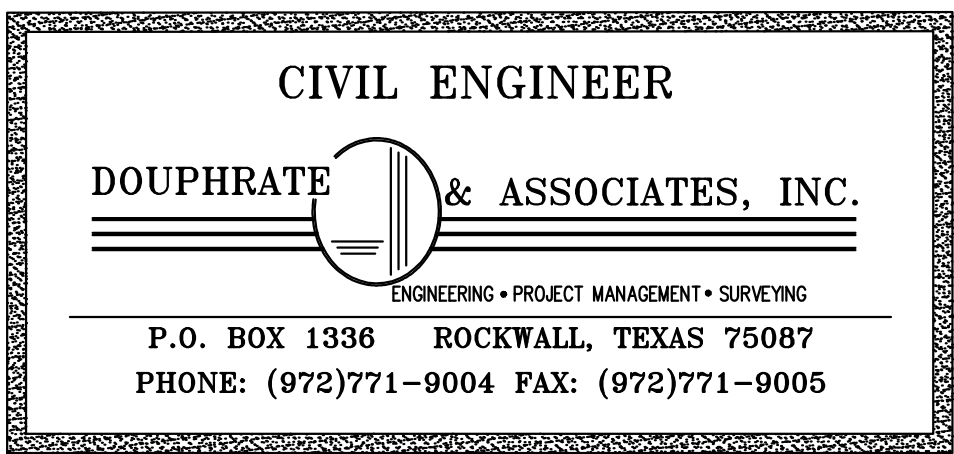

APRIL, 2023

BARRETT HEIGHTS SITE IMPROVEMENTS

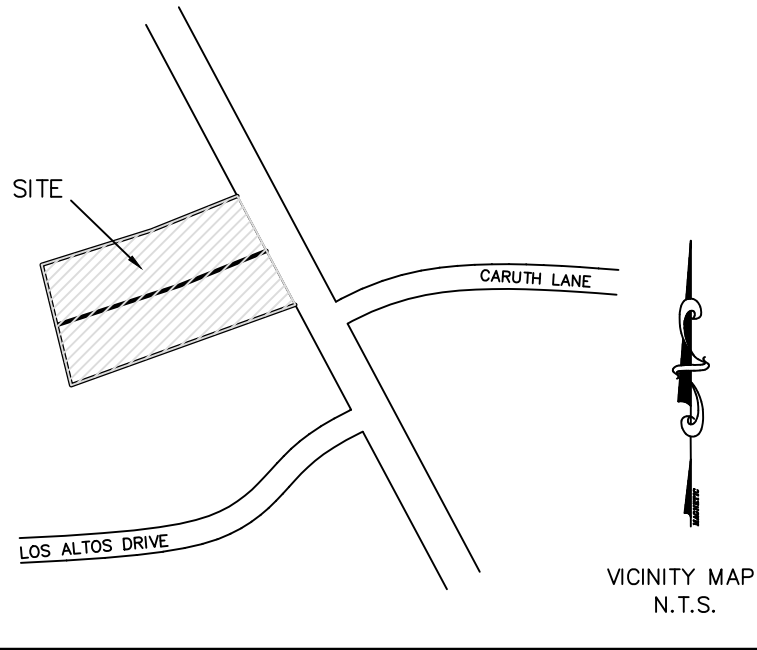

NOTE:
1) Bearings shown are base on NAD 83 Texas North Central Zone.

FLOODZONE CERIFICATE:
As determined by the FLOOD INSURANCE RATE MAPS for Rockwall County, no portion of the property shown hereon lies with a Special Flood Hazard Area (100 Year Flood), Map dated 09/26/2008 Community Panel No. 84397C0030L.

LEGEND:
IRFC = IRON ROD FOUND WITH CAP
CUT X = FOUND CUT X IN CONCRETE
P.R.R.C.T. = PLAT RECORDS OF ROCKWALL COUNTY, TEXAS
O.P.R.R.C.T. = OFFICIAL PUBLIC RECORDS OF ROCKWALL COUNTY, TEXAS
U.E. = UTILITY EASEMENT
R.O.W. = RIGHT-OF-WAY

LINE TABLE		
LINE	LENGTH	BEARING
L1	26.71	S09°18'21"W
L2	30.12	S06°29'09"E
L3	23.76	S22°23'08"E
L4	5.06	S86°37'37"E
L5	8.55	N84°49'36"E
L6	25.05	N04°44'18"W
L7	14.73	N04°15'50"W
L8	27.56	N07°53'41"W
L9	18.21	N08°48'03"W
L10	9.55	S84°02'19"W
L11	6.65	S21°47'47"W

CURVE TABLE				
CURVE	LENGTH	RADIUS	CHORD	CHORD
C1	40.51	80.00	N05°59'00"E	40.07
C2	38.18	80.00	N06°49'03"E	37.81
C3	49.63	104.00	S06°49'03"W	49.16
C4	29.21	56.00	S05°32'40"W	28.88



FINAL PLAT
BARRETT HEIGHTS
2 LOTS

BEING A REPLAT OF LOTS 1 AND 2. GREEN VALLEY SUBDIVISION
and PART OF THE JOHN HB JONES SURVEY, ABSTRACT No. 124
CITY OF ROCKWALL
ROCKWALL COUNTY, TEXAS

PREPARED BY:
JAMES M. ANDERSON
1195 LAKE GLEN CIRCLE
ROCKWALL, TEXAS 75087
214-548-2042
jma90266@gmail.com

Engineer:
Doughrte & Associates, Inc
2235 Ridge Road, Suite 200
Rockwall, Texas 75087
214-771-9004

OWNER:
HOWARD BARRETT
1203 GOLIAD
ROCKWALL, TX 75087
972-722-8292

CITY CASE No. _____

Date: 5-03-2023

SHEET 1 OF 2

OWNERS CERTIFICATE:

STATE OF TEXAS
COUNTY OF ROCKWALL

WHEREAS, HOWARD BARRETT, being the owner of Lots 1 and 2 of GREEN VALLEY SUBDIVISION as recorded in Cabinet A, Slide 78 of the Plat Records of Rockwall County, Texas and a part of the John HB JONES SURVEY, ABSTRACT No. 124, ROCKWALL COUNTY, TEXAS by deeds recorded in Instrument Numbers 20220000025462 and 20220000006570 of the Official Public Records of Rockwall County, Texas (O.P.R.R.C.T.) to HOMAR INVESTMENTS, LLC and being more particularly described as follows:

BEGINNING at a $\frac{1}{4}$ " iron rod found on the west right-of-way line of North Goliad Street (S.H. 205), said point being the southeast corner of Lot 1 of said GREEN VALLEY SUBDIVISION and the northeast corner of Lot 1, Block A of the LIZANDRO OEMENO ADDITION, an addition to the City of Rockwall as recorded in Cabinet J, Slide 377 of the Plat Records of Rockwall County, Texas (P.R.R.C.T.);

THENCE South 83°31'27" West along the south line of Lot 1 of said GREEN VALLEY SUBDIVISION and the north line of said LIZANDRO OEMENO ADDITION, a distance of 383.75' to a $\frac{3}{8}$ " iron rod found at the northwest corner of said OEMENO ADDITION, said point also being of the east line of Lot 15, Block C of the LAKEVIEW SUMMIT PHASE ONE ADDITION, an addition recorded in Cabinet D, Slide 135 P.R.R.C.T.;

THENCE North 00°27'07" West along the east line of said LAKEVIEW SUMMIT ADDITION, passing at 100.02' a 1" iron rod found for the northwest corner of the said HOMAR INVESTMENTS, LLC tract Instrument No. 20220000025462 and the southwest corner of said HOMAR INVESTMENTS, LLC tract Instrument No. 20220000006570, a total distance of 199.94' to a $\frac{3}{8}$ " iron rod found on the east line of Lot 12, Block C of said LAKEVIEW SUMMIT ADDITION and the southwest corner of a tract of land conveyed to the TRUSTEES OF EVELYN WAY SMITH IRREVOCABLE TRUST as recorded in Instrument No. 20220000010972, Official Public Records of Rockwall County, Texas;

THENCE North 85°53'09" East along the north line of said HOMAR INVESTMENTS, LLC tract and the south line of said EVELYN WAY SMITH tract, a distance of 185.37' to a $\frac{3}{4}$ " iron rod found for a corner, said point being the northwest corner of Lot 2 of the said GREEN VALLEY SUBDIVISION;

THENCE North 81°23'19" East a distance of 150.76' to a $\frac{1}{2}$ " iron rod found for the northeast corner of said Lot 2 and said point being on the west right-of-way line of said North Goliad Street (S.H. 205);

THENCE South 14°13'35" East along said west right-of-way line and passing at 100.00' to northeast corner of Lot 1 of said GREEN VALLEY SUBDIVISION a total distance of 198.62' to the POINT OF BEGINNING and containing 70,077.80 square feet or 1.608 acres of land.

OWNER'S CERTIFICATE:

NOW, THEREFORE, KNOW ALL MEN BY THESE PRESENTS:

- Howard Barrett, the undersigned owner of the land shown on this plat, and designated herein as BARRETT HEIGHTS Addition to the City of Rockwall, Texas, and whose name is subscribed hereto, hereby dedicate to the use of the public forever all streets, alleys, parks, water courses, drains, easements and public places thereon shown on the purpose and consideration therein expressed. I further certify that all other parties who have a mortgage or lien interest in the subject property have been notified and signed this plat. I understand and do hereby reserve the easement strips shown on this plat for the purposes stated and for the mutual use and accommodation of all utilities desiring to use or using same. I also understand the following:
- No buildings shall be constructed or placed upon, over, or across the utility easements as described herein.
 - Any public utility shall have the right to remove and keep removed all or part of any buildings, fences, trees, shrubs, or other growths or improvements which in any way endanger or interfere with construction, maintenance or efficiency of their respective system on any of these easement strips; and any public utility shall at all times have the right of ingress or egress to, from and upon said easement strips for purpose of construction, reconstruction, inspecting, patrolling, maintaining, and either adding to or removing all or part of their respective system without the necessity of, at any time, procuring the permission of anyone.
 - The City of Rockwall will not be responsible for any claims of any nature resulting from or occasioned by the establishment of grade of steers in the subdivision.
 - The developer and subdivision engineer shall bear total responsibility for storm drain improvements.
 - The developer shall be responsible for the necessary facilities to provide drainage patterns and drainage controls such that properties within the drainage area are not adversely affected by the storm drainage from the development.
 - No house dwelling unit, or other structure shall be constructed on any lot in this addition by the owner or any other person until the developer and/or owner has complied with all requirements o the Subdivision Regulations of the City of Rockwall regarding improvements with respect to the entire block on the street or streets on which the property abuts, including the actual installation of streets with the required base and paving, curb and gutter, water and sewer, drainage structures, storm structures, storm sewer, and alleys, all according to the specifications of the City of Rockwall; or Until an escrow deposit, sufficient to pay for the cost o such improvements, as determined by the city's engineer and/or city administrator, computed on a private commercial rate basis, has been made with the city secretary, accompanied by an agreement signed by the developer and/or owner, authorizing the city to make such improvements at prevailing private commercial rates, or have the same made by a contractor and pay for the same out of the escrow deposit, should the developer and/or owner fail or refuse to install the required improvements within the time stated in such a written agreement, but in no case shall the City be obligated to make such improvements itself. Such deposit may be used by the owner and/or developer s progress payments as the work progresses in making such improvements by making certified requisitions to the city secretary, supported by evidence of work done; or Until the developer and/or owner files a corporate surety bond with the city secretary in a sum equal to the cost of such improvements tor the designated area, guaranteeing the installation thereof within the time stated in the bond, which time shall be fixed by the city council of the City of Rockwall.
 - Property owners are responsible for maintenance, repair, and replacement of all retaining walls and drainage and detention systems in easements.

I further acknowledge that the dedications and/or exaction's made herein are proportional to the impact of the Subdivision upon the public services required in order that the development will comport with the present and future growth needs of the City; I, my successors and assigns hereby waive any claim, damage, or cause of action that I may have as a result of dedication of exactions made herein.

FOR: BARRETT HEIGHTS

By: _____

FOR: _____(LIEN HOLDER)

BY: _____NAME: _____

TITLE: _____

Engineer:
Doughrate & Associates, Inc
2235 Ridge Road, Suite 200
Rockwall, Texas 75087
214-771-9004

Surveyor:
Rudy Rangel
Rangel Land Surveying
1012 Timberline Drive
Heath, Texas 75032
214-325-8026
Rangelandsurvey@swb.com

OWNER:
HOWARD BARRETT
1203 GOLIAD
ROCKWALL , TX 75087
972-722-8292

APPROVAL CERTIFICATE

Planning & Zoning Commission, Chairman _____ Date _____

APPROVED:
I hereby certify that the above and foregoing plat of an addition to the City of Rockwall, Texas, was approved by the City Council of the City of Rockwall on the ____ day of _____,2023.

This approval shall be invalid unless the approved plat for such addition is recorded in the office of the County Clerk of Rockwall, County, Texas, within one hundred and eighty (180) days from said date of final approval.

WITNESS OUR HANDS, this ____ day of _____ 2023.

Mayor, City of Rockwall City Secretary City Engineer

SURVEYOR'S CERTIFICATE

NOW, THEREFORE KNOW ALL MEN BY THESE PRESENTS:

That I Rudy Rangel, do hereby certify that this plat was prepared from an actual and accurate survey of the land, and that the corner monuments shown thereon were properly placed under my personal supervision.

GIVEN UNDER MY HAND AND SEAL THIS ____ DAY _____,2023.

RUDY RANGEL
REGISTERED PROFESSIONAL LAND SURVEYOR
STATE OF TEXAS NO. 5664
TBPLS No. 10077100

NOTARY CERTIFICATE

STATE OF _____
COUNTY OF _____

Before me, the undersigned authority, a Notary Public in and for the said County and State on this day personally appeared_____, known to me to be the person whose name is subscribed to the foregoing instrument and acknowledged to me that he/she executed the same for the purposes and considerations therein expressed and in the capacity therein stated and as the act and deed therein stated.

Given under my han and seal of office, this _____ day of _____, 2023.

Notary Signature

FINAL PLAT
BARRETT HEIGHTS

2 LOTS

BEING A REPLAT OF LOTS 1 AND 2. GREEN VALLEY SUBDIVISION
and PART OF THE JOHN HB JONES SURVEY, ABSTRACT No. 124

CITY OF ROCKWALL
ROCKWALL COUNTY, TEXAS

CITY CASE No. _____

Date: 5-03-2023

DEMOLITION, REMOVAL, DISPOSAL AND EXCAVATION NOTES

1. All pavements to be removed and replaced shall be saw cut to full depth along neat squared lines shown in the plans.
2. Proposed concrete pavement shall be constructed with longitudinal butt construction joints at all connections to existing concrete pavement.
3. All public concrete pavement to be removed and replaced shall be full panel replacement, 1-inch thicker and on top of 6-inch thick compacted flexbase.
4. No excess excavated material shall be deposited in low areas or along natural drainage ways without written permission from the affected property owner and the City of Rockwall. No excess excavation shall be deposited in the City Limits without a permit from the City of Rockwall. If the CONTRACTOR places excess materials in these areas without written permission, the CONTRACTOR will be responsible for all damages resulting from such fill and shall remove the material at their own cost.

PAVING AND GRADING

1. All detention systems are to be installed and verified for design compliance along with the associated storm sewer and outflow structures, prior to the start of any paving operations (including building foundations). Erosion protection shall be placed at the pond outflow structures, silt fence along the perimeter of the pond along with any of the associated erosion BMPs noted on the erosion control plan, and the sides and bottom of the detention system shall have either sod or anchored seeded curlex installed prior to any concrete placement.
2. All paving roadway, driveways, fire lanes, drive-isles, parking, dumpster pads, etc. sections shall have a minimum thickness, strength, reinforcement, joint type, joint spacing and subgrade treatment shall at a minimum conform to the City standards of Design and Construction and table below.

Street/Pavement Type	Minimum Thickness (inches)	Streng th 28- Day (psi)	Minimum Cement (sacks / CY)		Steel Reinforcement	
			Machine placed	Hand Placed	Bar #	Spacing (O.C.E.W.)
Arterial	10”	3,600	6.0	6.5	#4 bars	18”
Collector	8”	3,600	6.0	6.5	#4 bars	18”
Residential	6”	3,600	6.0	6.5	#3 bars	24”
Alley	7”-5”-7”	3,600	6.0	6.5	#3 bars	24”
Fire Lane	6”	3,600	6.0	6.5	#3 bars	24”
Driveways	6”	3,600	6.0	6.5	#3 bars	24”
Barrier Free Ramps	6”	3,600	N/A	6.5	#3 bars	24”
Sidewalks	4”	3,000	N/A	5.5	#3 bars	24”
Parking Lot/Drive Aisles	5”	3,000	5.0	5.5	#3 bars	24”
Dumpster Pads	7”	3,600	6.0	6.5	#3 bars	24”

3. Reinforcing steel shall be tied (100%). Reinforcing steel shall be set on plastic chairs. Bar laps shall be minimum 30 diameters. Sawed transverse dummy joints shall be spaced every 15 feet or 1.25 time longitudinal butt joint spacing whichever is less. Sawing shall occur within 5 to 12 hours after the pour, including sealing. Otherwise, the section shall be removed and longitudinal butt joint constructed.
4. No sand shall be allowed under any paving.
5. All concrete mix design shall be submitted to the City for review and approval prior to placement.
6. Fly ash may be used in concrete pavement locations provided that the maximum cement reduction does not exceed 20% by weight per C.Y. of concrete. The fly ash replacement shall be 1.25 lbs. per 1.0 lb. cement reduction.
7. All curb and gutter shall be integral (monolithic) with the pavement.
8. All fill shall be compacted by sheep's foot roller to a minimum 95% standard proctor. Maximum loose lift for compaction shall be 8 inches. All lifts shall be tested for density by an independent laboratory. All laboratory compaction reports shall be submitted to the City Engineering Construction Inspector once results are received. All reports will be required prior to final acceptance.
9. All concrete compression tests and soil compaction/density tests are required to be submitted to the City's Engineering Inspector immediately upon results.
10. All proposed sidewalks shall include barrier free ramps at intersecting streets, alleys, etc. Barrier free ramps (truncated dome plate in Colonial or brick red color) shall meet current City and ADA requirements and be approved by the Texas Department of Licensing and Regulation (TDLR).
11. All public sidewalks shall be doweled into pavement where it abuts curbs and driveways. Expansion joint material shall be used at these locations.
12. All connection of proposed concrete pavement to existing concrete pavement shall include a longitudinal butt joint as the load transfer device. All longitudinal butt joints shall be clean, straight and smooth (not jagged in appearance)
13. Cracks formed in concrete pavement shall be repaired or removed by the CONTRACTOR at the City's discretion. CONTRACTOR shall replace existing concrete curbs, sidewalk, paving, a gutters as indicated on the plans and as necessary to connect to the existing infrastructure, including any damage caused by the CONTRACTOR.
14. All residential lots will require individual grading plans submitted during the building permit process that correspond with the engineered grading and drainage area plans.
15. Approval of this plan is not an authorization to grade adjacent properties when the plans or field conditions warrant off-site grading. Written permission must be obtained and signed from the affected property owner(s) and temporary construction easements may be required. The written permission shall be provided to the City as verification of approval by the adjacent property owner(s). Violation of this requirement will result in suspension of all work at the job site until issue has been rectified.
16. All cut or fill slopes of non-paved areas shall be a maximum of 4:1 and minimum of 1%.
17. CONTRACTOR agrees to repair any damage to property and the public right-of-way in accordance with the City Standards of Design and Construction.
18. CONTRACTOR shall protect all monuments, iron pins/rods, and property corners during construction.
19. CONTRACTOR shall ensure positive drainage so that runoff will drain by gravity flow to new or existing drainage inlets or sheet flow per these approved plans.

DRAINAGE / STORM SEWER NOTES

1. The CONTRACTOR shall maintain drainage at all times during construction. Ponding of water in streets, drives, trenches, etc. will not be allowed. Existing drainage ways shall not be blocked or removed unless explicitly stated in the plans or written approval is given by the City.
2. All structural concrete shall be 4200 psi compressive strength at 28 days minimum 7.0 sack mix, air entrained, unless noted otherwise. Fly ash shall not be allowed in any structural concrete.
3. Proposed storm sewer embedment shall be NCTCOG Class 'B' as amended by the City of Rockwall's Engineering Department Standards of Design and Construction Manual.
4. All public storm pipe shall be a minimum of 18-inch reinforced concrete pipe (RCP), Class III, unless otherwise noted.
5. All storm pipe entering structures shall be grouted to assure connection at the structure is watertight.
6. All storm structures shall have a smooth uniform poured mortar invert from invert in to invert out.
7. All storm sewer manholes in paved areas shall be flush with the paving grade, and shall have traffic bearing ring and covers.
8. All storm sewer pipes and laterals shall be inspected by photographic means (television and DVD) prior to final acceptance and after franchise utilities are installed. The CONTRACTOR shall furnish a DVD to the Engineering Construction Inspector for review. Pipes shall be cleaned prior to TV inspection of the pipes. Any sags, open joints, cracked pipes, etc. shall be repaired or removed by the CONTRACTOR at the CONTRACTOR's expense. A television survey will be performed as part of the final testing in the twentieth (20th) month of the maintenance period.

RETAINING WALLS

1. All retaining walls, regardless of height, will be reviewed and approved by the City Engineering Department
2. All retaining walls (including foundation stem walls), regardless of height, will be constructed of rock/stone/brick or rock/stone/brick faced. No smooth concrete walls are allowed. Wall materials shall be the same for all walls on the project.
3. All portions, including footings, tie-backs, and drainage backfill, of the wall shall be on-site and not encroach into any public easements or right-of-way. The entire wall shall be in one lot and shall not be installed along a lot line.
4. All walls 3 feet and taller will be designed and signed/sealed by a registered professional engineer in the State of Texas. The wall design engineer is required to inspect the wall construction and supply a signed/sealed letter of wall construction compliance to the City of Rockwall along with wall as-builts prior to City Engineering acceptance.
5. No walls are allowed in detention easements. A variance to allow retaining walls in a detention easement will require approval by the Planning and Zoning Commission with appeals being heard by the City Council.

FINAL ACCEPTANCE AND RECORD DRWINGS/AS-BUILTS

1. Final Acceptance shall occur when all the items on the Checklist for Final Acceptance have been completed and signed-off by the City. An example of the checklist for final acceptance has been included in the Appendix of the Standards of Design and Construction. Items on the checklist for final acceptance will vary per project and additional items not shown on the check list may be required.
2. After improvements have been constructed, the developer shall be responsible for providing to the City “As Built” or “Record Drawings”. The Design Engineer shall furnish all digital files of the project formatted in Auto Cad 14, or 2000 format or newer and Adobe Acrobat (.pdf) format with a CD-ROM disk or flash drive. The disk or drive shall include a full set of plans along with any landscaping, wall plans, and details sheets.
3. Submit 1-set of printed drawings of the “Record Drawings” containing copies of all sheets to the Engineering Construction Inspector for the project. The printed sheets will be reviewed by the inspector PRIOR to producing the “Record Drawing” digital files on disk or flash drive. This will allow any revisions to be addressed prior to producing the digital files.
4. Record Drawing Disk drawings shall have the Design Engineers seal, signature and must be stamped and dated as “Record Drawings” or “As Built Drawings” on all sheets.
5. The City of Rockwall will not accept any Record Drawing disk drawings which include a disclaimer. A disclaimer shall not directly or indirectly state or indicate that the design engineer or the design engineer's surveyor/surveyors did not verify grades after construction, or that the Record Drawings were based solely on information provided by the construction contractor/contractors. Any Record Drawings which include like or similar disclaimer verbiage will not be accepted by the City of Rockwall.
6. Example of Acceptable Disclaimer: “To the best of our knowledge ABC Engineering, Inc., hereby states that this plan is As-Built. This information provided is based on surveying at the site and information provided by the contractor.”



GENERAL CONSTRUCTION NOTES
Sheet 2 of 2
October 2020

CITY OF ROCKWALL
ENGINEERING DEPARTMENT

385 S. Goliad
Rockwall, Texas 75087

P (972) 771-7746
F (972) 771-7748

11
DRAINAGE ESM'T

GRAPHIC SCALE



(IN FEET)
1 inch = 20 ft.

EVELYN WAY SMITH, TRUSTEE OF
EVELYN WAY SMITH IRREVOCABLE TRUST

LOT 3
GREEN VALLEY SUBDIVISION
CAB. A, SLIDE 78
P.R.R.C.T.

10' CROSS ACCESS EASEMENT

EXISTING STRUCTURE TO REMAIN

64'X15' NO PARKING ZONE TO BE STRIPED AND SIGNED

PROJECT LOCATION

LOCATION MAP
NTS

EXISTING DRIVE TO BE REMOVED TO N GOLIAD ROADWAY
WITH NEW CURB INSTALLED, REMOVE CULVERT,
RELOCATE HEADWALL

NOTES:
DIMENSIONS ARE TO BACK
OF CURB OR EDGE OF PAVEMENT

STORMWATER DETENTION TO BE CONTAINED
WITHIN PROPOSED PARKING IN REAR BOTH
LOTS 1203 & 1205

ALL ACCESSORY STRUCTURES TO
BE REMOVED

EXISTING DRIVE TO BE REMOVED TO N GOLIAD
ROADWAY WITH NEW CURB INSTALLED,
REMOVE CULVERT,

CONNECT TO EX ACCESS DRIVE AND EXTEND
24' FIRE LANE THROUGH 1203 & 1205

EXISTING STRUCTURE TO REMAIN

REVISED TO CONFORM TO CONSTRUCTION RECORDS.
DATE: 6-15-24

OWNER
HOWARD BARRETT
1203 GOLIAD
ROCKWALL, TX 75087
972-722-8292

- NOTES:
1. PARKING SPACES ARE 9'X20'
 2. ALL GROUND MOUNTED HVAC TO BE SCREENED WITH 3-5 GAL TEXAS SAGE BUSHES
 3. SCREEN PARKING FRONTAGE WITH A MIXTURE OF 7 GAL TEXAS SAGE DESPARADO & 5 GAL WAX LEAF LIGUSTRUM BUSHES, 2 PER SPACE
 4. LANDSCAPE EACH BLDG FRONTAGE & SIDES WITH MIXTURE OF 16-5 GAL EASTERN RED CEDAR AND VITEX CASTUS PLANTS
 5. ALL MUTUAL ACCESS EASEMENTS TO BE PAVED PER CITY OF ROCKWALL STANDARDS OF DESIGN
 6. ALL SHRUBS SHALL BE A 5 GAL MINIMUM IN SIZE.
 7. 2 ACCENT TREES TO BE PLANTED WITHIN THE 20' LANDSCAPE BUFFER ON EACH LOT
 8. A TOTAL OF 2-SHAUNTING MAPLE & 2- YAUPON HOLLY
 9. A TOTAL OF 5- 4" CANOPY TREES SHALL BE PLANTED IN THE REAR OF THE LOTS.
 10. THE 5-4" CANOPY TREES WILL BE A MIXTURE OF LIVE OAK, TEXAS RED BUD, AND AUTUMN BLAZE RED MAPLE

SHRUBS



WAX LEAF PRIVET LIGUSTRUM
(PL)



TEXAS SAGE DESPARADO
(SD)

TREES



CANOPY: 4" LIVE OAK, TEXAS RED
BUD, OR AUTUMN BLAZE RED MAPLE




ACCENT: SHAUNTING MAPLE, OR
YAUPON HOLLY

SITE DATA SUMMARY:
NAME OF FINAL PLAT: GREEN VALLEY SUBD LOT 1
ZONING: NO (RESIDENTIAL OFFICE DISTRICT)
PROPOSED USE: BUSINESS OFFICE
EXIST BUILDING SQUARE FOOTAGE: 1203 GOLIAD-2361 SF, 1205 GOLIAD-2324 SF
PROPOSED BUILDING EXPANSION SQUARE FOOTAGE: NONE
TOTAL LOT AREA: 1203 GOLIAD 35,537 SF + 1205 GOLIAD 34,337 SF = 69,874 SF = 1.60 AC
BUILDING HEIGHT: 28 FT
LOT BLDG COVERAGE: 1203 GOLIAD 6.8% 1205 GOLIAD 6.8%
PARKING SPACES REQUIRED BOTH 1203 & 1205: 1 SPACE/300 SF = 8 EA
HANDICAP PARKING REQUIRED: 1 EA
TOTAL PARKING SPACES PROVIDED: 1203 GOLIAD 8 SPACES, 1205 GOLIAD 11 SPACES
HANDICAP PARKING PROVIDED: 1EA
INTERIOR LANDSCAPING REQUIRED: 20% 7,000 SF
TOTAL SQUARE FOOTAGE OF IMPERVIOUS SURFACE (BLDGS + PARKING/FIRE LANE) =13,818 SF


APPROVED:
I HEREBY CERTIFY THAT THE ABOVE AND FOREGOING SITE PLAN
FOR A DEVELOPMENT IN THE CITY OF ROCKWALL, TEXAS, HAS APPROVED
BY THE PLANNING & ZONING COMMISSION OF THE CITY OF ROCKWALL
ON THE _____ DAY OF _____
WITNESS OUR HANDS, THIS _____ DAY OF _____

PLANNING & ZONING COMMISSION, CHAIRMAN DIRECTOR OF PLANNING AND ZONING
CASE NO. SP2023-010

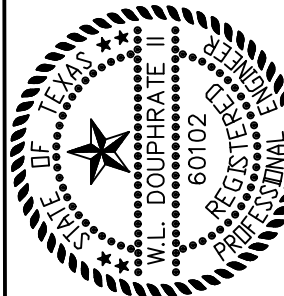

THE SEAL APPEARING ON THIS
DOCUMENT WAS AUTHORIZED BY
THE BOARD OF SURVEYORS
NO. 60102, F-686, ON
DATE: MARCH 10, 2023

DOUPHRE & ASSOCIATES, INC.

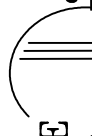

ENGINEERING PROJECT MANAGEMENT SURVEYING
2235 RIDGE RD., # 200 ROCKWALL, TEXAS 75087
PHONE: (972)771-9004 FAX: (972)771-9005

SITE & LANDSCAPING PLAN
BARRETT HEIGHTS
1203 & 1205 GOLIAD STREET ROCKWALL TEXAS
CITY OF ROCKWALL
ROCKWALL COUNTY, TEXAS

REVISION

W.L.D.

CHECKED

W.L.D.

DRAWN

SCALE
1"=20' H
1"= V

DATE MAR 10, 2023

23010 SITE PL

PROJECT

10




GRAPHIC SCALE



(IN FEET)
1 inch = 20 ft.

EVELYN WAY SMITH, TRUSTEE OF
EVELYN WAY SMITH IRREVOCABLE TRUST

LOT 3
GREEN VALLEY SUBDIVISION
CAB. A, SLIDE 78
P.R.R.C.T.

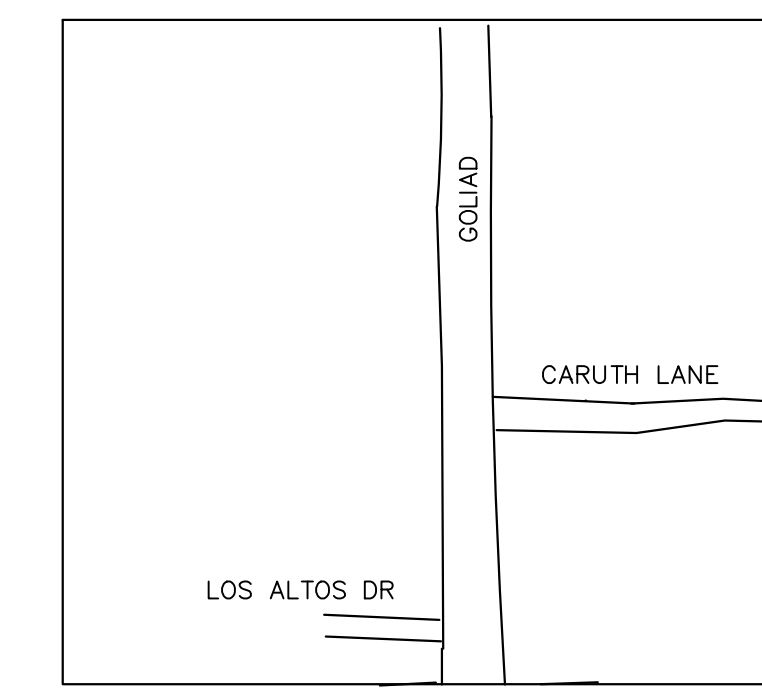

LOCATION MAP
NTS



- LANDSCAPING NOTES:
1. PARKING SPACES ARE 9'X20'
 2. ALL GROUND MOUNTED HVAC TO BE SCREENED WITH 3-5 GAL TEXAS SAGE BUSHES
 3. SCREEN PARKING FRONTAGE WITH A MIXTURE OF 3-7 GAL TEXAS SAGE DESPARADO & 3-5 GAL WAX LEAF LIGUSTRUM BUSHES
 4. LANDSCAPE EACH BLDG FRONTAGE & SIDES WITH 16-5 GAL TEXAS RED YUCCA PLANTS
 5. ALL MUTUAL ACCESS EASEMENTS TO BE PAVED PER CITY OF ROCKWALL STANDARDS OF DESIGN
 6. ALL SHRUBS SHALL BE A 5 GAL MINIMUM IN SIZE
 7. 2 ACCENT TREES TO BE PLANTED WITHIN THE 20' LANDSCAPE BUFFER ON EACH LOT
A. TOTAL OF 2-SHAUNTING MAPLE & 2- YAUPON HOLLY
 8. A TOTAL OF 3-4" CANOPY TREES SHALL BE PLANTED IN THE REAR OF THE LOTS.
THE 3-4" CANOPY TREES SHALL BE A MIXTURE OF LIVE OAK, TEXAS RED BUD, AUTUMN BLAZE RED MAPLE

- SHRUBS**
- WAX LEAF PRIVET LIGUSTRUM (PL)
 - TEXAS SAGE DESPARADO (SD)

- TREES**
-

TREE MITIGATION NOTES SUMMARY:
TOTAL EXIST SPECIMEN TREES TO BE PRESERVED:
1- 30\"/>

TOTAL SPECIMEN TREES TO BE REMOVED:
1- 24\"/>

TOTAL 20% MITIGATION TREE BALANCE:
TOTAL INCHES PRESERVED = 308"
TOTAL INCHES REMOVED = 40"
TOTAL PRESERVATION CREDITS = 40 X .2 = 8 PRESERVATION CREDITS
TOTAL NET INCHES TO MITIGATE = 40 - 8 = 32"
TOTAL SPECIMEN TREE INCHES PRESERVED EXCEED NET INCHES TO MITIGATE THEREFORE NO MITIGATION IS REQUIRED.

REVISED TO CONFORM TO CONSTRUCTION RECORDS.

DATE: 6-15-24

OWNER
HOWARD BARRETT
1203 GOLIAD
ROCKWALL, TX 75087
972-722-8292

THE SEAL APPEARING ON THIS DOCUMENT WAS AUTHORIZED BY W.L. DOUPHRATE II, TEXAS P.E. NO. 60102, EXPIRING DATE: MARCH 16, 2023

DOUPHRATE & ASSOCIATES, INC.

ENGINEERING PROJECT MANAGEMENT SURVEYING

2235 RIDGE RD., # 200 ROCKWALL, TEXAS 75087
PHONE: (972)771-9004 FAX: (972)771-9005

TREE PRESERVATION / MITIGATION PLAN

HOWARD BARRETT COMMERCIAL


1203 & 1205 GOLIAD STREET ROCKWALL TEXAS

CITY OF ROCKWALL

ROCKWALL COUNTY, TEXAS


REVISION

W.L.D.
CHECKED
W.L.D.
DRAWN
SCALE 1"=20' H 1"=20' V
DATE MAR 10, 2023
23010 TREE PROJECT
21

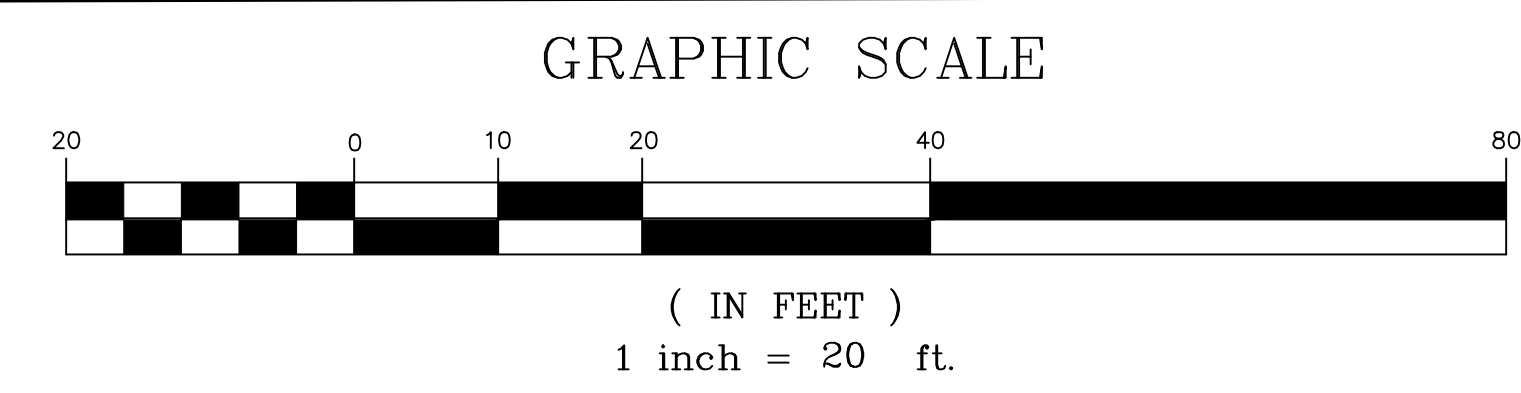

EVELYN WAY SMITH, TRUSTEE OF
EVELYN WAY SMITH IRREVOCABLE TRUST

LOT 3
GREEN VALLEY SUBDIVISION
CAB. A, SLIDE 78
P.R.R.C.T.

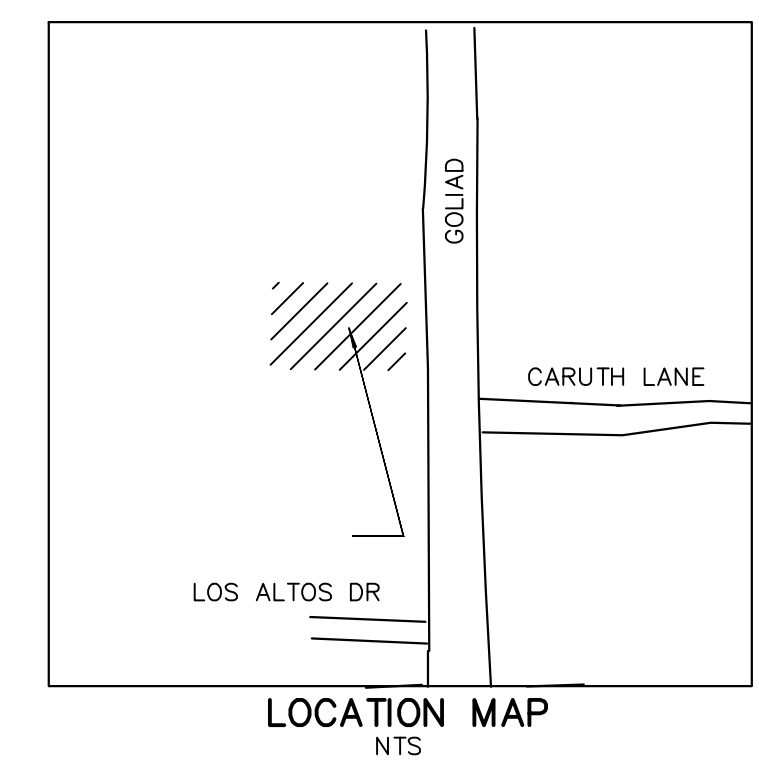

LOCATION MAP
NTS



THE SEAL APPEARING ON THIS
DOCUMENT WAS AUTHORIZED BY
THE BOARD OF ENGINEERING
EXAMINERS, STATE OF TEXAS
NO. 60102 F-666 DA
DATE: MARCH 10, 2023


DOUPHRA
& ASSOCIATES, INC.
ENGINEERING PROJECT MANAGEMENT SURVEYING
2235 RIDGE RD., # 200 ROCKWALL, TEXAS 75087
PHONE: (972)771-9004 FAX: (972)771-9005

DIMENSION CONTROL PLAN
HOWARD BARRETT COMMERCIAL
1203 & 1205 GOLIAD STREET ROCKWALL TEXAS
CITY OF ROCKWALL
ROCKWALL COUNTY, TEXAS



REVISION	W.L.D.
CHECKED	W.L.D.
DRAWN	
SCALE	1"=20' H 1"=20' V
DATE	MAR 10, 2023
PROJECT	23010 DM PL
	3

PROPOSED PAVING SPECIFICATIONS

7" PAVING 3600 PSI CONCR. NO. 4 BAR ON 18" CENTERS
SEE ROCKWALL GENERAL CONSTR NOTES SH. 2 OF 2
6" SUBGRADE SHALL BE MOISTURE CONTROLLED AND
COMPACTED TO 95% STANDARD MOISTURE DENSITY

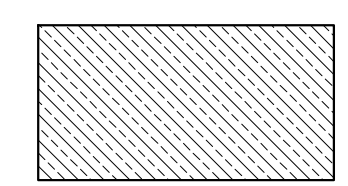

5" PAVING 3600 PSI CONCR. NO. 4 BAR ON 18" CENTERS
SEE ROCKWALL GENERAL CONSTR NOTES SH. 2 OF 2
6" SUBGRADE SHALL BE MOISTURE CONTROLLED AND
COMPACTED TO 95% STANDARD MOISTURE DENSITY

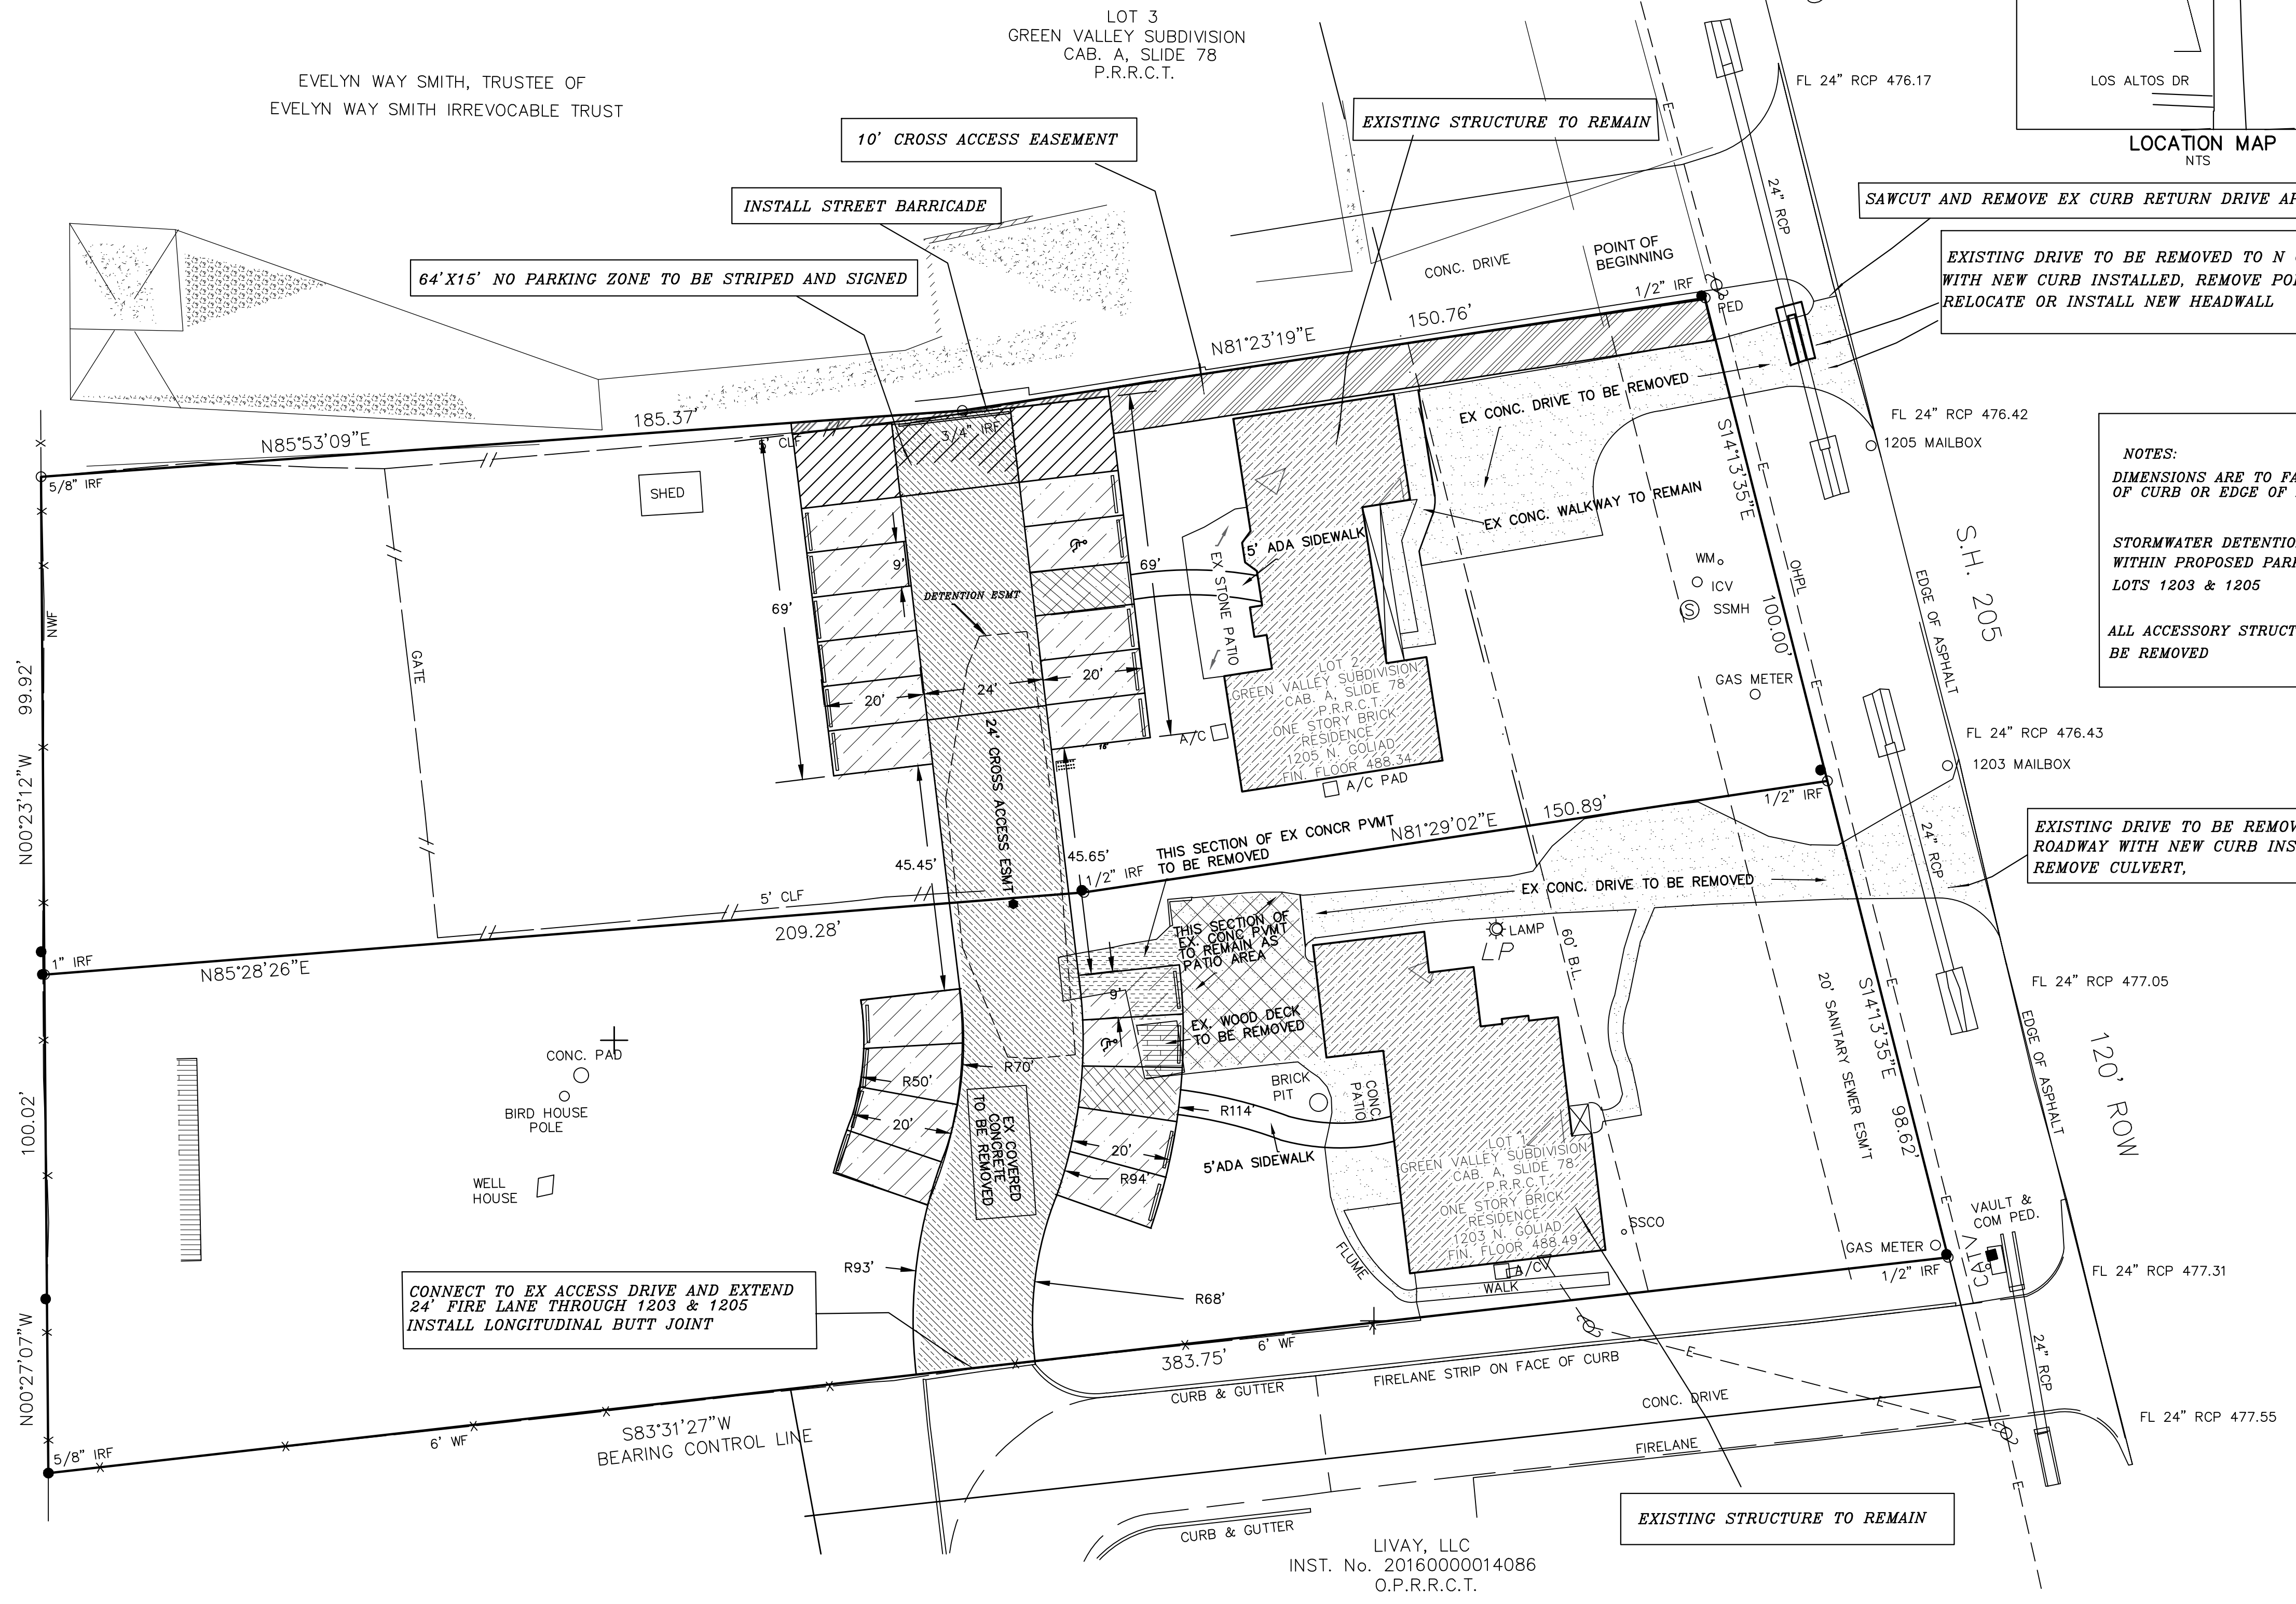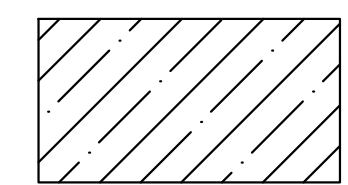

LIVAY, LLC
INST. No. 20160000014086
O.P.R.R.C.T.

REVISED TO CONFORM TO CONSTRUCTION RECORDS.

DATE: 6-15-24

OWNER
HOWARD BARRETT
1203 GOLIAD
ROCKWALL, TX 75087
972-722-8292

11
DRAINAGE ESM'T

12


LAKEVIEW SUMMIT, PHASE ONE
CABINET D, SLIDE 135
P.R.R.C.T.

13

BLOCK C
14

15

16

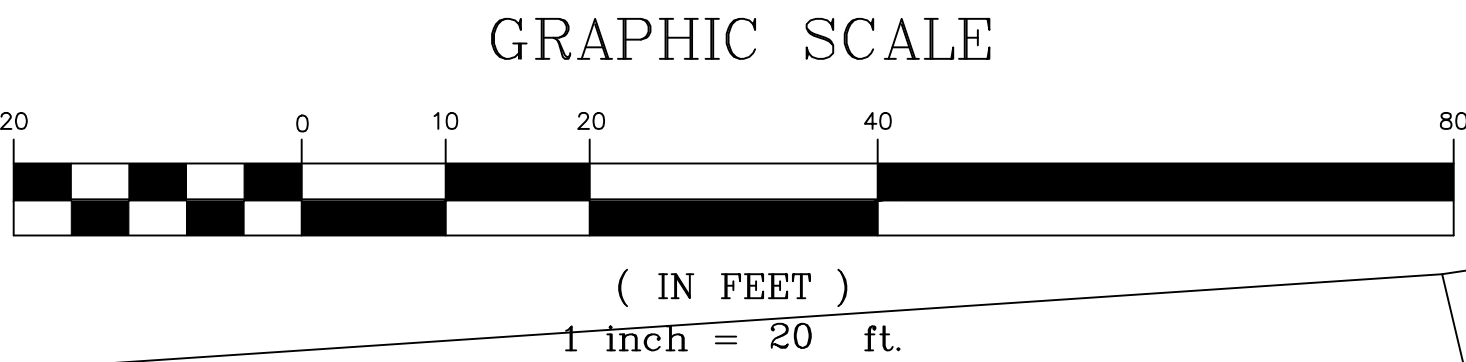

EVELYN WAY SMITH, TRUSTEE OF
EVELYN WAY SMITH IRREVOCABLE TRUST

LOT 3
GREEN VALLEY SUBDIVISION
CAB. A, SLIDE 78
P.R.R.C.T.



PRE-PAVING DRAINAGE TABLE						
DRAINAGE AREA NO.	ACRES	T.C. (MG)	C	I 100 YR.	Q 100 YR.	SUM Q 100 YR.
1	0.74	10	0.5	9.8	3.62	3.62
2	0.21	-	-	-	1.03	4.65
3	0.64	-	-	-	3.14	7.80


POST-PAVING DRAINAGE TABLE						
DRAINAGE AREA NO.	ACRES	T.C. (MG)	C	I 100 YR.	Q 100 YR.	SUM Q 100 YR.
1	0.74	10	0.5	9.8	3.62	3.62
2	0.21	-	0.9	-	1.85	5.47
3	0.64	-	0.5	-	3.14	8.61

LIVAY, LLC
INST. No. 20160000014086
O.P.R.R.C.T.

REVISED TO CONFORM TO CONSTRUCTION RECORDS.

DATE: 6-15-24

OWNER
HOWARD BARRETT
1203 GOLIA
ROCKWALL, TX 75087
972-722-8292

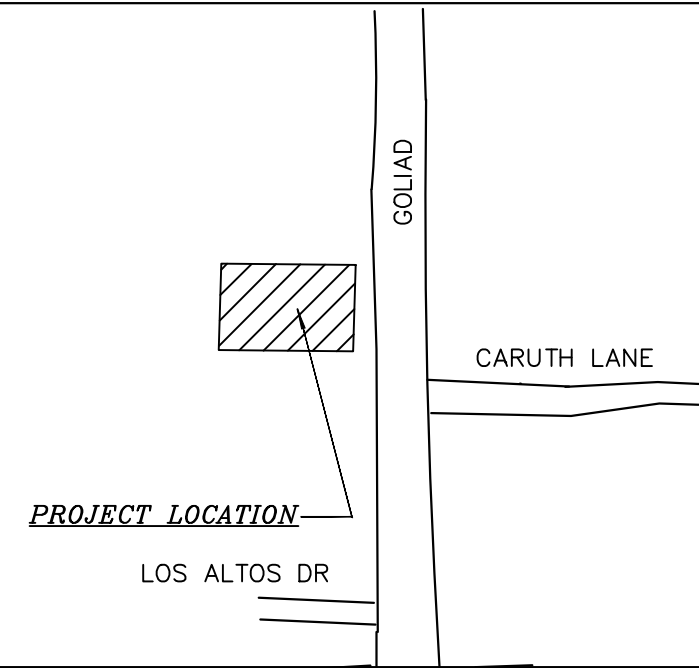

LOCATION MAP
NTS

THE SEAL APPEARING ON THIS DOCUMENT WAS AUTHORIZED BY THE BOARD OF ENGINEERS & SURVEYORS OF TEXAS P.E. NO. 60102 F-696 ON DATE: MARCH 10, 2023

DOUPHRAE & ASSOCIATES, INC.

ENGINEERING PROJECT MANAGEMENT SURVEYING

2235 RIDGE RD., # 200 ROCKWALL, TEXAS 75087

PHONE: (972)771-9004 FAX: (972)771-9005

DRAINAGE AREA MAP
BARRETT HEIGHTS
1203 & 1205 GOLIA STREET ROCKWALL TEXAS
CITY OF ROCKWALL
ROCKWALL COUNTY, TEXAS

REVISION

W.L.D.

CHECKED

W.L.D.

DRAWN

SCALE
1"=20' H
1"=20' V

DATE MAR 10, 2023

23010 SITE PL

PROJECT

40

DETENTION 1 - 5 YEAR STORM

Present Conditions				
Q=CIA				
A =	0.21			
C =	0.5			
Tc =	10			
I5 =	6.1			
Q5 =	0.6405			

Future Conditions (Developed)		Offsite Conditions (Undeveloped)		Bypass
A =	0.21	A =	0.74	A= 0
Aadj=	0.21			
C =	0.9	C =	0.5	C= 0.9
Tc =	10	Tc =	10	Tc= 10
I5 =	6.1	I5 =	6.1	I5= 6.1
Q5 =	1.1529	Q5 =	2.257	Q5 = 0

Flow for Storm Durations (Developed)					Flow for Storm Durations (Offsite)				
Time	L	C	Q		Time	L	C	Q	
10 min	6.1	0.9	1.1529		10 min	6.1	0.5	2.257	
15 min	5.5	0.9	1.0395		15 min	5.5	0.5	2.035	
20 min	4.9	0.9	0.9261		20 min	4.9	0.5	1.813	
30 min	4.1	0.9	0.7749		30 min	4.1	0.5	1.517	
40 min	3.4	0.9	0.6426		40 min	3.4	0.5	1.258	
50 min	2.8	0.9	0.5292		50 min	2.8	0.5	1.036	
60 min	2.6	0.9	0.4914		60 min	2.6	0.5	0.962	
70 min	2.4	0.9	0.4536		70 min	2.4	0.5	0.888	
80 min	2.3	0.9	0.4347		80 min	2.3	0.5	0.851	
90 min	2.1	0.9	0.3969		90 min	2.1	0.5	0.777	
100 min	1.9	0.9	0.3591		100 min	1.9	0.5	0.703	
110 min	1.8	0.9	0.3402		110 min	1.8	0.5	0.666	

Storage Calculations				
10 min				
Inflow	2045.94	Storage	307.44	
Outflow	1738.5			
15 min				
Inflow	2767.05	Storage	593.925	
Outflow	2173.125			
20 min				
Inflow	3286.92	Storage	679.17	
Outflow	2607.75			
30 min				
Inflow	4125.42	Storage	648.42	
Outflow	3477			
40 min				
Inflow	4561.44	Storage	215.19	
Outflow	4346.25			
50 min				
Inflow	4695.6	Storage	-519.9	
Outflow	5215.5			
60 min				
Inflow	5232.24	Storage	-852.51	
Outflow	6084.75			
70 min				
Inflow	5634.72	Storage	-1319.28	
Outflow	6954			
80 min				
Inflow	6171.36	Storage	-1651.89	
Outflow	7823.25			
90 min				
Inflow	6339.06	Storage	-2353.44	
Outflow	8692.5			
100 min				
Inflow	6372.6	Storage	-3189.15	
Outflow	9561.75			
110 min				
Inflow	6037.2	Storage	-4393.8	
Outflow	10431			

DETENTION 1 - 10 YEAR STORM

Present Conditions				
Q=CIA				
A =	0.21			
C =	0.5			
Tc =	10			
I10 =	7.2			
Q10 =	0.756			

Future Conditions (Developed)		Offsite Conditions (Undeveloped)		Bypass
A =	0.21	A =	0.74	A=
Aadj=	0.21			
C =	0.9	C =	0.5	C= 0.9
Tc =	10	Tc =	10	Tc= 10
I10 =	7.2	I10 =	7.2	I10= 7.1
Q10 =	1.3608	Q10 =	2.664	Q10 = 0

Flow for Storm Durations (Developed)					Flow for Storm Durations (Offsite)				
Time	L	C	Q		Time	L	C	Q	
10 min	7.1	0.9	1.3419		10 min	7.1	0.5	2.627	
15 min	6.5	0.9	1.2285		15 min	6.5	0.5	2.405	
20 min	5.9	0.9	1.1151		20 min	5.9	0.5	2.183	
30 min	4.8	0.9	0.9072		30 min	4.8	0.5	1.776	
40 min	4	0.9	0.756		40 min	4	0.5	1.48	
50 min	3.5	0.9	0.6615		50 min	3.5	0.5	1.295	
60 min	3	0.9	0.567		60 min	3	0.5	1.11	
70 min	2.8	0.9	0.5292		70 min	2.8	0.5	1.036	
80 min	2.6	0.9	0.4914		80 min	2.6	0.5	0.962	
90 min	2.5	0.9	0.4725		90 min	2.5	0.5	0.925	
100 min	2.4	0.9	0.4536		100 min	2.4	0.5	0.888	
110 min	2.3	0.9	0.4347		110 min	2.3	0.5	0.851	

Storage Calculations				
10 min				
Inflow	2381.34	Storage	329.34	
Outflow	2052			
15 min				
Inflow	3270.15	Storage	705.15	
Outflow	2565			
20 min				
Inflow	3957.72	Storage	879.72	
Outflow	3078			
30 min				
Inflow	4829.76	Storage	725.76	
Outflow	4104			
40 min				
Inflow	5366.4	Storage	236.4	
Outflow	5130			
50 min				
Inflow	5869.5	Storage	-286.5	
Outflow	6156			
60 min				
Inflow	6037.2	Storage	-1144.8	
Outflow	7182			
70 min				
Inflow	6573.84	Storage	-1634.16	
Outflow	8208			
80 min				
Inflow	6976.32	Storage	-2257.68	
Outflow	9234			
90 min				
Inflow	7546.5	Storage	-2713.5	
Outflow	10260			
100 min				
Inflow	8049.6	Storage	-3236.4	
Outflow	11286			
110 min				
Inflow	7714.2	Storage	-4597.8	
Outflow	12312			

DETENTION 1 - 25 YEAR STORM

Present Conditions				
Q=CIA				
A =	0.21			
C =	0.5			
Tc =	10			
I25 =	8.2			
Q25 =	0.881			

Future Conditions (Developed)		Offsite Conditions (Undeveloped)		Bypass
A =	0.21	A =	0.74	A= 0
Aadj=	0.21			
C =	0.9	C =	0.5	C= 0.9
Tc =	10	Tc =	10	Tc= 10
I25 =	8.2	I25 =	8.2	I25= 8.3
Q25 =	1.5498	Q25 =	3.034	Q25 = 0

Flow for Storm Durations (Developed)					Flow for Storm Durations (Offsite)				
Time	L	C	Q		Time	L	C	Q	
10 min	8.3	0.9	1.5687		10 min	8.3	0.5	3.071	
15 min	7.5	0.9	1.4175		15 min	7.5	0.5	2.775	
20 min	6.6	0.9	1.2474		20 min	6.6	0.5	2.442	
30 min	5.5	0.9	1.0395		30 min	5.5	0.5	2.035	
40 min	4.6	0.9	0.8694		40 min	4.6	0.5	1.702	
50 min	4	0.9	0.756		50 min	4	0.5	1.48	
60 min	3.5	0.9	0.6615		60 min	3.5	0.5	1.295	
70 min	3.3	0.9	0.6237		70 min	3.3	0.5	1.221	
80 min	3.1	0.9	0.5859		80 min	3.1	0.5	1.147	
90 min	2.9	0.9	0.5481		90 min	2.9	0.5	1.073	
100 min	2.7	0.9	0.5103		100 min	2.7	0.5	0.999	
110 min	2.5	0.9	0.4725		110 min	2.5	0.5	0.925	

Storage Calculations				
10 min				
Inflow	2783.82	Storage	446.82	
Outflow	2337			
15 min				
Inflow	3773.25	Storage	852	
Outflow	2921.25			
20 min				
Inflow	4427.28	Storage	921.78	
Outflow	3505.5			
30 min				
Inflow	5534.1	Storage	860.1	
Outflow	4674			
40 min				
Inflow	6171.36	Storage	328.86	
Outflow	5842.5			
50 min				
Inflow	6708	Storage	-303	
Outflow	7011			
60 min				
Inflow	7043.4	Storage	-1136.1	
Outflow	8179.5			
70 min				
Inflow	7747.74	Storage	-1600.26	
Outflow	9348			
80 min				
Inflow	8317.92	Storage	-2198.58	
Outflow	10516.5			
90 min				
Inflow	8753.94	Storage	-2931.06	
Outflow	11685			
100 min				
Inflow	9055.8	Storage	-3797.7	
Outflow	12853.5			
110 min				
Inflow	8385	Storage	-5637	
Outflow	14022			

DETENTION 1 - 100 YEAR STORM

Present Conditions				
Q=CIA				
A =	0.21			
C =	0.5			
Tc =	10			
I100 =	9.8			
Q100 =	1.029			

Future Conditions (Developed)		Offsite Conditions (Undeveloped)		Bypass
A =	0.21	A =	0.74	A= 0
Aadj=	0.21			
C =	0.9	C =	0.5	C= 0.9
Tc =	10	Tc =	10	Tc= 10
I100 =	9.8	I100 =	9.8	I100= 9.8
Q100 =	1.8522	Q100 =	3.626	Q100 = 0

Flow for Storm Durations (Developed)					Flow for Storm Durations (Offsite)				
Time	L	C	Q		Time	L	C	Q	
10 min	9.8	0.9	1.8522		10 min	9.8	0.5	3.626	
15 min	9	0.9	1.701		15 min	9	0.5	3.33	
20 min	8.3	0.9	1.5687		20 min	8.3	0.5	3.071	
30 min	6.9	0.9	1.3041		30 min	6.9	0.5	2.553	
40 min	5.8	0.9	1.0962		40 min	5.8	0.5	2.146	
50 min	5	0.9	0.945		50 min	5	0.5	1.85	
60 min	4.5	0.9	0.8505		60 min	4.5	0.5	1.665	
70 min	4	0.9	0.756		70 min	4	0.5	1.48	
80 min	3.7	0.9	0.6993		80 min	3.7	0.5	1.369	
90 min	3.5	0.9	0.6615		90 min	3.5	0.5	1.295	
100 min	3.3	0.9	0.6237		100 min	3.3	0.5	1.221	
110 min	2.9	0.9	0.5481		110 min	2.9	0.5	1.073	


Storage Calculations				
10 min				
Inflow	3286.92	Storage	493.92	
Outflow	2793			
15 min				
Inflow	4527.9	Storage	1036.65	
Outflow	3491.25			
20 min				
Inflow	5567.64	Storage	1378.14	
Outflow	4189.5			
30 min				
Inflow	6942.78	Storage	1356.78	
Outflow	5586			
40 min				
Inflow	7781.28	Storage	798.78	
Outflow	6982.5			
50 min				
Inflow	8385	Storage	6	
Outflow	8379			
60 min				
Inflow	9055.8	Storage	-719.7	
Outflow	9775.5			
70 min				
Inflow	9391.2	Storage	-1780.8	
Outflow	11172			
80 min				
Inflow	9927.84	Storage	-2640.66	
Outflow	12568.5			
90 min				
Inflow	10565.1	Storage	-3399.9	
Outflow	13965			
100 min				
Inflow	11068.2	Storage	-4293.3	
Outflow	15361.5			
110 min				
Inflow	9726.6	Storage	-7031.4	
Outflow	16758			

WEIR CALCULATIONS


Rectangular Suppressed Weir

$Q = 3.33 \ h1^{3/2} \ L$
 $Q = \text{Exist. Conditions Flowrate Allowed} = \text{ cfs}$
 $h1 = \text{Height of Weir} = 6 \text{ in.} = 0.5 \text{ ft.}$
 $L = \text{Length of Weir}$
 $4.6 = 3.33 \ (.5)^{1.5} \ L$
 $L = 3.9 \text{ ft} = 47 \text{ in.}$

STORAGE VOLUME STAGE					
STORM	d	ELEVATION	VOLUME	Qallowable	Qactual
5 YR	0.2	489.00 ft	679 cf	2.90 cfs	2.9 cfs
10 YR	0.30	489.10 ft	880 cf	3.4 cfs	3.4 cfs
25 YR	0.40	489.20 ft	922 cf	3.9 cfs	3.9 cfs
100 YR	0.50	489.3 ft	1378 cf	4.6 cfs	4.6 cfs

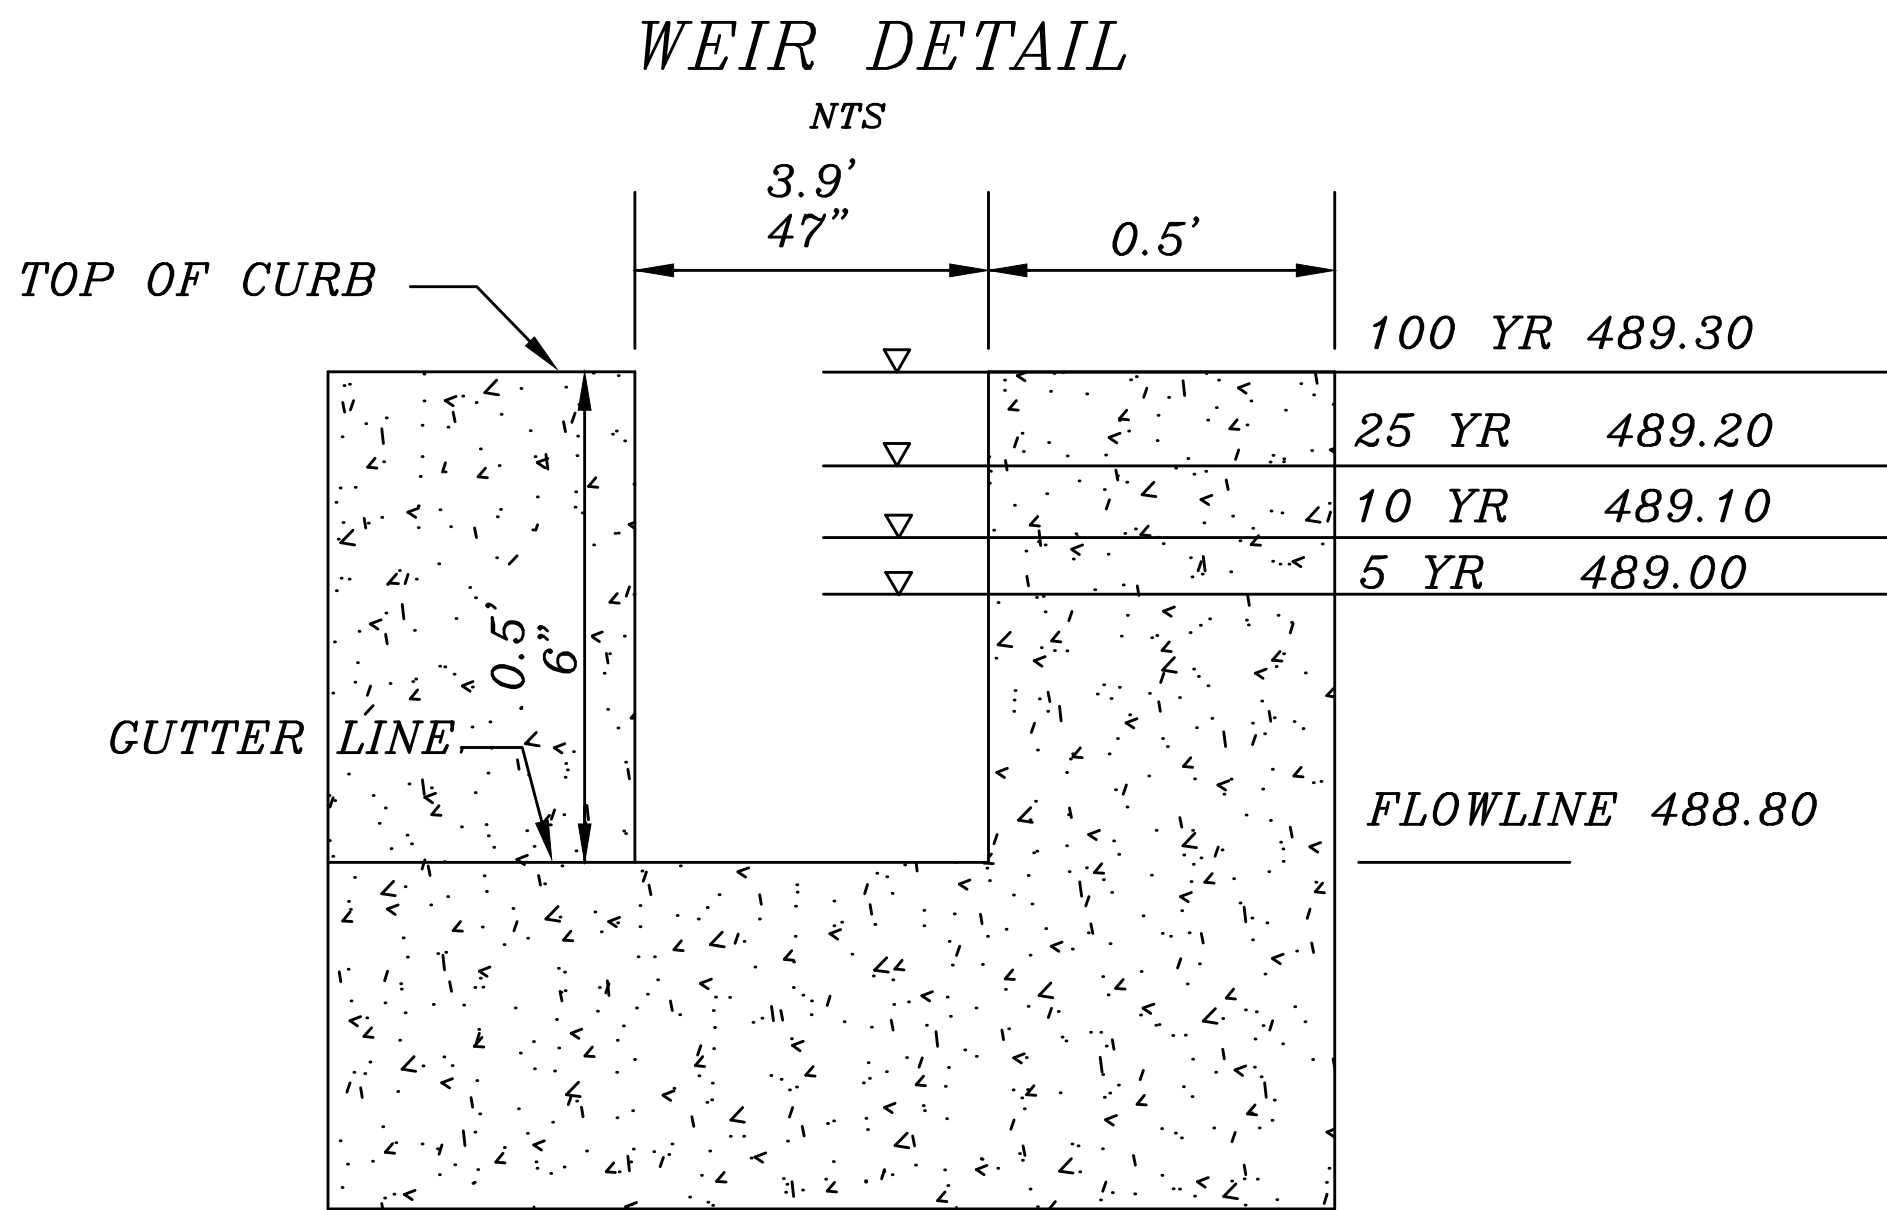

DETENTION REQUIRED - 1378 cf
DETENTION PROVIDED - 1378 cf

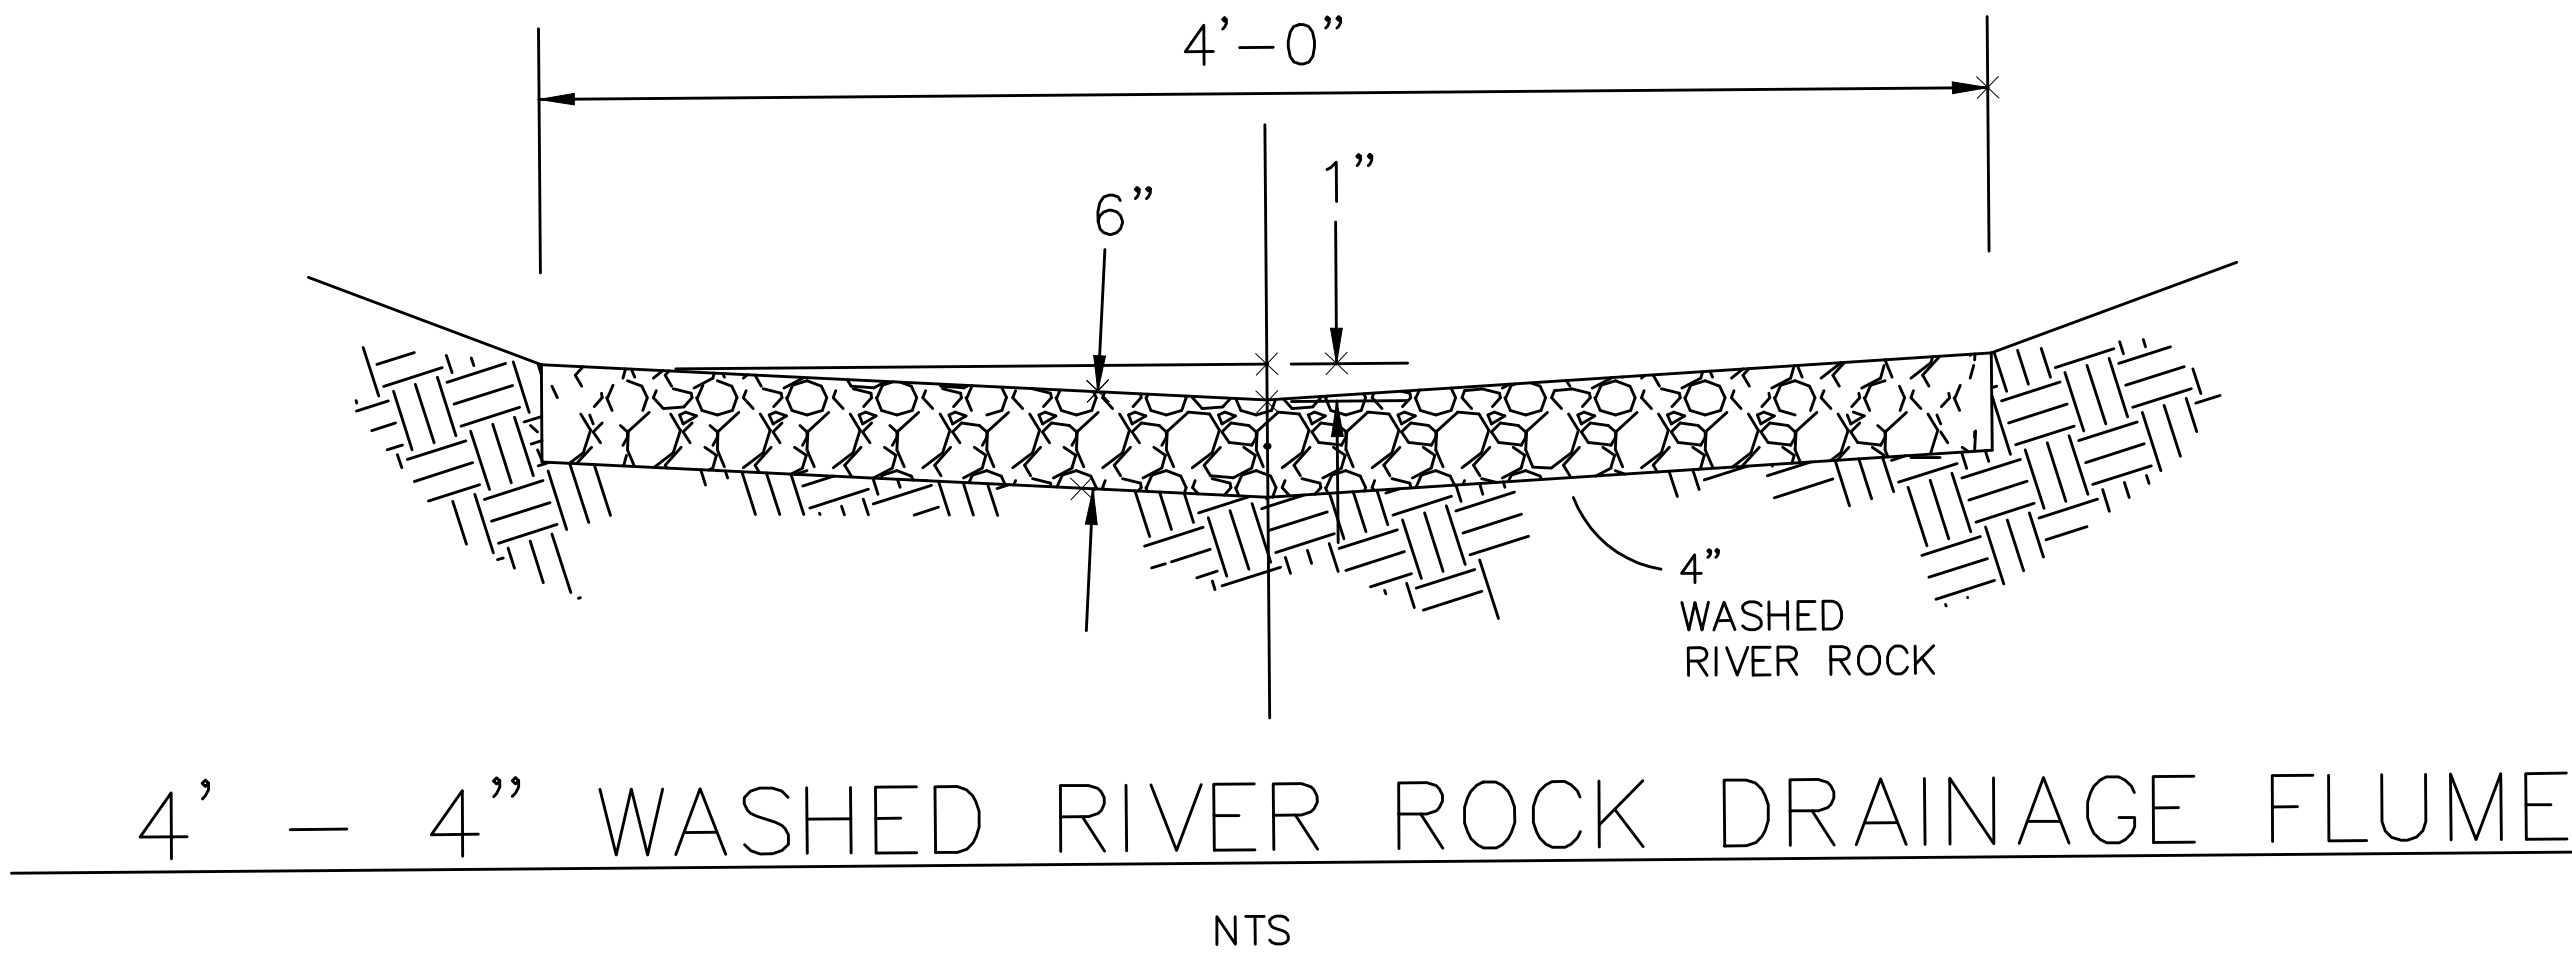

REVISED TO CONFORM TO CONSTRUCTION RECORDS.
DATE: 6-15-24



DOUPHRATE & ASSOCIATES, INC.
ENGINEERING • PROJECT MANAGEMENT • SURVEYING
2235 RIDGE RD., # 200 ROCKWALL, TEXAS 75087
PHONE: (972)771-9004 FAX: (972)771-9005

DETENTION WEIR & DRAINAGE FLUME
BARRETT HEIGHTS
1203 & 1205 N GOLIAD ST
CITY ROCKWALL
ROCKWALL COUNTY, TEXAS

REVISION
W.L.D.
CHECKED
GCW.
DRAWN
SCALE 1" = 50'H
APRIL, 2023 DATE
23010 PROJECT
6



THE SEAL APPEARING ON THIS
DOCUMENT WAS AUTHORIZED BY
W.L. DOUGHPATE II TEXAS P.E.
NO. 60102, F-886, ON
DATE: MARCH 10, 2023

GRADING PLAN
BARRETT HEIGHTS
GOLIAD STREET ROCKWALL TEXAS
CITY OF ROCKWALL
ROCKWALL COUNTY, TEXAS

REVISION	W.L.D.
CHECKED	W.L.D.
DRAWN	
SCALE	
1" = 20' H	
1" = V	
DATE	MAR 10, 2023
PROJECT	23010 GRADING PL.
	7.0



EXISTING DRIVE TO BE REMOVED TO N GOLIAD ROADWAY
WITH NEW CURB INSTALLED, REMOVE CULVERT,
RELOCATE OR INSTALL NEW 24" HEADWALL FL=476.25'

NOTES:
***DIMENSIONS ARE TO BACK
OF CURB OR EDGE OF PAVEMENT***

***STORMWATER DETENTION TO BE CONTAINED
WITHIN PROPOSED PARKING IN REAR BOTH
LOTS 1203 & 1205***

***ALL ACCESSORY STRUCTURES TO
BE REMOVED***

EXISTING SLOPE OF BAR DITCH FL TO BE
PRESERVED AT 0.63%, REGRADE BAR DITCH
W/ MIN OF 4:1 SIDE SLOPE

EXISTING DRIVE TO BE REMOVED TO N GOLIAD
ROADWAY WITH NEW CURB INSTALLED,
REMOVE CULVERT,

REVISED TO CONFORM TO CONSTRUCTION RECORDS.

W. W. [Signature] DATE: 6-15-24

OWNER
HOWARD BARRETT
1203 GOLIAD
ROCKWALL , TX 75087
972-722-8292




GRAPHIC SCALE



(IN FEET)
1 inch = 20 ft.

EVELYN WAY SMITH, TRUSTEE OF
EVELYN WAY SMITH IRREVOCABLE TRUST

LOT 3
GREEN VALLEY SUBDIVISION
CAB. A, SLIDE 78
P.R.R.C.T.

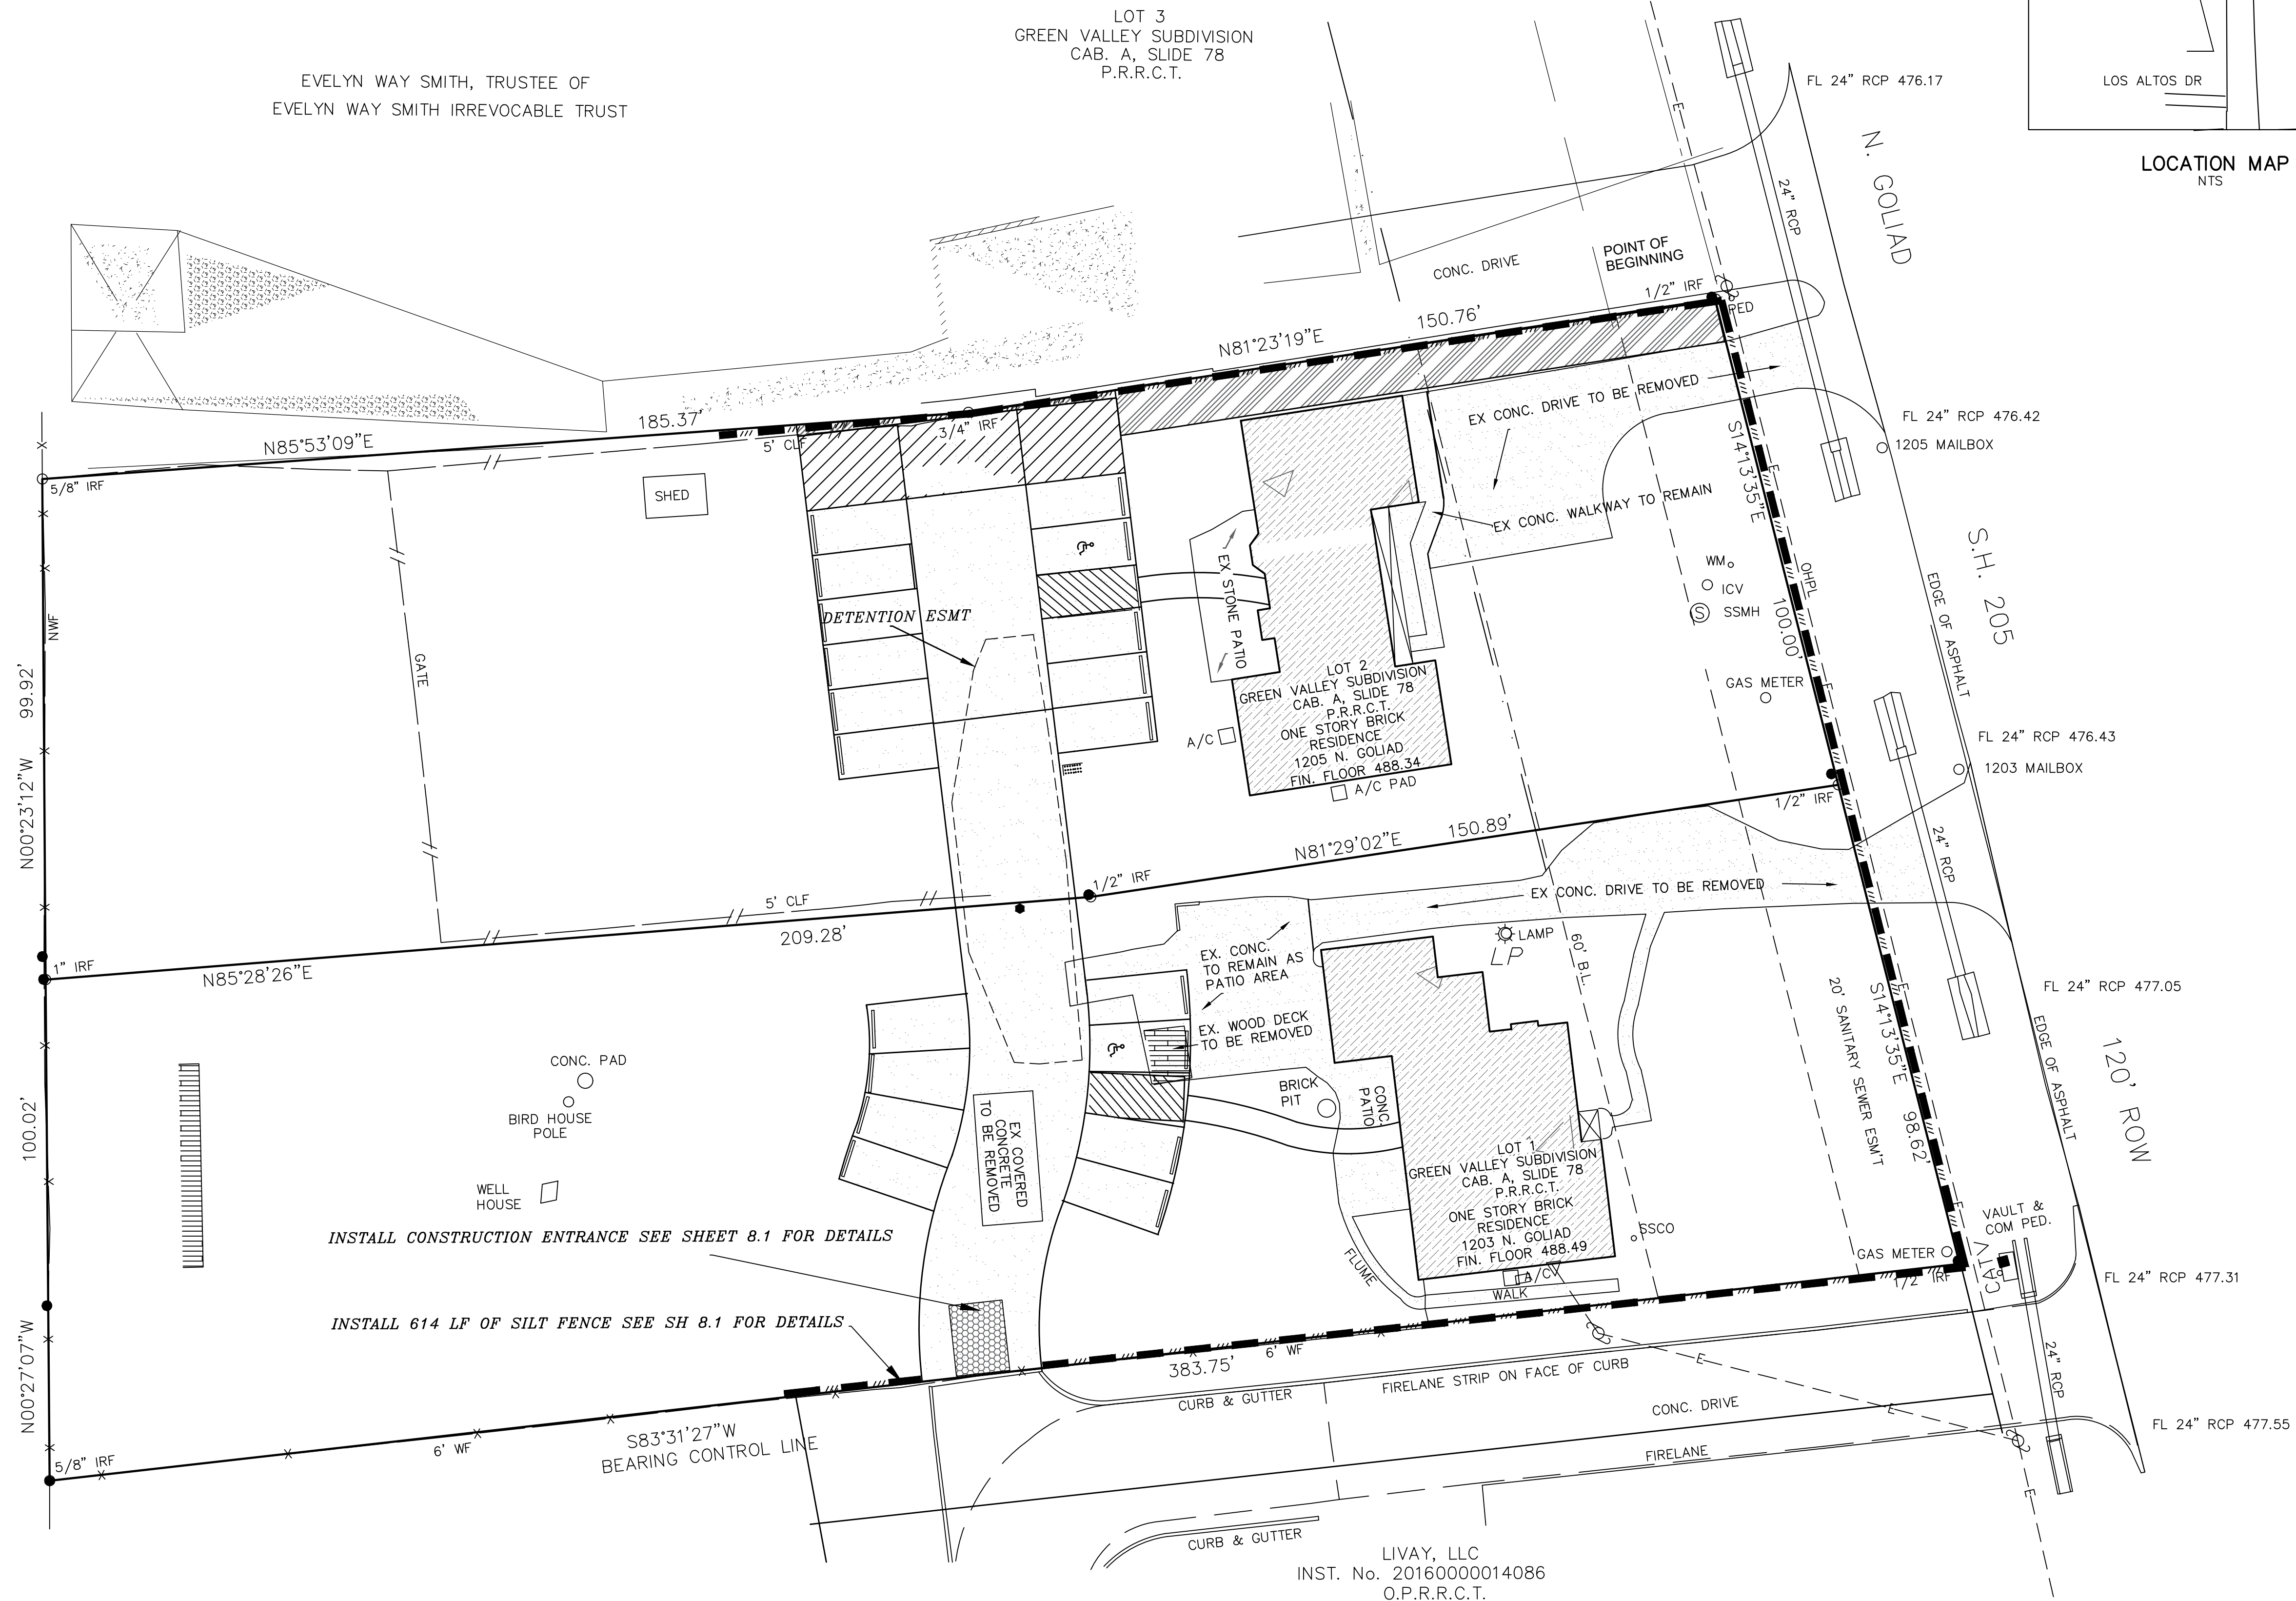

LOCATION MAP
NTS



THE SEAL APPEARING ON THIS
DOCUMENT WAS AUTHORIZED BY
W.L. DOUPHRATE II TEXAS P.E.
NO. 60102 F-886, ON
DATE: MARCH 10, 2023

DOUPHRATE
& ASSOCIATES, INC.
ENGINEERING PROJECT MANAGEMENT SURVEYING
2235 RIDGE RD., # 200 ROCKWALL, TEXAS 75087
PHONE: (972)771-9004 FAX: (972)771-9005

EROSION CONTROL PLAN
BARRETT HEIGHTS
1203 & 1205 GOLIAD STREET ROCKWALL TEXAS
CITY OF ROCKWALL
ROCKWALL COUNTY, TEXAS


REVISION	W.L.D.
CHECKED	W.L.D.
DRAWN	
SCALE	1"=20' H 1"=20' V
DATE	MAR 10, 2023
PROJECT	23010 ERO CONTROL

REVISED TO CONFORM TO CONSTRUCTION RECORDS.

W. Douphrate II DATE: 6-15-24

OWNER
HOWARD BARRETT
1203 GOLIAD
ROCKWALL, TX 75087
972-722-8292

LIVAY, LLC
INST. No. 20160000014086
O.P.R.R.C.T.

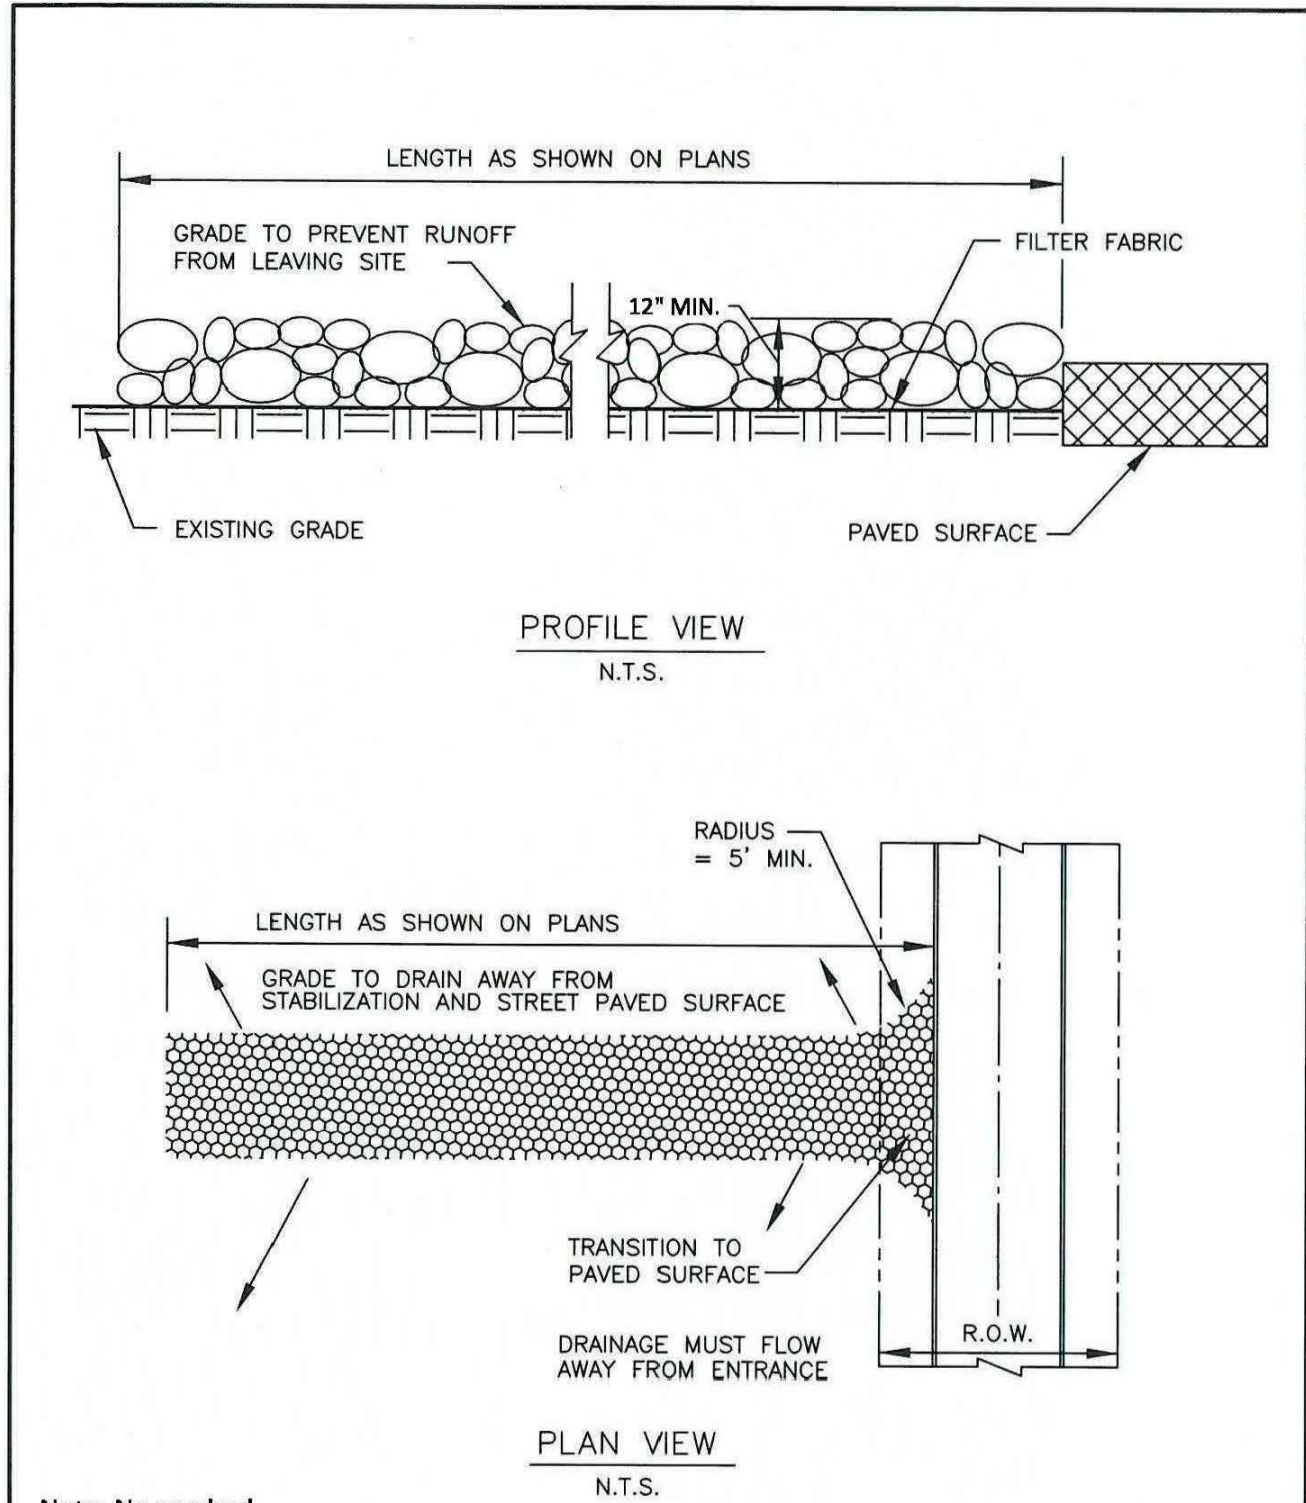

STABILIZED CONSTRUCTION ENTRANCE	CITY OF ROCKWALL	STANDARD SPECIFICATION REFERENCE 202.11 *
		DATE: Mar. 2018 STANDARD DRAWING NO.: R-1070A

*Section II Standard Drawings as of October 2004. Reference number only has been updated for Fifth Edition Specifications. Public Works Construction Standards North Central Texas, Fifth Edition.

STANDARDS FOR SILT FENCE DEFINITION

TEMPORARY BARRIER FENCE MADE OF BURLAP OR POLYPROPYLENE MATERIAL WHICH IS WATER PERMEABLE BUT WILL TRAP WATER — BORNE SEDIMENT.

PURPOSE

TO INTERCEPT AND DETAIN WATER — BORNE SEDIMENT FROM UNPROTECTED AREAS OF LIMITED EXTENT.

CONDITIONS WHERE PRACTICE APPLIES

SILT FENCE IS USED DURING THE PERIOD OF CONSTRUCTION NEAR THE PERIMETER OF A DISTURBED AREA TO INTERCEPT SEDIMENT WHILE ALLOWING WATER TO PERCOLATE THROUGH. THIS FENCE SHALL REMAIN IN PLACE UNTIL THE DISTURBED AREA IS PERMANENTLY STABILIZED. SILT FENCE SHOULD NOT BE USED WHERE THERE IS A CONCENTRATION OF WATER IN A CHANNEL OR OTHER DRAINAGE WAY.

DESIGN CRITERIA

SILT FENCE IS CONSTRUCTED NEAR THE PERIMETER OF A DISTURBED SITE WITHIN THE DEVELOPING AREA. IT IS NOT TO BE CONSTRUCTED OUTSIDE THE PROPERTY LINES WITHOUT OBTAINING A LETTER OF PERMISSION FROM THE AFFECTED ADJACENT PROPERTY OWNERS.

A DESIGN IS NOT REQUIRED FOR THE INSTALLATION OF THE SILT FENCE. HOWEVER, THE FOLLOWING CRITERIA SHALL BE OBSERVED:

- DRAINAGE AREA — LESS THAN TWO ACRES
- HEIGHT — 30 INCHES MINIMUM HEIGHT MEASURED FROM EXISTING OR GRADED GROUND.
- MATERIAL — BURLAP, POLYPROPYLENE FABRIC, OR NYLON REINFORCED WITH POLYESTER NETTING. THE MULLEN BURST STRENGTH SHALL BE GREATER THAN 150 PSI. THE EDGES SHALL BE TREATED TO PREVENT UNRAVELING.
- SUPPORT — STEEL FENCE POSTS SPACED A MAXIMUM OF 8 FEET APART. WOVEN WIRE WILL BE USED TO SUPPORT THE MATERIAL.

OUTLET

SILT FENCE SHALL BE PLACED AND CONSTRUCTED IN SUCH A MANNER THAT RUNOFF FROM A DISTURBED SURFACE OR EXPOSED UPLAND AREA SHALL BE INTERCEPTED, SEDIMENT TRAPPED, AND THE SURFACE RUNOFF ALLOWED TO PERCOLATE THROUGH THE STRUCTURE.

SILT FENCE SHALL BE PLACED IN SUCH A MANNER THAT SURFACE RUNOFF WHICH PERCOLATES THROUGH WILL FLOW ONTO AN UNDISTURBED STABILIZED AREA OR STABILIZED OUTLET.

- NOTES:
- SHOULD WORK CEASE FOR A PERIOD OF 21 DAYS PERMANENT STABILIZATION SHALL BE INSTALLED.
 - SHOULD THE CONTRACTOR STORE ANY FUEL OR OTHER HAZARDOUS MATERIAL ONSITE THIS PLAN WILL BE MODIFIED TO REFLECT PROTECTION MEASURES.

EROSION CONTROL GENERAL NOTES



- STEEL POSTS WHICH SUPPORT THE SILT FENCE SHALL BE INSTALLED ON A SLIGHT ANGLE TOWARD THE ANTICIPATED RUNOFF SOURCE.
- THE TOE OF THE SILT FENCE SHALL BE TRENCHED IN WITH A SPADE OR MECHANICAL TO THE LINE OF FLOW.
- FOR THE SILT FENCE TO BE LAID IN THE GROUND AND BACKFILLED.
- SILT FENCE SHOULD BE SECURELY FASTENED TO EACH STEEL SUPPORT POST OR TO WOVEN WIRE, WHICH IS IN TURN ATTACHED TO THE STEEL FENCE POSTS.
- INSPECTION SHALL BE FREQUENT AND REPAIR OR REPLACEMENT SHALL BE MADE PROMPTLY AS NEEDED.
- BLOCK OR IMPEDE STORM FLOW OR DRAINAGE.
- SEDIMENT TRAPPED BY THIS PRACTICE SHALL BE DISPOSED OF IN AN APPROVED SITE IN A MANNER THAT WILL NOT CONTRIBUTE TO ADDITIONAL SILTATION.
- DISPOSED OF IN AN APPROVED SPOIL SITE OR AS IN NO. 7 ABOVE.
- EROSION PROTECTION WILL BE DELETED OR ADDED PER THE CITY OF ROCKWALL.
- THE CONTRACTOR SHALL COMPLY WITH ALL APPLICABLE FEDERAL, STATE, AND LOCAL EROSION, CONSERVATION, AND SILTATION ORDINANCES. THE CONTRACTOR SHALL REMOVE ALL TEMPORARY EROSION CONTROL DEVICES UPON COMPLETION OF PERMANENT DRAINAGE FACILITIES AND THE ESTABLISHMENT OF A STAND OF GRASS OR OTHER GROWTH TO PREVENT EROSION.
- ALL SEEDING AND FERTILIZATION OF DISTURBED AREAS WILL BE THE RESPONSIBILITY OF THE GRADING CONTRACTOR.

STORM DRAIN INLET PROTECTION CONSTRUCTION SPECIFICATIONS

- STEEL FRAME IS TO BE CONSTRUCTED OF SUITABLE MATERIAL.
- WIRE MESH MUST BE OF SUFFICIENT STRENGTH TO SUPPORT FILTER FABRIC, AND STONE FOR CURB INLETS, WITH WATER FULLY IMPOUNDED AGAINST IT.
- FILTER CLOTH MUST BE OF A TYPE APPROVED FOR THIS PURPOSE; RESISTANT TO SUNLIGHT WITH SIEVE SIZE, EOS, 40-85, TO ALLOW SUFFICIENT PASSAGE OF WATER AND REMOVAL OF SEDIMENT.
- STONE IS TO BE 2" IN SIZE AND CLEAN, SINCE FINES WOULD CLOG THE CLOTH.
- THE ASSEMBLY SHALL BE PLACED SO THAT THE END SPACERS ARE A MINIMUM 1' BEYOND BOTH ENDS OF THE THROAT OPENING.
- FORM THE WIRE MESH AND FILTER CLOTH TO THE CONCRETE GUTTER AND AGAINST THE FACE OF CURB ON BOTH SIDES OF THE INLET. PLACE CLEAN 2" STONE OVER THE WIRE MESH AND FILTER FABRIC IN SUCH A MANNER AS TO PREVENT WATER FROM ENTERING THE INLET UNDER OR AROUND THE FILTER CLOTH.
- THIS TYPE OF PROTECTION MUST BE INSPECTED FREQUENTLY AND THE FILTER CLOTH AND STONE REPLACED WHEN CLOGGED WITH SEDIMENT.
- ASSURE THAT STORM FLOW DOES NOT BYPASS INLET BY INSTALLING TEMPORARY EARTH OR ASPHALT DIKES DIRECTING FLOW INTO INLET.

- NOTE:
- SILTATION FENCE SHALL BE PLACED AROUND INLETS DURING CONSTRUCTION.
 - 75%-80% OF ALL DISTURBED AREAS TO HAVE MINIMUM 1" STAND OF GRASS (NOT RYE OR WEEDS) PRIOR TO CITY ACCEPTANCE.
 - ALL RIGHT OF WAY TO BE SODDED PRIOR TO CITY ACCEPTANCE AND CERTIFICATE OF OCCUPANCY

EROSION CONTROL DETAILS

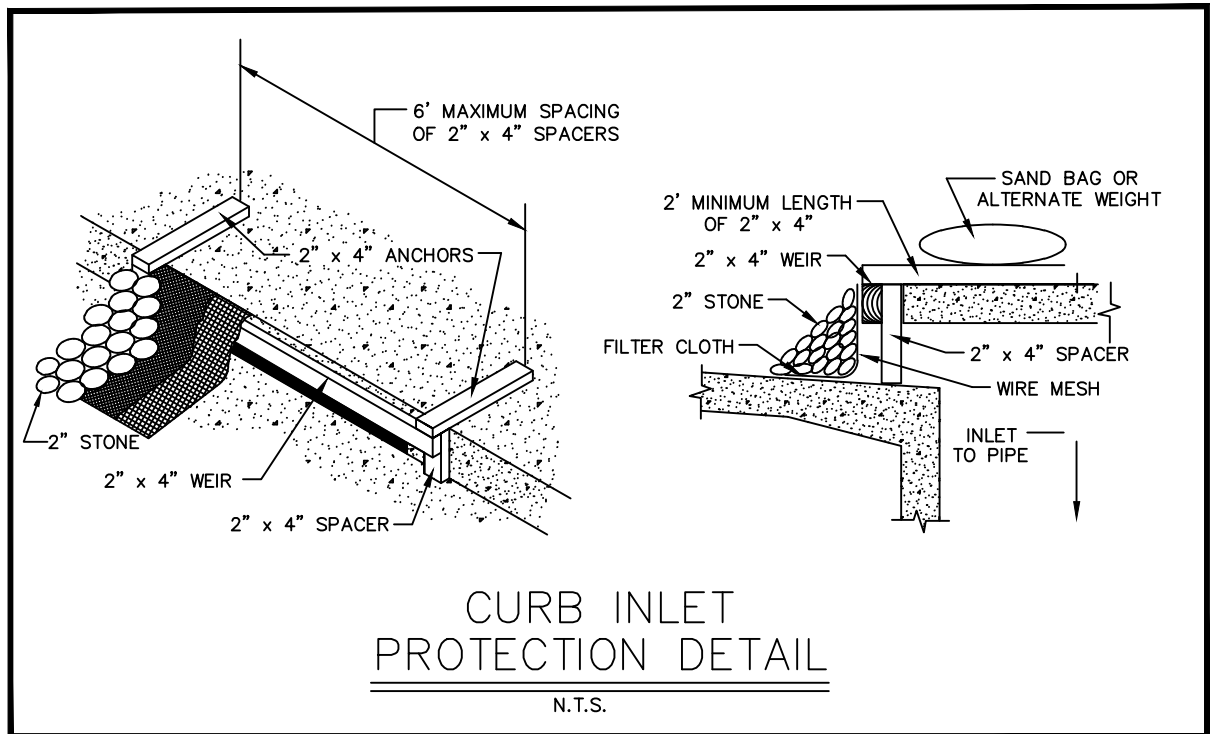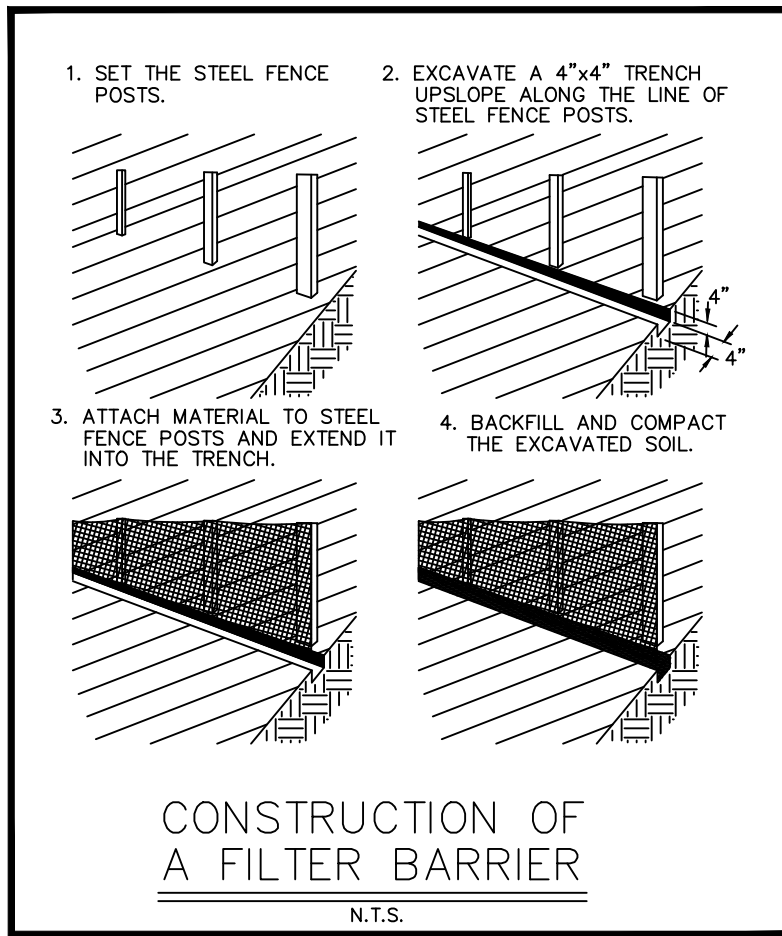

REVISED TO CONFORM TO CONSTRUCTION RECORDS.

DATE: 6-15-24

DOUPHRATE & ASSOCIATES, INC.
ENGINEERING • PROJECT MANAGEMENT • SURVEYING

2235 RIDGE RD., # 200 ROCKWALL, TEXAS 75087
PHONE: (972)771-8004 FAX: (972)771-8005

EROSION CONTROL DETAILS
BARRETT HEIGHTS
CITY OF ROCKWALL,
ROCKWALL COUNTY, TEXAS

REVISION

W.L.D.

CHECKED

D.A.C.

DRAWN

SCALE

1"=60'H

1"=5'




FEB. 2023

DATE

23010

PROJECT

81

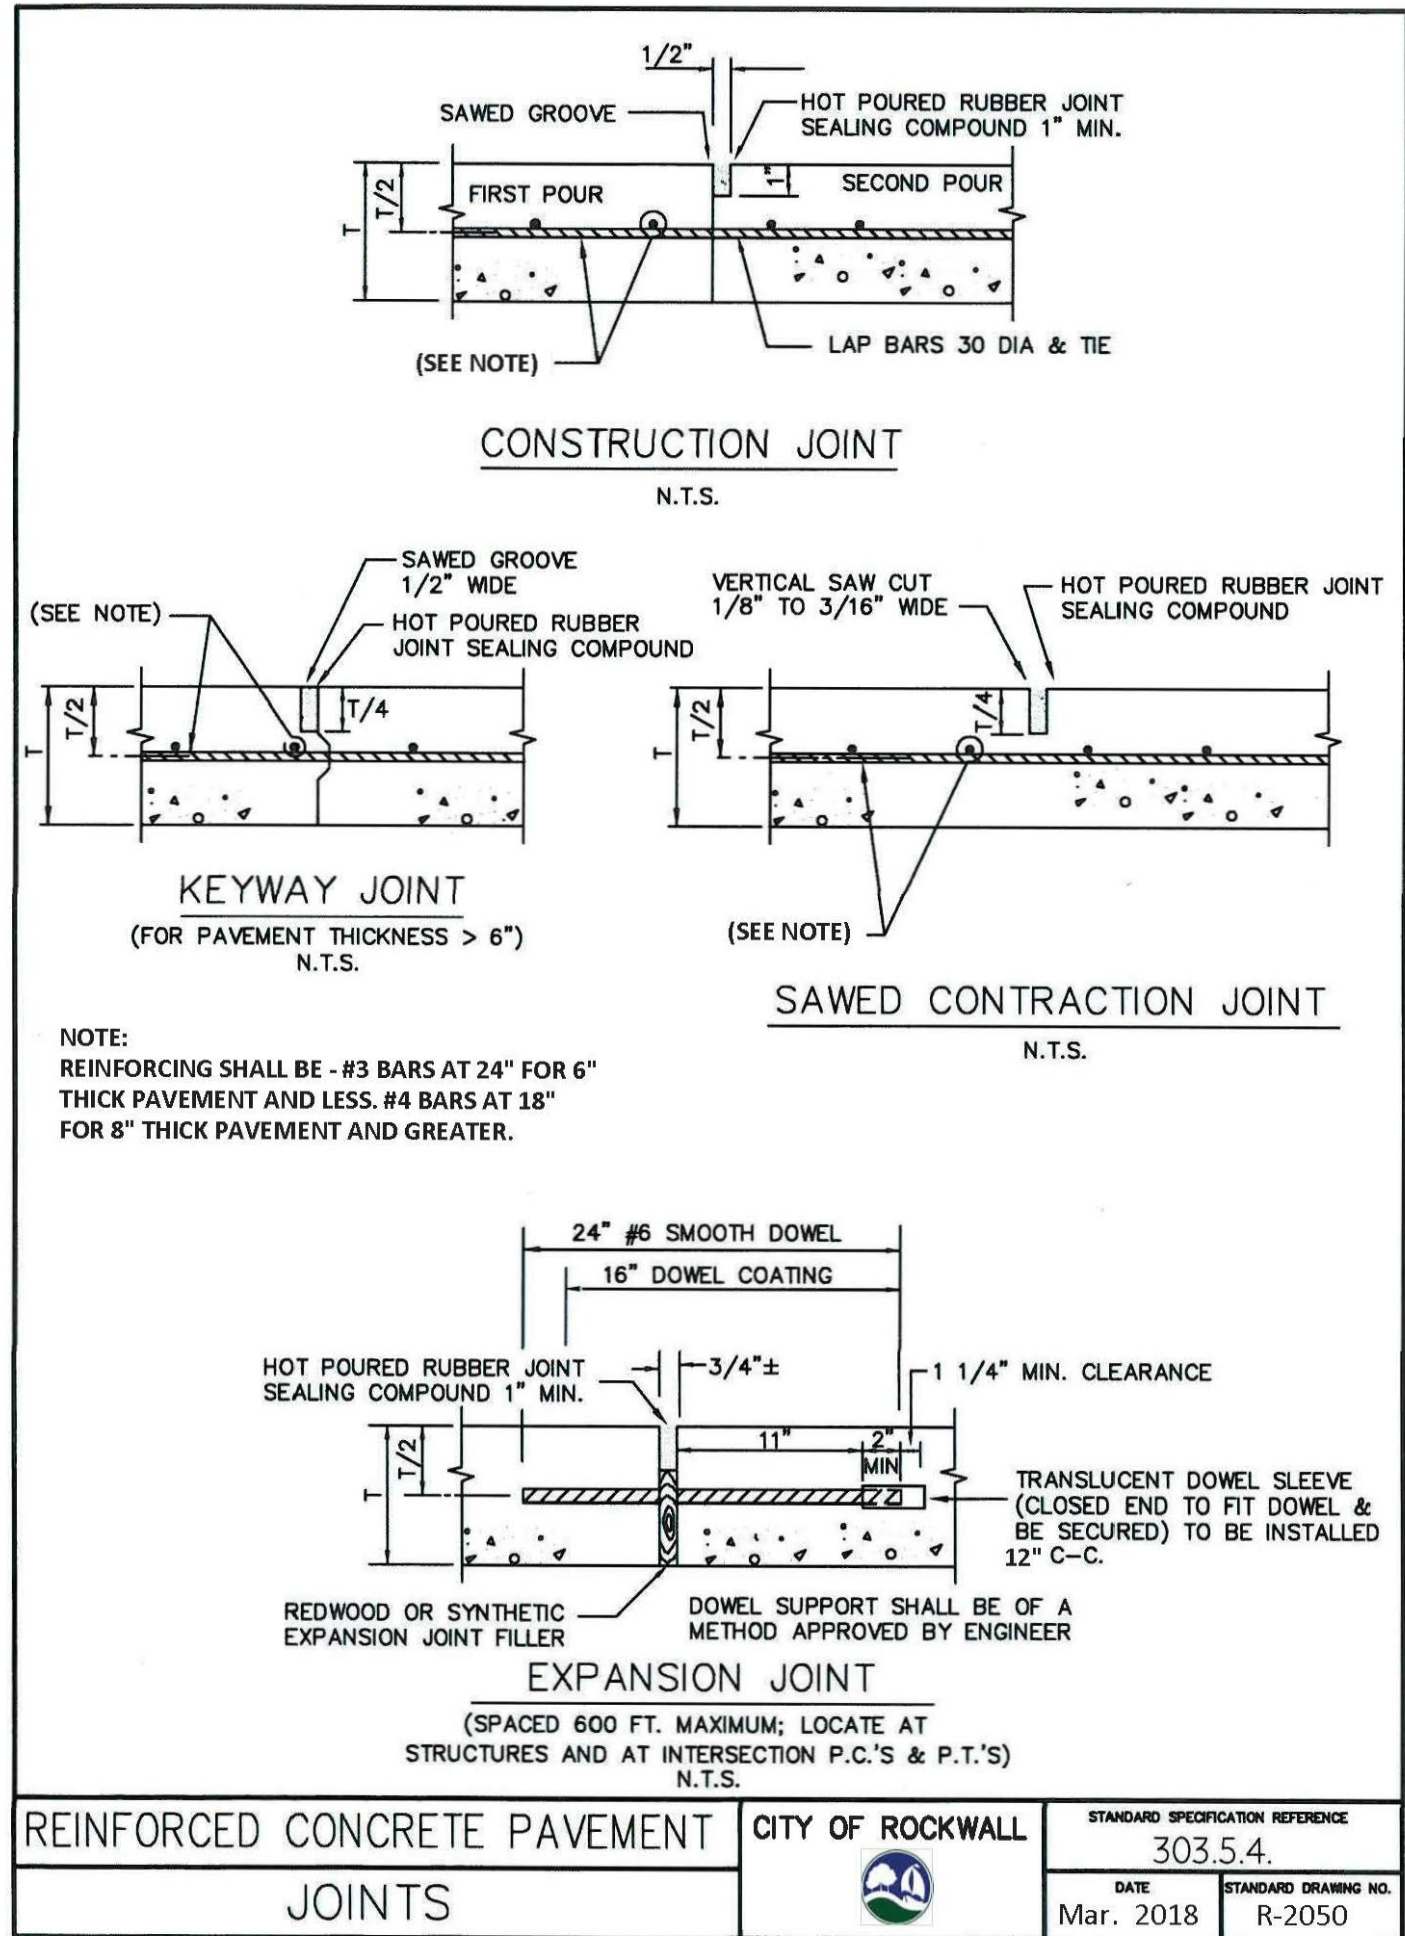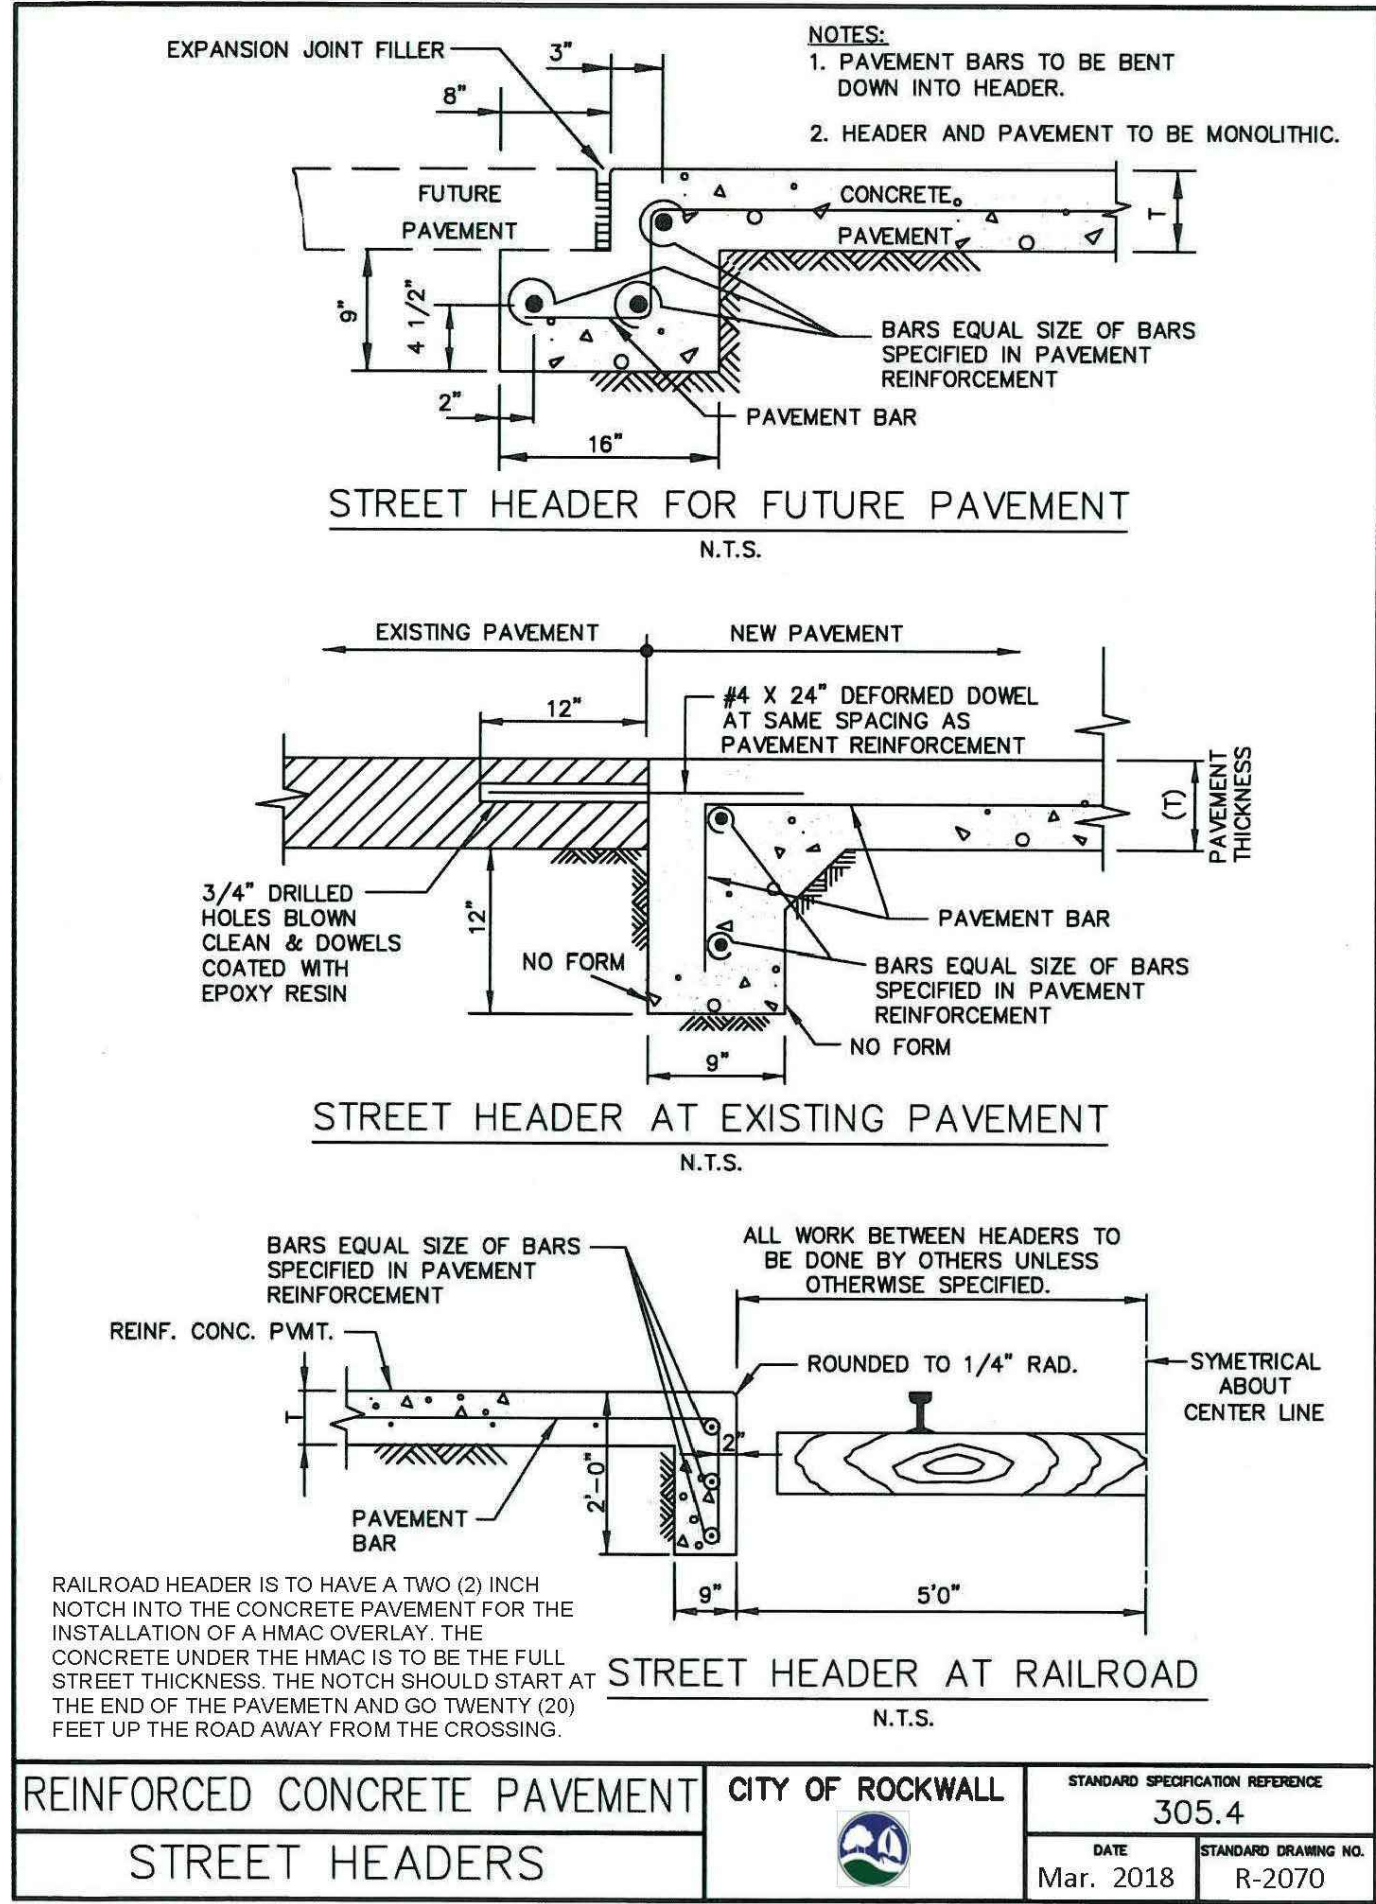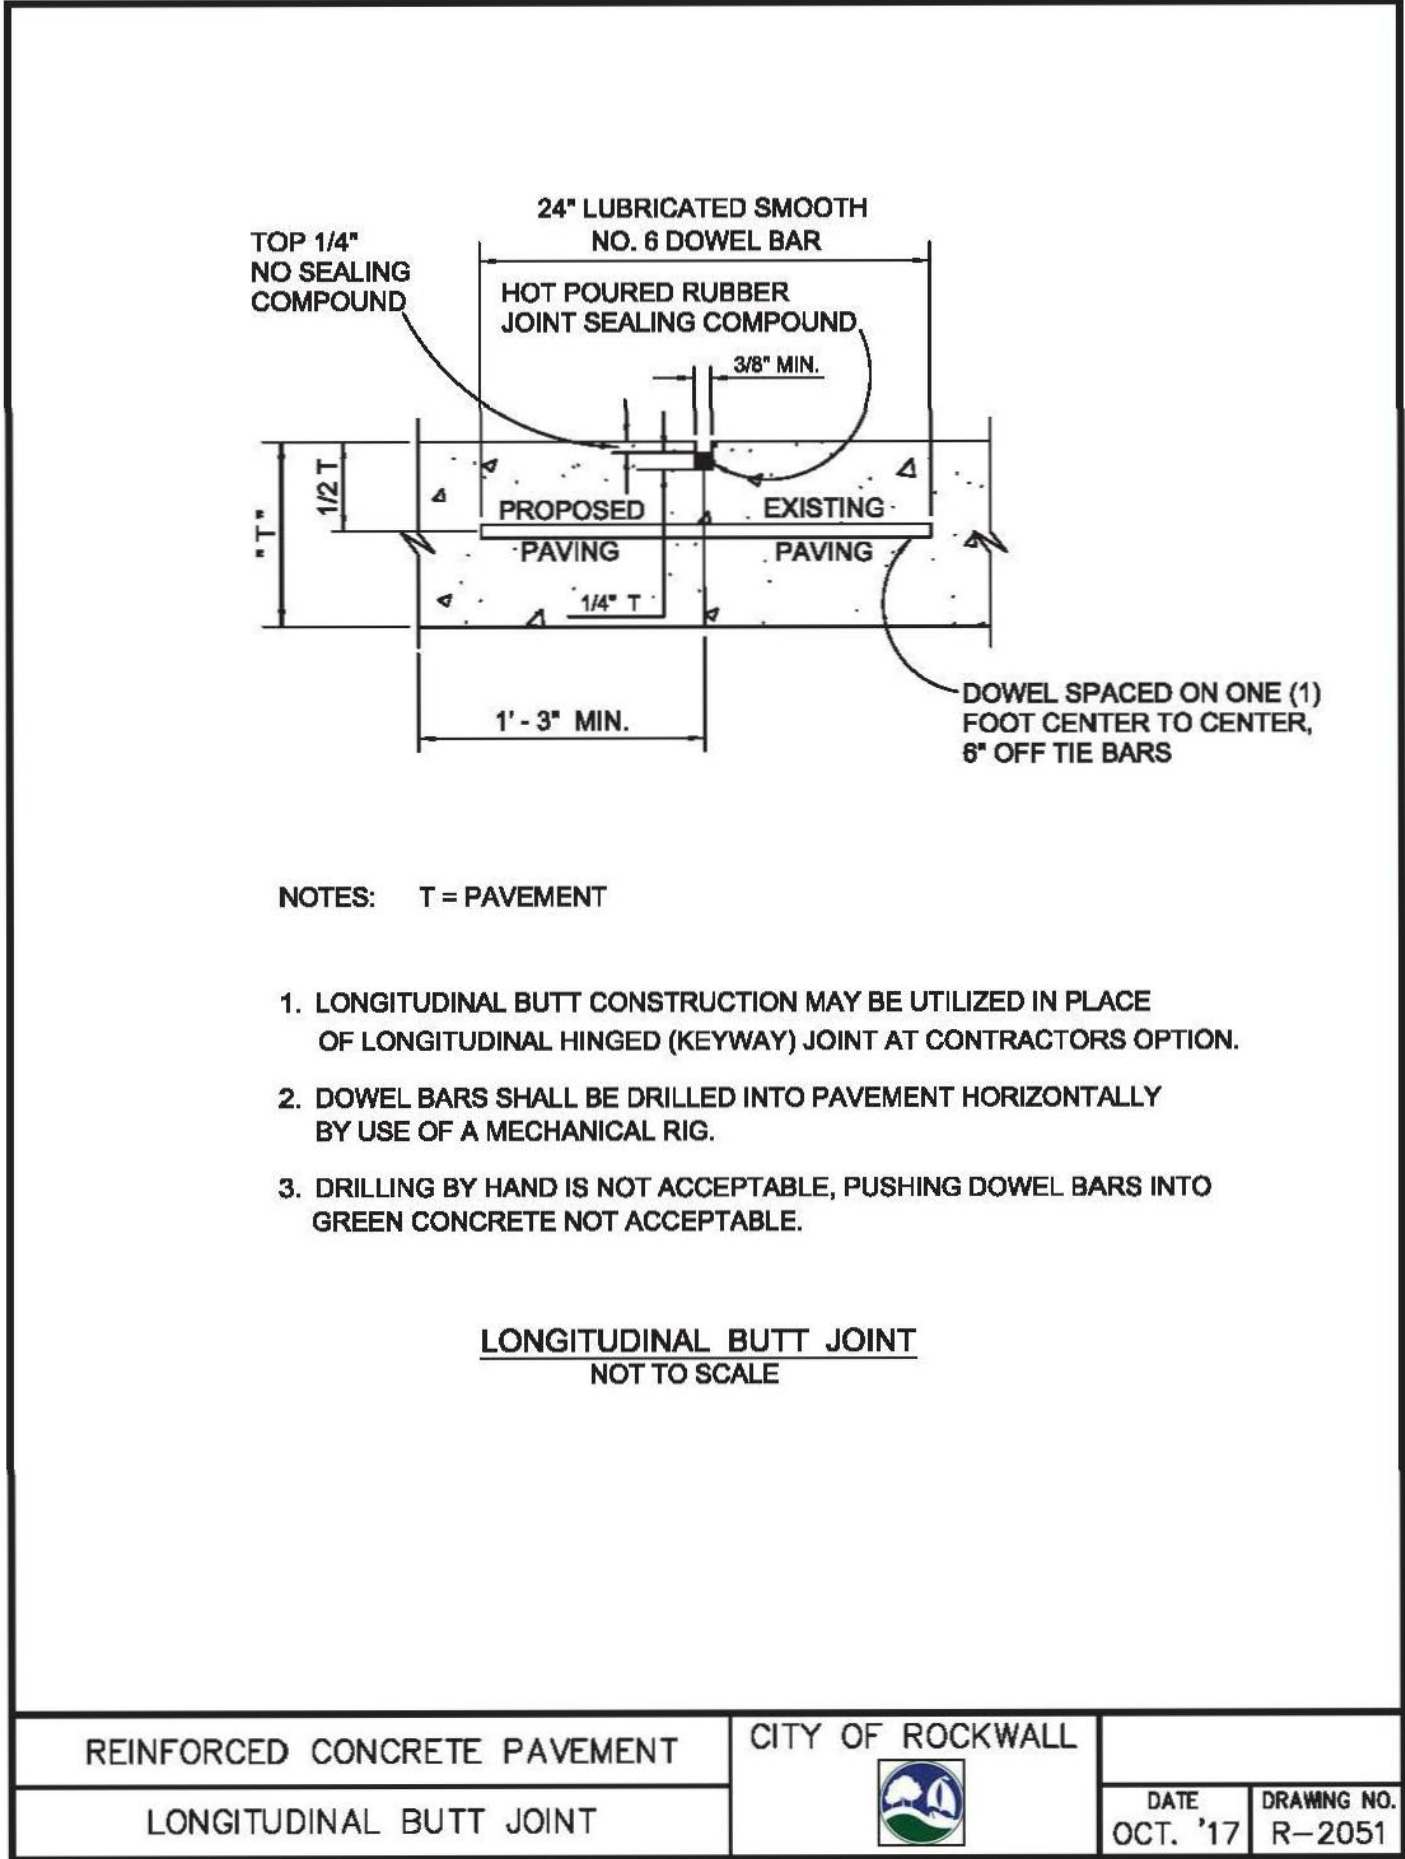

REVISED TO CONFORM TO CONSTRUCTION RECORDS.
DATE: 6-15-24

PAVING DETAILS
BARETT HEIGHTS
CITY OF ROCKWALL
ROCKWALL COUNTY, TEXAS

REVISION
W.L.D.
CHECKED
D.A.C.
DRAWN
SCALE
1"=60'H
1"=V
FEB. 2023
DATE
22027
PROJECT
82

DOUPHRATE & ASSOCIATES, INC.
ENGINEERING • PROJECT MANAGEMENT • SURVEYING
2235 RIDGE RD., # 200 ROCKWALL, TEXAS 75087
PHONE: (972) 771-9004 FAX: (972) 771-9005

THE SEAL APPEARING ON THIS DOCUMENT IS AUTHORIZED BY THE BOARD OF PROFESSIONAL ENGINEERS OF THE STATE OF TEXAS P.E. NO. 60102, F-686, ON DATE: FEBRUARY 13, 2023