
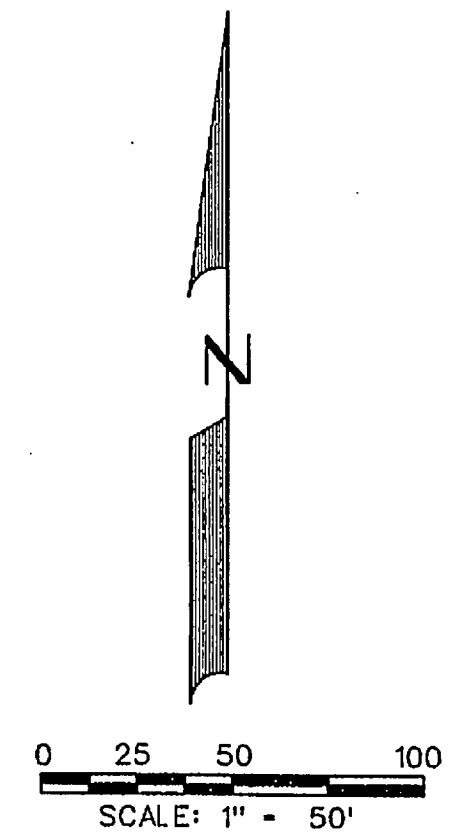



DRAINAGE TO DITCH
BREEZY HILL RD

EXIST. CONDITIONS
8.86 AC.
25.7cfs

PROPOSED
1.48 AC. (AREA 20)
0.70 AC (EX ROAD AND DITCH)
10.6 cfs TOTAL

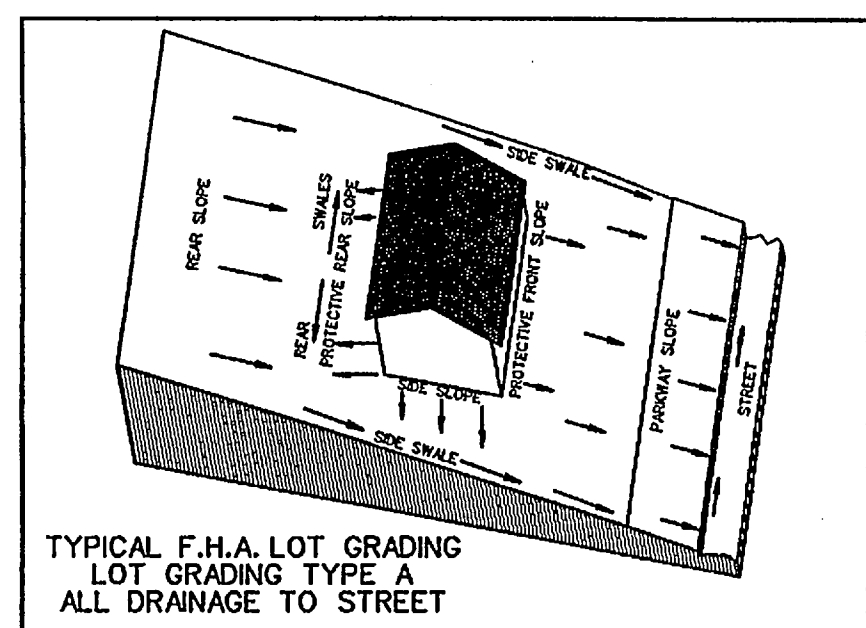

⊗ Driveway must be located on noted side.

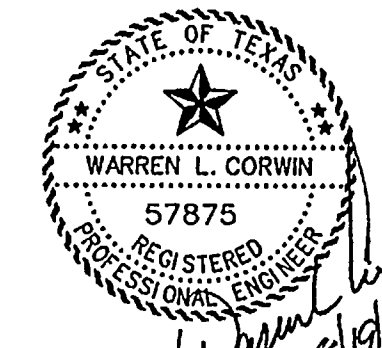

RELEASED FOR CONSTRUCTION
The seal appearing hereon is the responsibility of the DESIGNER. IN REVIEWING AND RELEASING
this document REMAINS WITH THE DESIGN ENGINEER, THE CITY
authorized by OF ROCKWALL, IN REVIEWING AND RELEASING
Warren L. Corwin PLANS FOR CONSTRUCTION, ASSUMES NO
P.E. 57875, OF RESPONSIBILITY FOR ADEQUACY OR ACCURACY
August 19, 2013

CITY _____ DATE _____

CORWIN ENGINEERING, INC. 200 W. BELMONT, SUITE E ALLEN, TEXAS 75013 (972)396-1200 TBPE FIRM #5951			
DEVELOPMENT PLANS FOR BREEZY HILL PHASE 2 ROCKWALL, TEXAS			
GRADING PLAN			
DRAWN BY	DESIGNED BY	CHECKED BY	SHEET NO.
JOB NUMBER	DATE	SCALE:	24 OF 25
13022	MAY 2013	1"=50'	

AS-BUILT JULY 2014
 INFORMATION PROVIDED BY CONTRACTORS
 (NOT FIELD VERIFIED)