



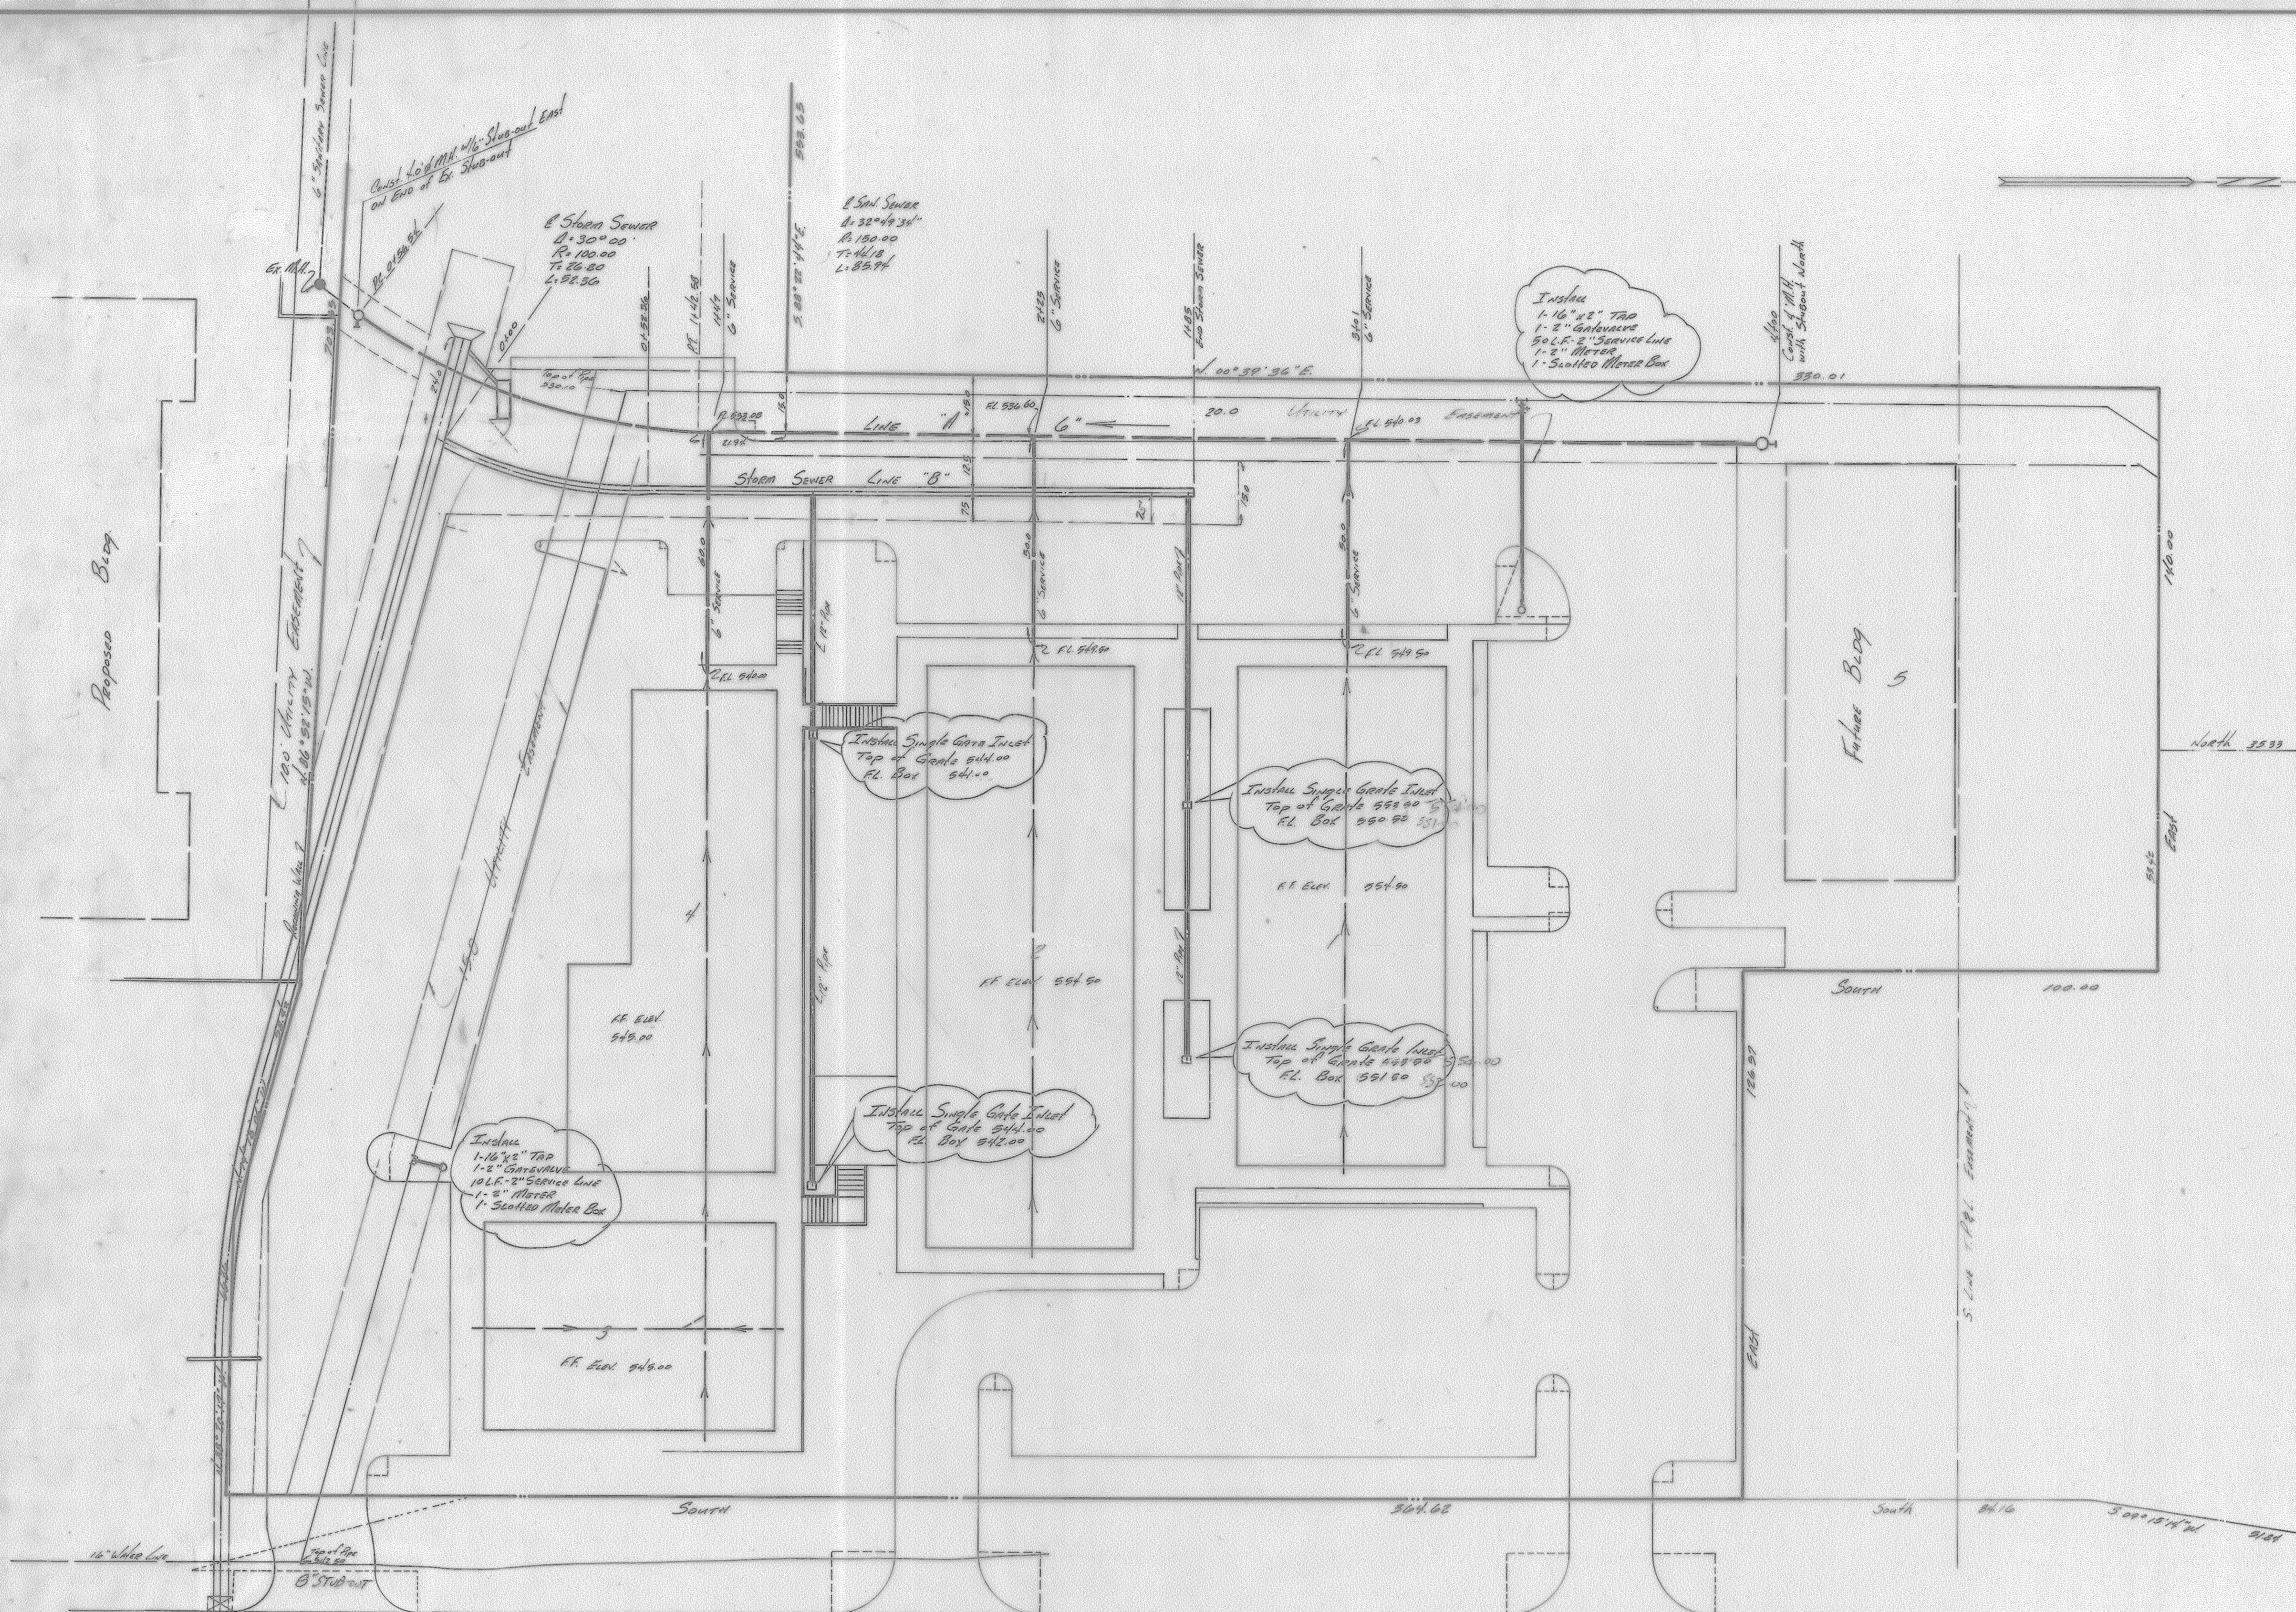

DRAINAGE	
1. 12" RCP	304 L.F.
2. 18" RCP	200 L.F.
3. 48" RCP	250 L.F.
4. Single Grate Inlets	4 Each
5. 8" Inlet	1 Each
6. Type "B" Headwall-48" Pipe	1 Each
7. Remove Existing Headwall and Connect to Existing 48" Pipe	1 Each
8. Sand Encasement	207 C.Y.
WATER	
1. 2" Service Line	60 L.F.
2. 16"x16"x2" Wet Tap	2 Each
3. 2" Gate Valves	2 Each
4. 2" Meters	2 Each
5. Slotted Meter Boxes	2 Each
6. Rock Embedment	1.5 C.Y.
7. Sand Encasement	2.5 C.Y.
SEWER	
1. 6" Sewer (Inc. 6" Service Lines)	560 L.F.
2. 4' Manholes	1 Each
3. 4' Manholes with Drop Connection	1 Each
4. Remove Existing Cleanout and Connect to Existing 6" Sewer	1 Each
5. 6" Wyes	3 Each
6. Rock Embedment	21 C.Y.
7. Sand Encasement	21 C.Y.

STATE HIGHWAY NO. 205

AS BUILT

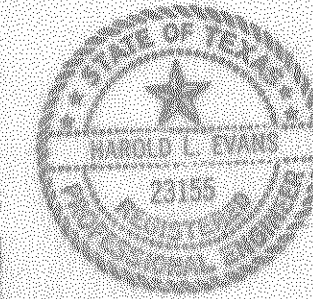

CE-3

WATER & SEWER PLANS				ROCKWALL COUNTY, TEXAS	
CAIN PROPERTIES NO. 1					
Design H.L.E.	Drawn M.L.P.	Scale 1" = 20'	Date 9-20-81	328-0135 HAROLD L. EVANS — CONSULTING ENGINEER DALLAS	
REVISED 5-18-82 Revised 11-27-82				Job No. 20102	