


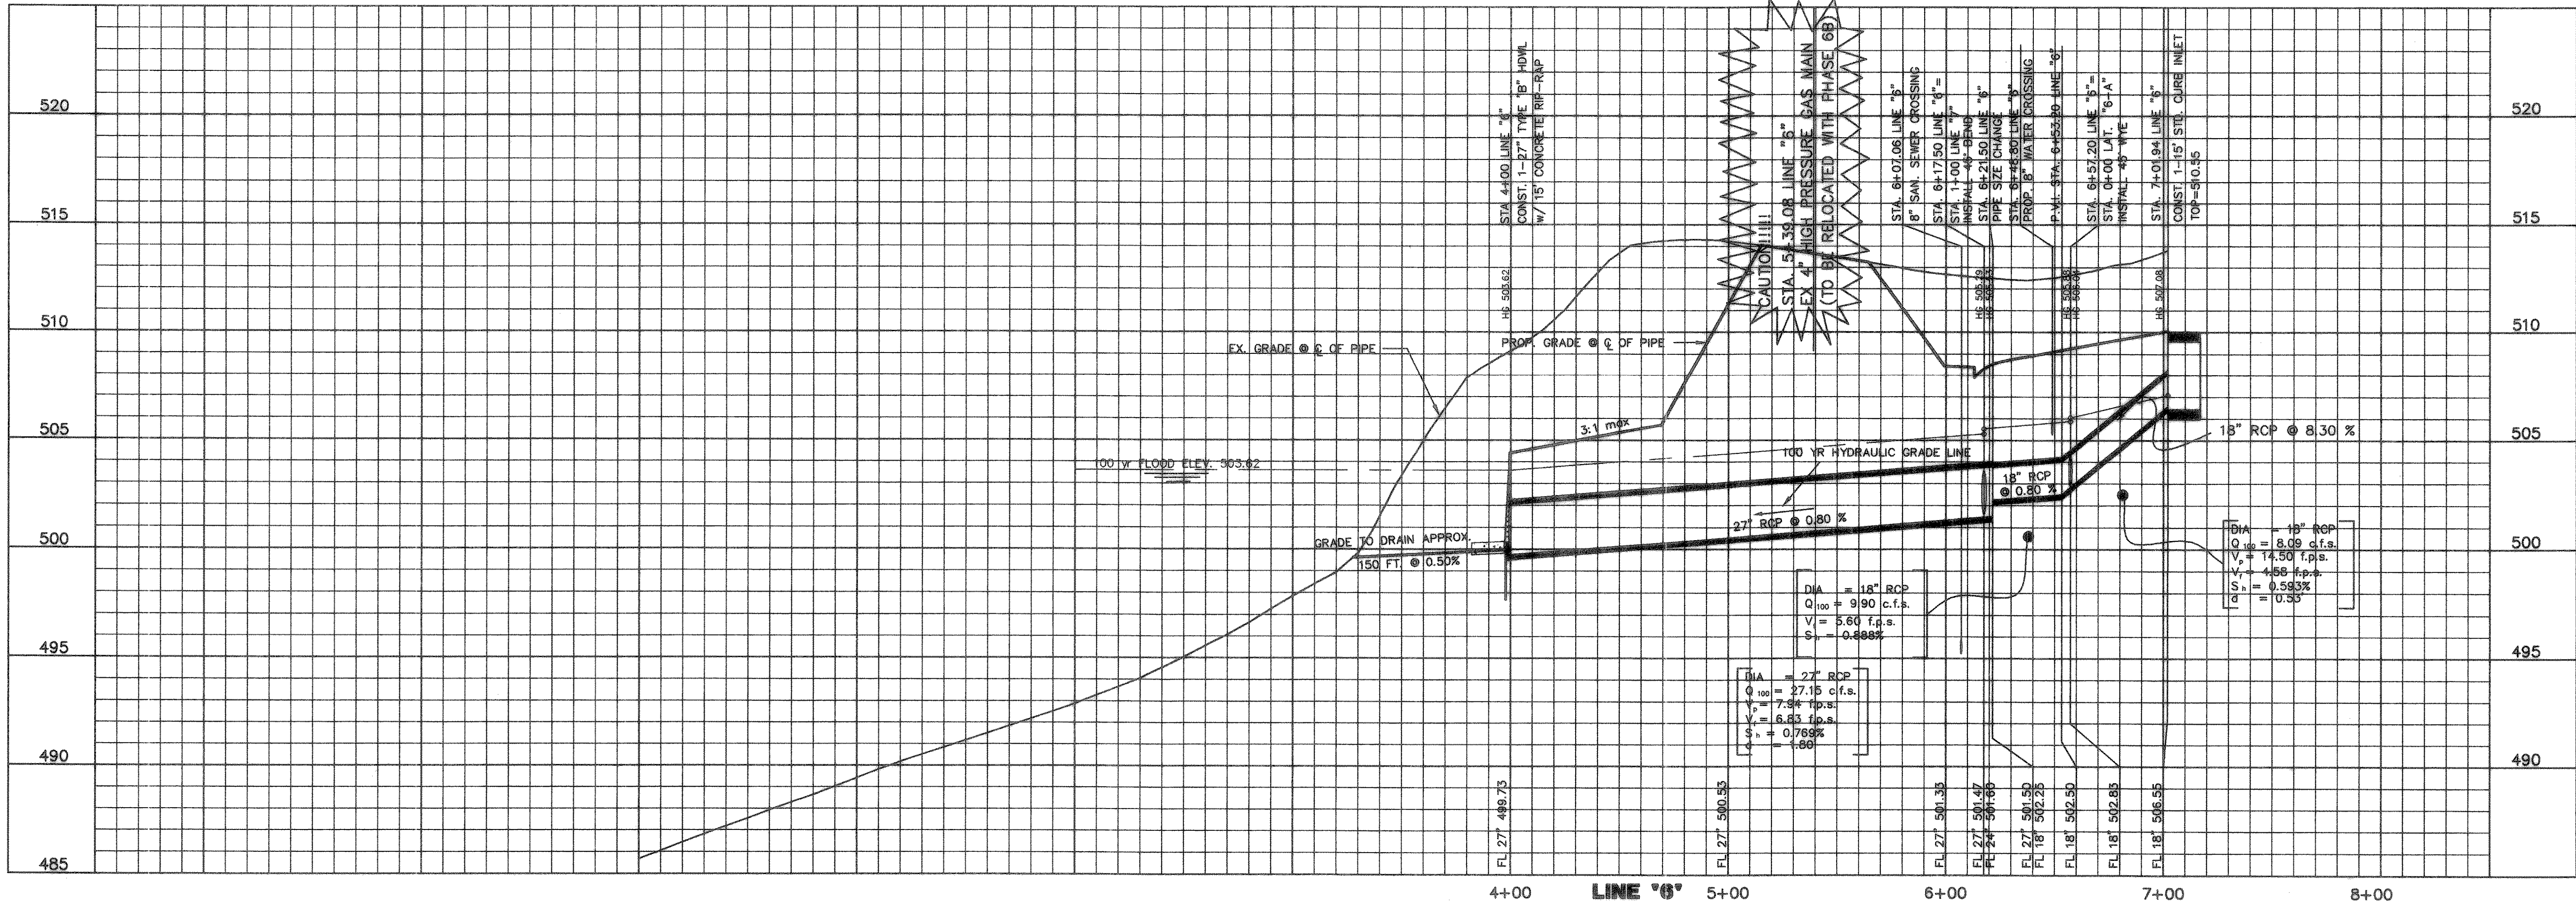

THESE CONSTRUCTION PLANS WERE PREPARED
UNDER THE RESPONSIBLE SUPERVISION OF
MD. NAM UDDIN KHAN, REGISTERED PROFESSIONAL
ENGINEER NO. 87776

THESE CONSTRUCTION PLANS WERE PREPARED
UNDER THE RESPONSIBLE SUPERVISION OF
MD. NAIM UDDIN KHAN, REGISTERED PROFESSIONAL
ENGINEER NO. 87776

THE SEAL APPEARING ON THIS
DOCUMENT WAS AUTHORIZED BY
MD. NAIM UDDIN KHAN, # 87776

**STORM SEWER PROFILES
(PHASE 6A)**

Scale : H: V: $\theta = 40^\circ$
 Date : 12/2/03
 Designed By : NK
 Drawn By : MS
 Checked By : NK
 File : I45446ANSTP.dwg View :
 Project No. : I454.01

SHEET
29A
OF
57

M.B. JONES SURVEY, ABSTRACT NO. 122
CITY OF ROCKWALL
ROCKWALL COUNTY, TEXAS

LUMBERMEN'S INVESTMENT CORPORATION
5495 BELTLINE ROAD #225
DALLAS, TEXAS 75240

**Winkelmann
& Associates, Inc.**

CONSULTING CIVIL ENGINEERS & SURVEYORS

(612) 490-7060
(972) 490-7061 FAX
(972) 490-7065 FAX

6750 HILLCREST PLAZA, SUITE 100
DALLAS, TEXAS
75250





STATE OF TEXAS
REGISTERED PROFESSIONAL ENGINEER
87776
MD. NAM UDDIN KHAN