

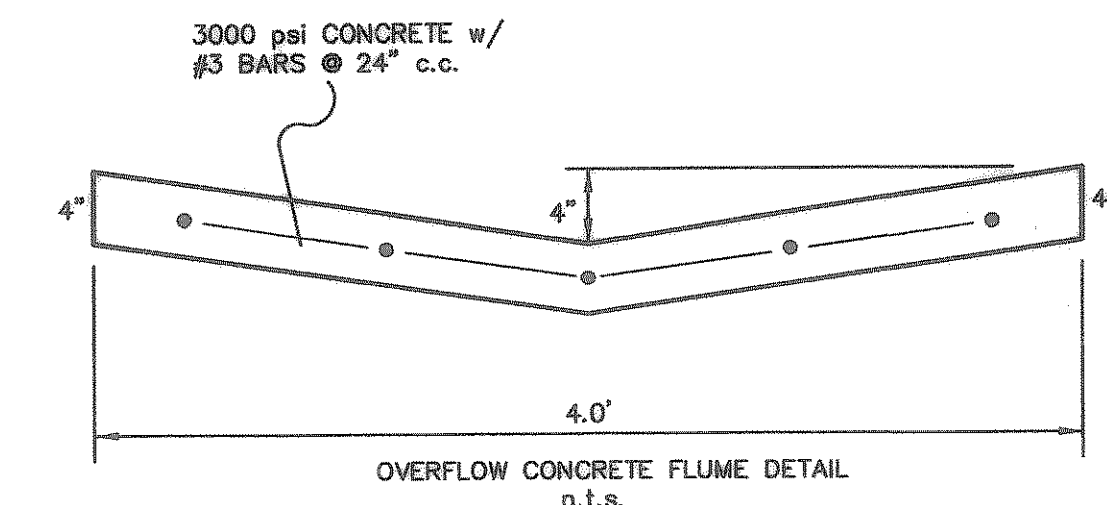
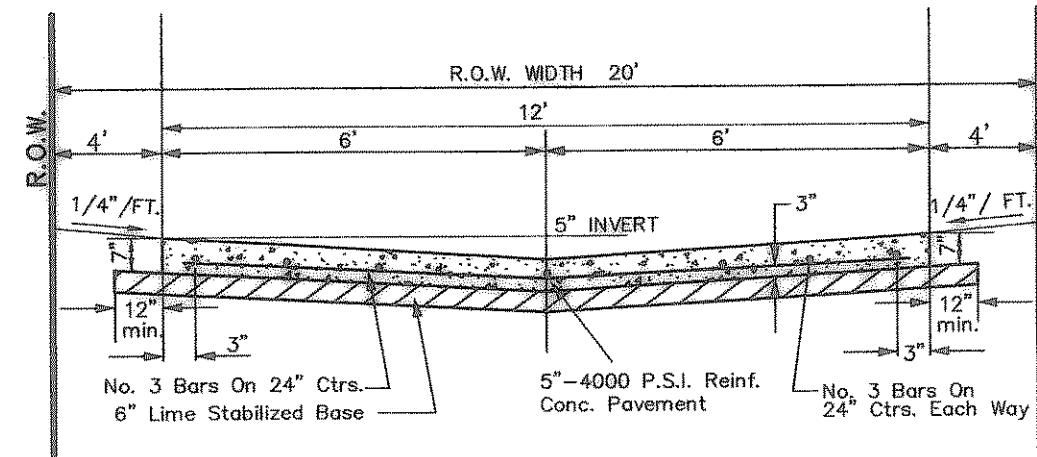



CURVE	RADIUS	DELTA	TANGENT	LENGTH	CHORD	BEARING
C-13	900.00'	17°21'56"	137.44'	272.78'	271.74'	S40°28'47"E
C-14	400.00'	47°13'08"	174.83'	329.65'	320.40'	S72°46'18"E
C-19	300.00'	15°49'45"	41.71'	82.88'	82.82'	S54°50'58"W

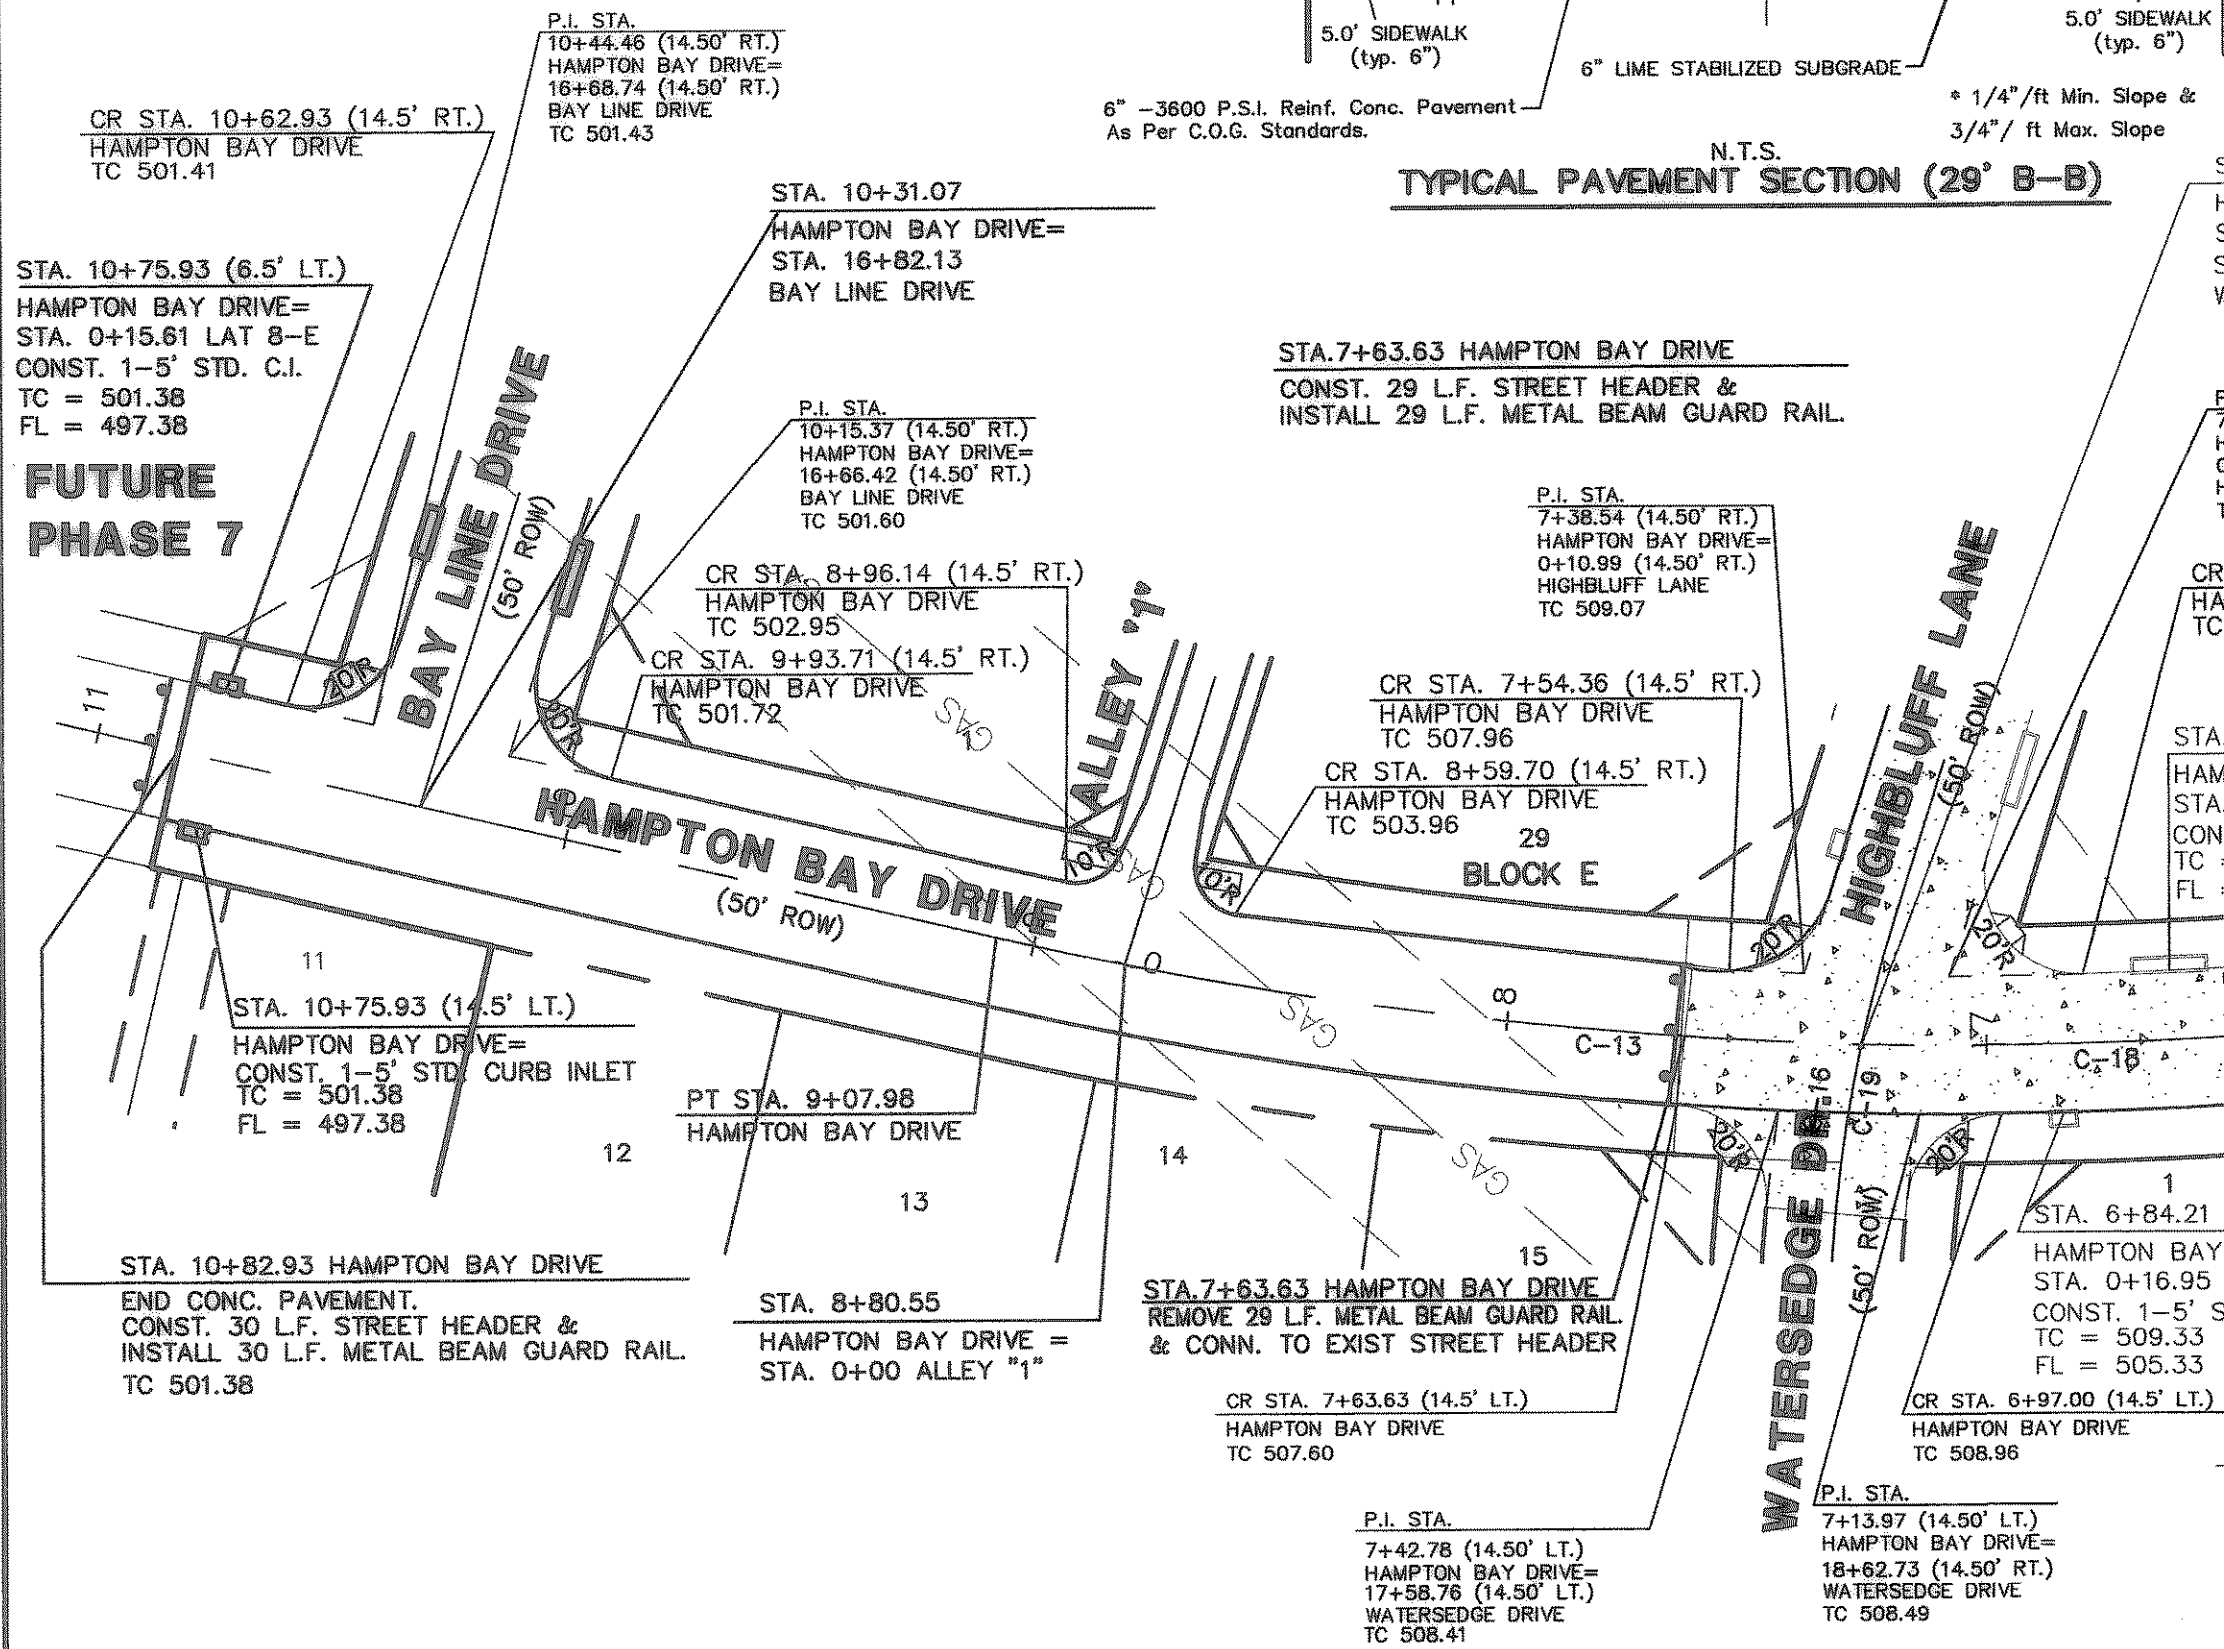

CUL-DE-SAC	ANGLE	DIST.
Δ 1	45°00'00"	31.02
Δ 2	31°29'19"	21.57

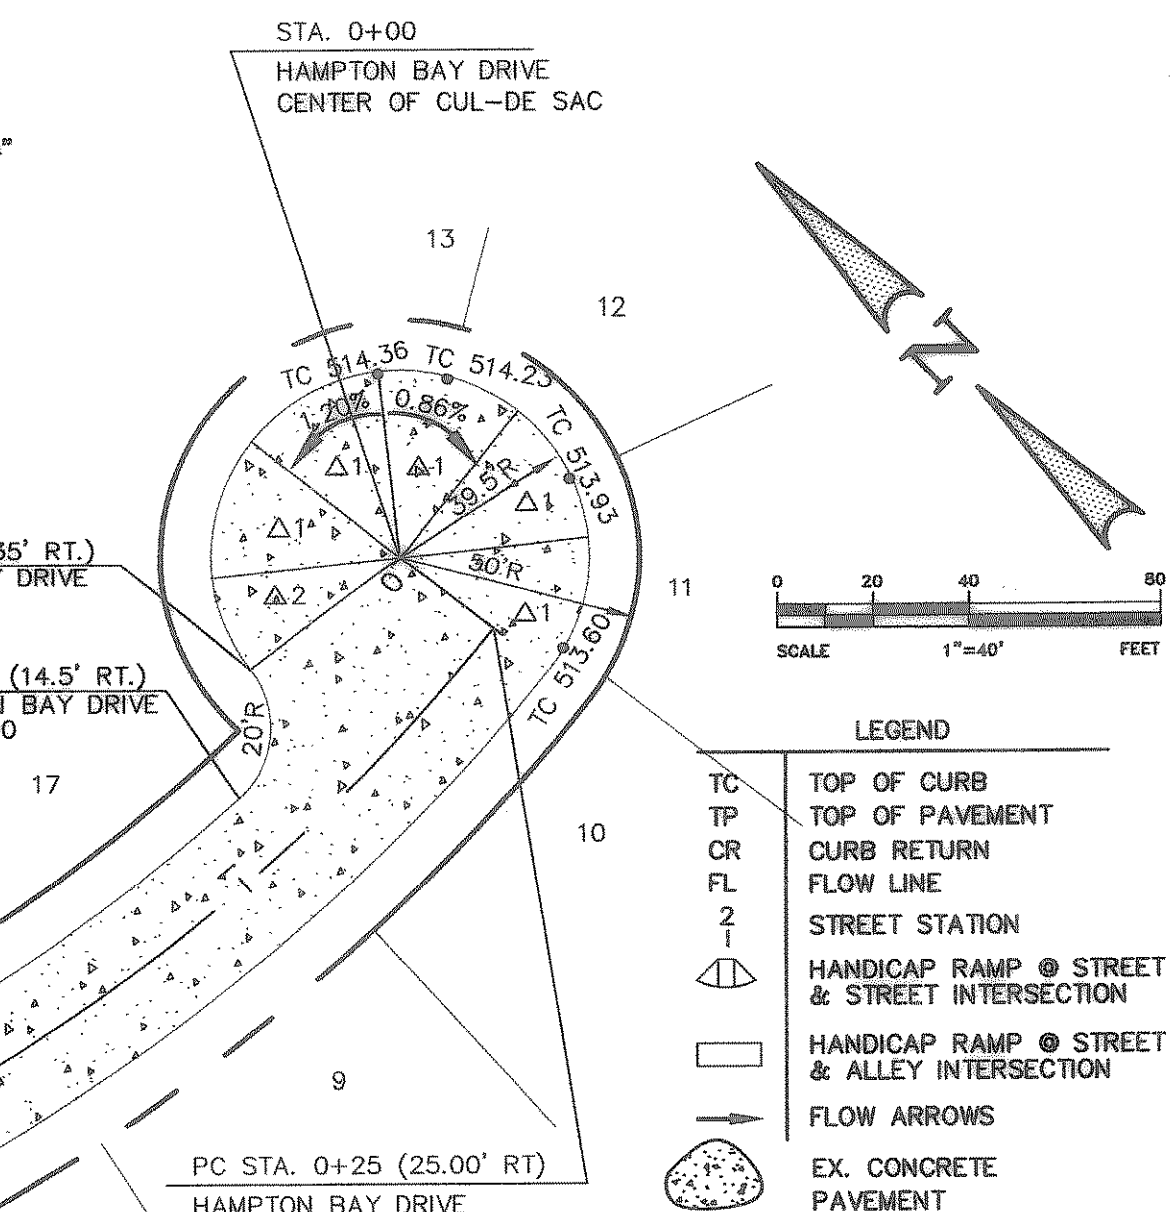

- NOTE:
- PAVEMENT FOR STREETS SHALL CONSIST OF 6\"/>

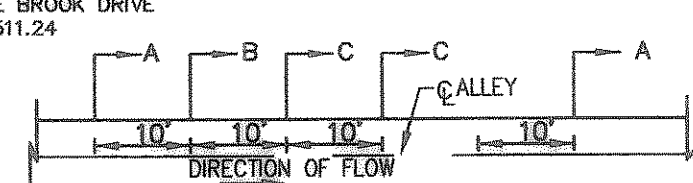



TYPICAL ALLEY WARPING AT INLET
N.T.S.



Winkelmann & Associates, Inc. hereby states that this plan is the best of our knowledge at the time of preparation. Modifications from the originally approved construction documents have been made as per information provided by the contractor. Winkelmann & Associates, Inc. does not certify as to the correctness or quality of construction as no field inspection was performed.

[Signature] 6/14/07
WINKELMANN & ASSOCIATES, INC. DATE

THESE CONSTRUCTION PLANS WERE PREPARED UNDER THE RESPONSIBLE SUPERVISION OF
MD. NAIM UDDIN KHAN, REGISTERED PROFESSIONAL ENGINEER NO. 87776
M.B. JONES SURVEY, ABSTRACT NO. 122
CITY OF ROCKWALL
ROCKWALL COUNTY, TEXAS
LUMBERMEN'S INVESTMENT CORPORATION
5495 BELTLINE ROAD #225
DALLAS, TEXAS 75240

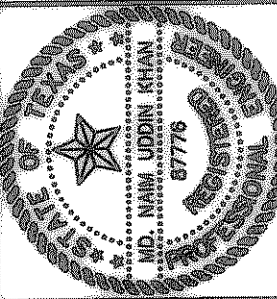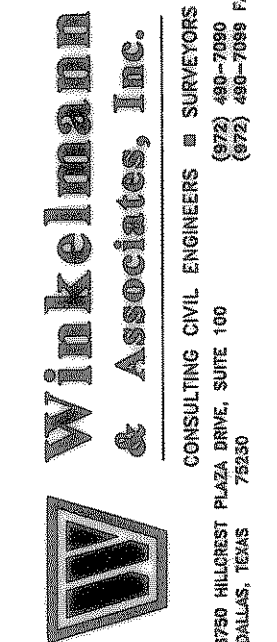

PHASE 08
Scale: 1"=40'
Designed By: RB
Drawn By: MS
Checked By: NK
File: 1465416P09.dwg View:
Project No.: 14654.01

PHASE 08
Scale: 1"=40'
Designed By: RB
Drawn By: MS
Checked By: NK
File: 1465416P09.dwg View:
Project No.: 14654.01

PHASE 08
Scale: 1"=40'
Designed By: RB
Drawn By: MS
Checked By: NK
File: 1465416P09.dwg View:
Project No.: 14654.01