
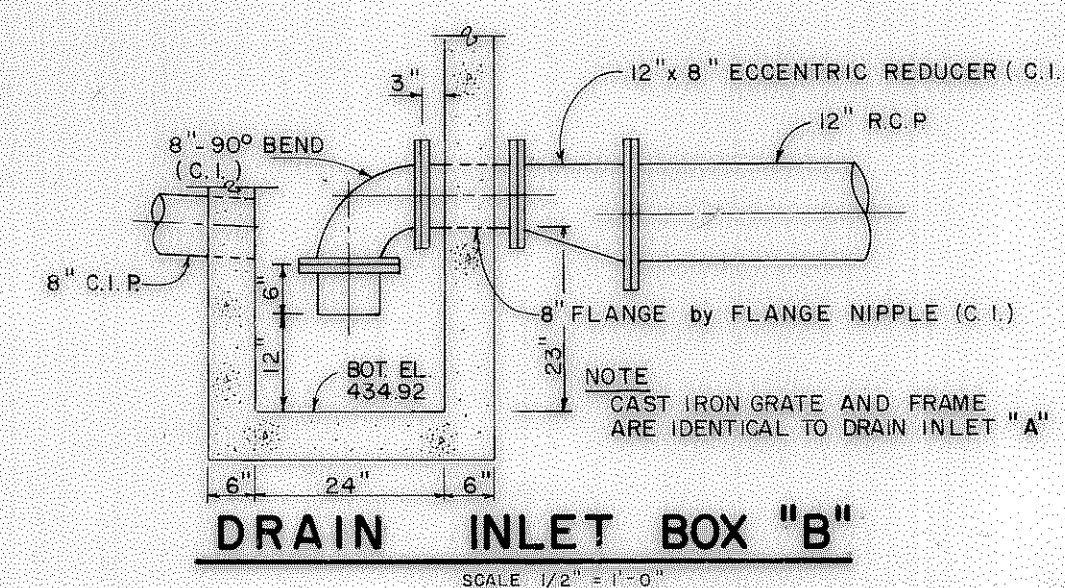
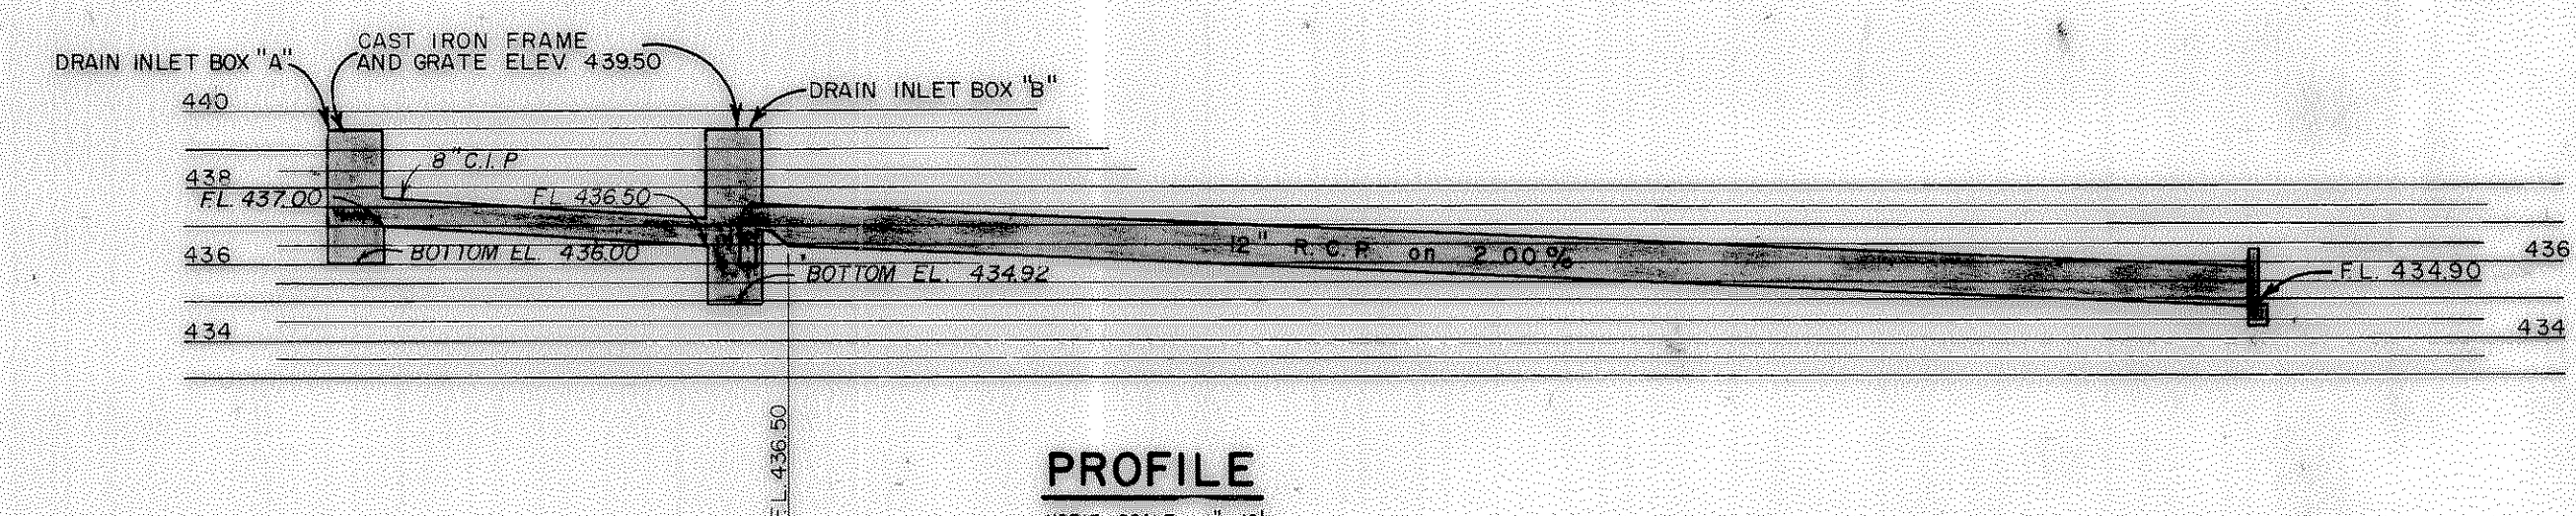
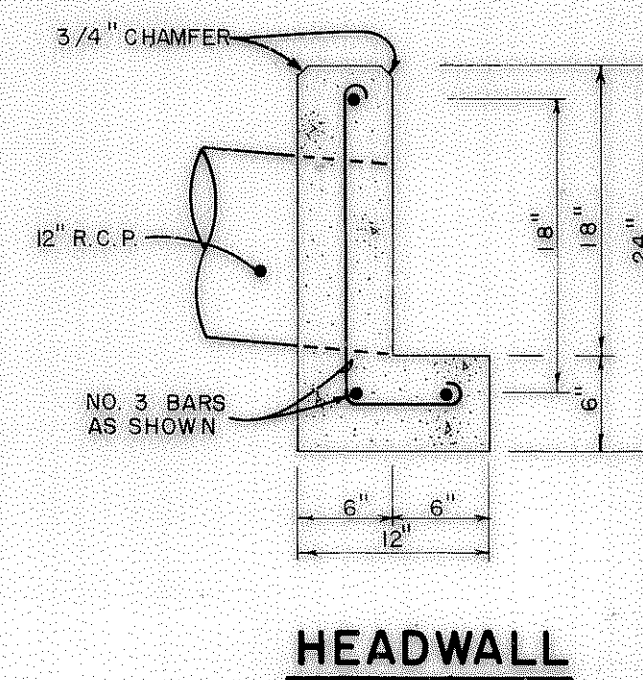
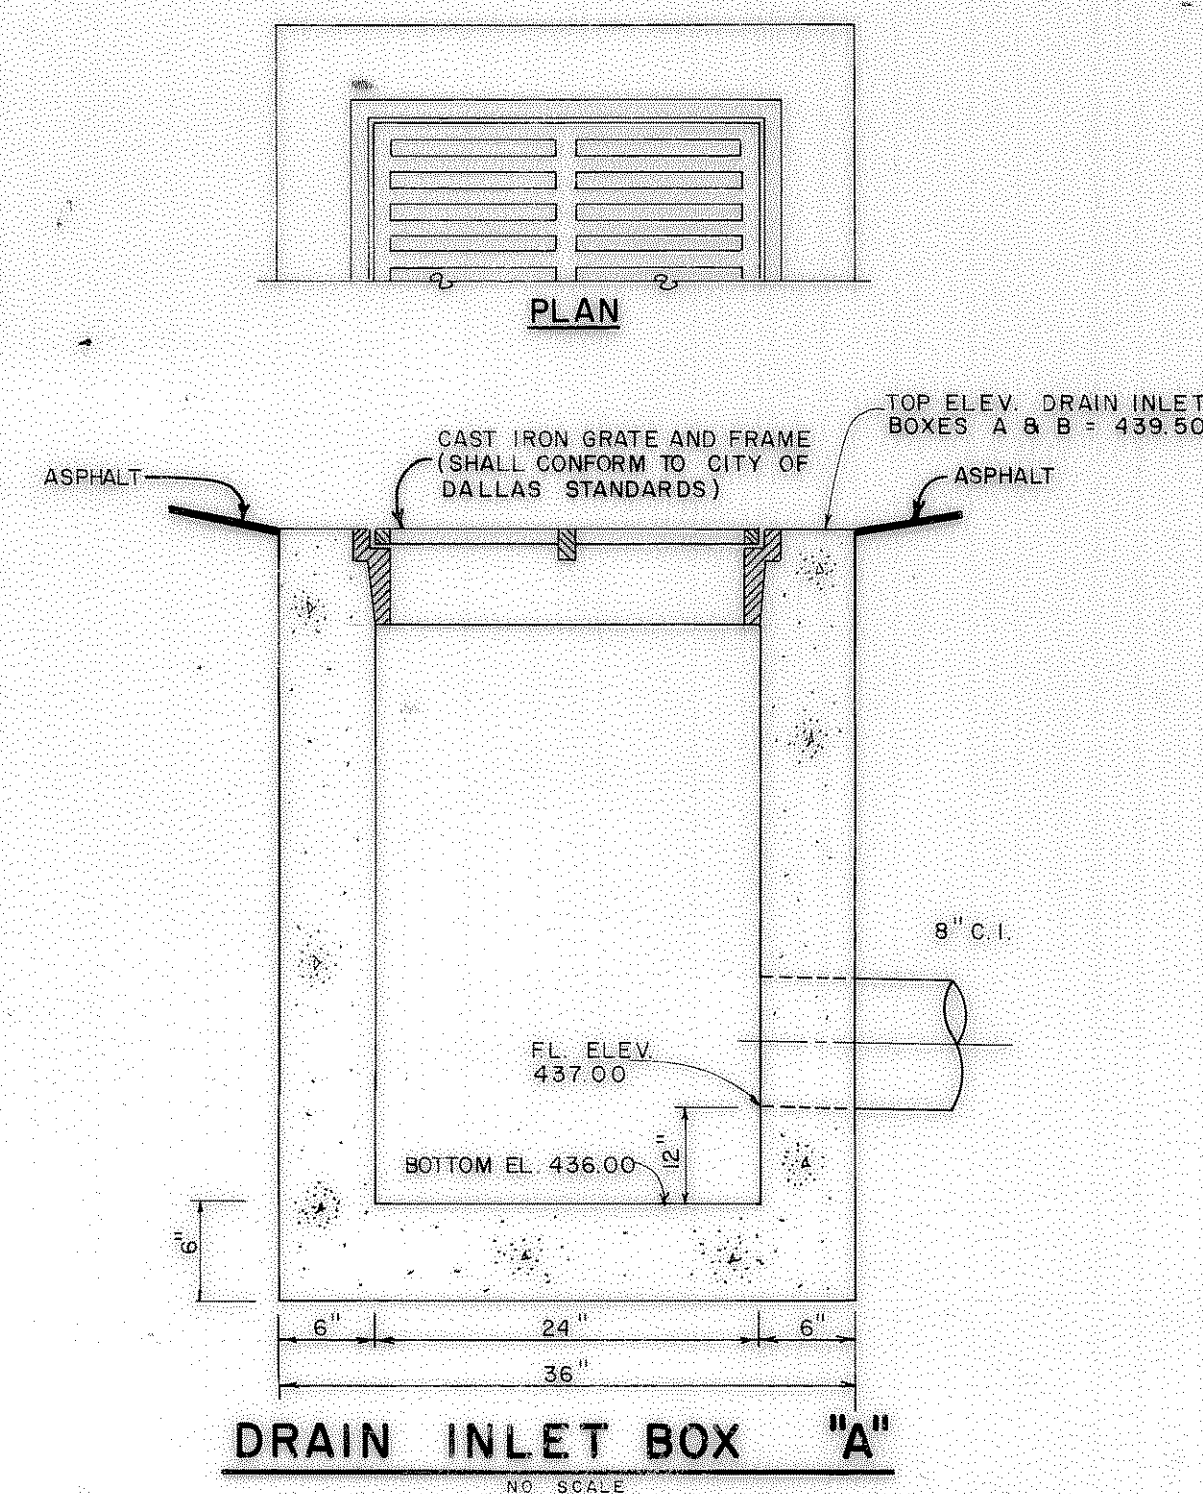


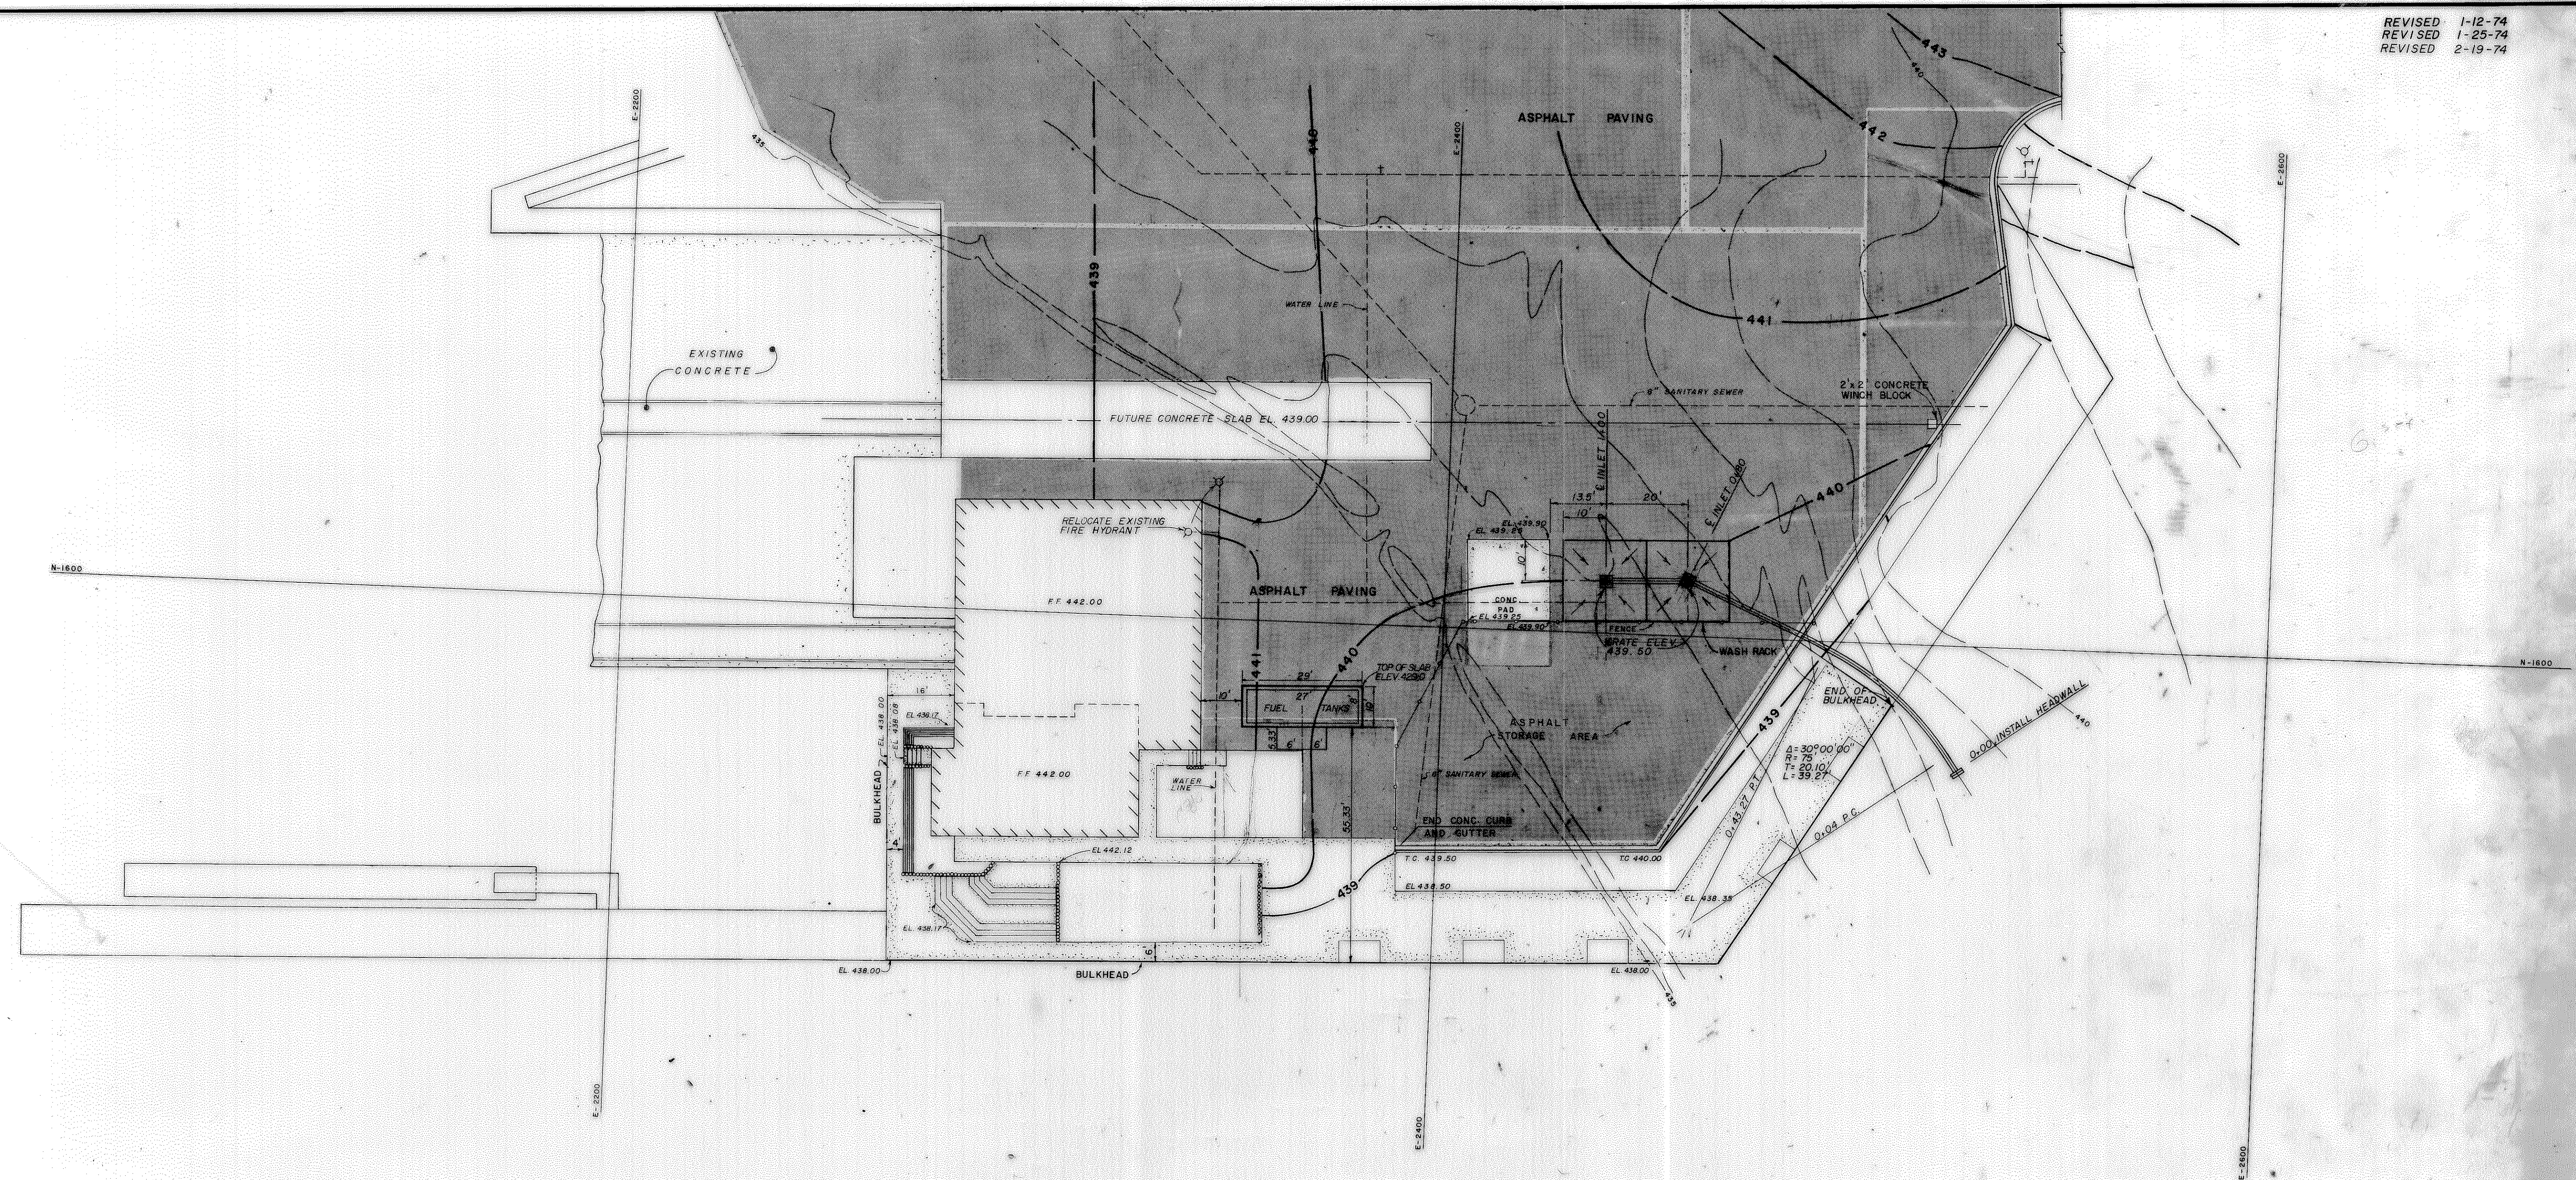

PROFILE
HORIZ. SCALE 1\"/>

AS BUILT

3A

MARINA PARKING LOT				CHANDLERS LANDING	
PHASE ONE					
DESIGN: W. H. W.	DRAWN: E. L. C.	SCALE: 1" = 20'	DATE: AUG. 73	DALLAS	Harold Evans Consulting Engineer 328-8133