

CONSTRUCTION PLANS

FOR

CHASE BANK

HORIZON ROAD (F.M. 3097)

& RALPH HALL PARKWAY


AN ADDITION TO

THE CITY OF ROCKWALL, TEXAS

PREPARED FOR
J.P. MORGAN CHASE BANK
 8111 PRESTON ROAD, SUITE 250
 DALLAS, TX. 75225

ENGINEER
O'DONALD ENGINEERING
 1601 EAST LAMAR BLVD., SUITE 210
 ARLINGTON, TEXAS 76011
 TEL: 817-794-0202
 FAX: 817-548-8430

SURVEYOR
PIBURN PARTNERS, LLC
 3445 HIGHLAND RD., SUITE 205
 DALLAS, TEXAS 75228
 TEL: 214-328-3500
 FAX: 214-328-3512

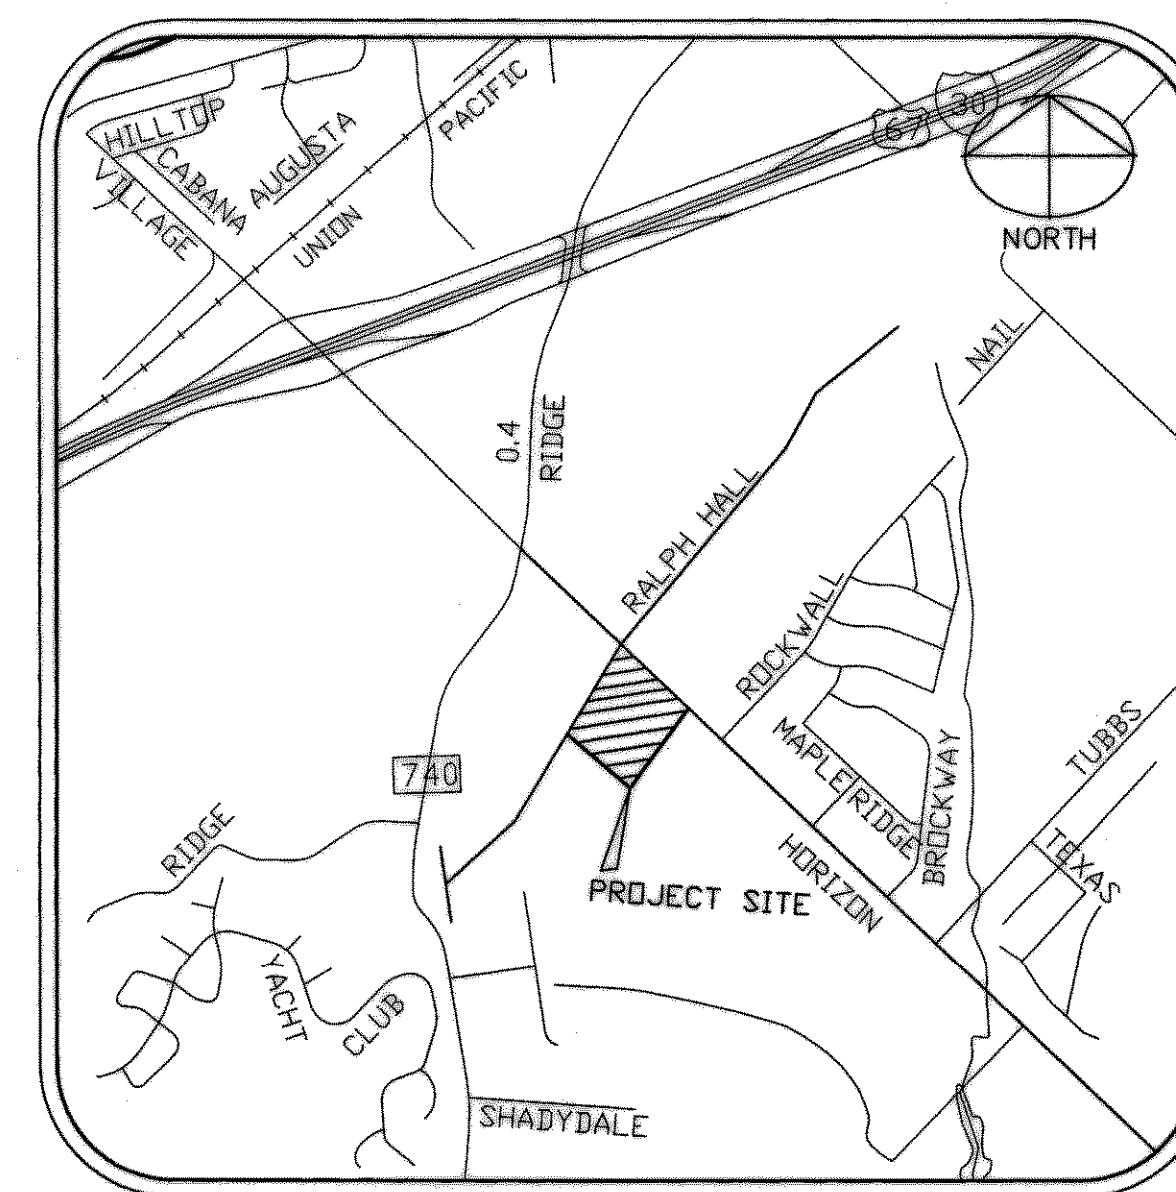

VICINITY MAP
 MAPSCO # NTS

INDEX OF DRAWINGS

	REPLAT
	SITE PLAN
C1	PAVING PLAN
C2	GRADING PLAN
C3	DRAINAGE AREA MAP
C4	STORM SEWER PLAN
C5	WATER & SANITARY SEWER PLAN
C6	EROSION CONTROL PLAN
C7	DETAILS (PRIVATE)
C8	CITY DETAILS

CONTRACTOR TO ONLY UTILIZE CIVIL
 ENGINEERING PLANS STAMPED AS
 APPROVED BY THE CITY OF
 ROCKWALL PUBLIC WORKS
 DEPARTMENT FOR CONSTRUCTION.

AS-BUILT

NOTE:
 THESE PLANS HAVE BEEN REVISED
 TO CONFORM WITH CONSTRUCTION
 RECORDS PROVIDED BY CONTRACTOR.



8-25-08