



- 1. All work shall be in accordance with these plans, City of Rockwall Standards and NCTCOG

- 4. All water lines to have 42 inch minimum cover or as required to clear other utilities.
- Contractor shall use PVC SDR 26 Sewer pipe. PVC pipe shall have a maximum
- 10. Trench excavation for trenches 5 feet or more in depth shall be in accordance with all provisions of Part 1926, Subpart P — Excavations, Trenching and shoring of the Occupational Safety and Health's Standards and Interpretations. It shall be the responsibility of the Contractor to conform to the above stated provisions and to supply
- 11. The locations of all utilities indicated on the plans are taken from available public records. The exact location and depth of all utilities indicated must be determined by the Contractor. It shall be the duty of the Contractor to ascertain whether any
- 12. It shall be the responsibility of the Contractor to protect all existing utilities in the construction of this project. Any utilities damaged during the construction of this project
- 15. Blue EMS locator pads to be installed on the waterline at every bend, service, and valve.
- 16. Fire hydrants shall have 5' clearance around, and min 3' from back of curb.
- Contractor / Plumber shall verify location of utilities exiting building prior to installation
- 18. All storm drain inlets (domed or standard) shall be Nyloplast brand or approved equal.

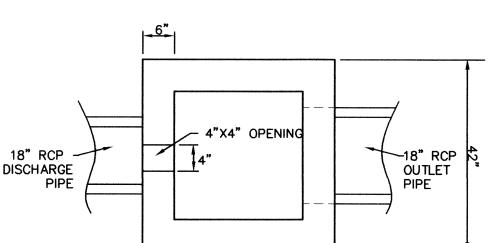

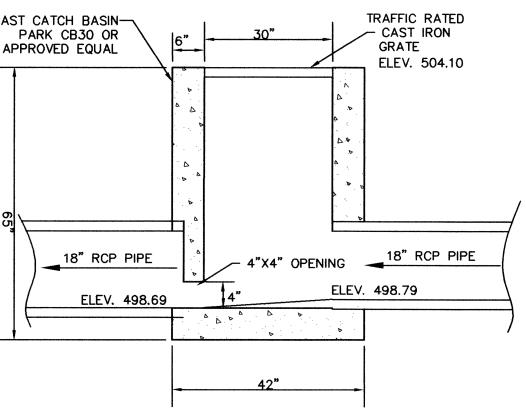

BENCHMARK: NORTHWEAST CORNER OF CURB INLET SOUTH SIDE OF W

ELEV. 501.54

RUSK ST. INLET LOCATED NORTH OF THE NORTHWEST PROPERTY CORNER.

## RECORD DRAWING

IMPROVEMENTS INDICATED ON THESE PLANS WHERE REVISED IN ACCORDANCE WITH THE ASBUILT SURVEY PERFORMED BY JAMES ANDERSON AND PROVIDED TO BENTLEY ENGINEERING, INC. ON 02/14/14.

DATE: FEBRUARY 19, 2014

1855 EMERALD BAY ROCKWALL, TEXAS : PH.214.957.1406

MARC O. BENTLEY 64980 CENSED THE SEAL APPEARING ON THIS DOCUMENT WAS AUTHORIZED BY MARC O. BENTLEY, P.E. NO. 64980 ON 03/02/13

R

~

1"=30' File Name: ROSESITE DEC 2012 Project No.: 2012109

C4