
DEVELOPMENT PLANS

FEATHERSTONE DRIVE EXTENSION

CITY OF ROCKWALL, TEXAS

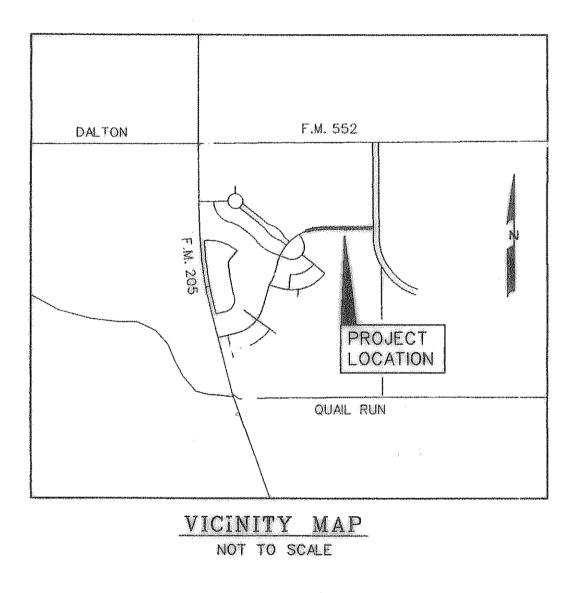

PREPARED FOR

STONE CREEK SF., LTD.

3838 OAK LAWN AVENUE, SUITE 1212, DALLAS, TEXAS 75219

CORWIN ENGINEERING, INC. — CONSULTING ENGINEERS

200 W. BELMONT, SUITE E

.\dgn\09021TJTL.dgn 3/12/2010 9:00:29 AM


TBPE FIRM #5951

ALLEN, TEXAS 75013

INDE>

- 1 117
- 2 DRAINAGE AREA MA
- 3 FEATHERSTONE DRIVE STA. 31+50.00 TO 39+00.0
- 4 FEATHERSTONE DRIVE STA. 39+00.00 TO 46+56.4
- 5 STORM SEWER PLAN AND PROFILE LINES 'D-1' & 'D
- 6 STORM SEWER PLAN AND PROFILES LINES 'D-2', 'D-2A', 'D-4', & 'D-5'
- 7 EROSION CONTROL PLA
- 7A GRADING PLA

AS-BUILT MARCH 2010
BASED ON INFORMATION PROVIDED BY CONTRACTORS
AND VERIFIED BY ON-SITE SURVEYING

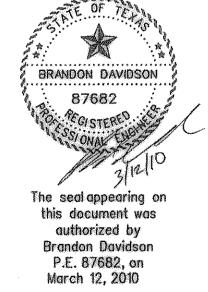

SHALL BE USED FOR REFERENCE.