
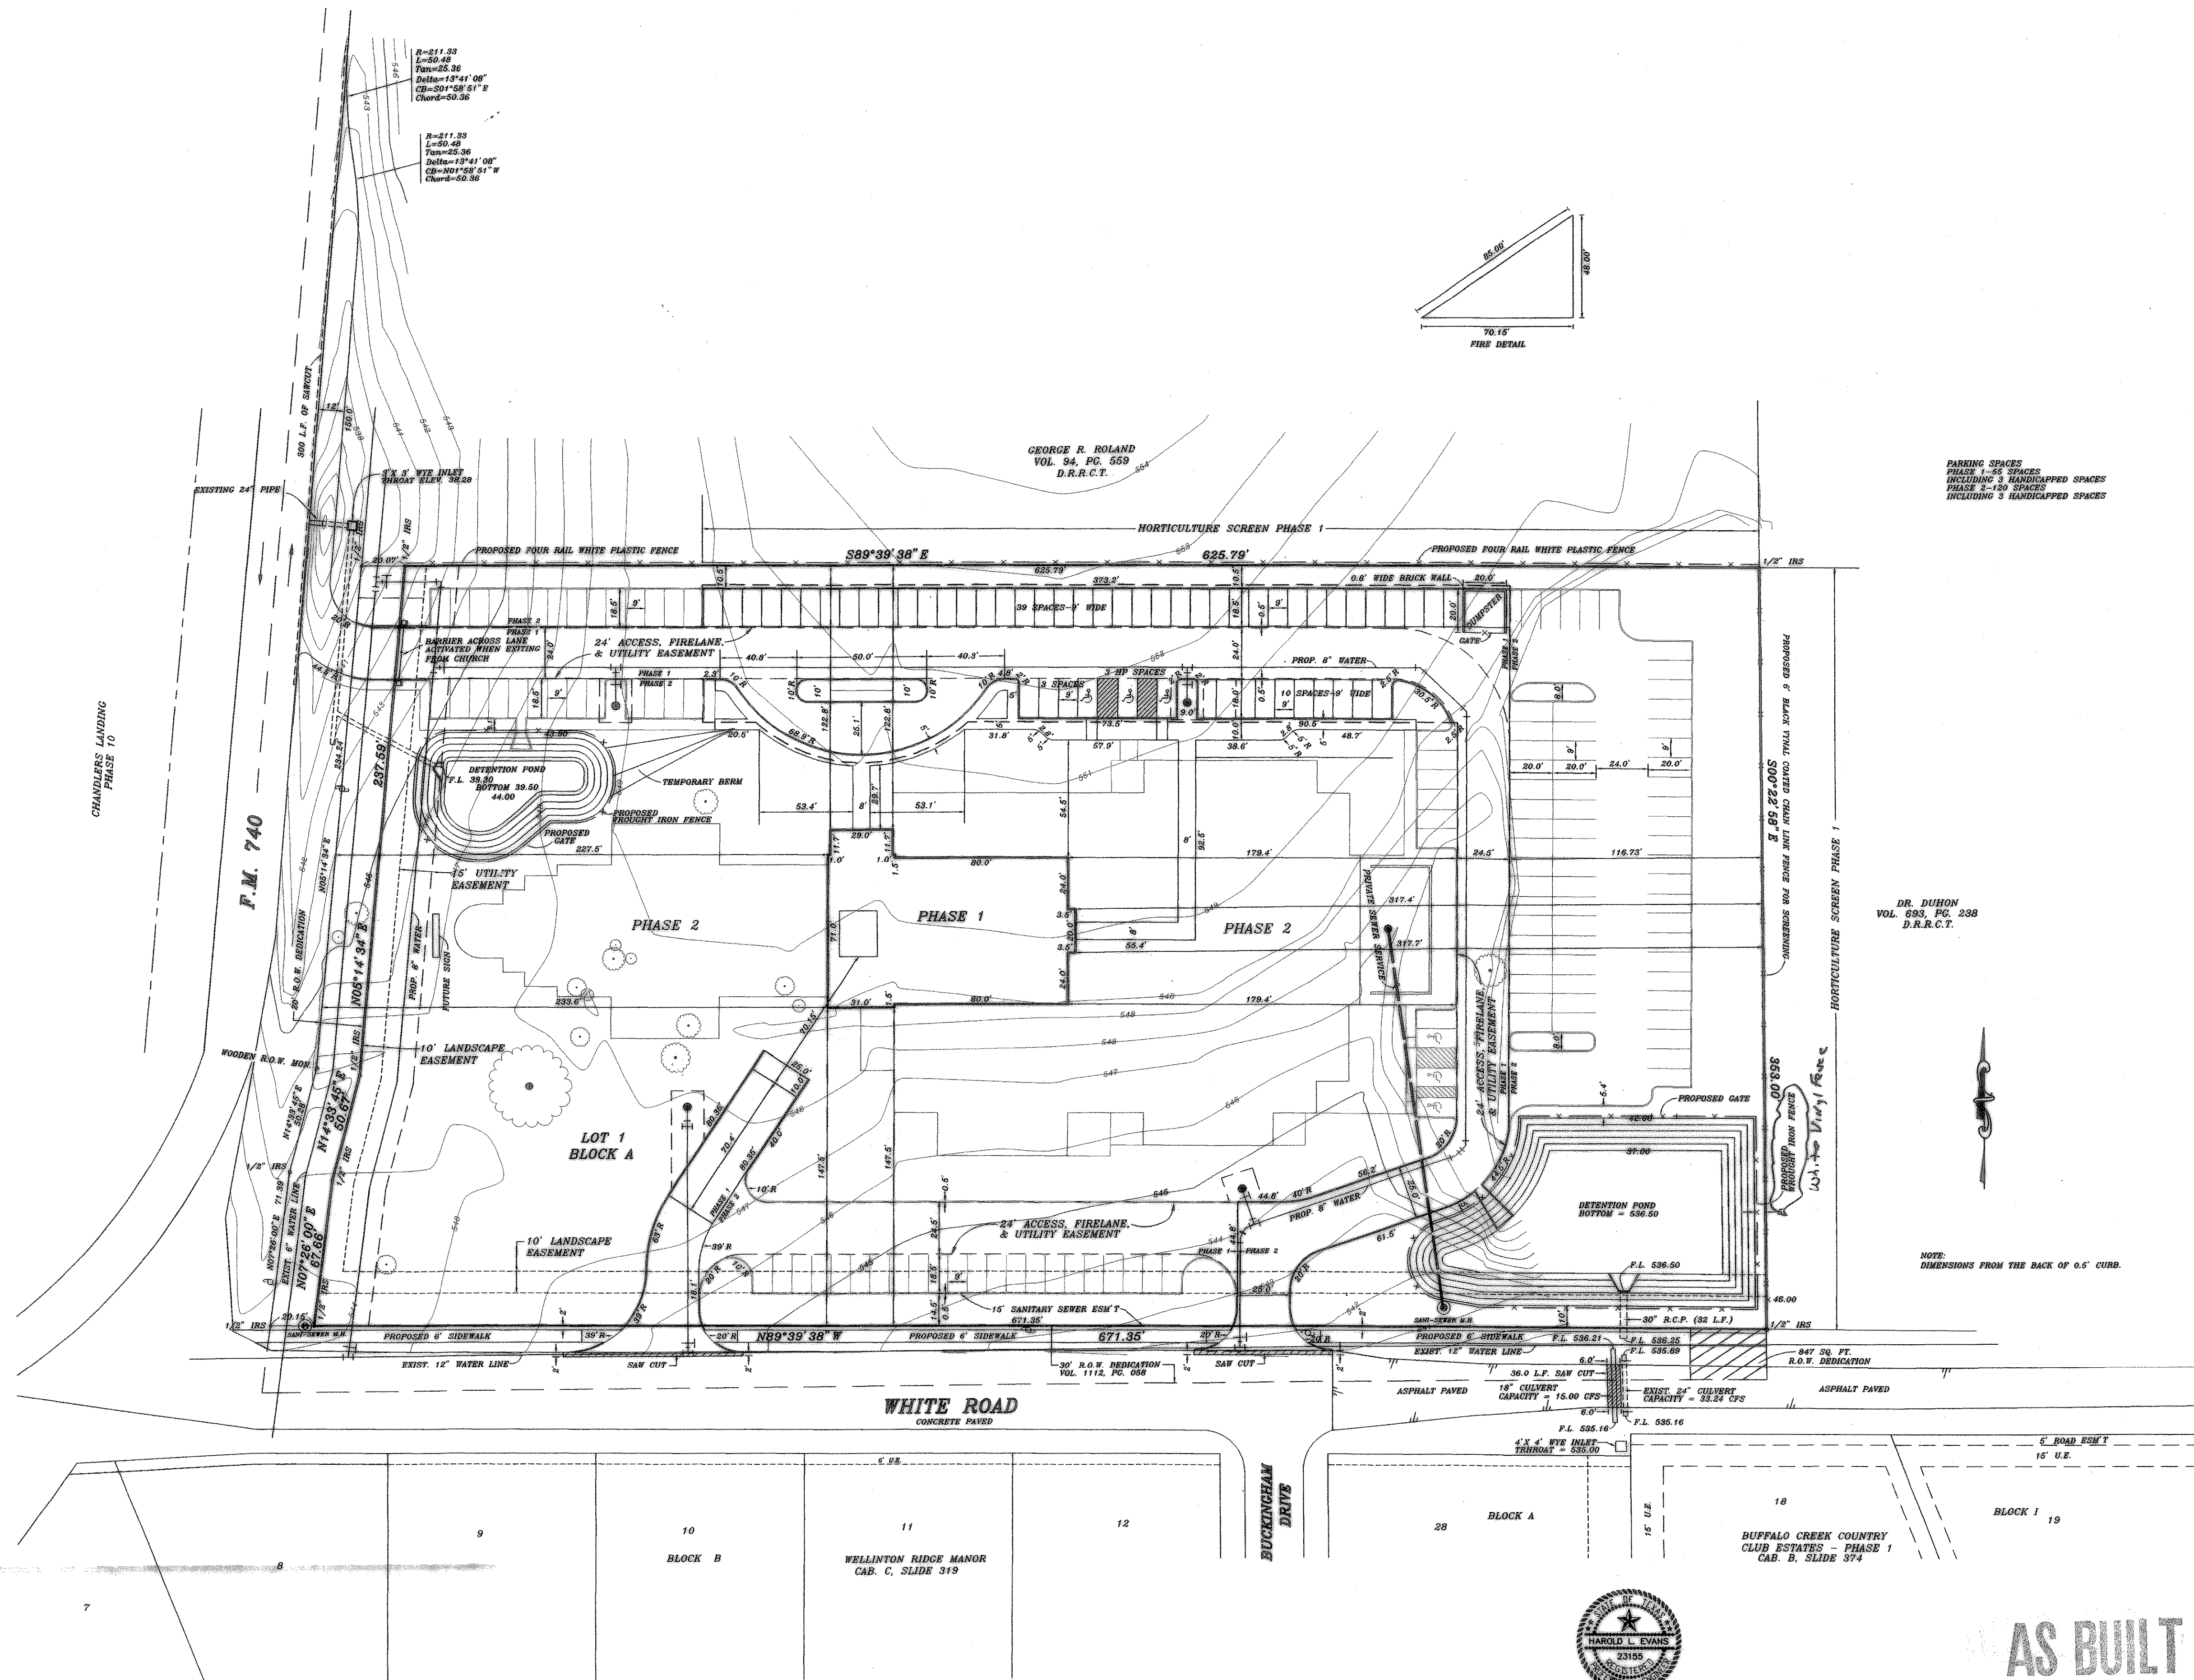



2 YELLOW REFLECTOR BUTTONS
20'
TRAFFIC BUTTON DETAIL

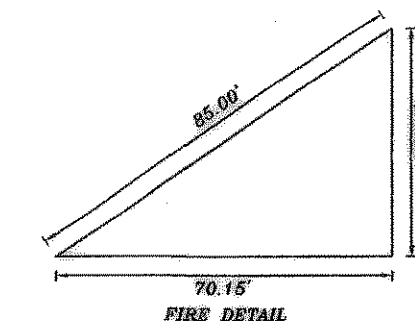

PARKING SPACES
PHASE 1-55 SPACES
INCLUDING 3 HANDICAPPED SPACES
PHASE 2-130 SPACES
INCLUDING 3 HANDICAPPED SPACES

DR. DUHON
VOL. 893, PG. 238
D.R.R.C.T.

NOTE:
DIMENSIONS FROM THE BACK OF 0.5' CURB.

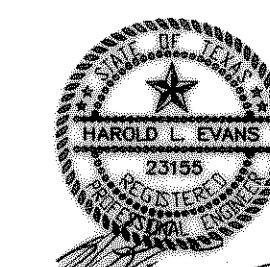

AS BUILT

REVISION PER CITY 7/15/03		HAROLD L. EVANS CONSULTING ENGINEER 2331 CUS THOMASSON ROAD, SUITE 102 DALLAS, TEXAS 75370, (214) 328-8133				SITE AND DIMENSION CONTROL PLAN FIRST CHRISTIAN CHURCH, DISCIPLES OF CHRIST, ROCKWALL, TEXAS ADDITION E. TEAL SURVEY, ABSTRACT NO. 207 CITY OF ROCKWALL		SHEET NO. 3
REVISION DESCRIPTION		DATE	SCALE	DESIGN	DRAWN			JOB NO. 9992
		2/11/03	1" = 40'	H.L.E.	AC			