



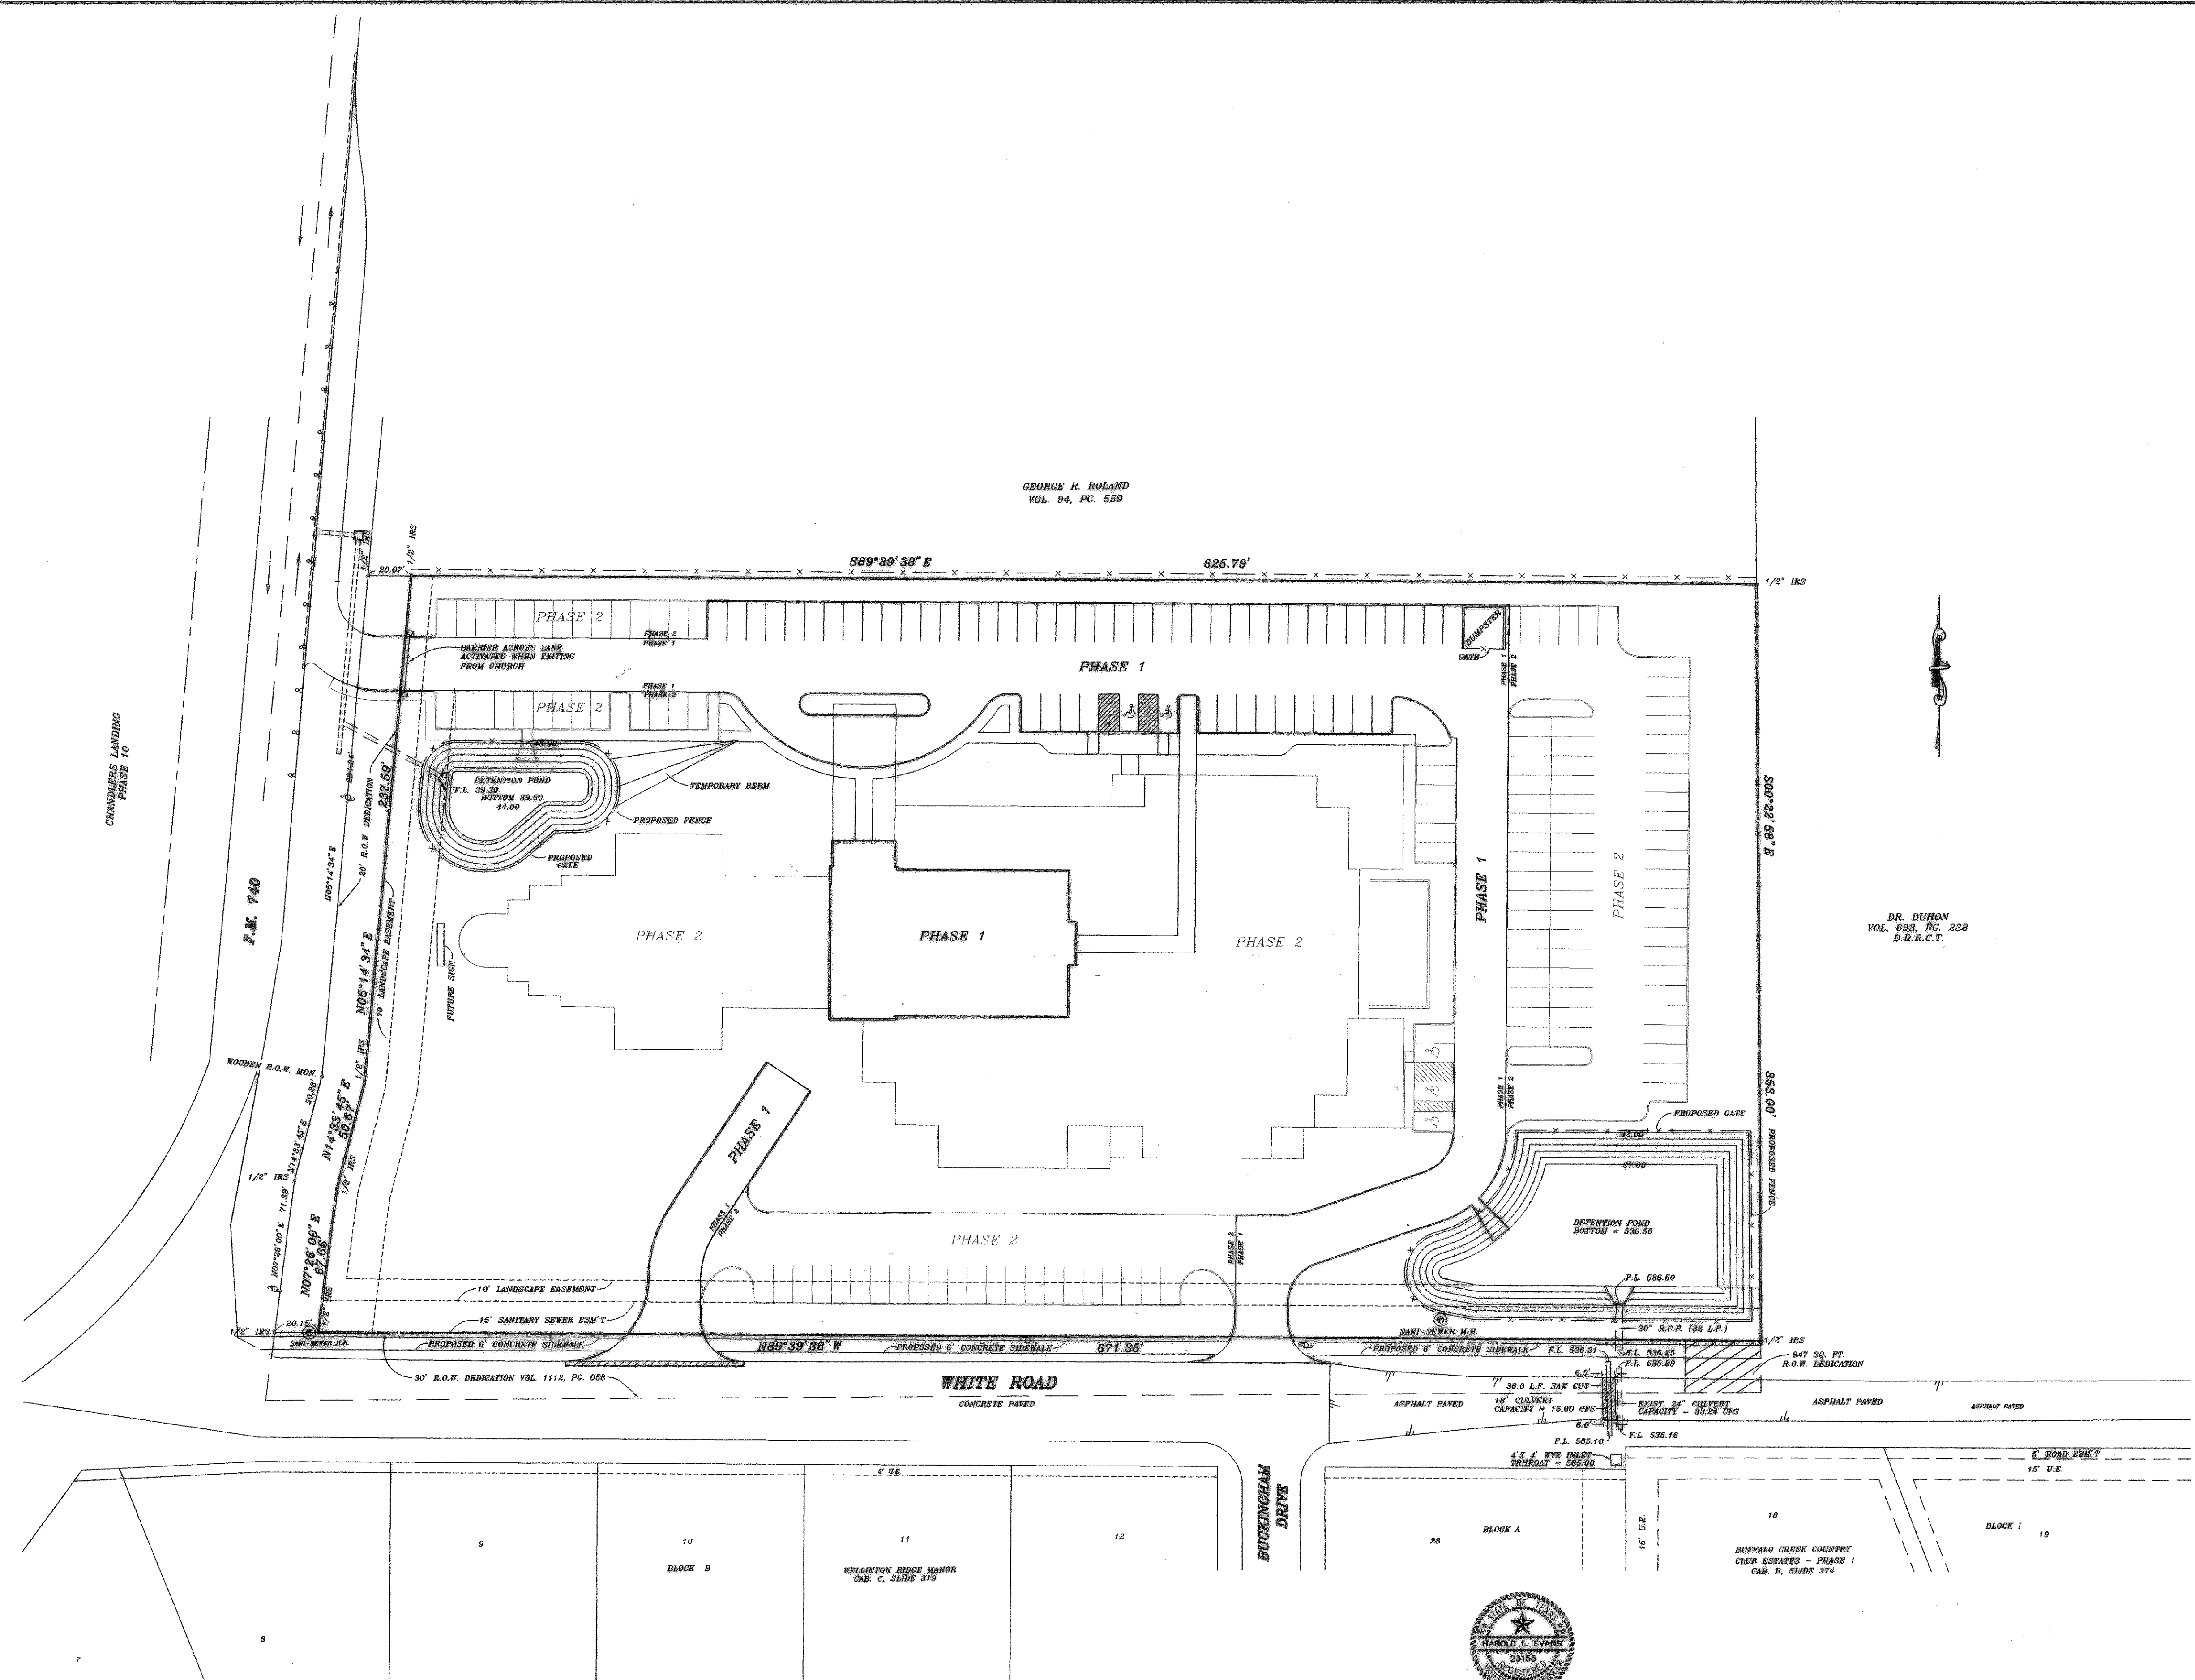

GEORGE R. ROLAND
VOL. 94, PG. 559

DR. DUHON
VOL. 693, PG. 238
D.R.R.C.T.

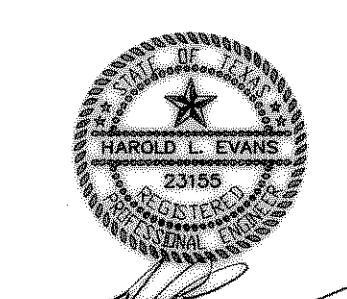

AS BUILT

REVISION PER CITY 7/15/03		HAROLD L. EVANS CONSULTING ENGINEER P.O. BOX 570355 DALLAS, TEXAS 75370, (214) 320-8133		PHASE 1 FIRST CHRISTIAN CHURCH, DISCIPLES OF CHRIST, ROCKWALL, TEXAS ADDITION E. TEAL SURVEY, ABSTRACT NO. 207 CITY OF ROCKWALL	
REVISION DESCRIPTION	DATE	SCALE	DESIGN	DRAWN	SHEET NO.
	2/11/03	1" = 30'	H.L.E.	AC	4
9992 SITE				JOB NO. 9992	