
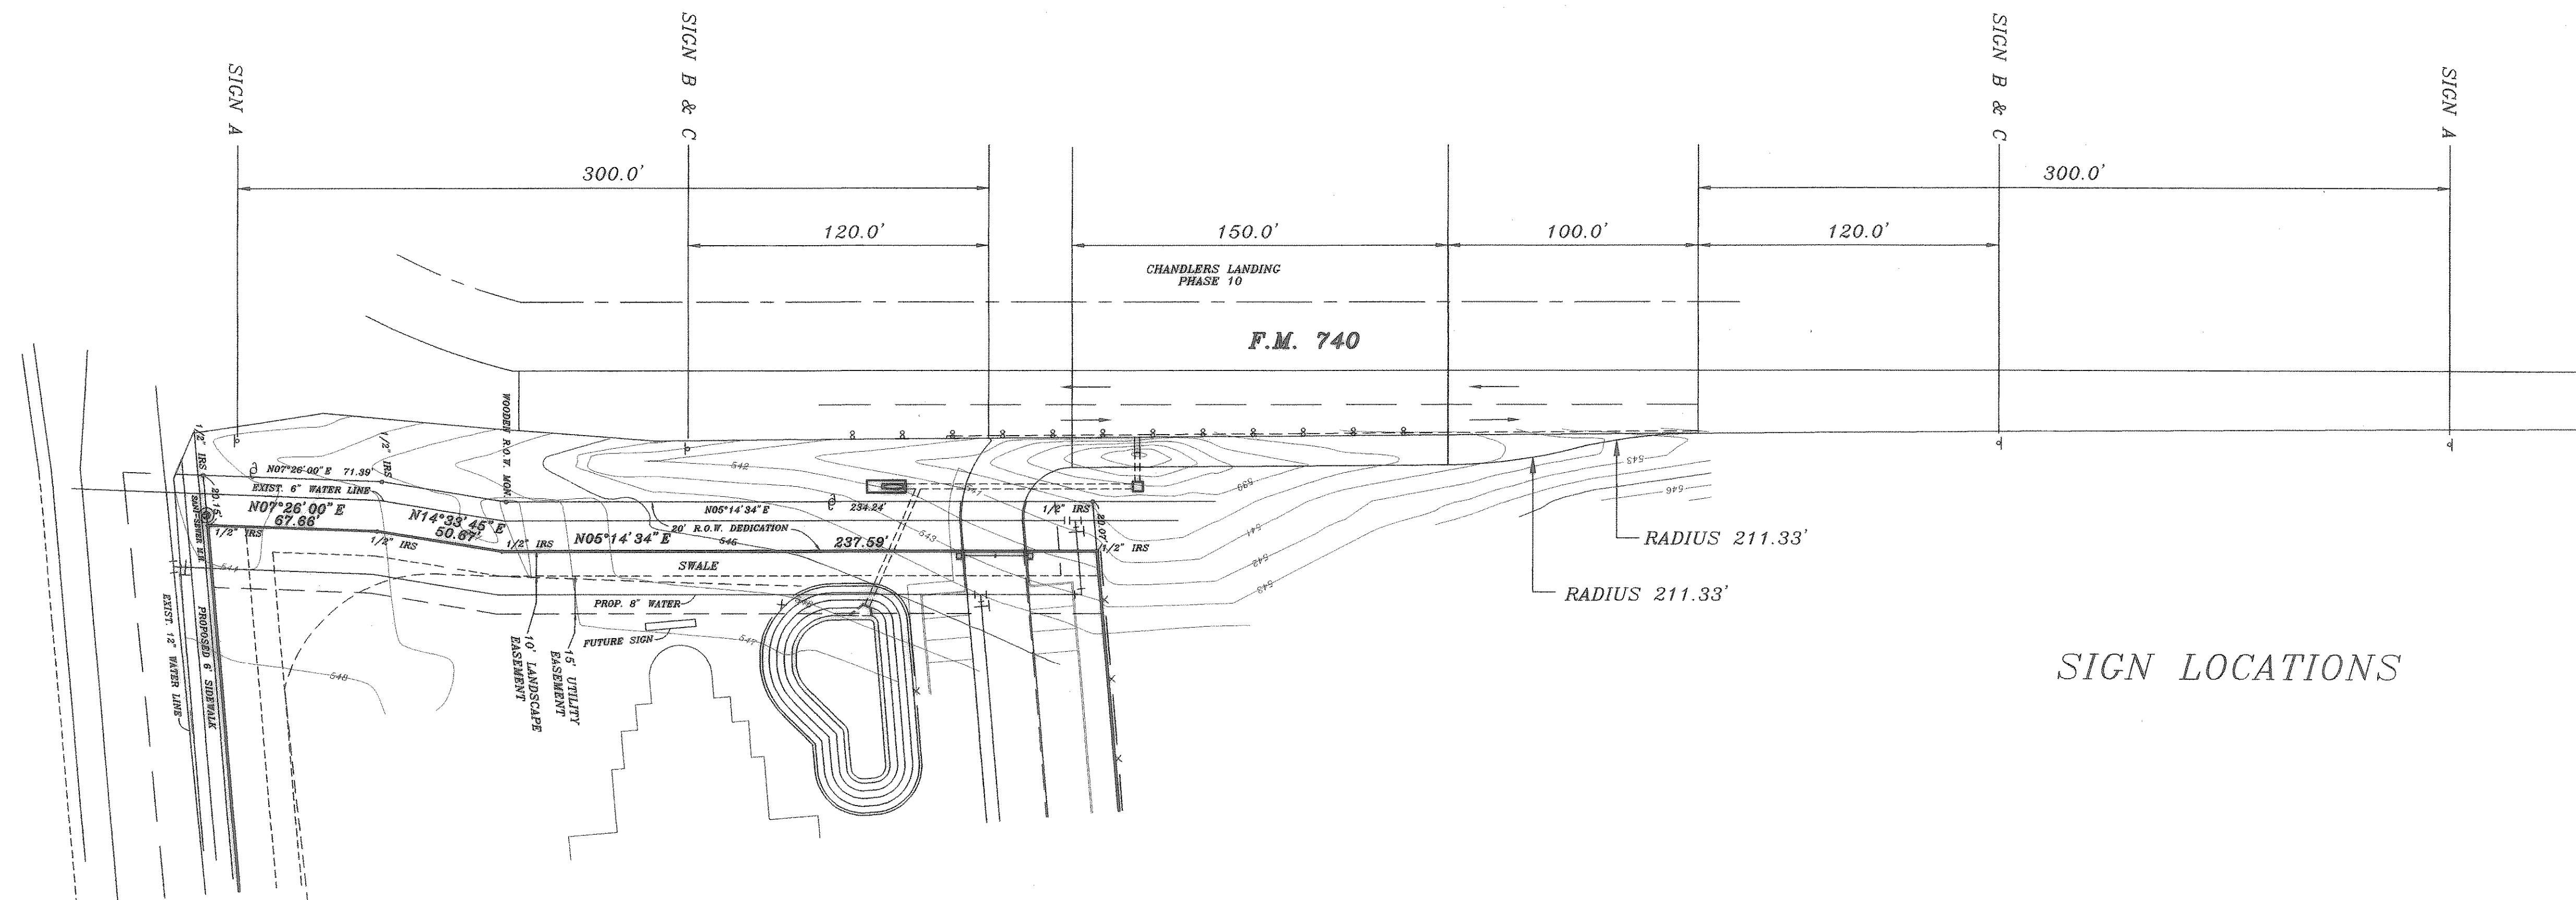
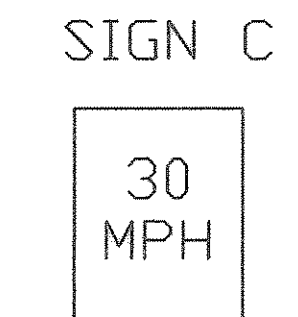
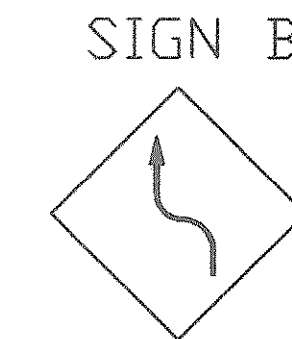
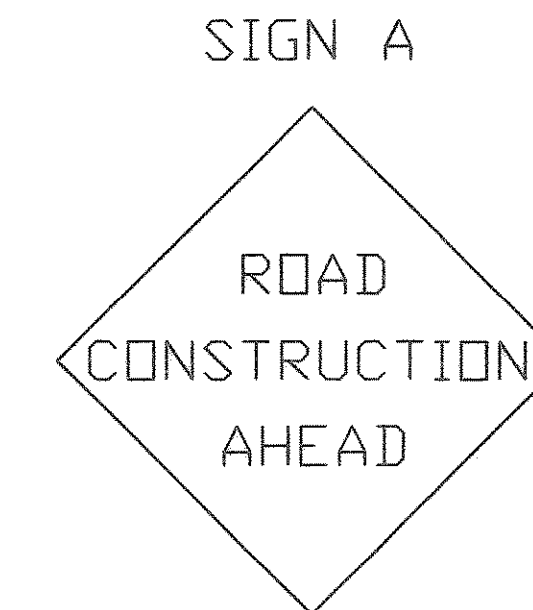


- MATERIAL:**
1. Earth fill compacted to 95% density at optimum moisture content.
 2. 6" thick (compacted) base course conforming to TxDOT (THD) specification 232.
 3. 4" thick asphaltic concrete pavement Type "B" conforming to TxDOT (THD) specification 340.
 4. 2" thick asphaltic concrete pavement Type "D" conforming to TxDOT (THD) specification 340.

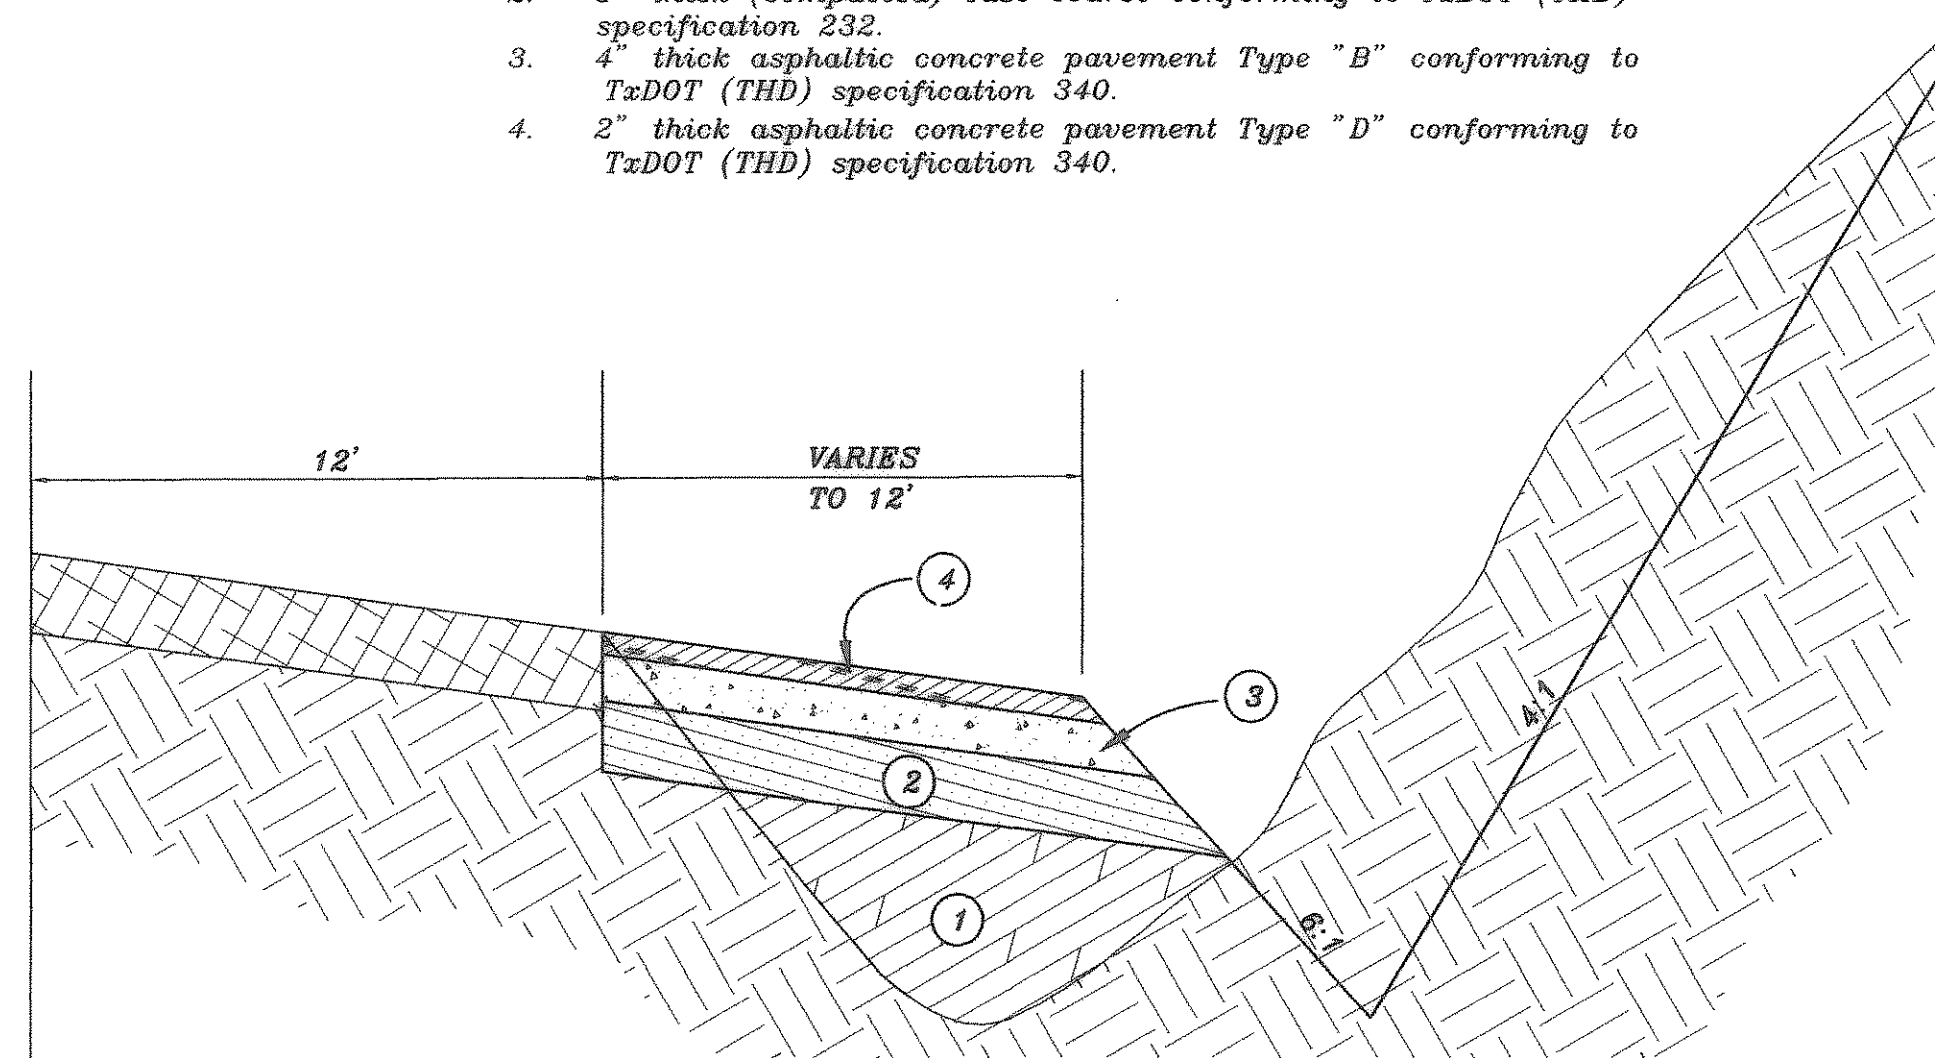

SIGN LOCATIONS

AS BUILT

		HAROLD L. EVANS CONSULTING ENGINEER P.O. BOX 570355 2331 CUS THOMASSON ROAD, SUITE 102 DALLAS, TEXAS 75370. (214) 328-8133		PROPOSED PAVING TRANSITION FIRST CHRISTIAN CHURCH, DISCIPLES OF CHRIST, ROCKWALL, TEXAS ADDITION E. TEAL SURVEY, ABSTRACT NO. 207 CITY OF ROCKWALL		SHEET NO. 10 / 10 JOB NO. 9992	
REVISION DESCRIPTION		DATE	SCALE	DESIGN	DRAWN		
		1/30/04	1" = 40'	H.L.E.	AC		