


SITE CONSTRUCTION PLANS  
FOR  
FIRST UNITED METHODIST CHURCH  
of ROCKWALL

PHASE 3  
GRADING, PAVING, DRAINAGE, WATER, & SANITARY SEWER

ALL RESPONSIBILITY FOR ADEQUACY OF DESIGN  
REMAINS WITH THE DESIGN ENGINEER. THE CITY OF  
ROCKWALL, IN REVIEWING AND RELEASING PLANS  
FOR CONSTRUCTION, ASSUMES NO RESPONSIBILITY  
FOR ADEQUACY OR ACCURACY OF DESIGN.

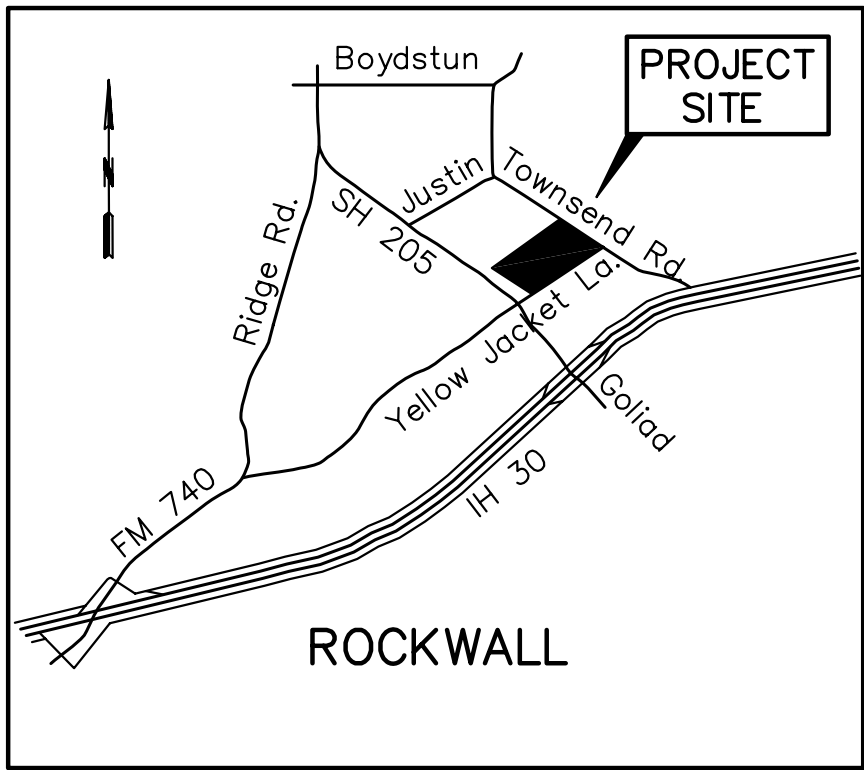

LOCATION MAP  
1" = 0.5 miles

First United Methodist Church Addition  
Block 1, Lots 7 and 8  
Mapsc0 Map 20C,Z  
Est. Start Date: January 2015

SHEET INDEX	
NO.	DESCRIPTION
1	TITLE
	REPLAT (3 Sheets)
	SITE PLAN
	LANDSCAPE PLAN
2	DIMENSIONAL CONTROL
3	DEMOLITION PLAN
4	GRADING/PAVING PLAN
5	DRAINAGE AREA MAP
6	STORM SEWER PLAN
7	STORM SEWER PROFILE
8	WATER & SEWER PLAN/PROFILE
9	WATER & SEWER NOTES
10	GRADING & PAVING DETAILS
11	EROSION CONTROL PLAN
12	EROSION CONTROL DETAILS
13	GAS and ELECTRIC SERVICE

AS BUILT  
November 30, 2015

1  
13


DEVELOPED BY:

FIRST UNITED METHODIST CHURCH  
of ROCKWALL

1200 E. Yellow Jacket Lane  
Rockwall, Texas 75087  
(972) 771-5500

SPECIFICATIONS:

3rd Edition NCTCOG Standard Specifications for  
Public Works Construction and City of Rockwall  
Specifications and Standards.

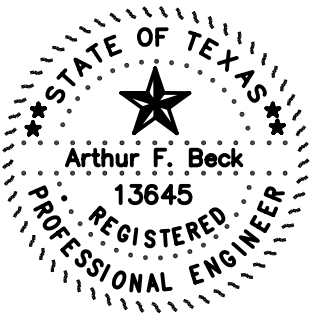

Arthur F. Beck



Consulting  
Civil  
Engineers  
TBPE # 684

4111 East U.S. Hwy. 80, Suite 405  
Mesquite, Texas 75150  
(972) 681-4680

bsm2@cawb.com