


N 47° 57' 52" E 1,098.07'

LEGEND

Utility Pole	572.62	Curb	E	Electric Line
Fire Hydrant	IRF	Spot Elevation	G	Gas Line
Street Light	CIRS	Iron Rod Found	TEL	Telephone Line
Water Meter		Copper Iron Rod Set	10" W	Water Main
Sanitary Sewer Manhole	580	Property Line	8" SS	Sanitary Sewer
Water Valve	575	Existing Contour	15" SD	Storm Sewer
Cleanout		Proposed Contour		
		Bench Mark		

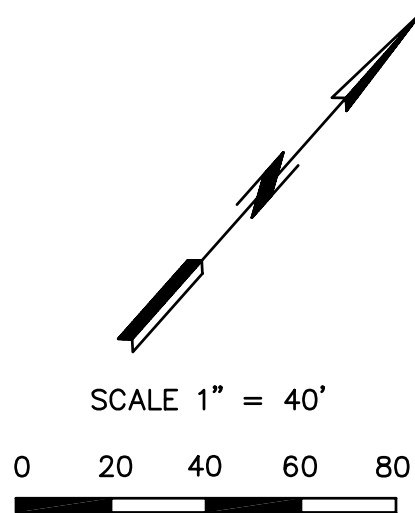

BENCH MARK

Finished Floor at West Entrance as shown by "●"
Elevation = 584.39

NOTES

Coordinates and dimensions are to FACE OF CURB.

Use 2 CONTROL POINTS and coordinates for layout purposes.

Contractor can be furnished a Auto CAD R14 electronic file of drawings for layout purposes.

For layout problems, call Fritz Beck at BSM Engineers, 972-681-4680.

For layout of Storm Sewer, Water Lines, Sanitary Sewer, and Detention Pond, see plan sheets for these utilities.


No	North	East
1	10,285.35N	10,274.39E
2	10,586.71N	10,006.78E
3	10,761.86N	10,204.02E
4	10,700.31N	10,258.02E
5	10,684.49N	10,239.98E
6	10,705.19N	10,221.81E
7	10,707.84N	10,179.34E
8	10,604.62N	10,063.10E
9	10,562.27N	10,060.58E
10	10,532.35N	10,087.15E
11	10,544.47N	10,103.81E
12	10,497.36N	10,145.64E
13	10,482.21N	10,131.69E
14	10,476.02N	10,145.00E
15	10,473.44N	10,188.59E
16	10,466.75N	10,202.36E
17	10,442.55N	10,223.86E
18	10,428.09N	10,228.87E
19	10,384.49N	10,226.28E
20	10,346.96N	10,261.78E
21	10,301.22N	10,292.40E
22	10,442.61N	10,179.27E
23	10,422.47N	10,197.16E

SPECIFICATIONS

3rd Edition NCTCOG Standard Specifications for Public Works Construction and City of Rockwall Specifications and Standards.

ROCKWALL COURT HOUSE

AS BUILT
November 30, 2015

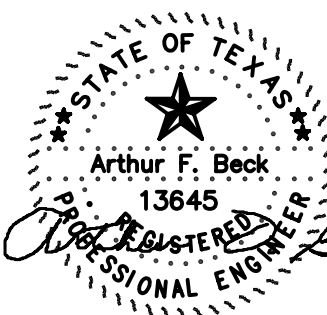

PHASE 3						
DIMENSIONAL CONTROL						
FIRST UNITED METHODIST CHURCH						
ROCKWALL						
CITY OF ROCKWALL, TEXAS						
BSM ENGINEERS, Inc.						
DESIGN	DRAWN	DATE	SCALE	NOTES	FILE	NO
BSM	BSM	07-14	1"=40'	BSM		1404