

N 47° 57' 52" E 1,098.07'

LEGEND


	Utility Pole		Curb		Electric Line
	Fire Hydrant		Spot Elevation		Gas Line
	Street Light		Iron Rod Found		Telephone Line
	Water Meter		Copper Iron Rod Set		Water Main
	Sanitary Sewer Manhole		Property Line		Sanitary Sewer
	Water Valve		Existing Contour		Storm Sewer
	Cleanout		Proposed Contour		
			Bench Mark		

NOTES

- For additional layout information, see Dimensional Control Sheet.
- Storm sewer pipe shall be HDPE pipe or RCP as specified.
- Embedment for "Private" pipes shall be 1/4" crushed rock starting 3 inches below pipe flow line and extending half way up sides of pipe. Use City of Rockwall Standards and NCTCOG 3rd Edition for "Public" RCP.
- Pipe bends and connections shall be manufactured fittings by pipe supplier.
- Pipe profiles are on Storm Sewer Profile sheet.
- Construction notes are on Water & Sewer Notes sheet.

SCALE 1" = 40'

0 20 40 60 80

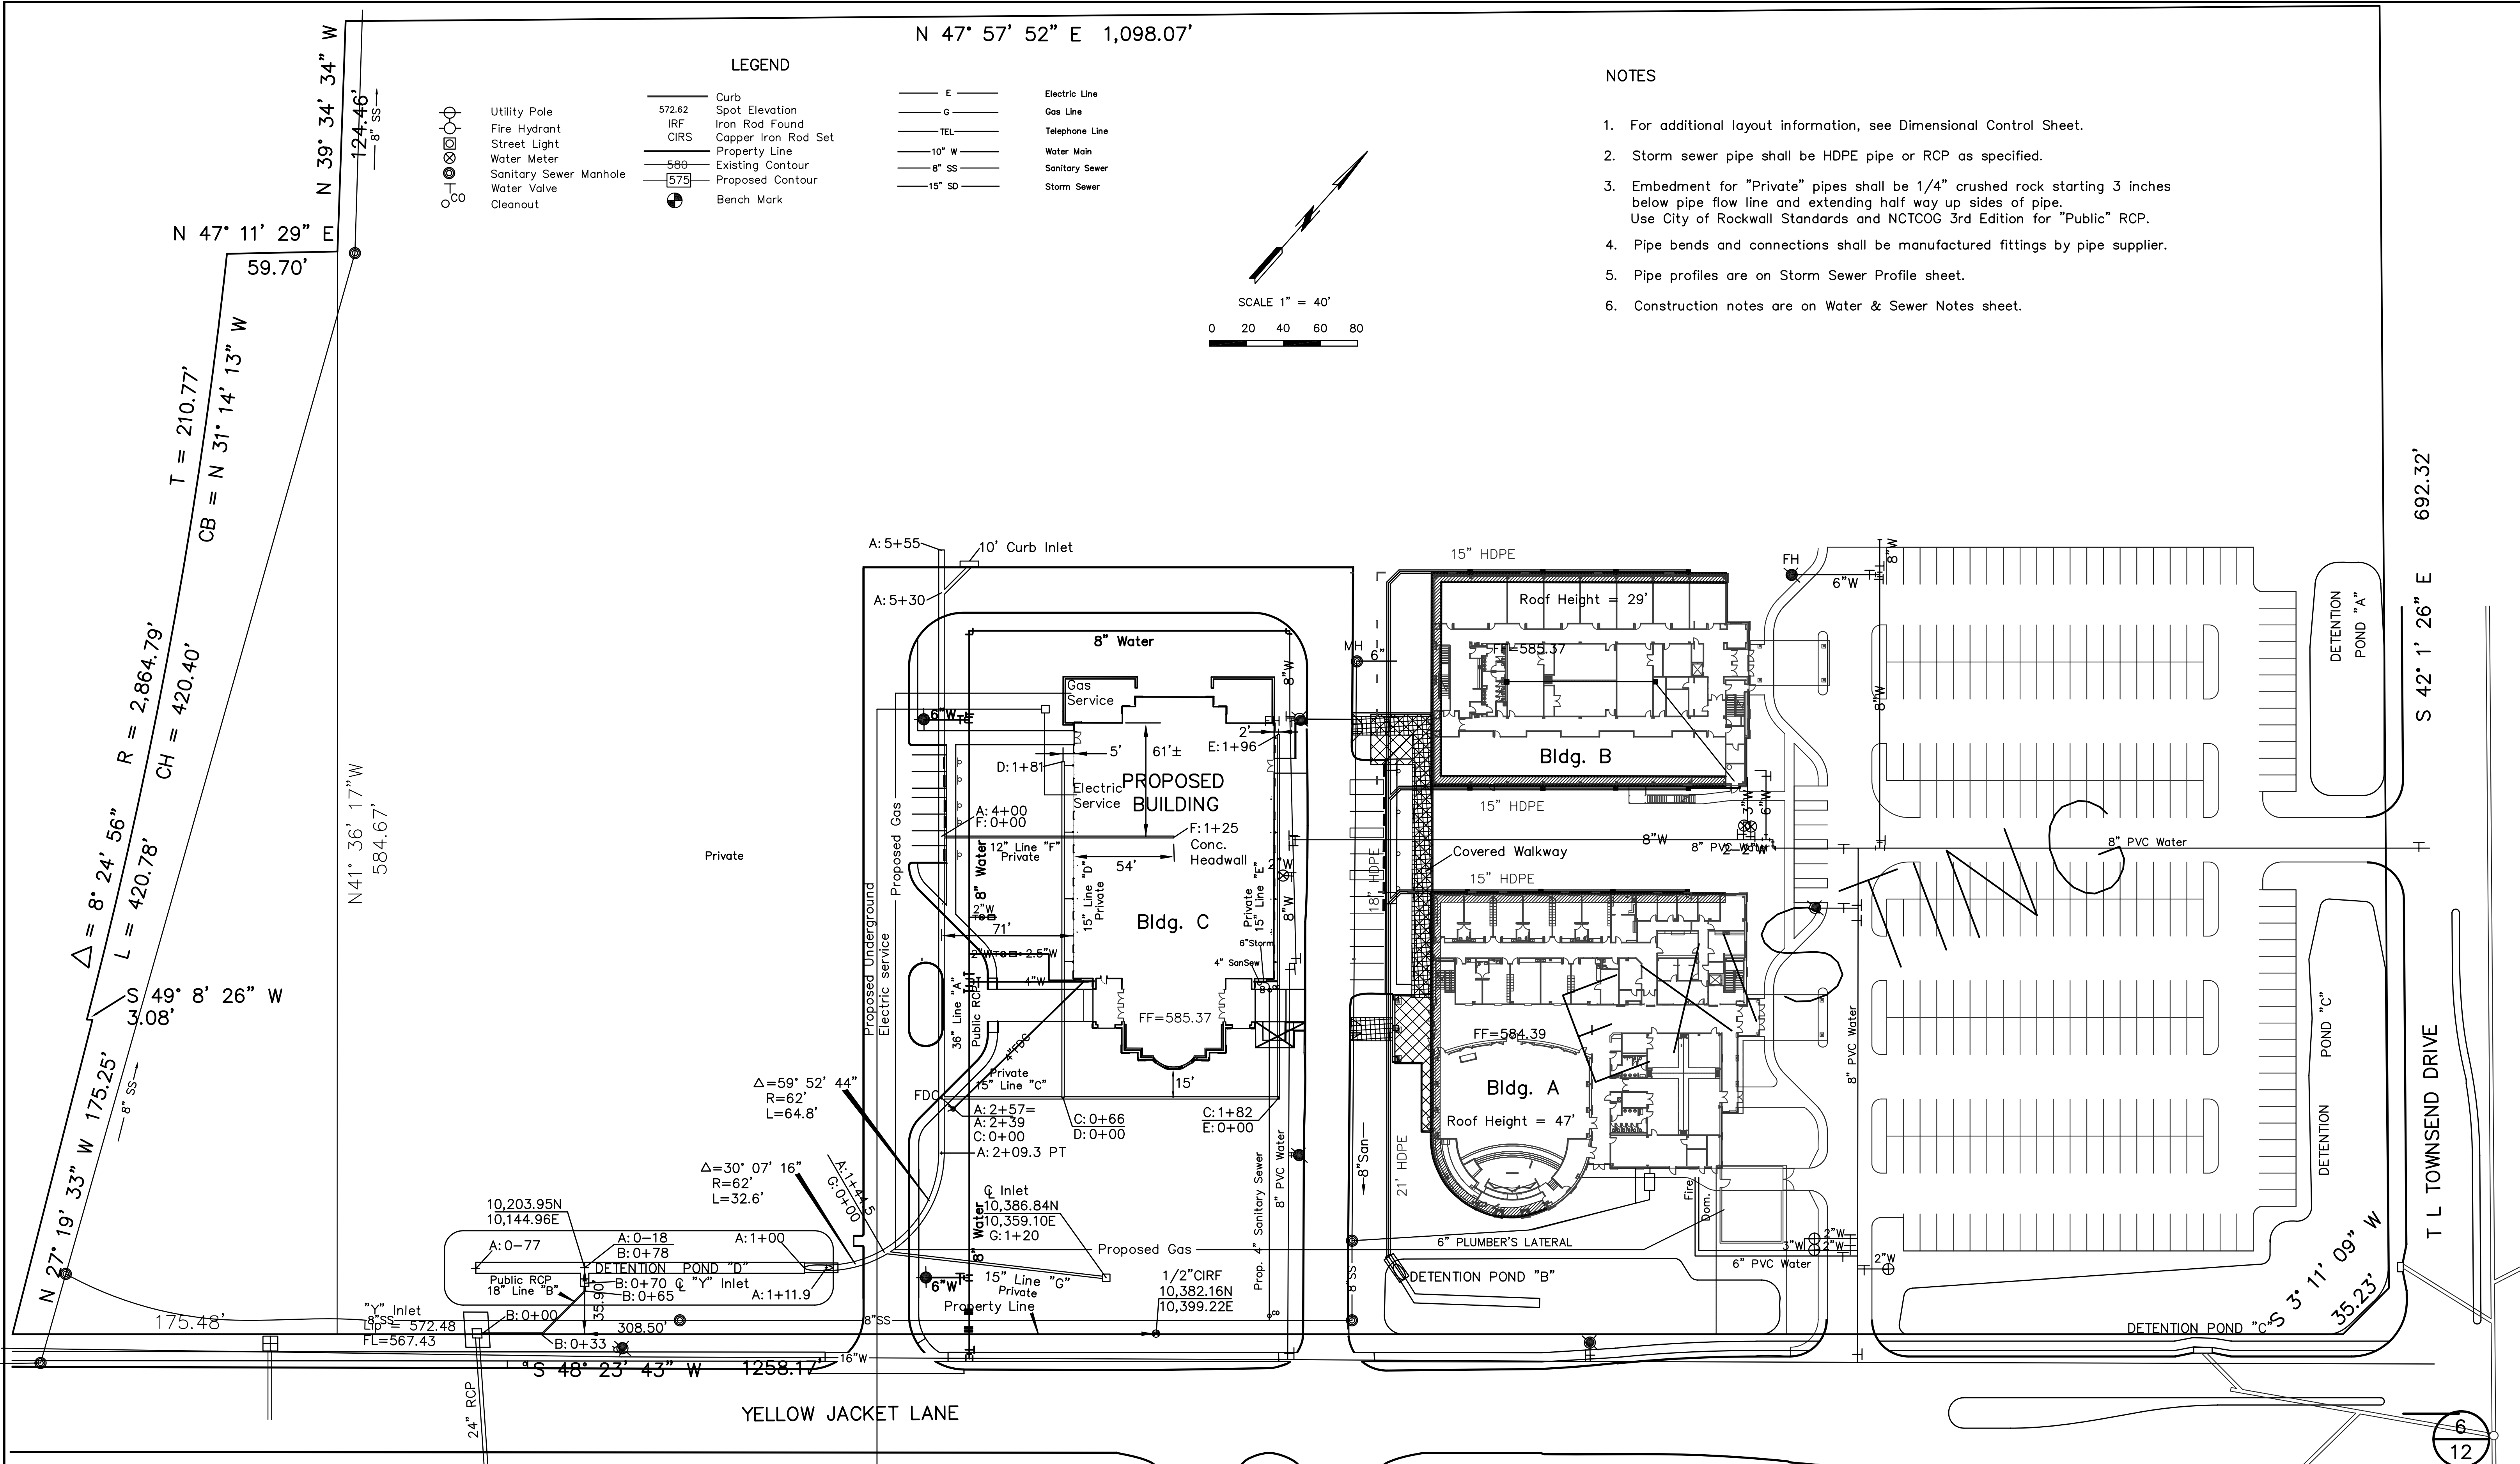


SPECIFICATIONS

3rd Edition NCTCOG Standard Specifications for Public Works Construction and City of Rockwall Specifications and Standards.

ROCKWALL COURT HOUSE

AS BUILT
November 30, 2015

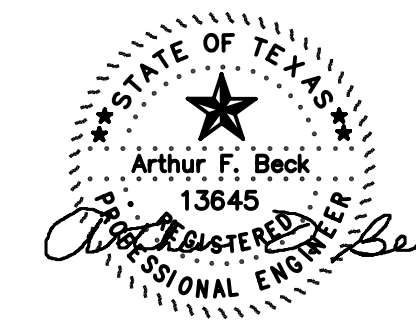

PHASE 3						
STORM SEWER PLAN						
FIRST UNITED METHODIST CHURCH						
ROCKWALL						
CITY OF ROCKWALL, TEXAS						
BSM ENGINEERS, Inc.						
DESIGN	DRAWN	DATE	SCALE	NOTES	FILE	NO
BSM	BSM	07-14	1"=40'	BSM		1404