


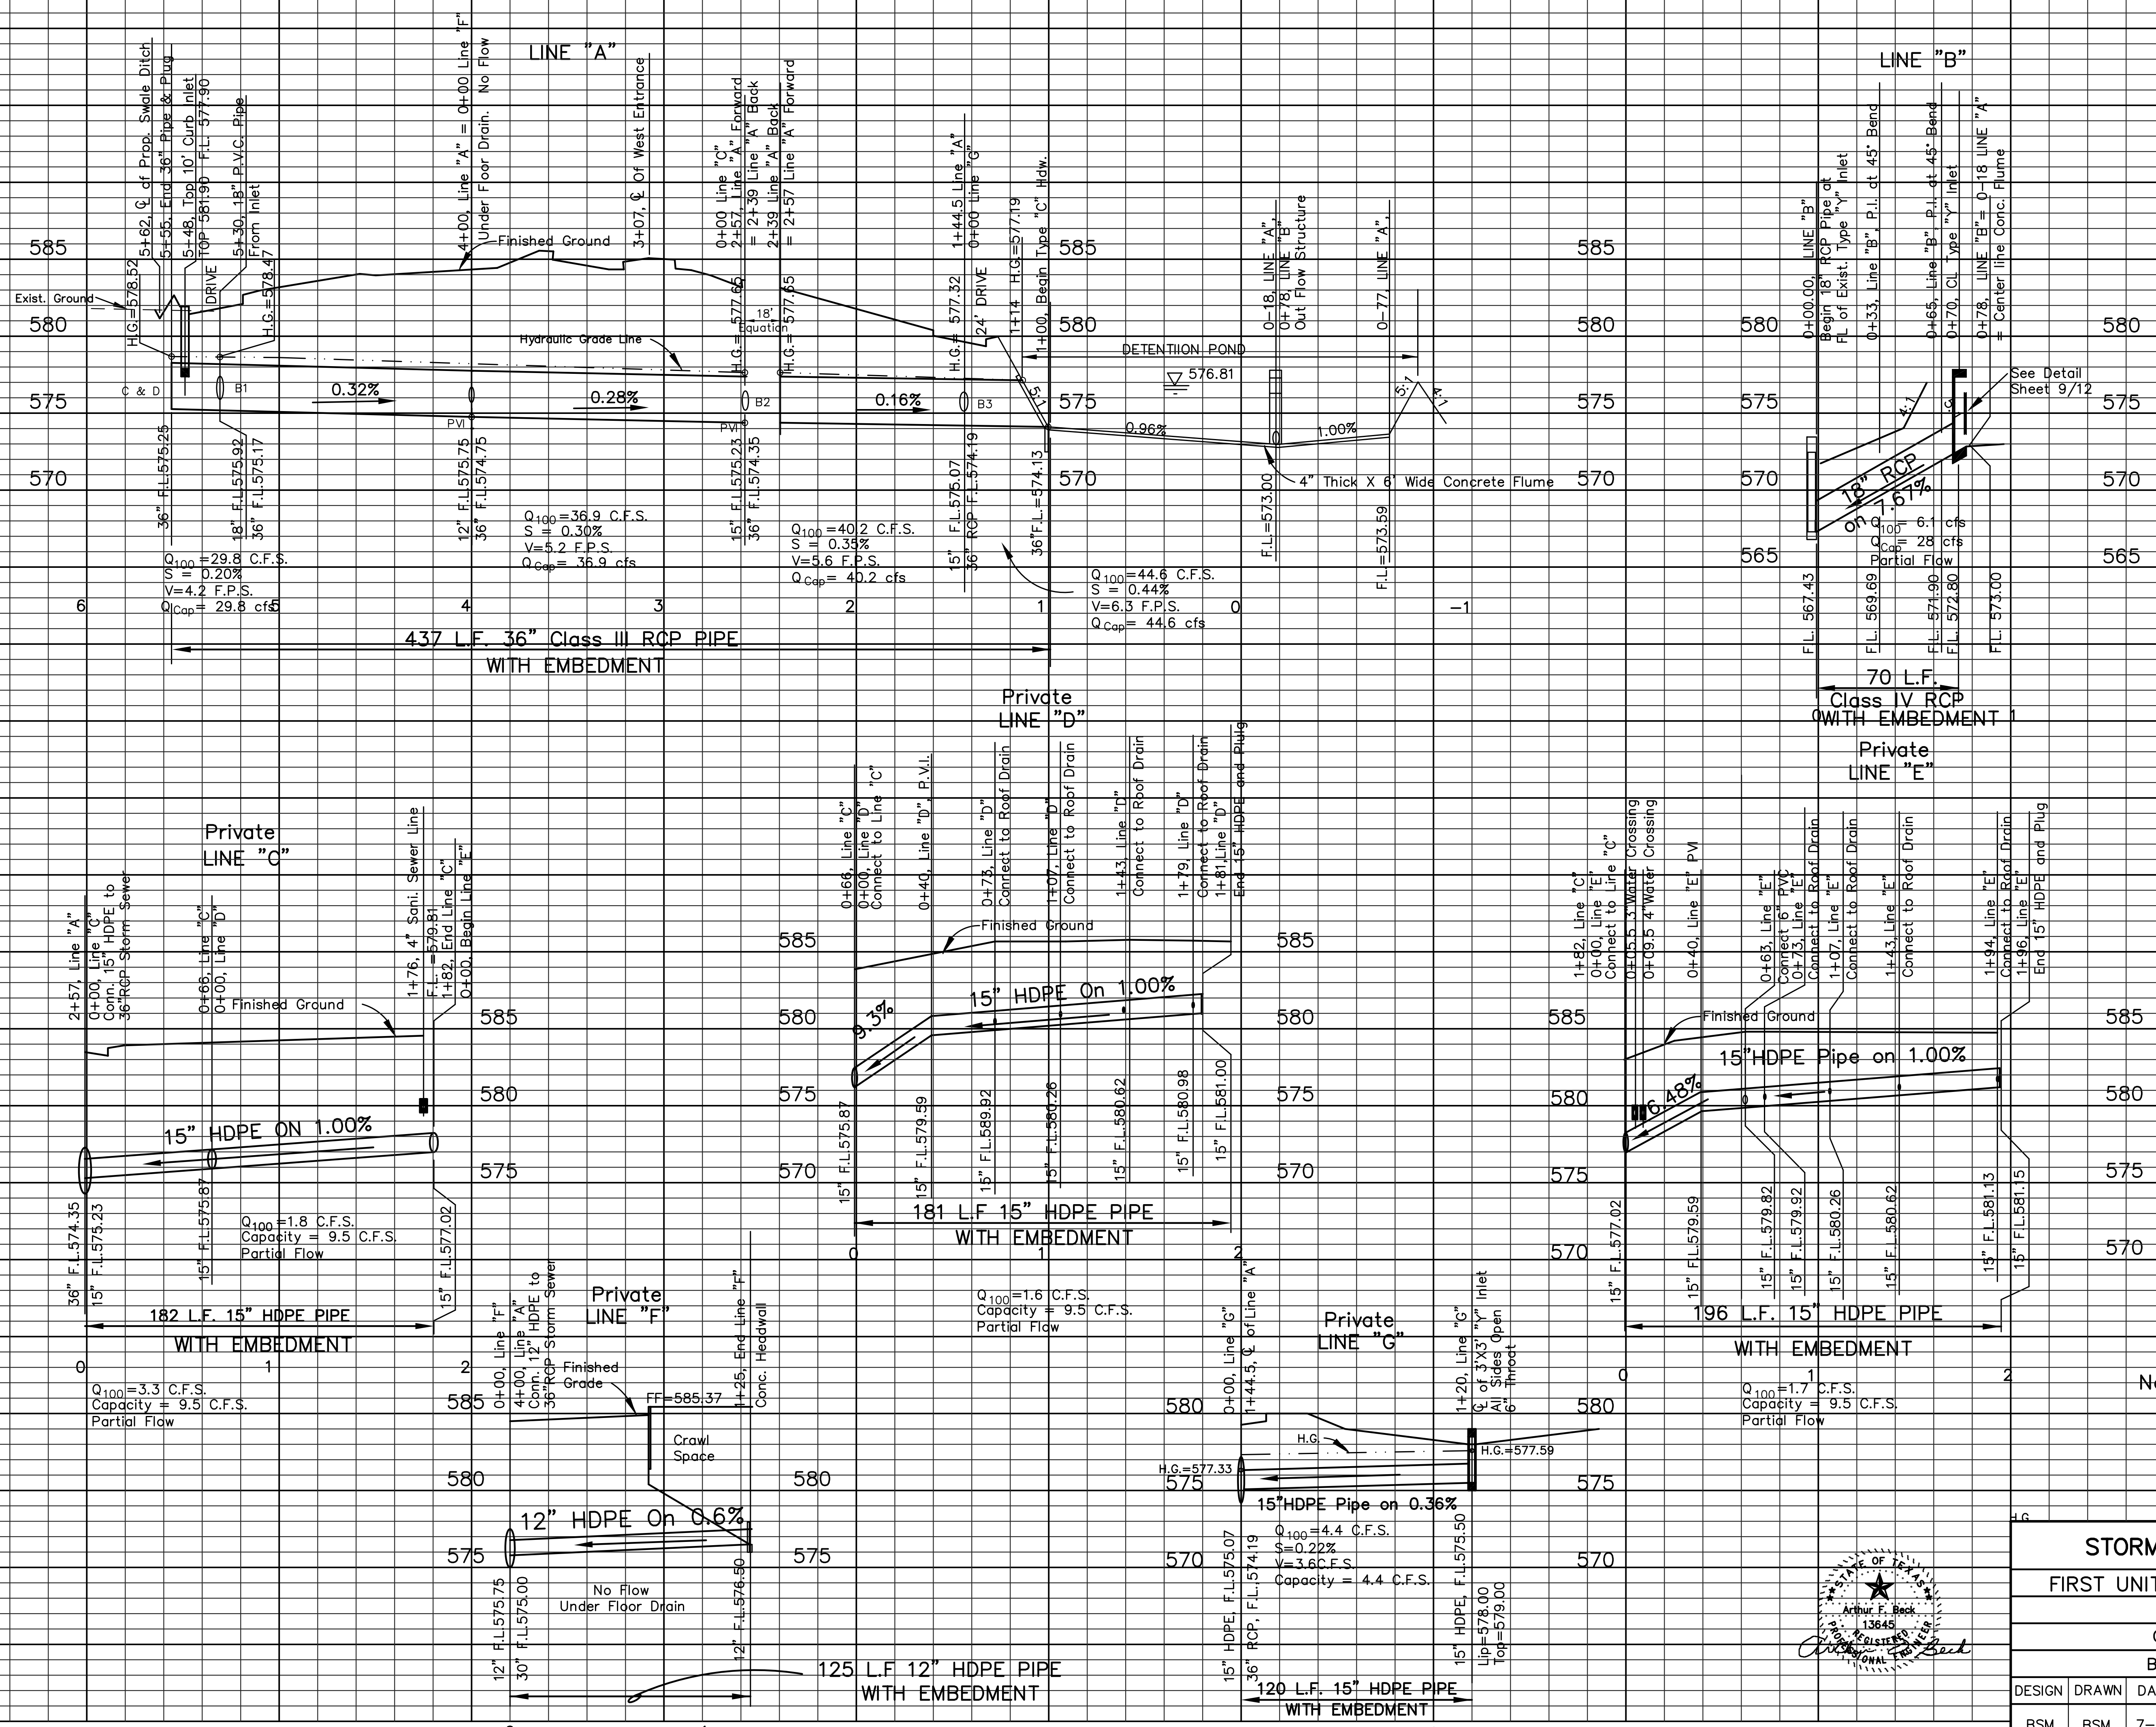

AS BUILT
November 30, 2015

7
12

PHASE 3

STORM SEWER PROFILES						
FIRST UNITED METHODIST CHURCH						
ROCKWALL						
CITY OF ROCKWALL						
BSM ENGINEERS, INC.						
DESIGN	DRAWN	DATE	SCALE	NOTES	FILE	NO.
BSM	BSM	7-14	H: 1"=40' V: 1"=5'	BSM		1404