


## LEGEND

- ☛ FDC Fire Department Connection

## NOTES

- encasement.

SCALE 1" = 40'

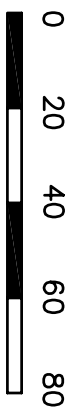


## SPECIFICATIONS

### 3rd Edition NCTCOG Standard Specifications for Public Works Construction and City of Rockwall Specifications and Standards.

# ROCKWALL COURT HOUSE

AS BUILT  
November 30, 2015

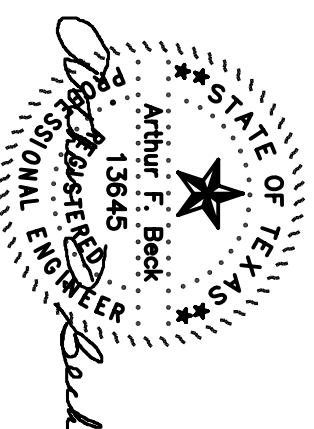

|                               |       |       |        |       |
|-------------------------------|-------|-------|--------|-------|
| WATER & SEWER PLAN/PROFILE    |       |       |        |       |
| FIRST UNITED METHODIST CHURCH |       |       |        |       |
| ROCKWALL                      |       |       |        |       |
| CITY OF ROCKWALL, TEXAS       |       |       |        |       |
| BSM ENGINEERS, Inc.           |       |       |        |       |
| DESIGN                        | DRAWN | DATE  | SCALE  | NOTES |
| BSM                           | BSM   | 07-14 | 1"=40' | BSM   |
|                               |       |       |        | 1404  |

C:\MISC\FUM\_ROCK\Phase3\8WS