


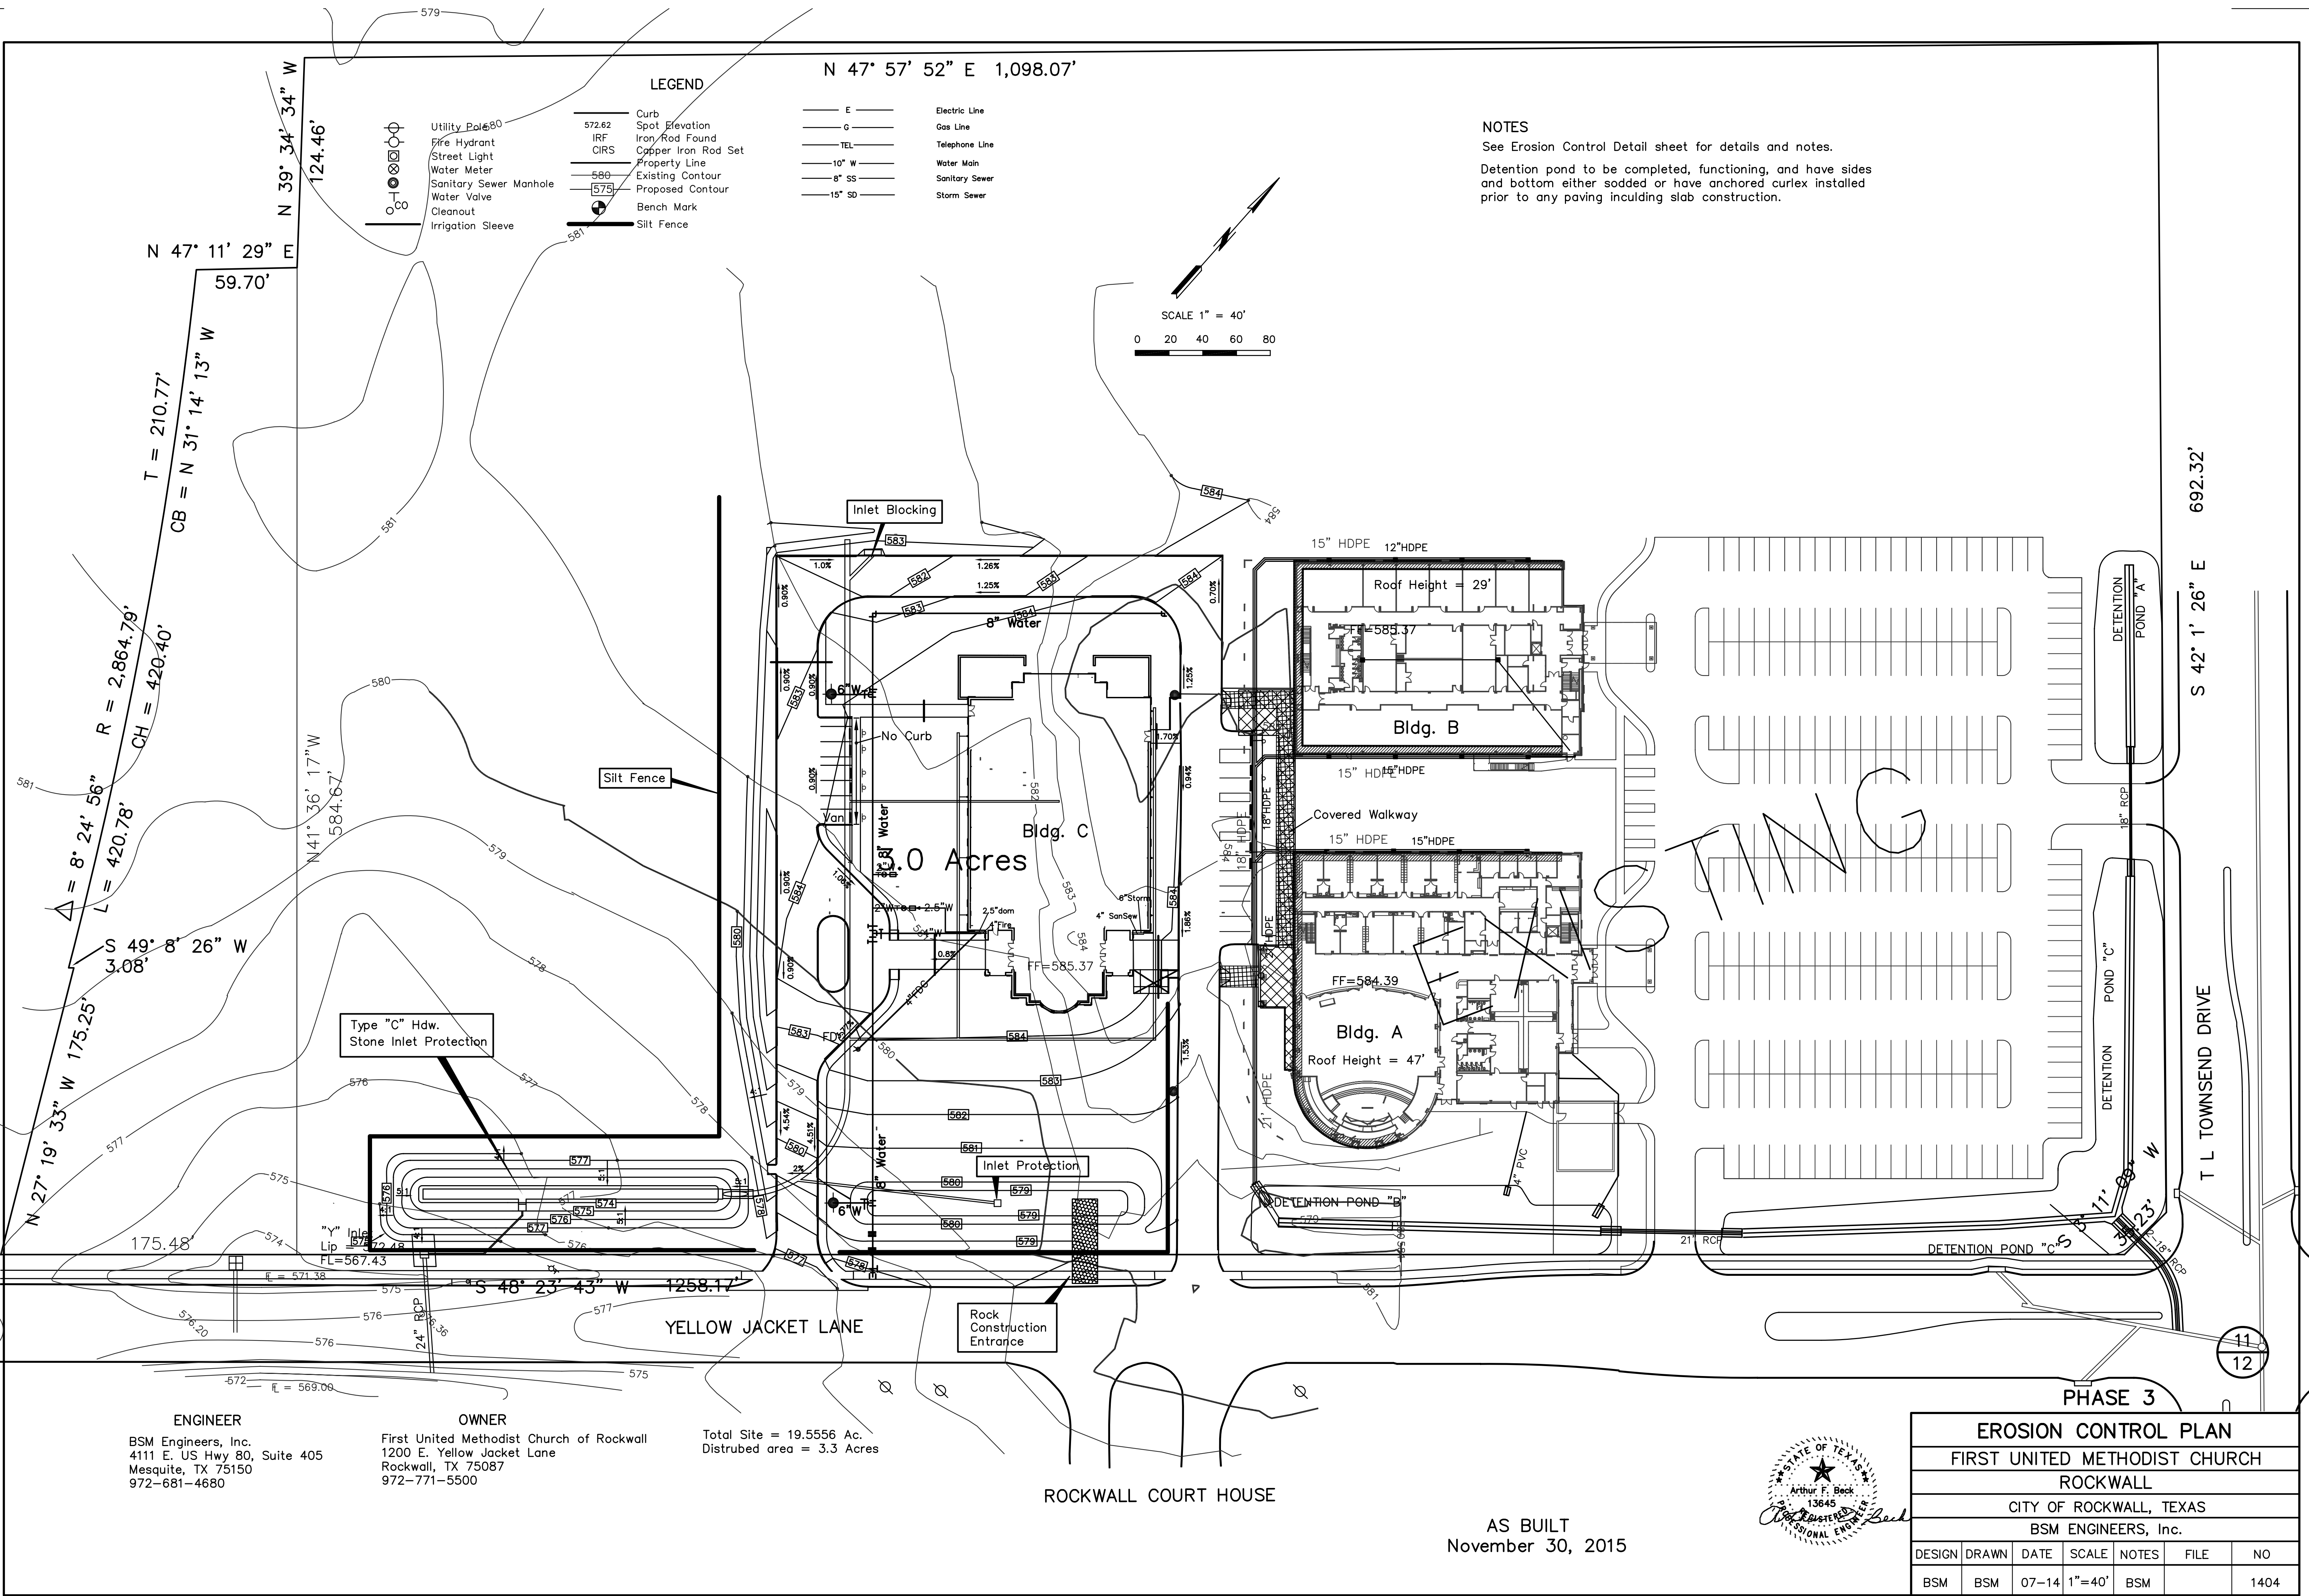


ENGINEER
BSM Engineers, Inc.
4111 E. US Hwy 80, Suite 405
Mesquite, TX 75150
972-681-4680

OWNER
First United Methodist Church of Rockwall
1200 E. Yellow Jacket Lane
Rockwall, TX 75087
972-771-5500

Total Site = 19.5556 Ac.
Disturbed area = 3.3 Acres

ROCKWALL COURT HOUSE

AS BUILT
November 30, 2015

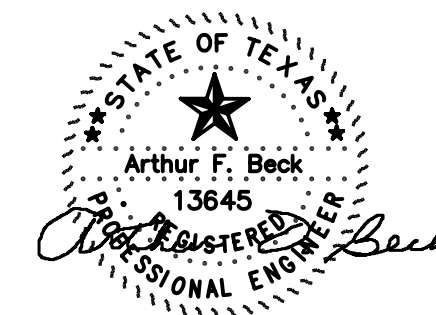

PHASE 3						
EROSION CONTROL PLAN						
FIRST UNITED METHODIST CHURCH						
ROCKWALL						
CITY OF ROCKWALL, TEXAS						
BSM ENGINEERS, Inc.						
DESIGN	DRAWN	DATE	SCALE	NOTES	FILE	NO
BSM	BSM	07-14	1"=40'	BSM		1404