


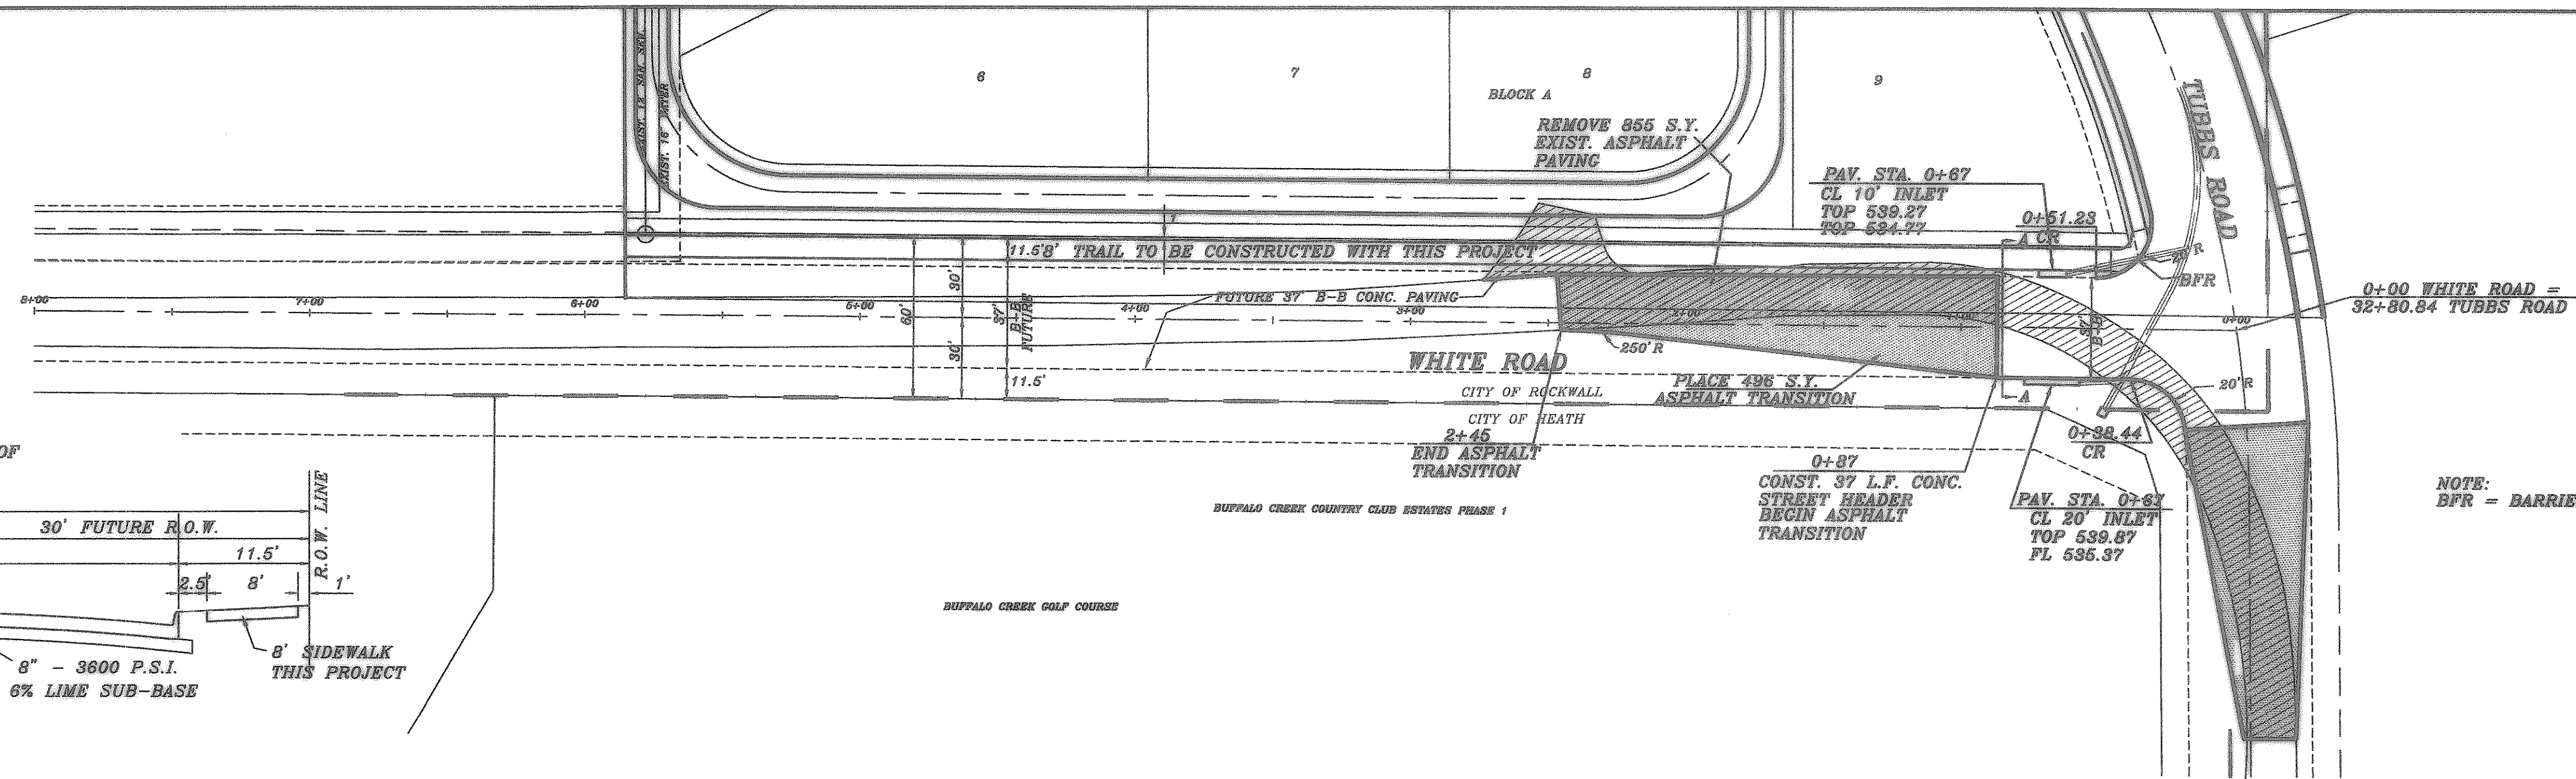
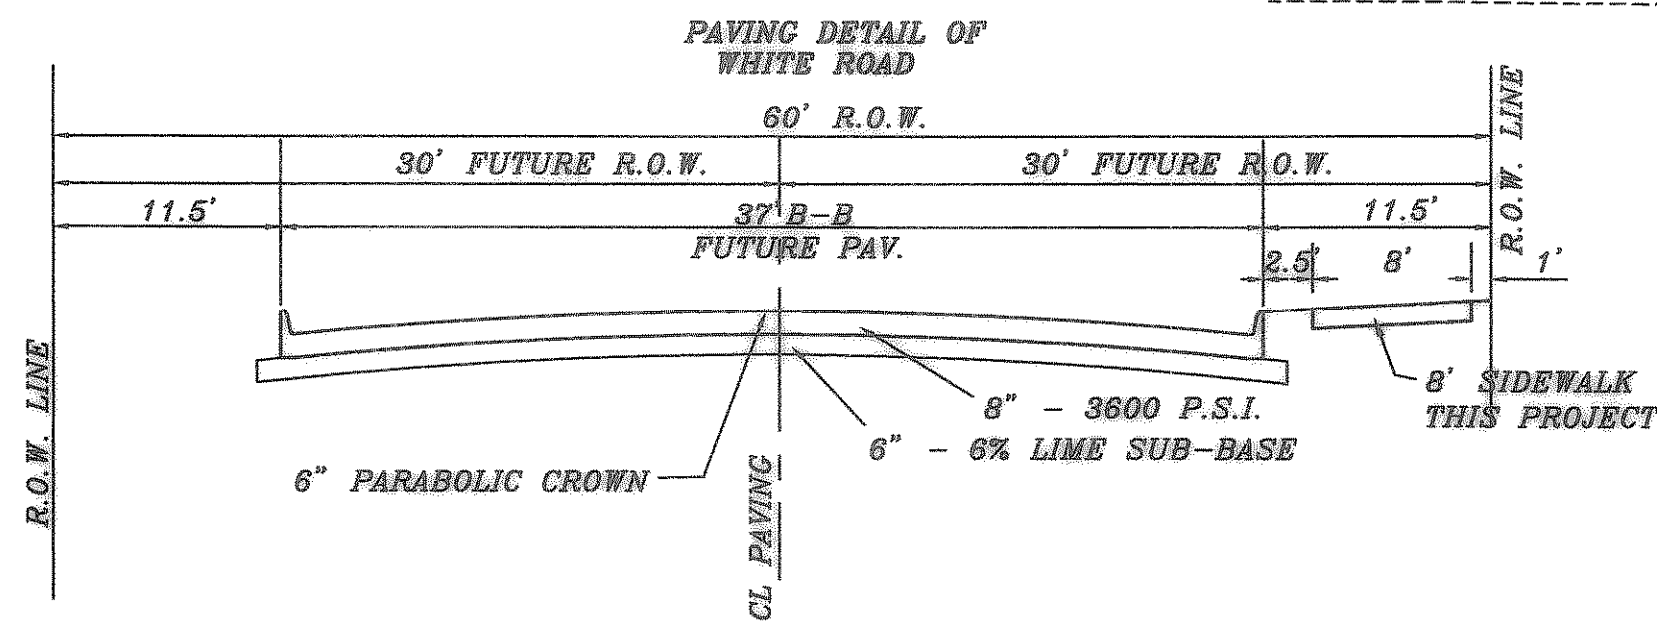


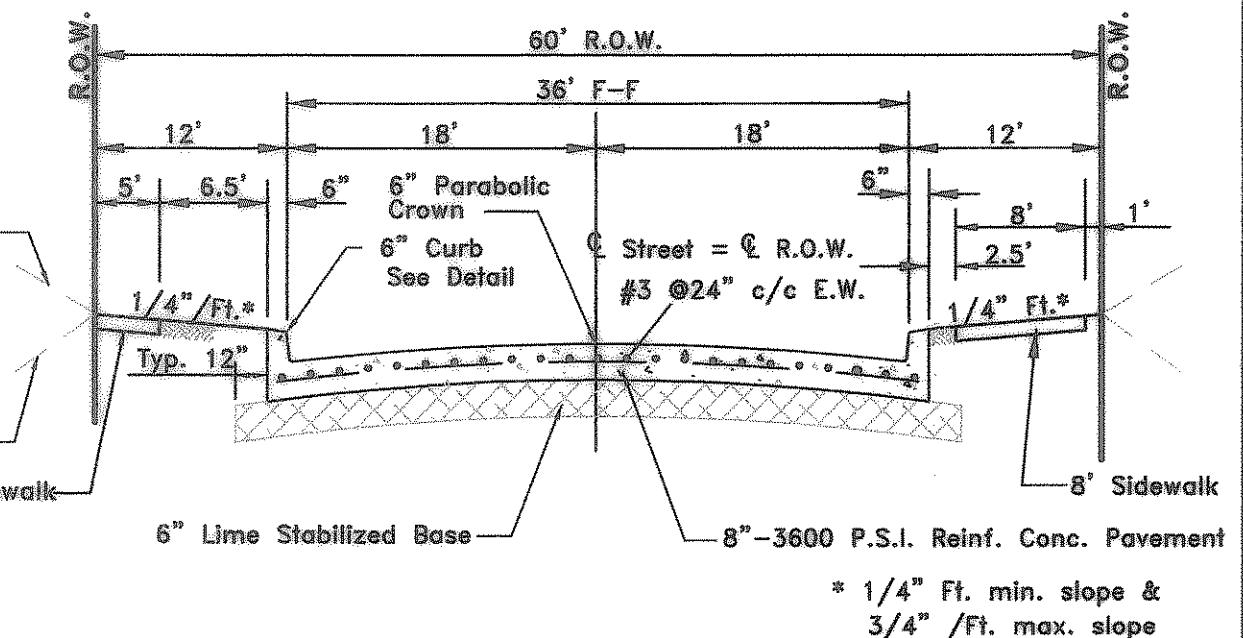


NOTE:
BPR = BARRIER FREE RAMP

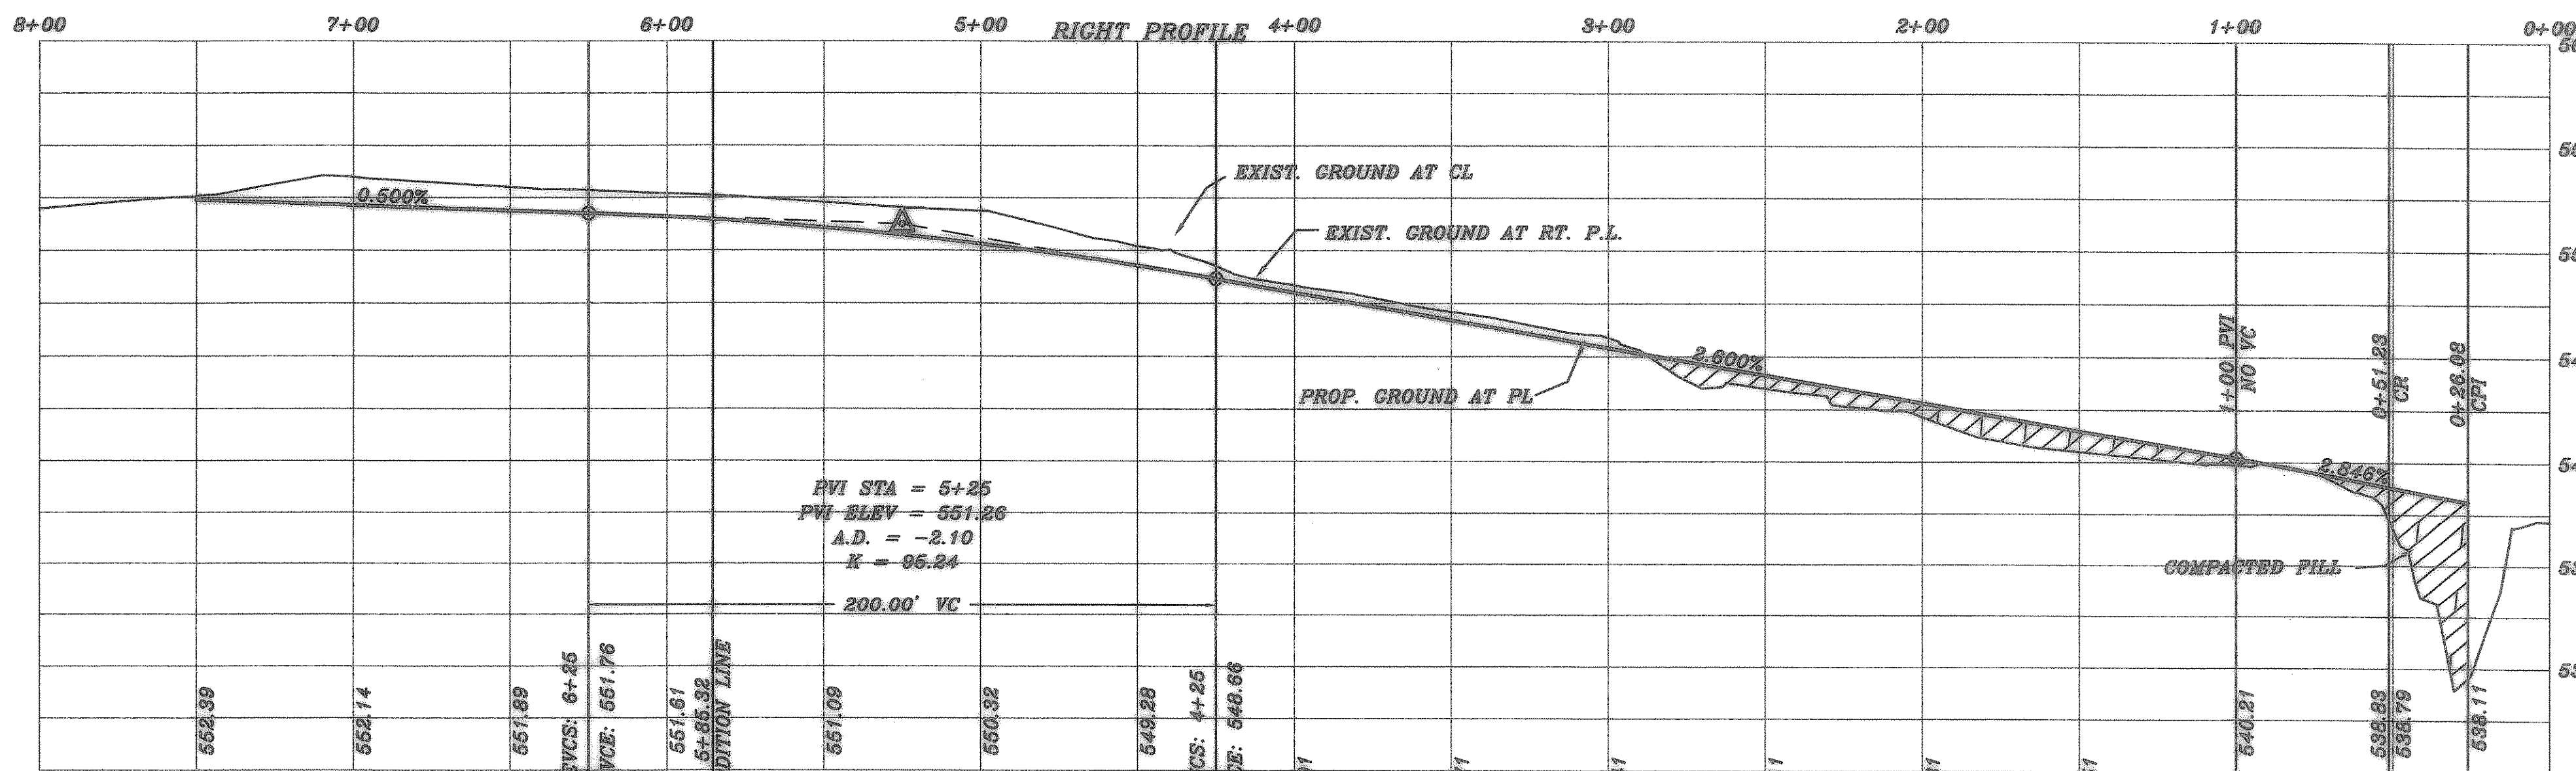

FUTURE FULL STREET SECTION
SECTION A-A

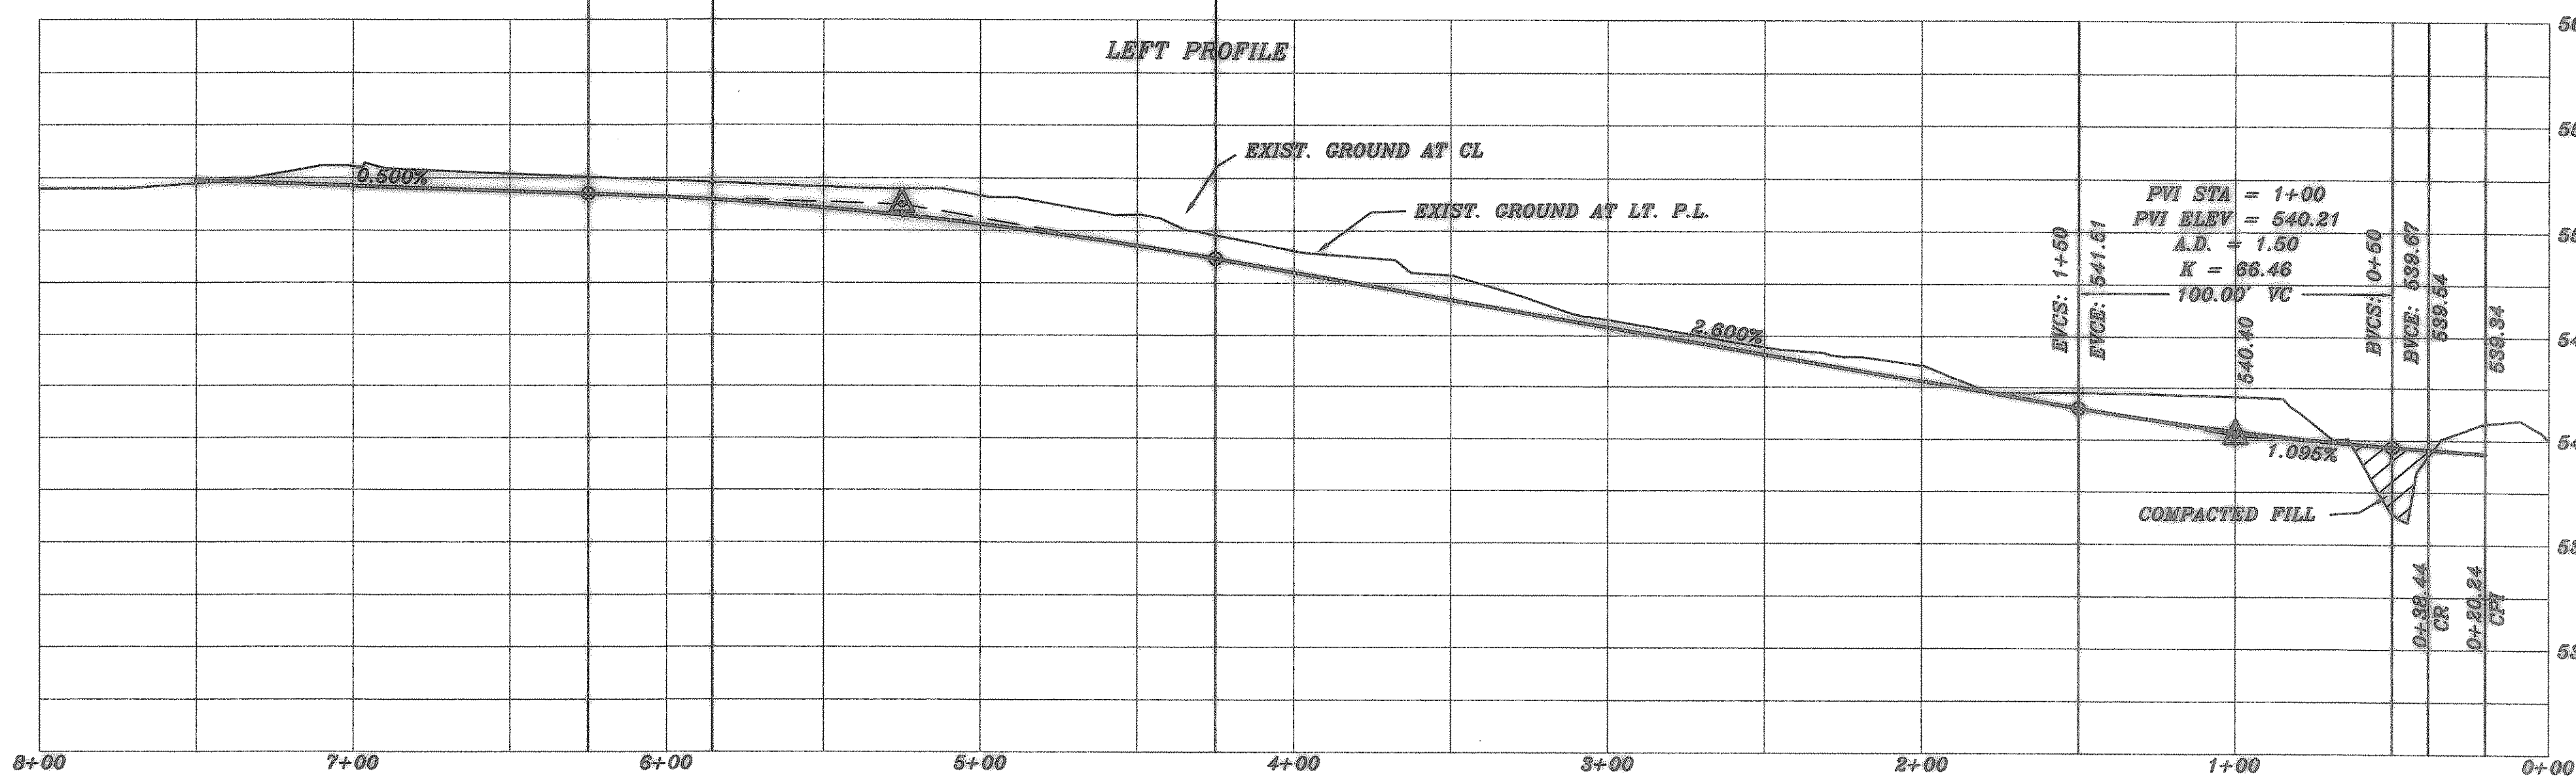

AS-BUILT

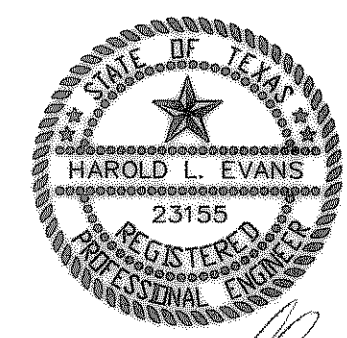

CITY OF ROCKWALL MONUMENT:
BRASS DISK ON TOP OF 10' CURB
INLET ON THE NORTH SIDE OF ELGIN
CT. AT THE NORTHWEST CORNER OF
THE INTERSECTION OF ELGIN CT. AND
TUBBS ROAD

N 7009919.8971
E 2597478.7812

ELEV: 537.22

		HAROLD L. EVANS CONSULTING ENGINEER P.O. BOX 570355 2831 GUS THOMASSON ROAD, SUITE 102 DALLAS, TEXAS 75270, (214) 328-8133	
REVISION DESCRIPTION FOXT FTS		DATE 9/28/08	SCALE 1" = 40' 1" = 6'
		DESIGN H.L.E.	DRAWN

PROPOSED PAVING WHITE ROAD FOXCHASE NO. 7 CITY OF ROCKWALL
--

SHEET NO. 5
JOB NO. 98111