



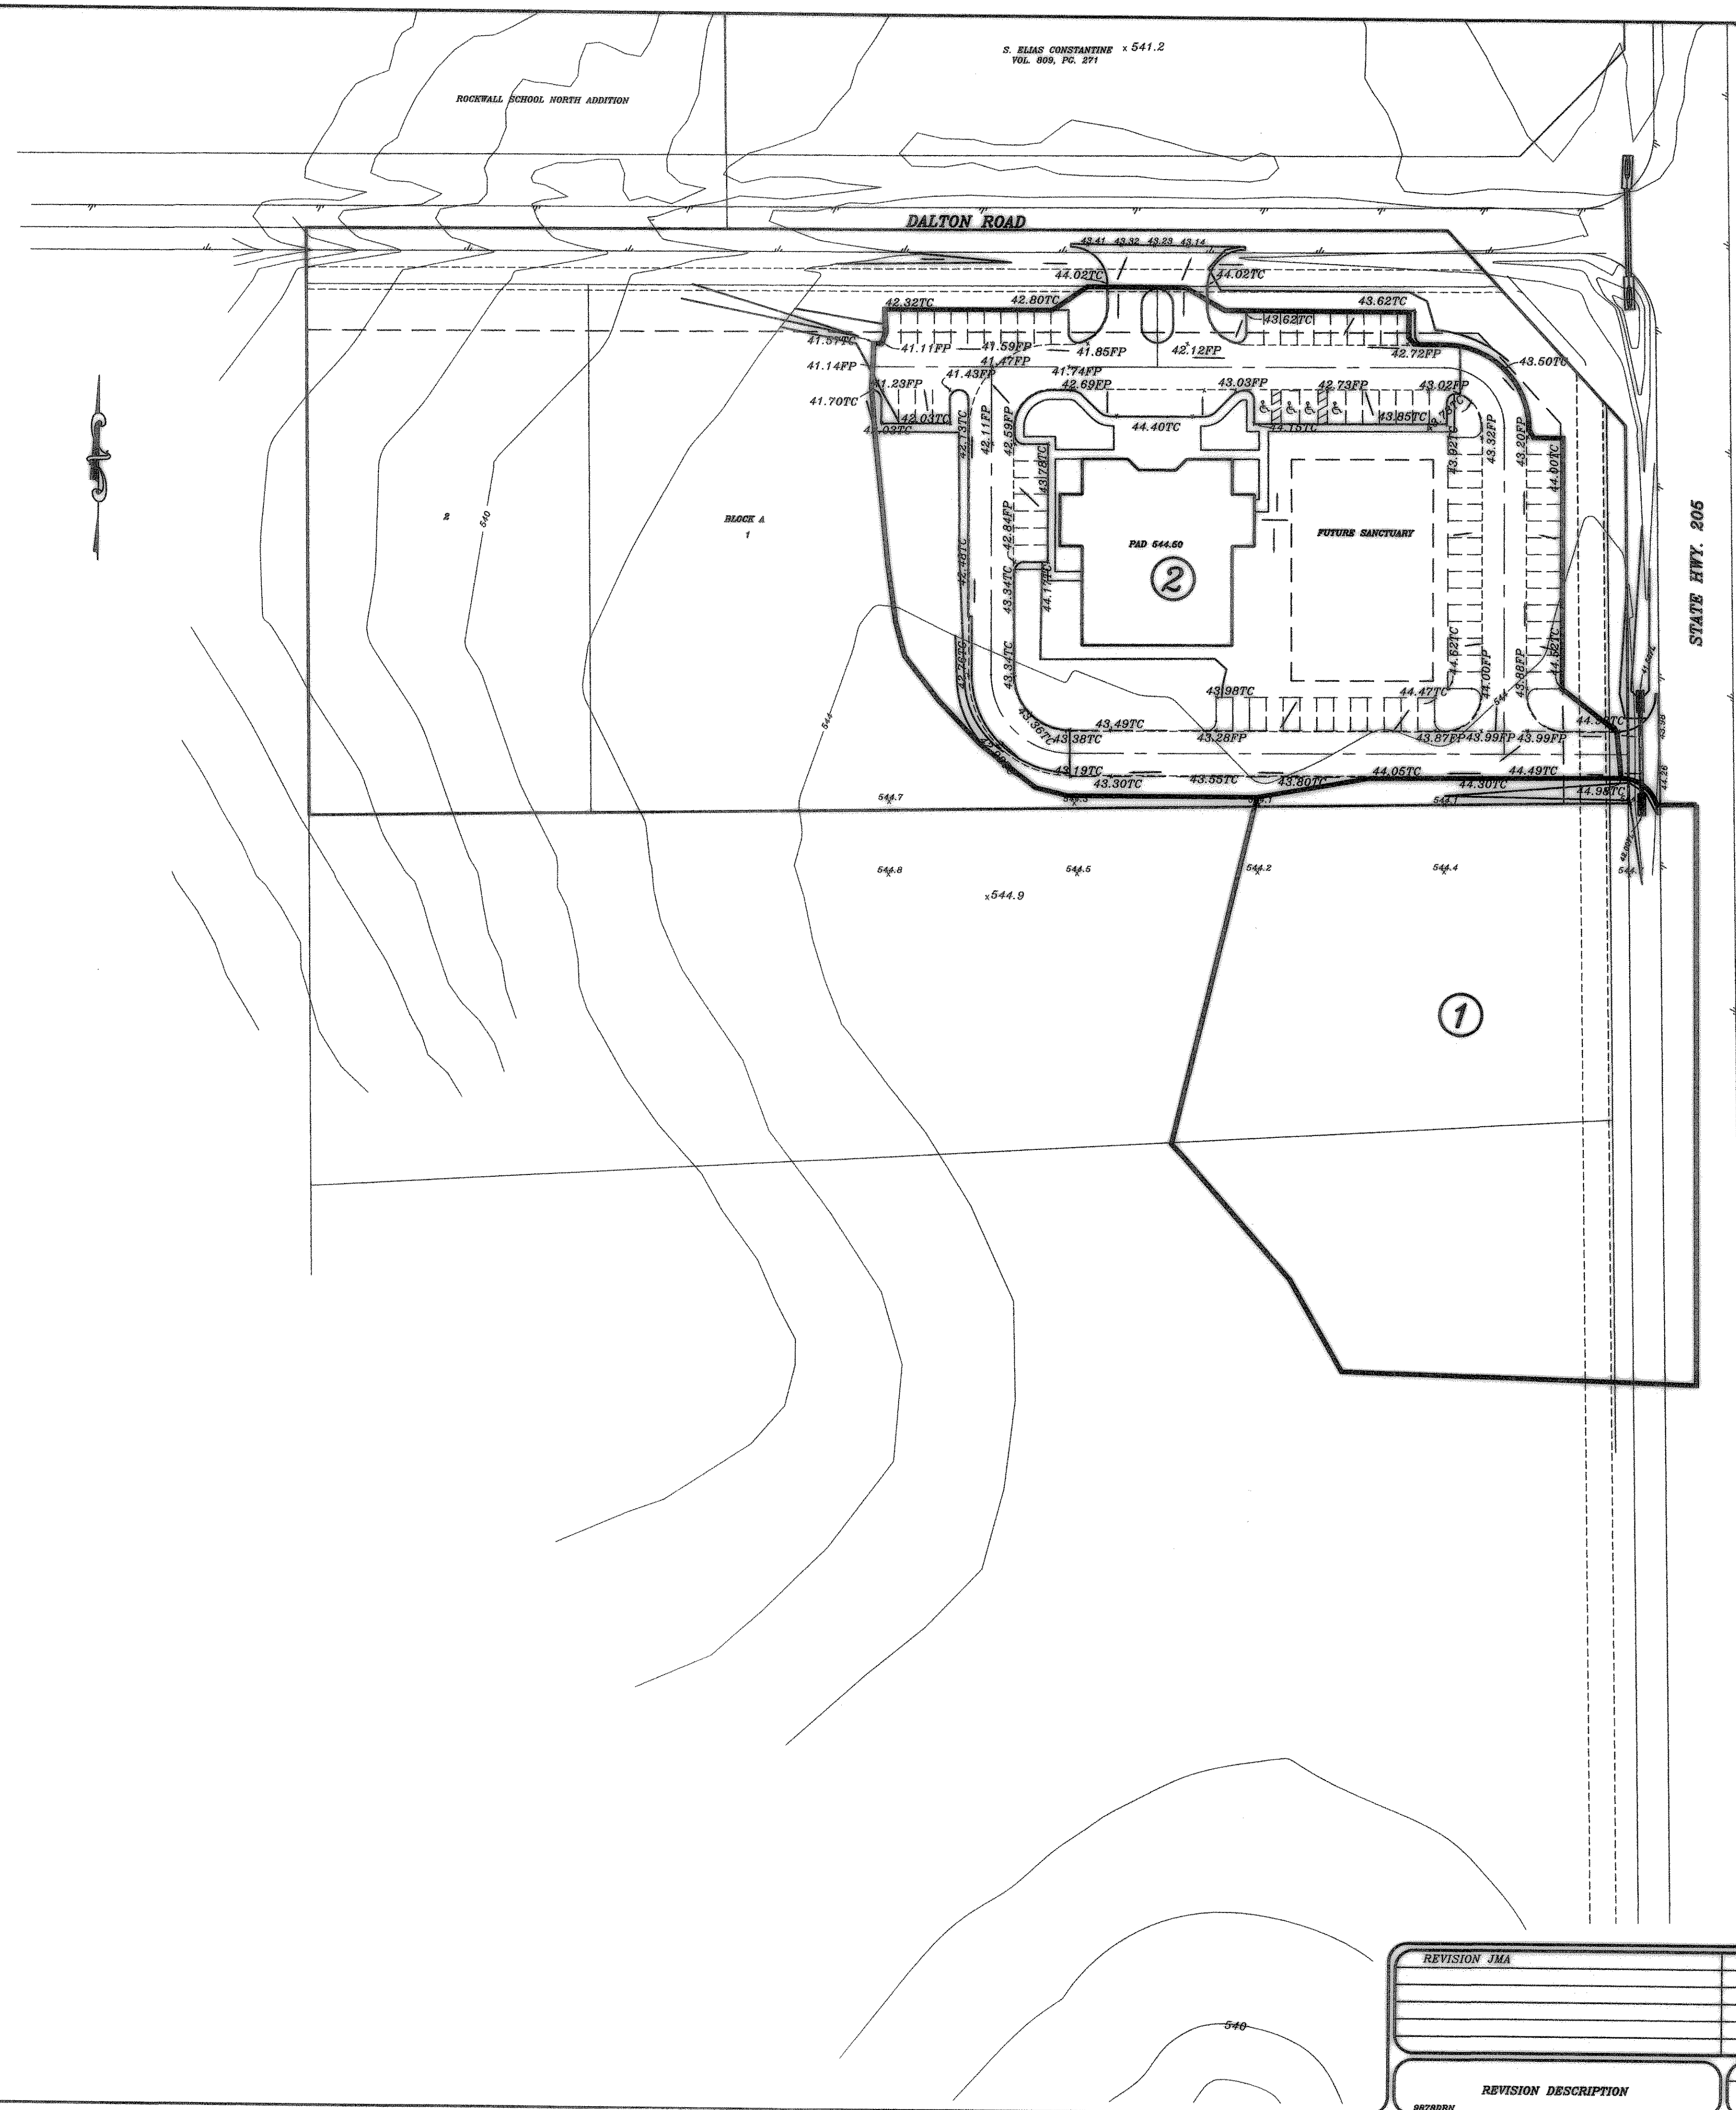

DRAINAGE AREA NO.	ACRES	T.C.	C	I 100 YR.	Q 100 YR.	SUM Q 100 YR.
1	1.83		0.8	9.8	8.97	
2	2.08		"	"	16.31	

B.M.
CITY OF ROCKWALL MONUMENT
LOCATED N 71° 57' 18" W 15.9'
FROM THE MOST NORTHERLY
NORTHEAST CORNER OF LOT 1
ELEV.: 542.38

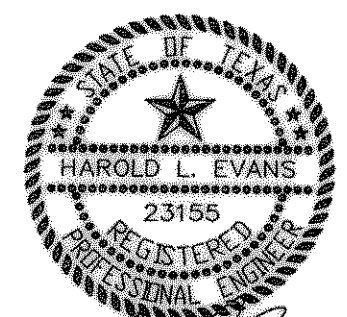

HAROLD L. EVANS
CONSULTING ENGINEER
P.O. BOX 28355
31 GUS THOMASSON ROAD, SUITE 102
DALLAS, TEXAS 75228, (214) 328-8133

DRAINAGE AREA MAP
THE FREE METHODIST CHURCH
OF NORTH AMERICA ADDITION
CITY OF ROCKWALL