
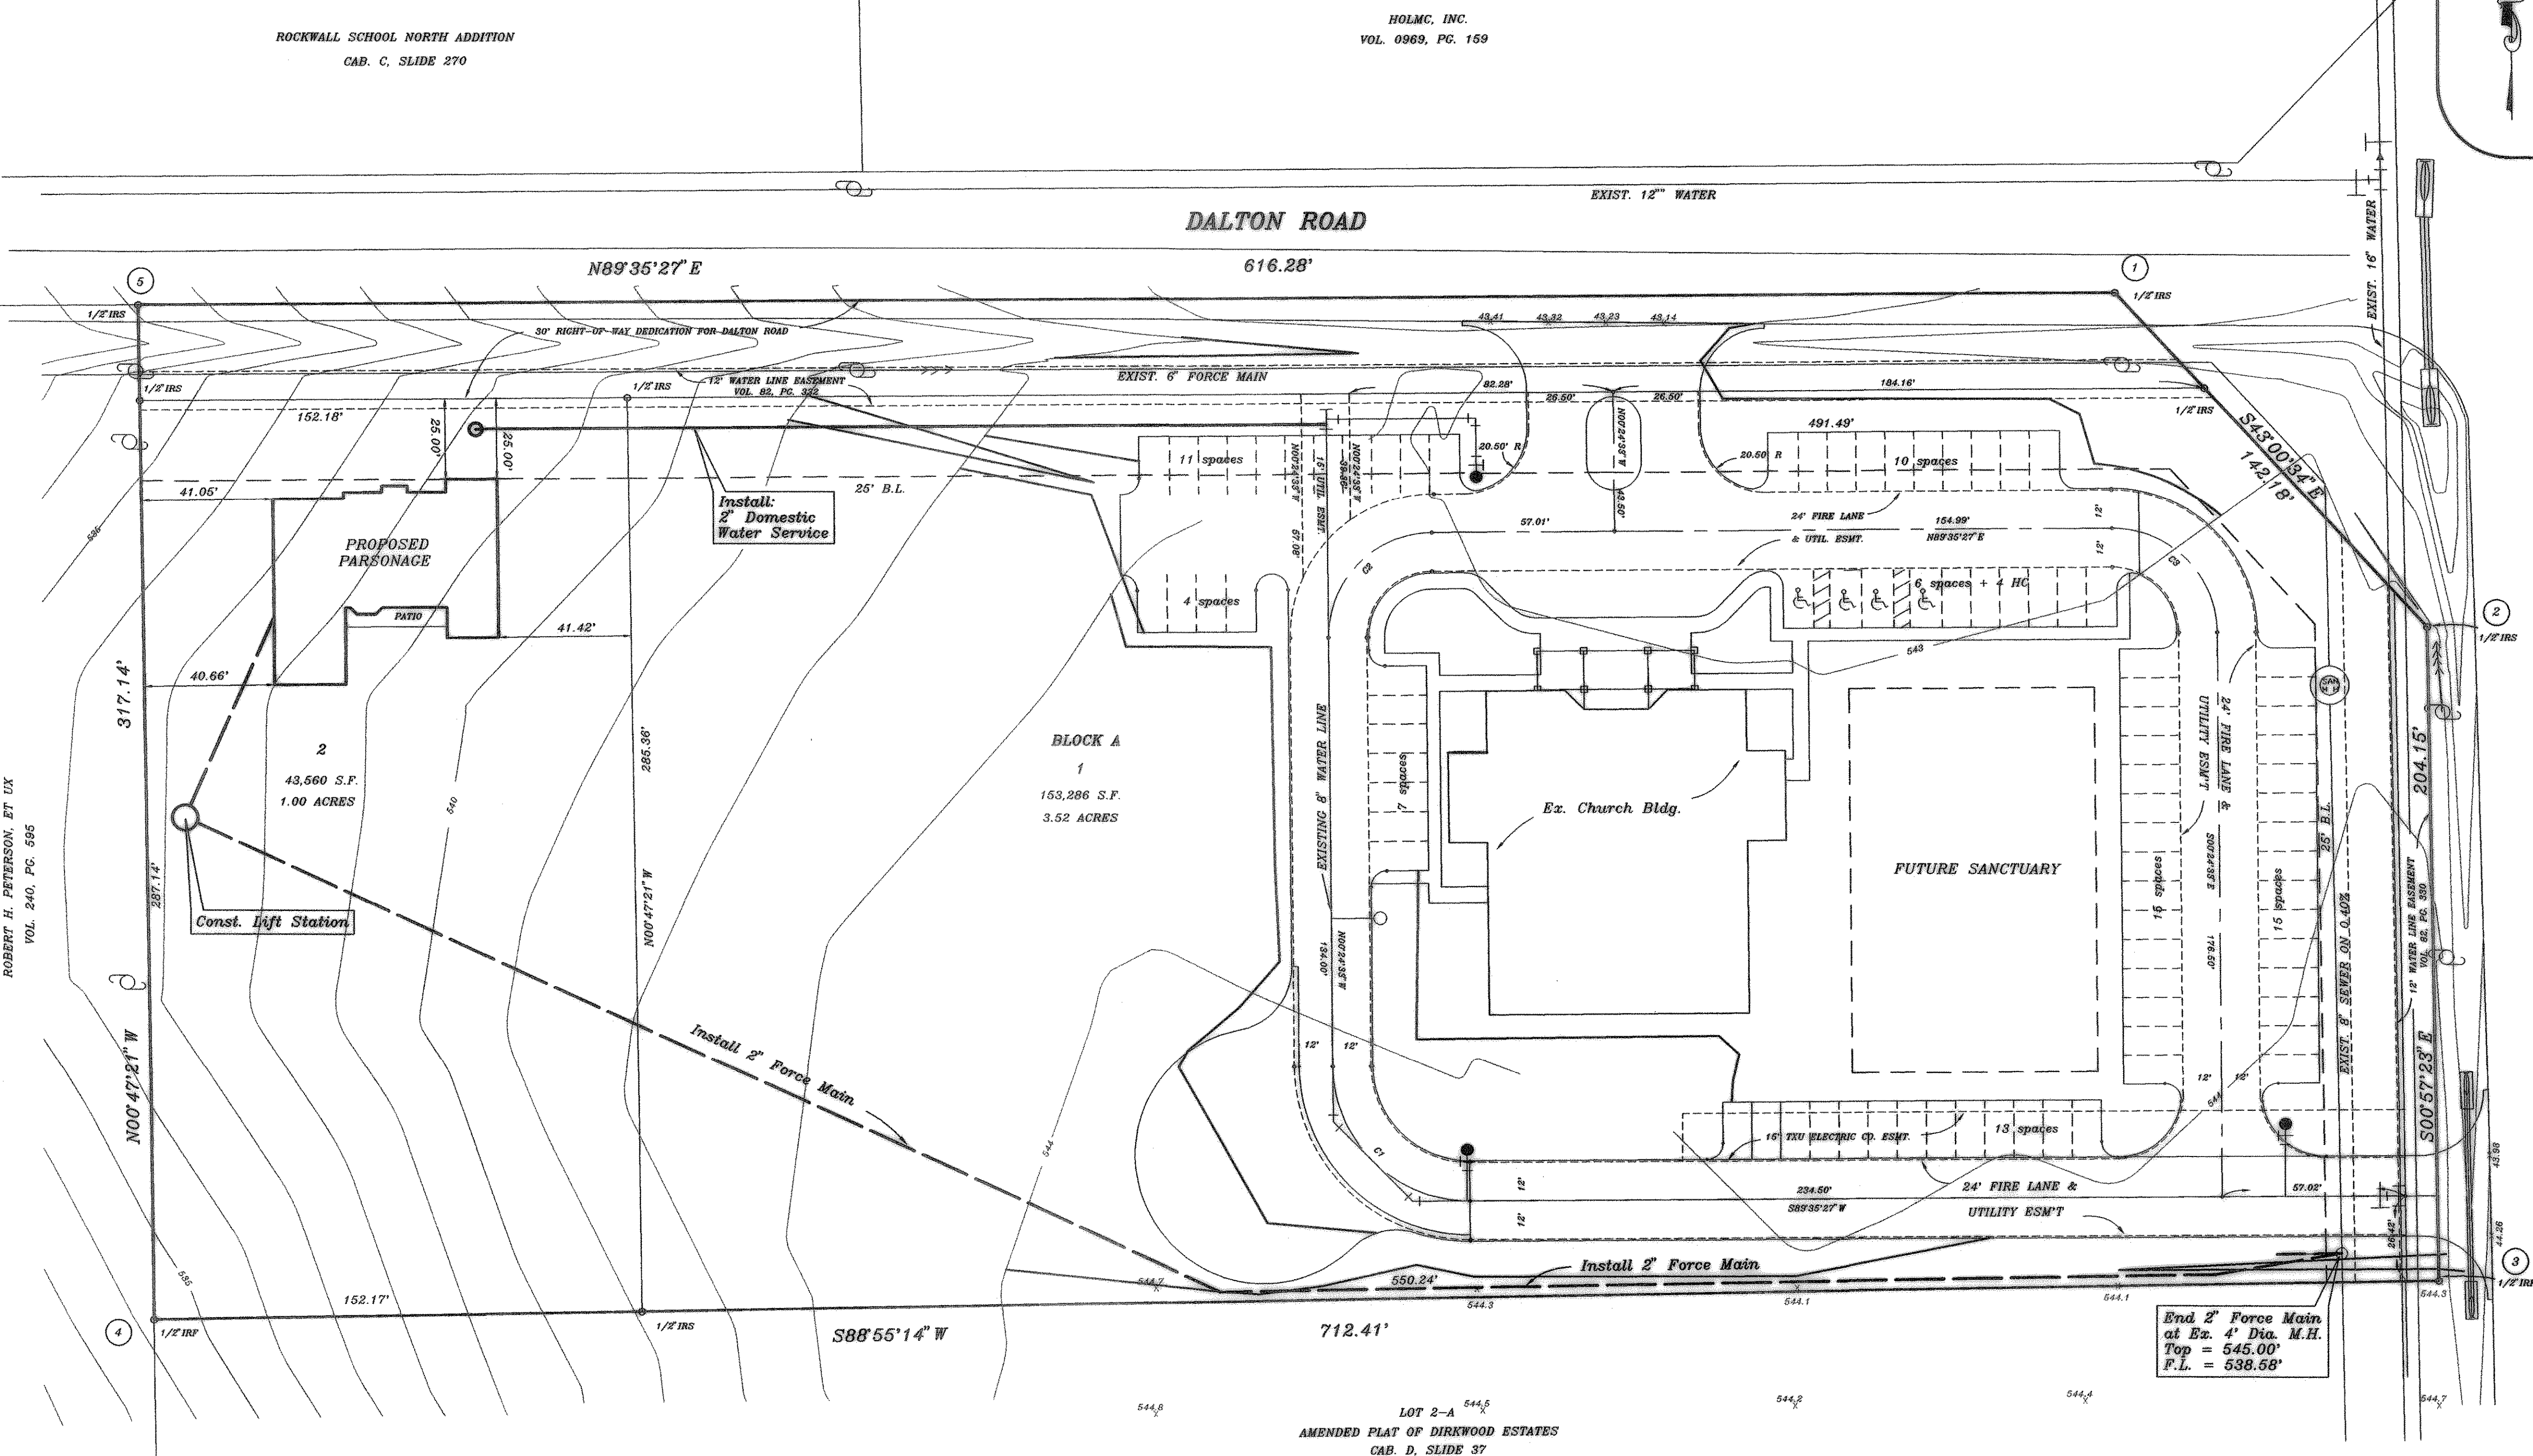
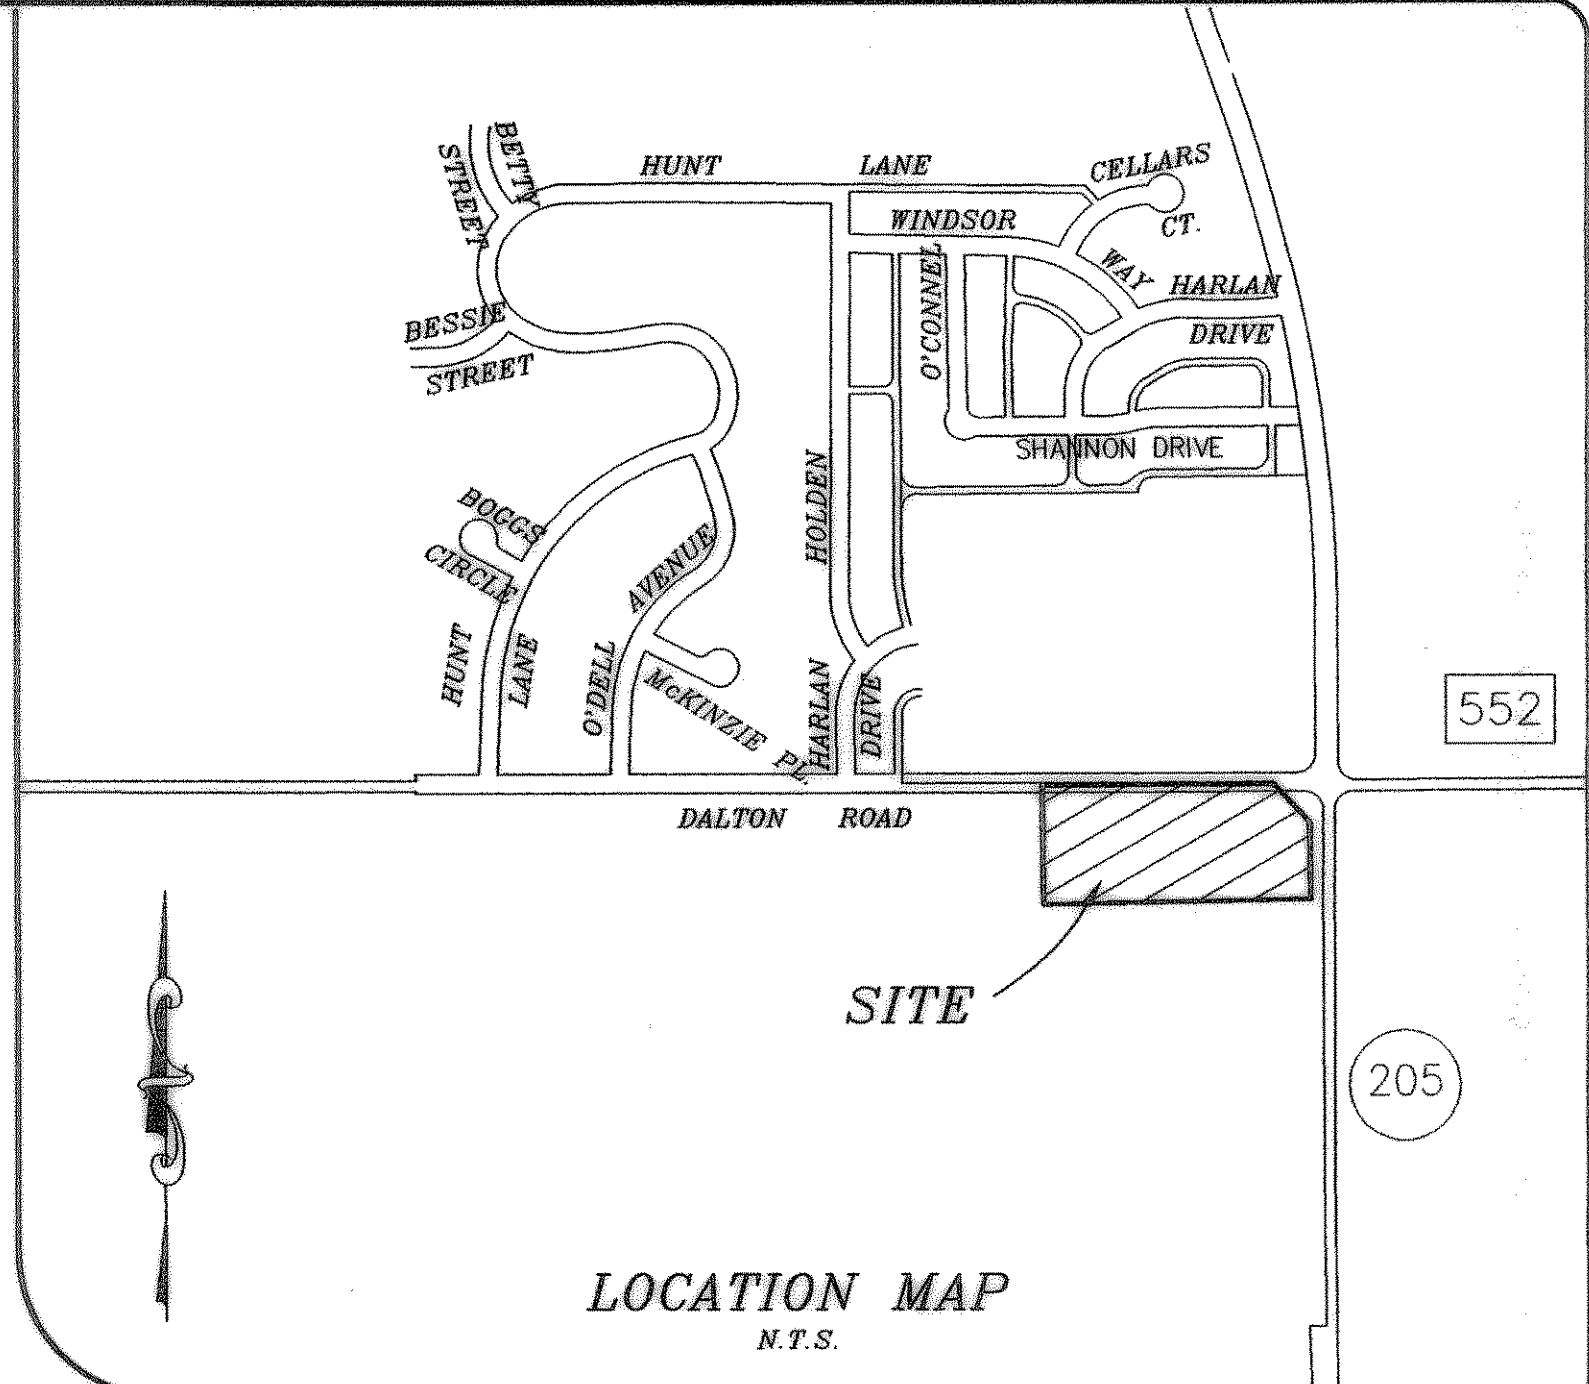



SURFACE ADJUSTED COORDINATES

	NORTHING	EASTING
1	7041529.833170	2592945.259805
2	7041425.865217	2593042.243535
3	7041221.740106	2593045.651583
4	7041208.317564	2592333.368041
5	7041525.432199	2592329.000419

CURVE	RADIUS	LENGTH	TANGENT	CHORD	BEARING	DELTA
C1	42.50'	66.76'	42.50'	80.10'	S45°24'33" E	90°00'00"
C2	32.50'	51.05'	32.50'	45.96'	N44°35'27" E	90°00'00"
C3	32.50'	51.05'	32.50'	45.96'	N45°24'33" W	90°00'00"

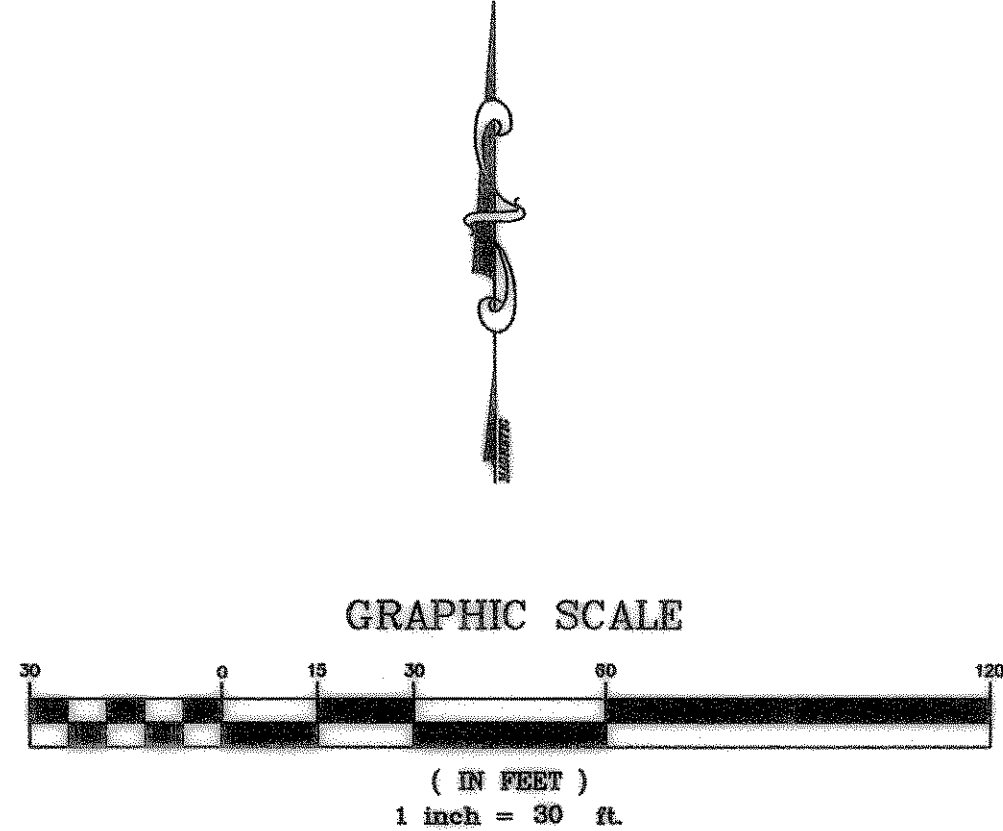

ST. HWY. 205
(NORTH COLIAD STREET)

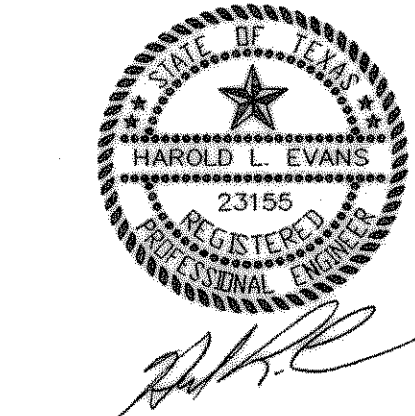

AS BUILT

ROBERT H. PETERSON, ET UX
VOL. 240, PG. 595

LOT 2-A
AMENDED PLAT OF DIRKWOOD ESTATES
CAB. D, SLIDE 37

OWNER:
THE FREE METHODIST CHURCH OF
NORTH AMERICA
302 N. COLIAD, ROCKWALL, TEXAS 75087

REVISION	DESCRIPTION	DATE	SCALE	DESIGN	DRAWN
5-5-01			1" = 30'	H.L.E.	JMA

HAROLD L. EVANS
CONSULTING ENGINEER
P.O. BOX 28355
2331 GUS THOMASSON ROAD, SUITE 102
DALLAS, TEXAS 75228, (214) 328-8133

SITE PLAN		SHEET NO.
LOT 2, BLOCK A of THE FREE METHODIST CHURCH OF NORTH AMERICA ADDITION		
CITY OF ROCKWALL, ROCKWALL CO., TX.		
JOB NO.	9878	