




NOTE:
Where two (2) 10' inlets are called for on the plans, it is intended to construct two (2) 10' long inlets with a common center wall. There shall be a 2' X 2' opening through the lower portion of the wall. Reinforcing is to be the same as an end wall modified to be in the center of the center wall. Bars D are to be 2' - 4" long with three additional #4 bars 3' - 0" long placed horizontal in the center wall.

TBM:
TOP OF OPERATING NUT OF FIRE HYDRANT ON NORTH SIDE OF OLD CONCRETE ROAD NORTHEAST OF YELLOWJACKET LANE, ELEV. = 488.90

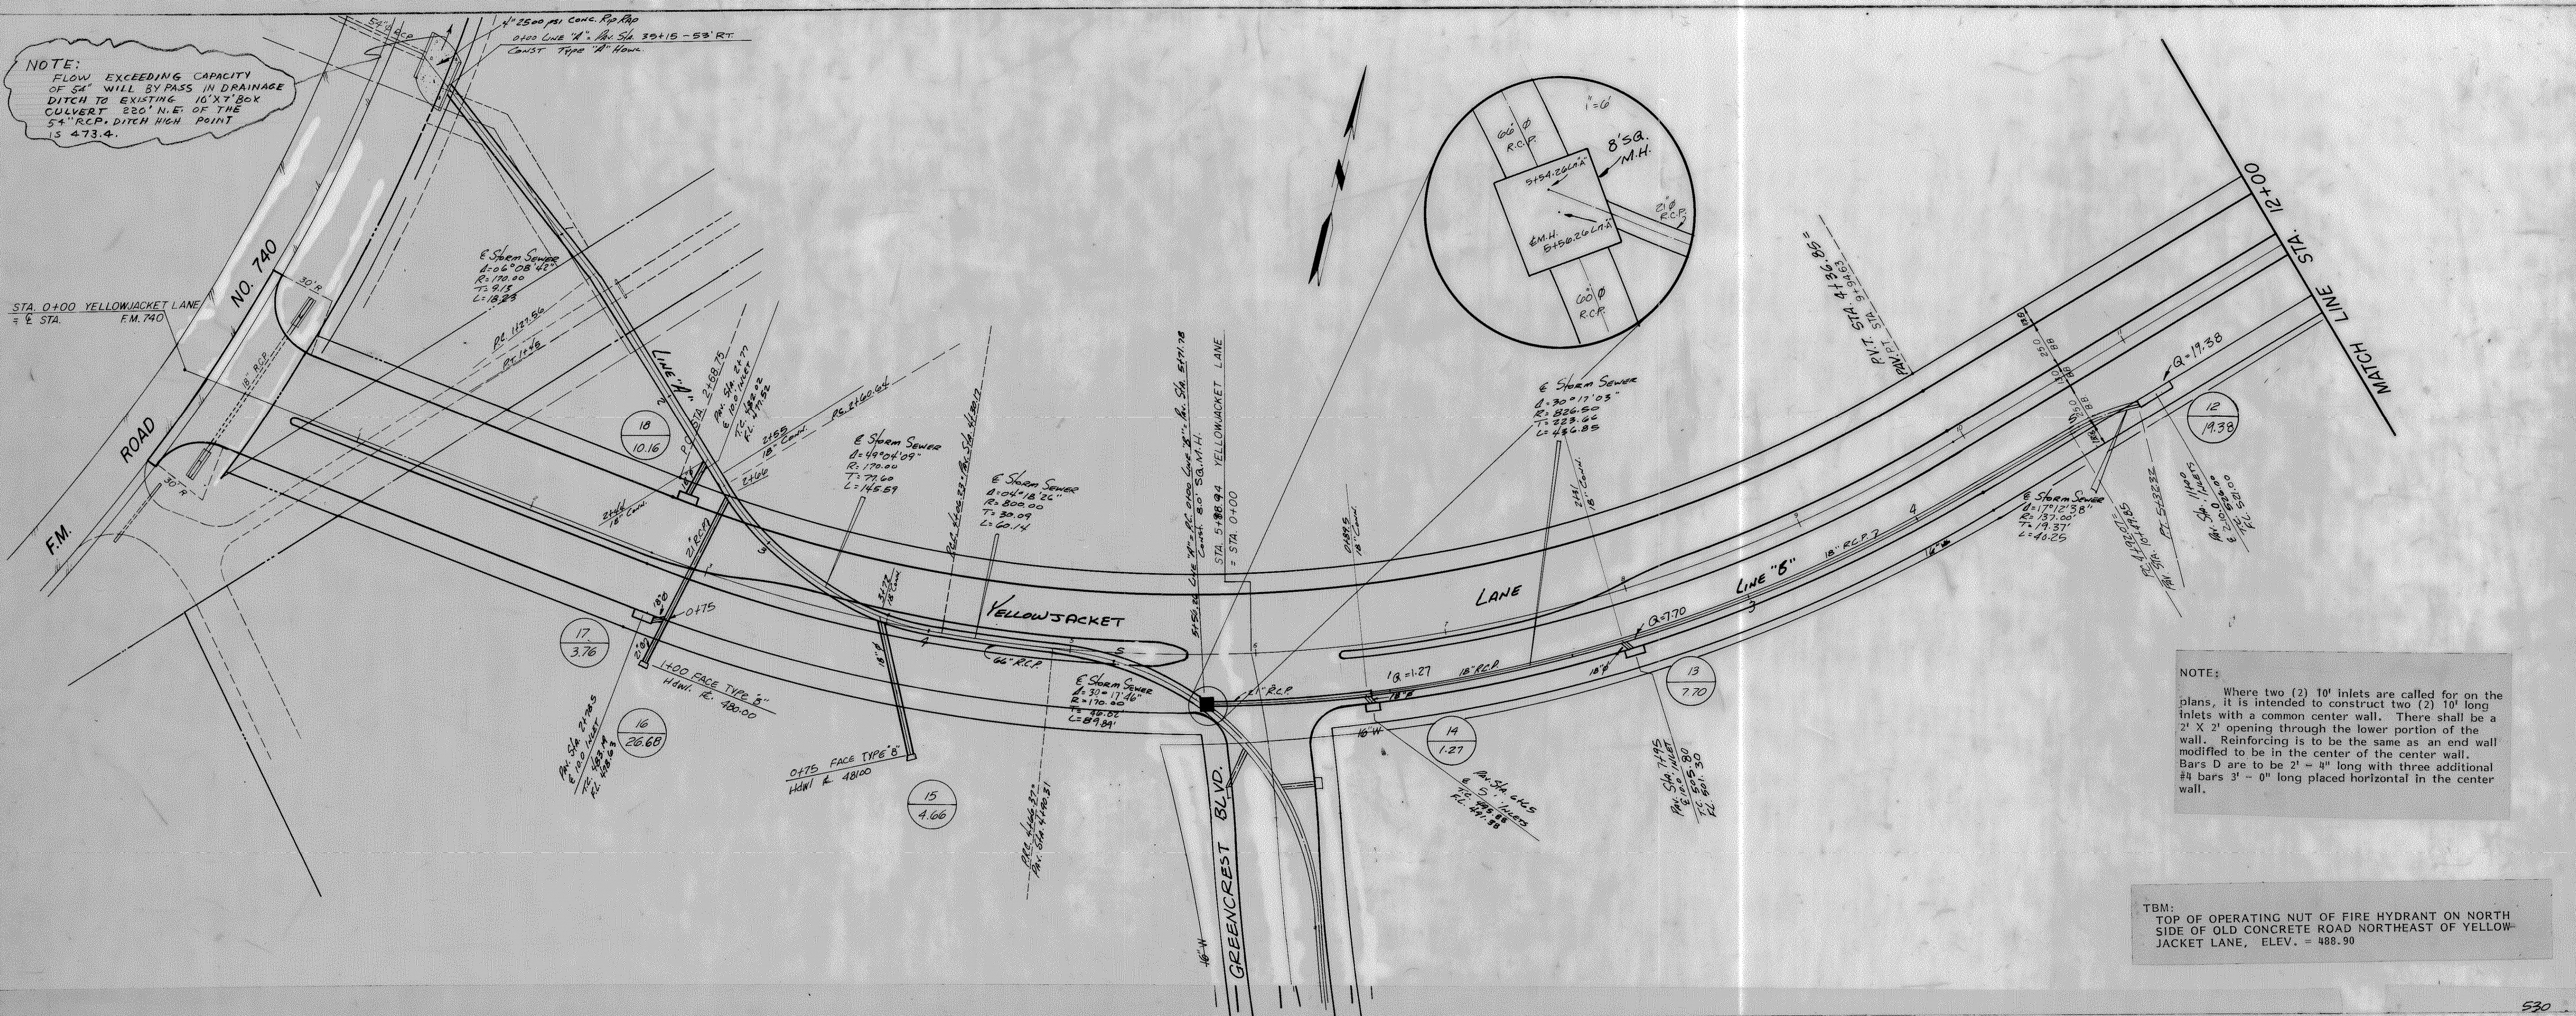