AS BUILT 9-12-05


GERALD E. MONK 9-12-05

Date Issued 5-16-03 Project No. 2003-15 Sheet Title SITE PLAN

Sheet Number

Sequence of

EXISTING 8" WATER EXISTING RETAINING WALL

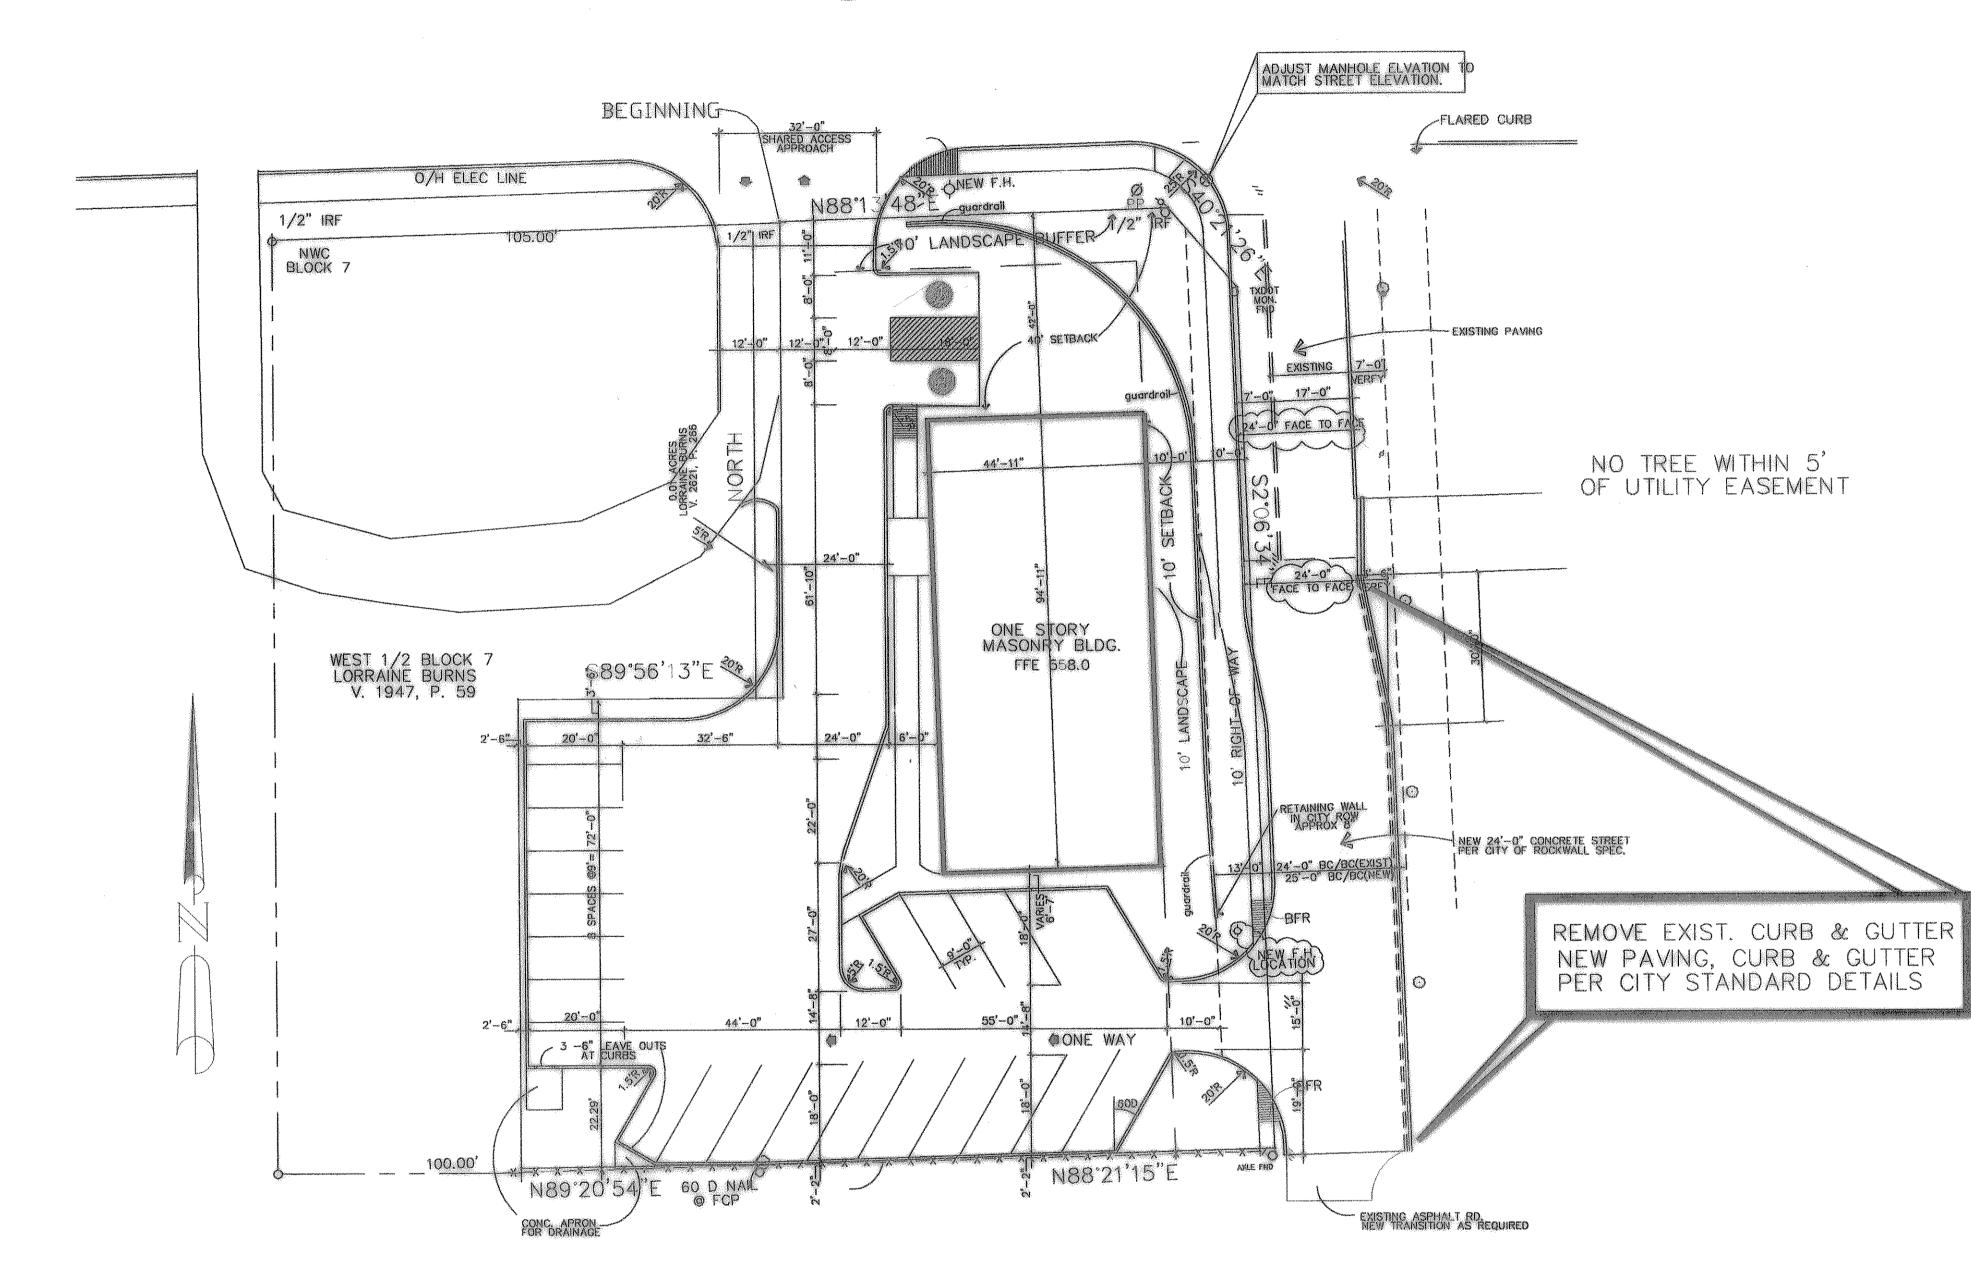

-9 BARS # 24" O.C. INTEGRAL CURB NOT TO SCALE

EXIST. CONC. PROP. CONC.

POUEL NO SECURE POUEL SLEEVE (CLOSED END) OC. CONCRETE PAVEMENT CONNECTION NOT TO SCALE

SITE PLAN SCALE 1"=20'-0"

NOTE: DIMENSIONS ARE FACE OF CURB TO FACE OF CURB UNLESS NOTED OTHERWISE

CEMETERY

PROJECT TABULATION 19,602 SF GENERAL REATIL SITE AREA ZONING

4275 SF 21.8 % BUILDING AREA COVERAGE

PARKING REQUIRED PARKING PROVIDED

BUILDING HEIGHT

SH 66 & FIRST STREET 22 25 **BOYDSTUN** 

B.F. BOYSTUD SURVEY ABSTRACT NO.14 ROCKWALL, TEXAS

PREPARED BY
GERALD MONK

CONSULTING ENGINEER 972-864-8028

INFORMATION PROVIDED

BY PCC ENGINEERING VERIFY IN FIELD ANY DISCREPANCY NOTIFY

ENGINEER/ACHITECT

HAIR MOTION

ROCKWALL, TEXAS

28'