



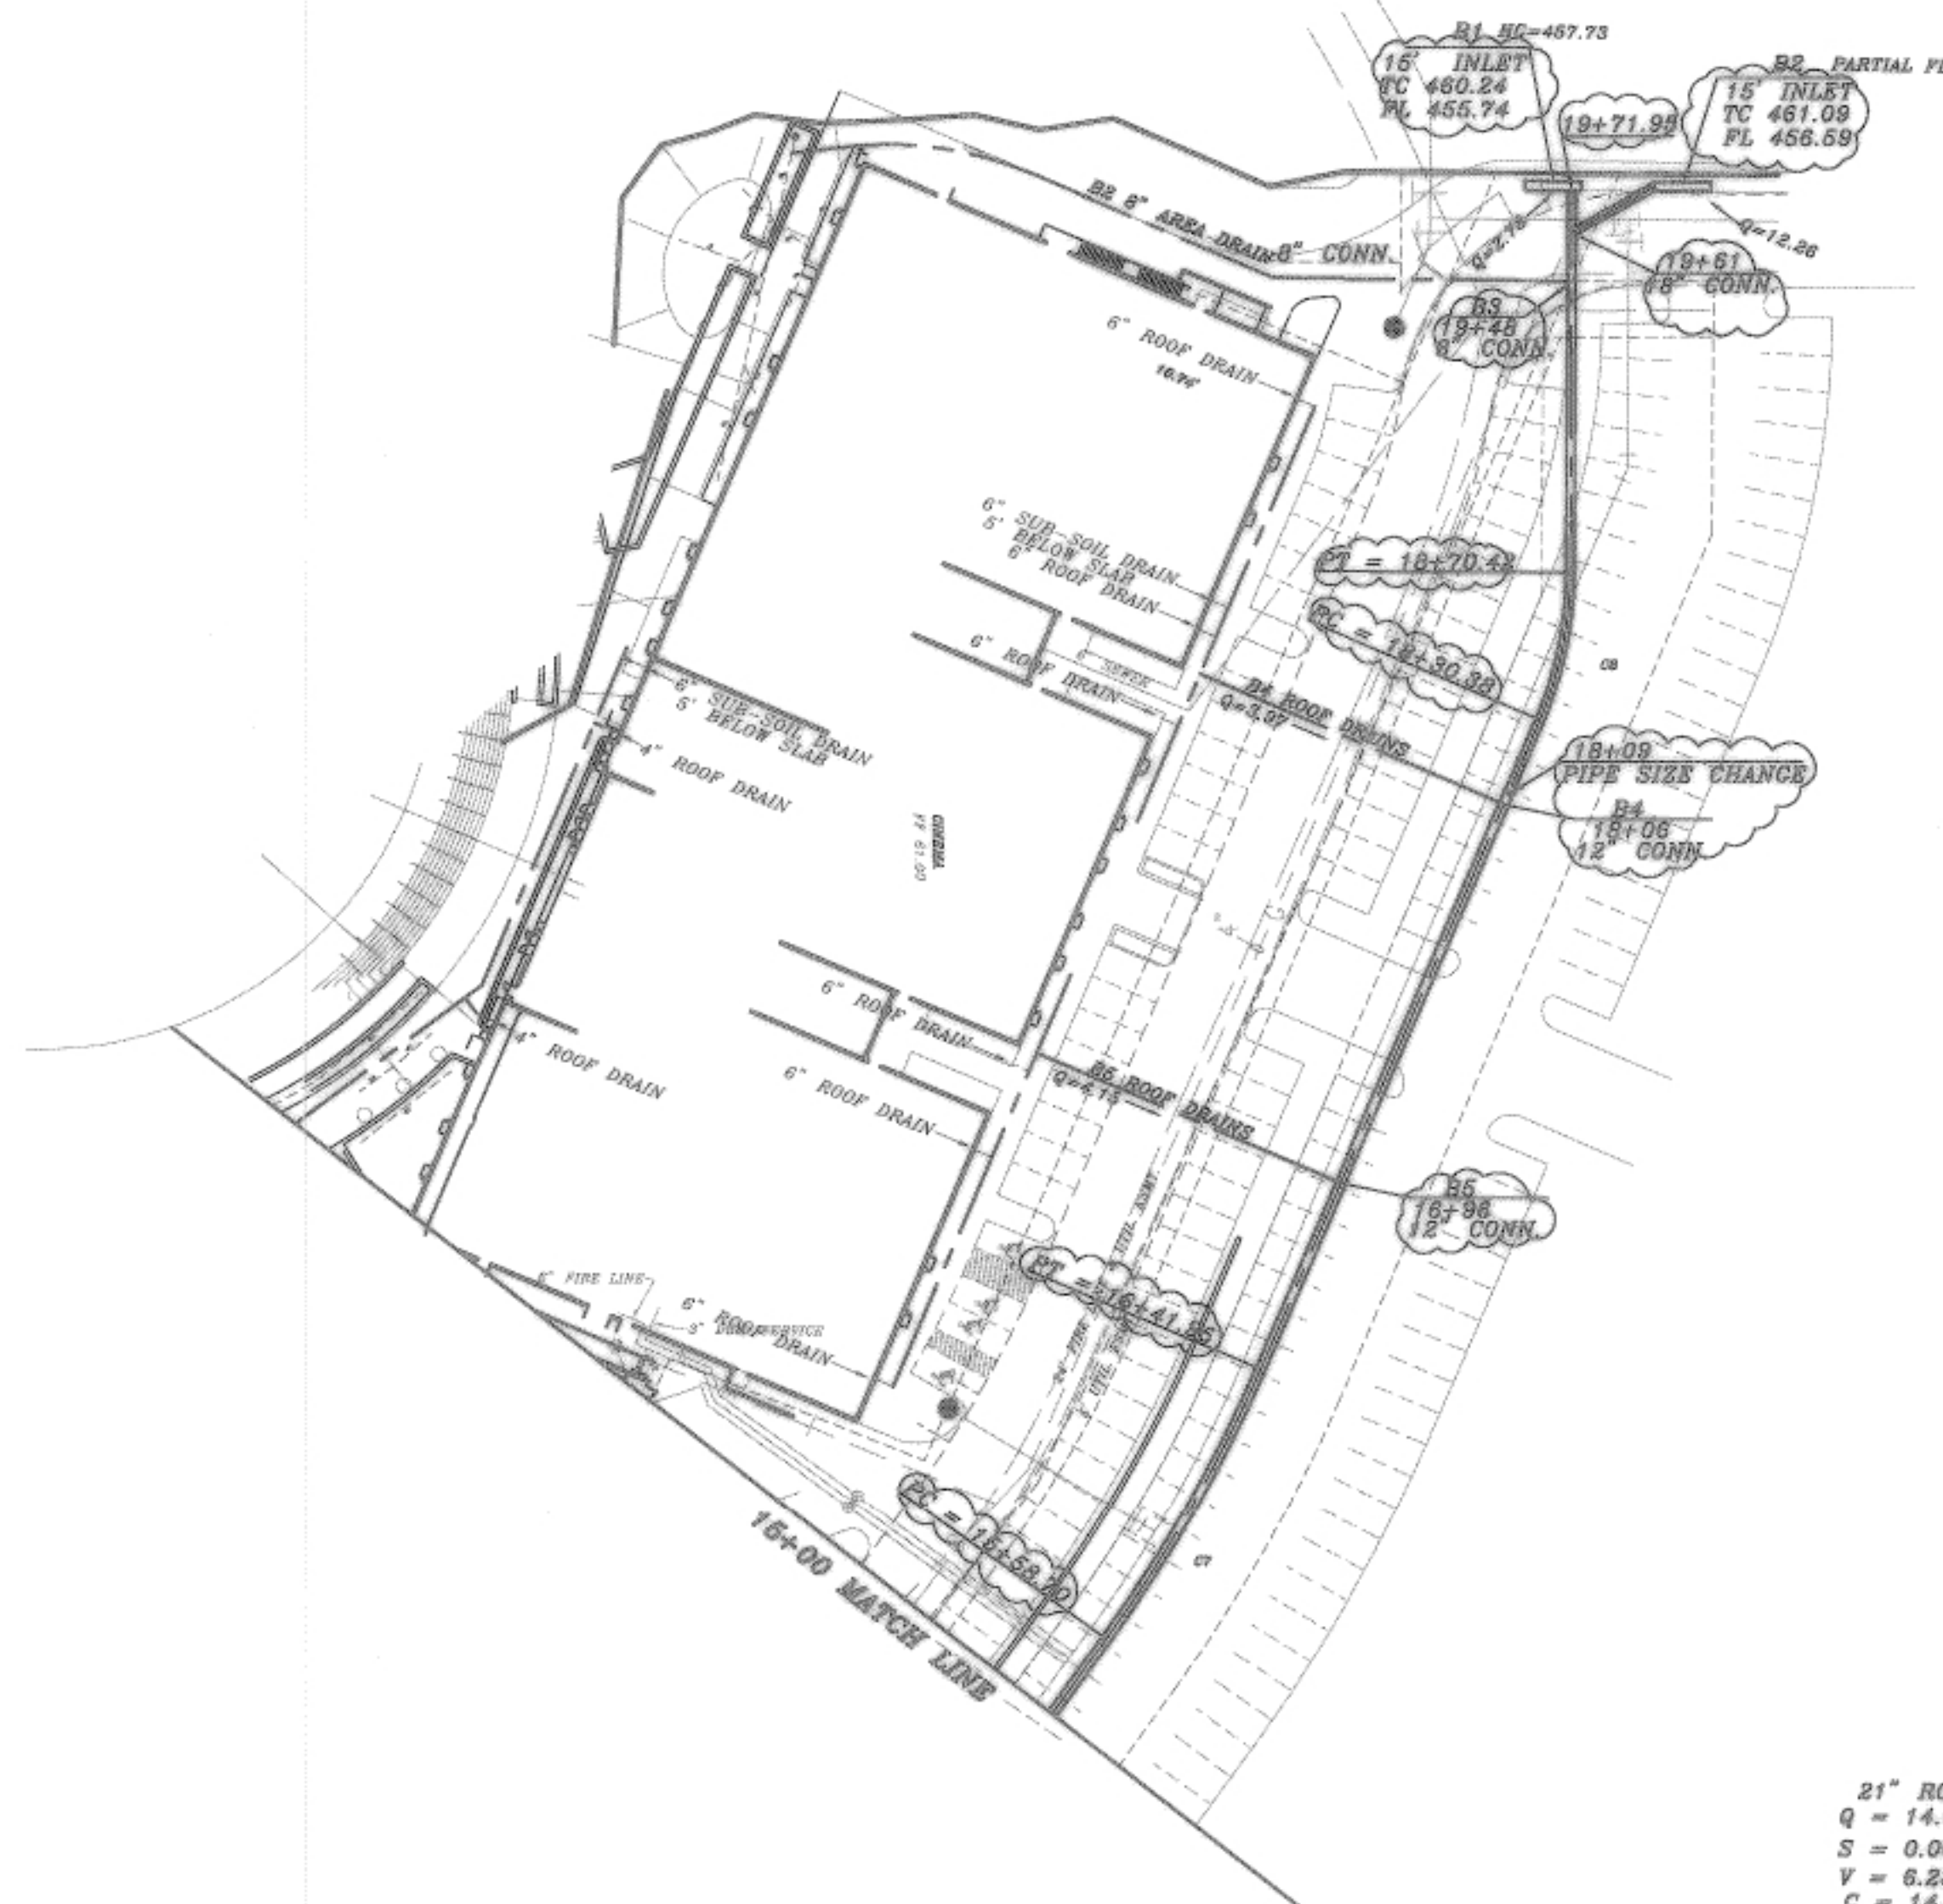

CURVE TABLE				
CURVE	DELTA	RADIUS	TANGENT	LENGTH
C7	12°30'26"	381.39	41.79	83.25
C8	22°58'39"	100.00	20.29	40.04

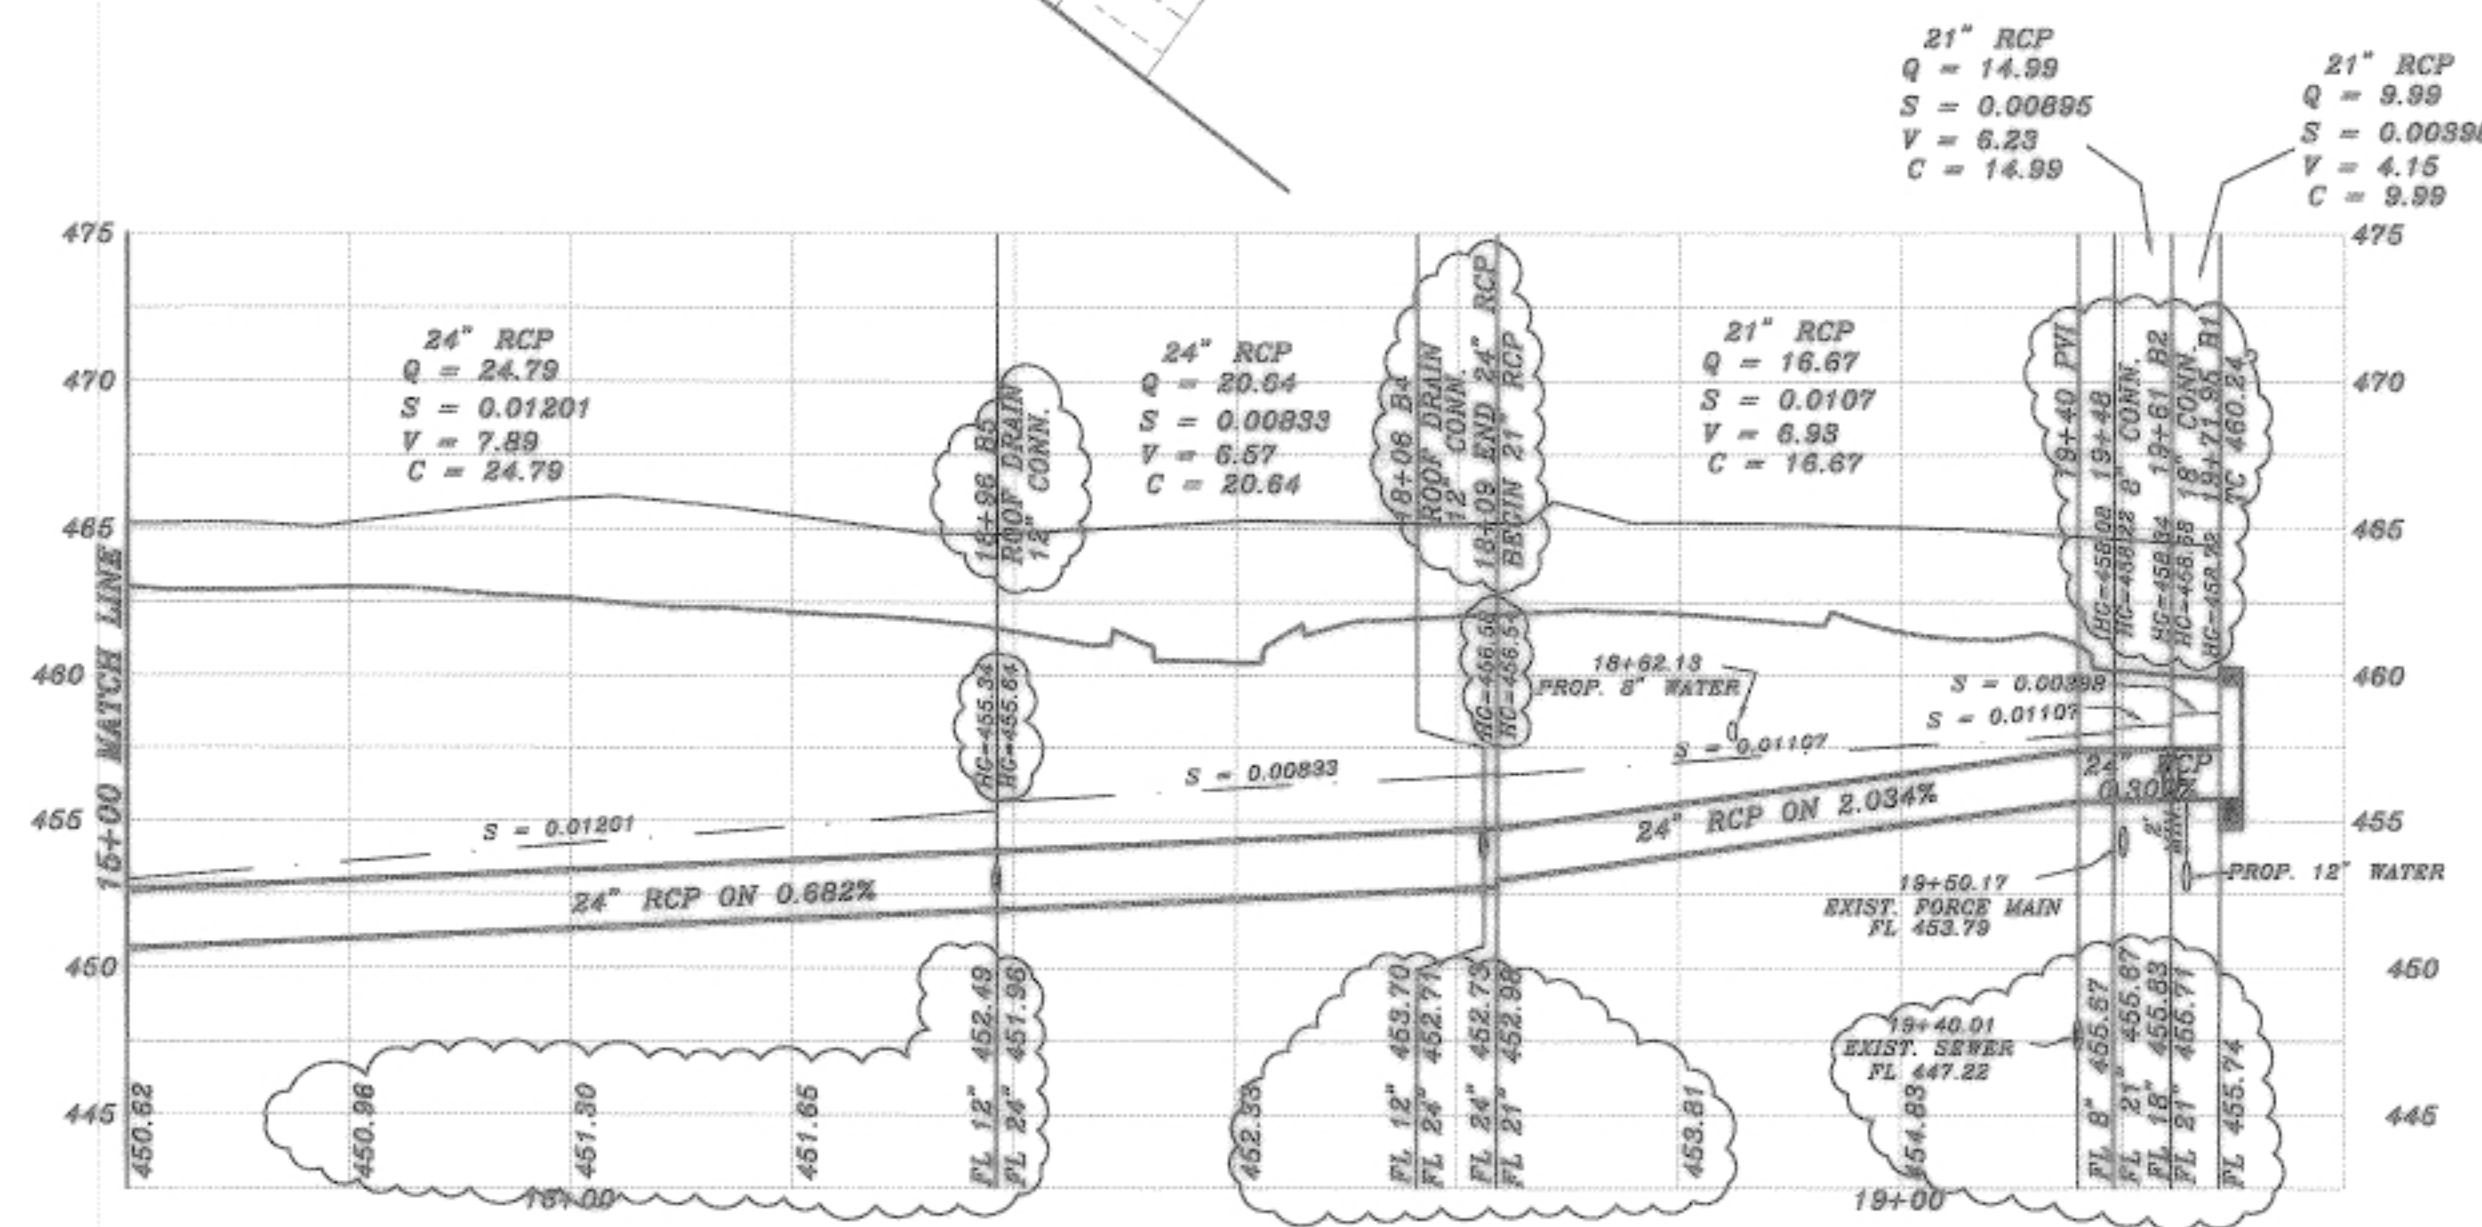

Received from Engineer
8/15/08
RECORD DRAWINGS

REV. _____ REV. _____ REV. _____ REV. _____ REV. _____	8/21/04 5/19/04 5/3/04 4/15/04 3/19/04	SOLID STRUCTURAL SOLUTIONS, INC. P.O. BOX 881800 HOUSTON, TX 77188-1800 PHONE: 814.417.8830 FAX: 872.888.5714	PROPOSED DRAINAGE LINE B THE HARBOR - ROCKWALL CITY OF ROCKWALL	SHEET NO. 17 26 JOB NO. 0136
REVISION DESCRIPTION 01360103		DATE SCALE 1" = 40' 1" = 8'	DESIGN H.L.B.	DRAWN