


CONTRACTOR(S) SHALL CALL "811" A MINIMUM OF 48 HOURS PRIOR TO BEGINNING WORK ON THE SITE, AND SHALL NOT BEGIN ANY EXCAVATION OR DEMOLITION ACTIVITES UNTIL AFTER SAID FACILITIES HAVE BEEN MARKED AND/OR FLAGGED, BOTH ONSITE AND OFFSITE,

CONTRACTOR(S) SHALL BE WHOLLY RESPONSIBLE FOR ANY DAMAGE

THAT MAY OCCUR TO SAID FACILITIES DUE TO WORK BEING DONE

PER "811" AND/OR THE FACILITY OWNERS.

WITHOUT FOLLOWING THE PROCEDURES ABOVE.

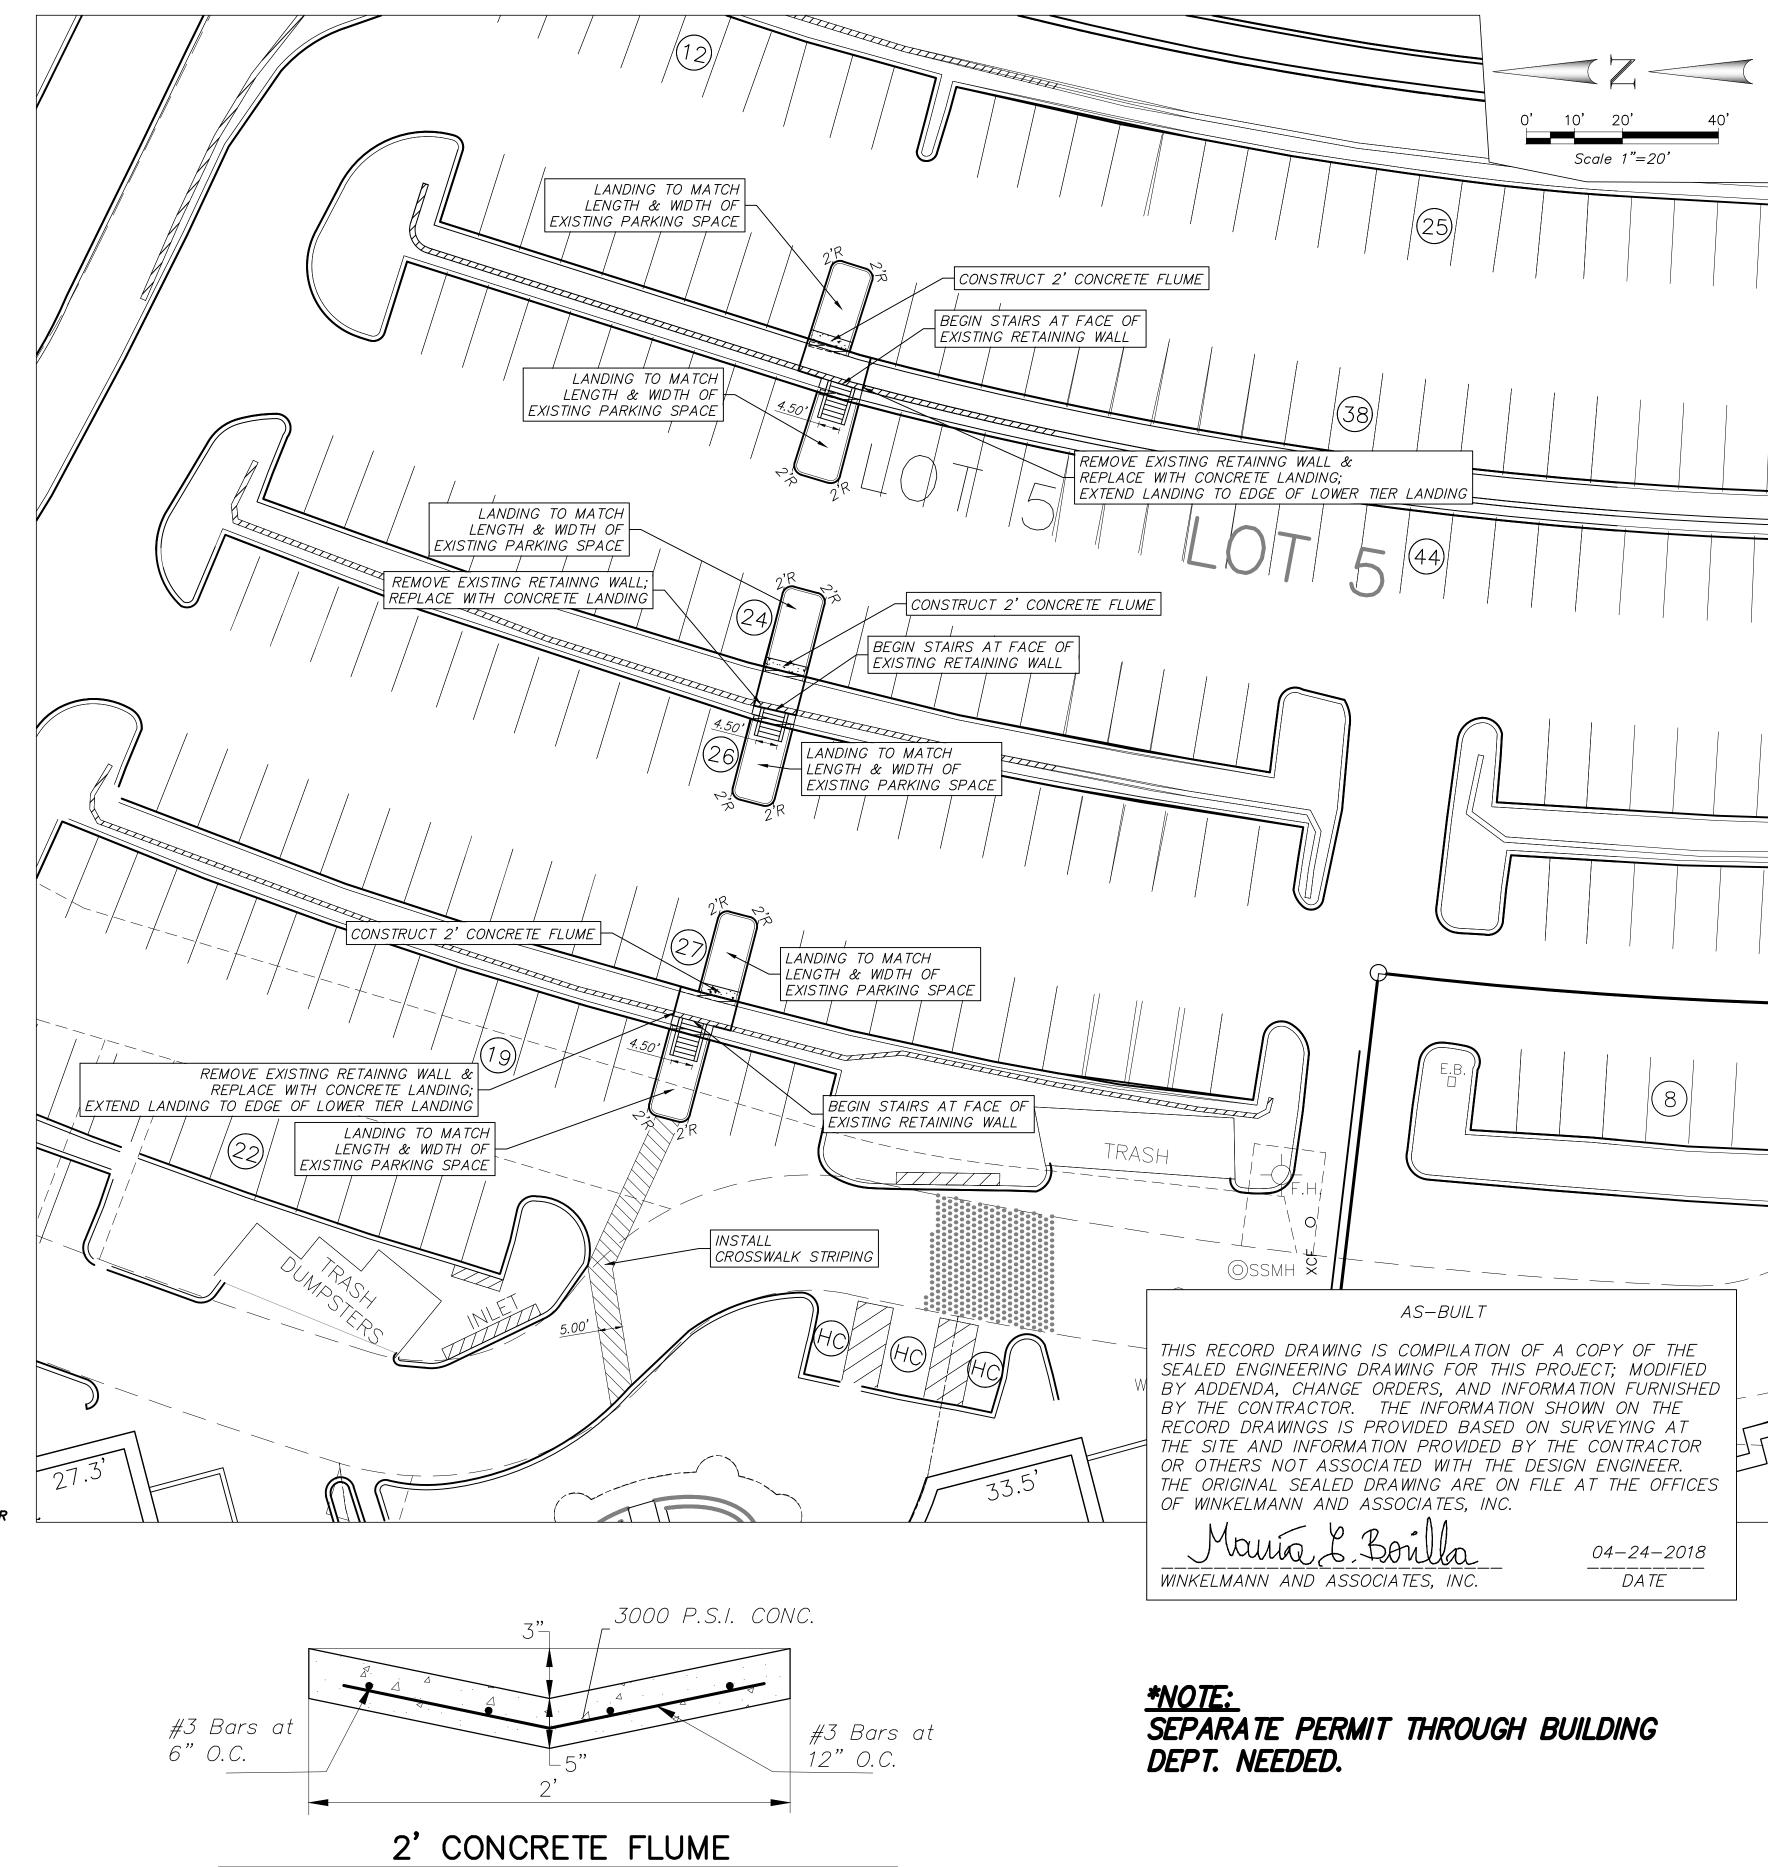

N.T.S.

180E DIMENSION CONTROL & PAVING PLAN 2 OF 2 HARBOR-ROCKWALL ADDITENAS C-04B