




7 RAIL TYPE R.1  
SECTION/ELEVATION SCALE: 1" = 1'-0"

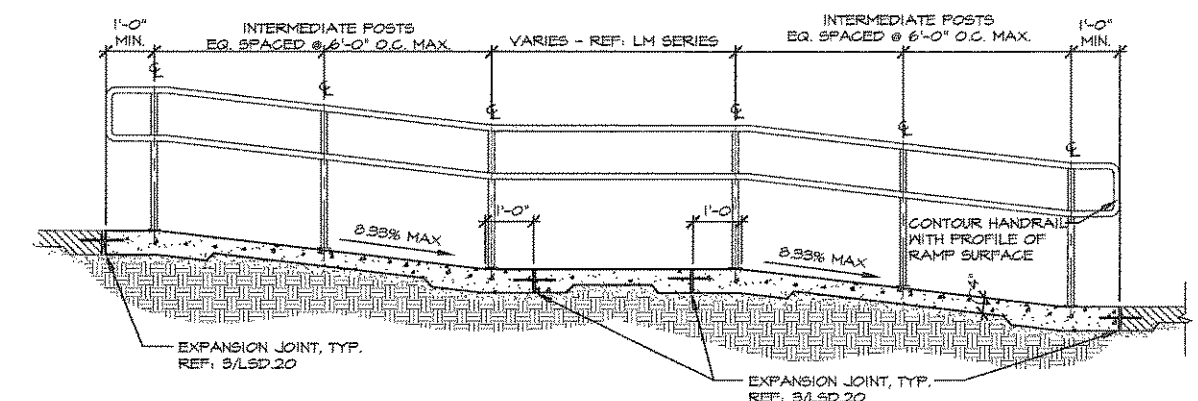


6 PROTOTYPICAL PEDESTRIAN RAMP @ LANDING  
ELEVATION SCALE: 1/2" = 1'-0"

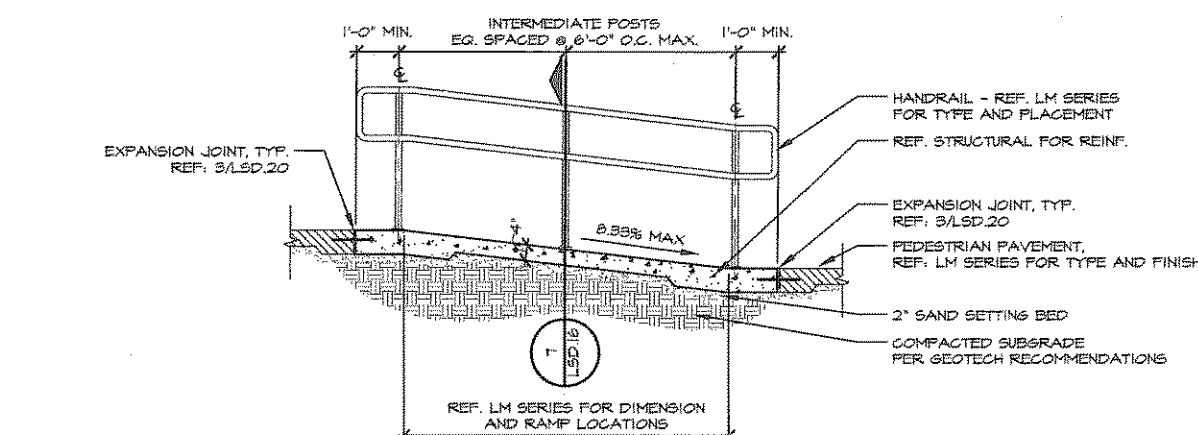


5 PROTOTYPICAL PEDESTRIAN RAMP  
SECTION SCALE: 1/2" = 1'-0"

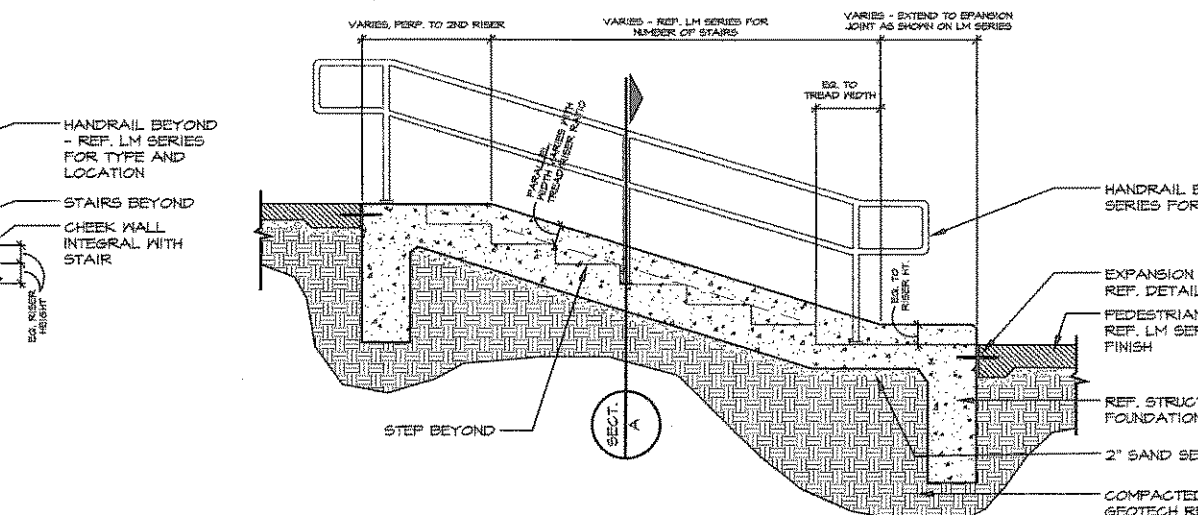


4 PROTOTYPICAL STAIR CHEEK WALL  
SECTION SCALE: 1" = 1'-0"

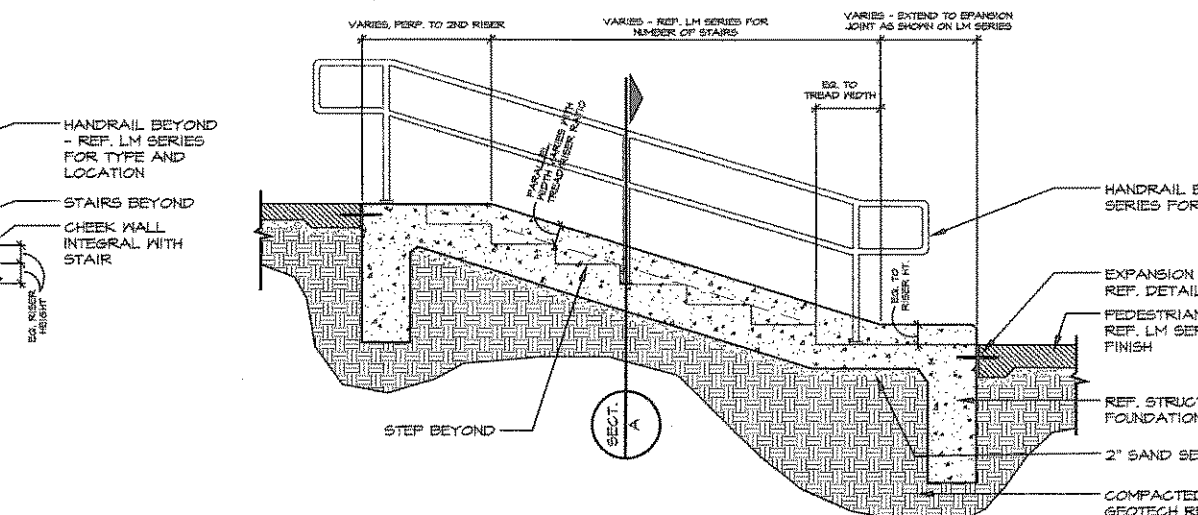


3 PEDESTRIAN STAIR - 4" RISER / 1'-4" TREAD  
SECTION SCALE: 1/2" = 1'-0"

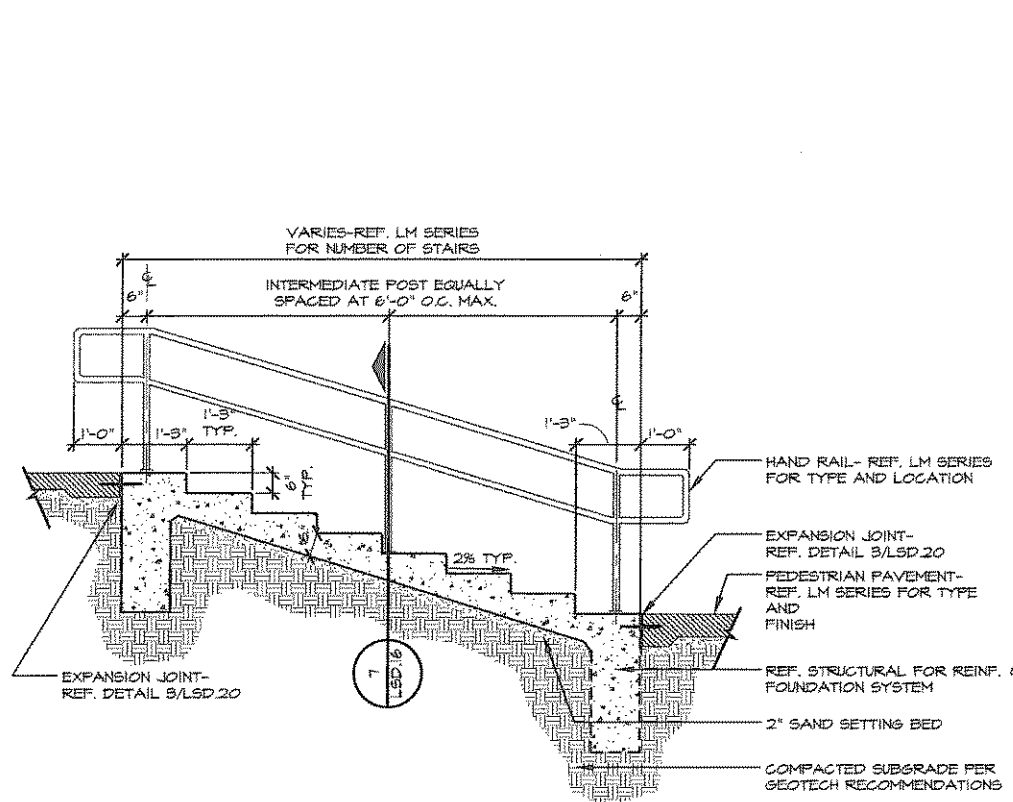

2 PEDESTRIAN STAIR - 6" RISER / 1'-3" TREAD  
SECTION SCALE: 1/2" = 1'-0"

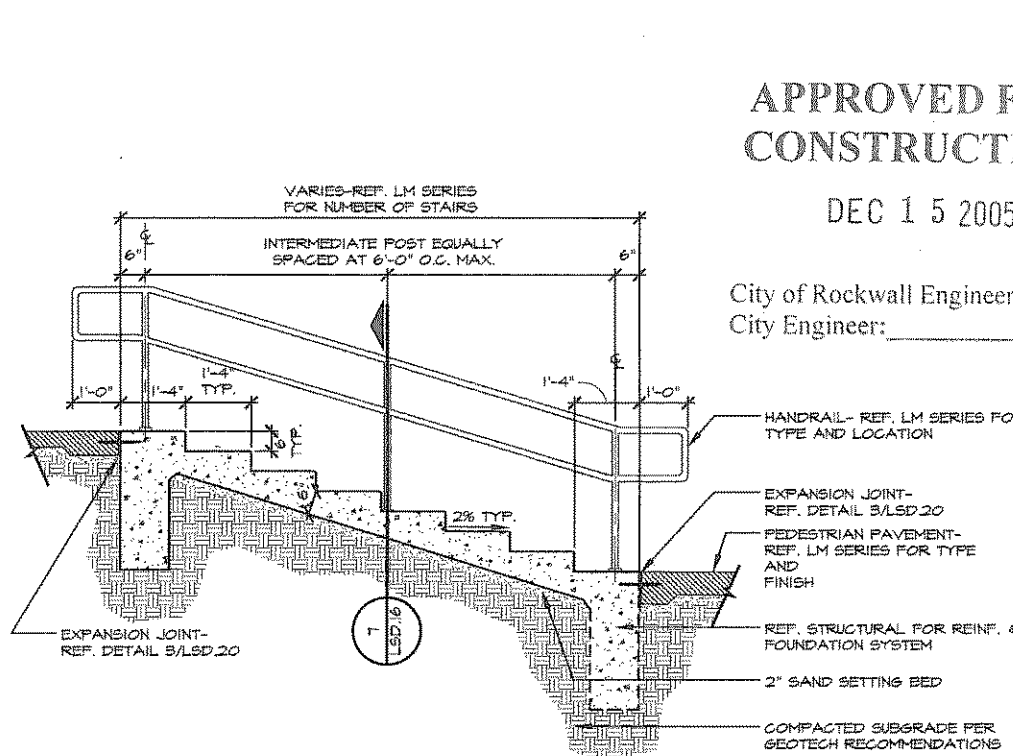

1 PEDESTRIAN STAIR - 6" RISER / 1'-4" TREAD  
SECTION SCALE: 1/2" = 1'-0"

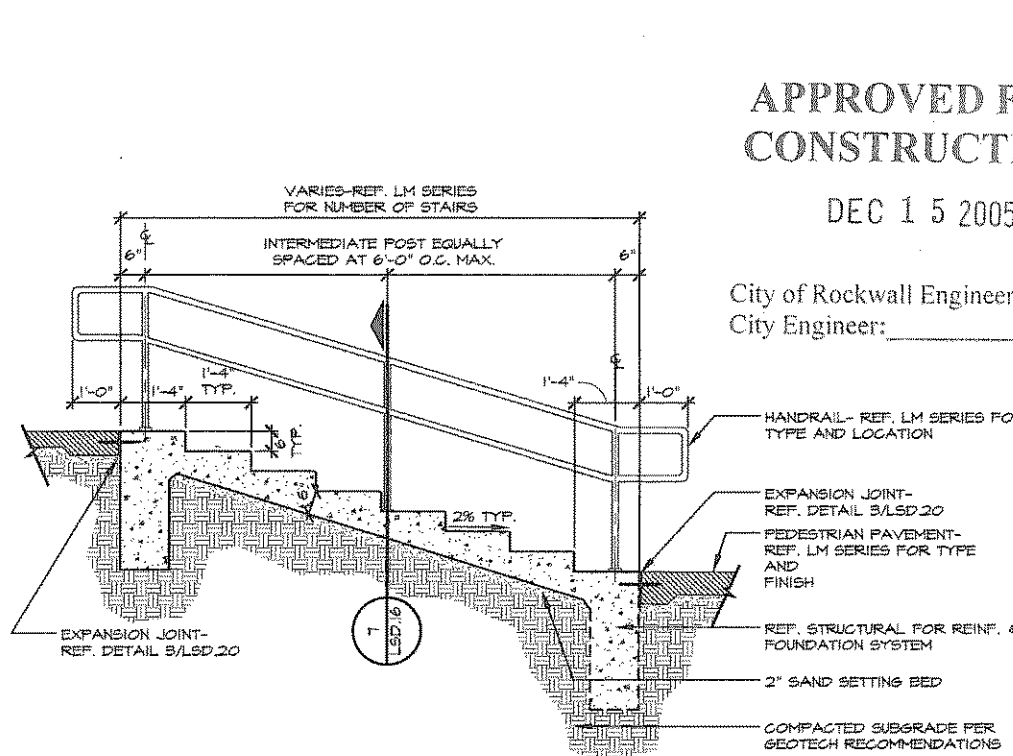

8 HARBOR RAMP PLAN ENLARGEMENT  
PLAN SCALE: 1/8" = 1'-0"

