


NOTE: FOR RETAINING WALL DETAILS & SECTIONS
SEE TBC PARTNERS PLANS.
FOR BUILDING DIMENSIONS AND LOCATIONS
SEE O'BRIEN AND ASSOCIATES ARCHITECTURAL PLANS.


NOTE: FOR RETAINING WALL DETAILS & SECTIONS
SEE TBC PARTNERS PLANS.

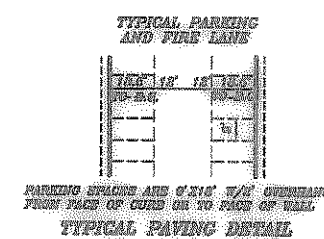


THE CURVE AND LINE TABLES DEPICTED
HEREON ARE FOR THIS SHEET ONLY

CURVE	DELTA	RADIUS	CURVE TABLE			DISTANCE
			TANGENT	LENGTH	BEARING	
C1	81°51'54"	780.00	805.91	1250.61	S00°31'07"E	1120.88
C2	7°19'28"	880.00	42.98	85.74	S40°58'32"E	85.88

LINE	DIRECTION	LENGTH
L1	N84°59'37"E	24.61
L2	N48°52'45"W	16.61
L3	N02°59'22"E	38.81
L4	N38°31'05"E	17.64
L5	N75°07'25"E	12.97
L6	N82°51'13"E	13.20
L7	S52°59'18"E	17.59
L8	N87°31'10"E	10.75
L9	N86°11'31"E	22.15
L10	S77°04'50"E	17.50
L11	N80°59'47"E	19.85
L12	S60°23'18"E	45.00
L13	N79°08'40"E	20.72

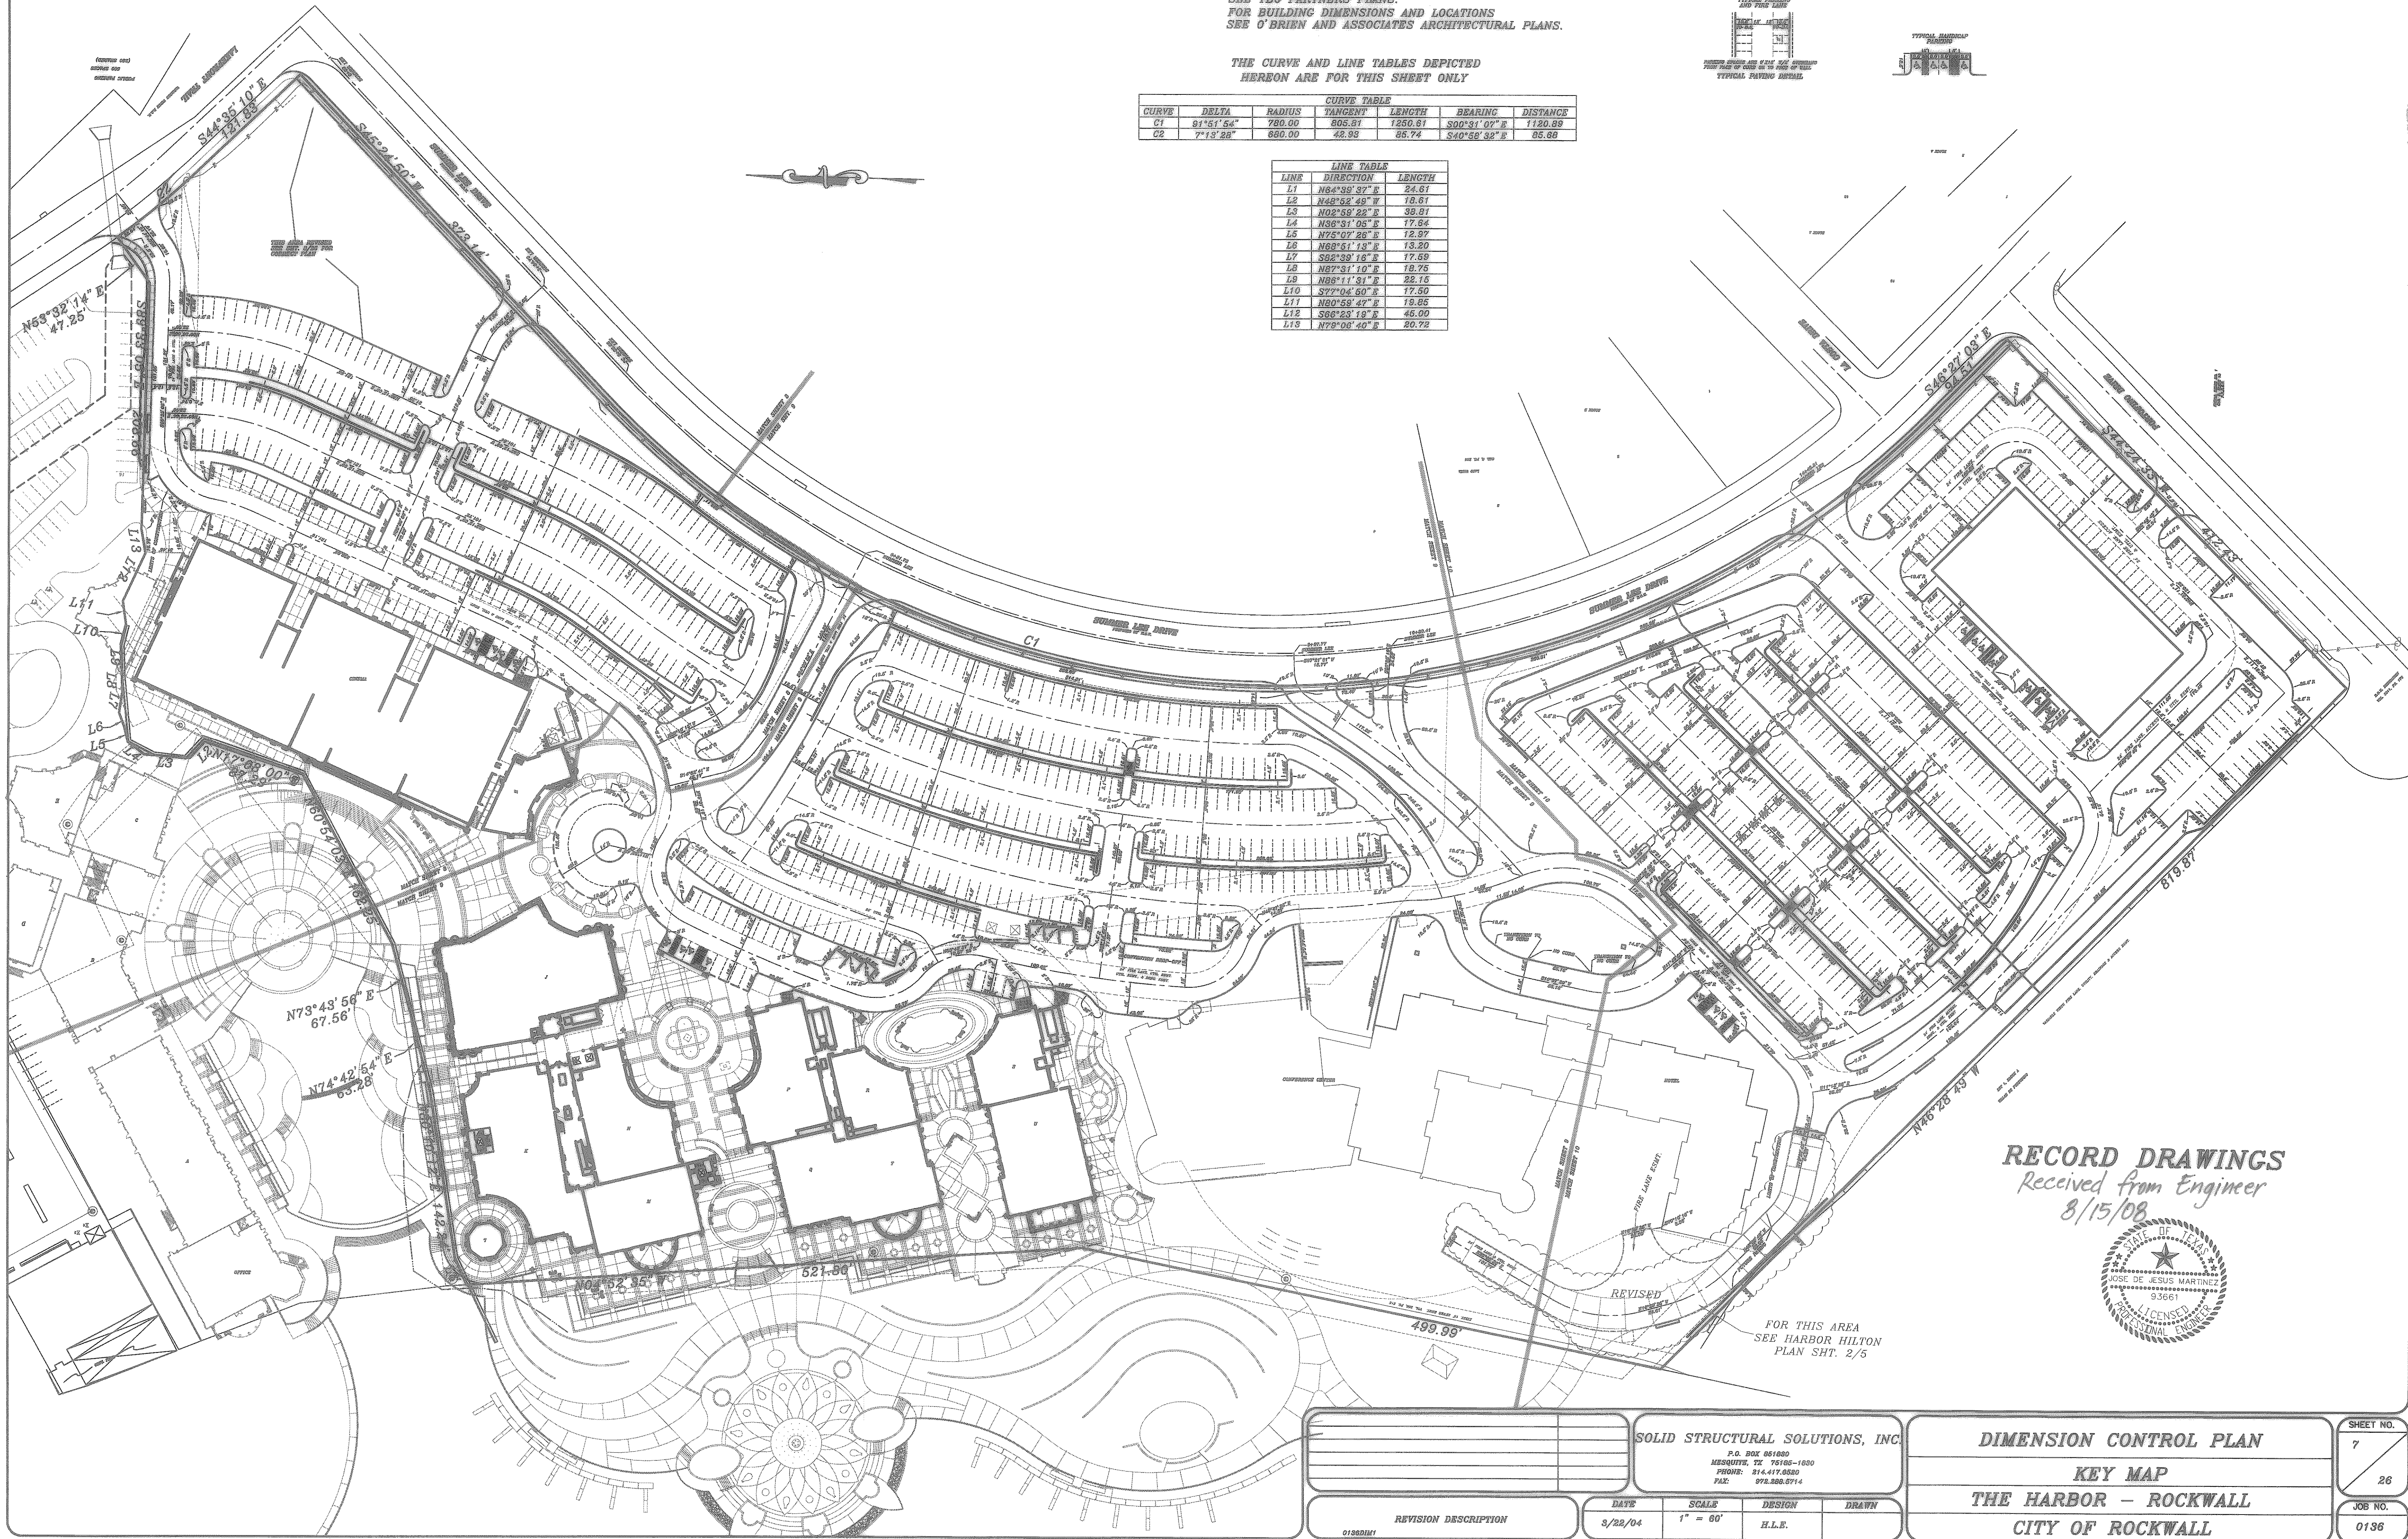

RECORD DRAWINGS
Received from Engineer
8/15/08

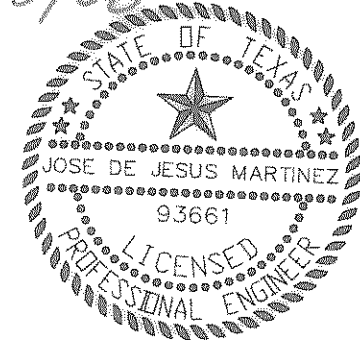

FOR THIS AREA
SEE HARBOR HILTON
PLAN SHT. 2/5

REVISION DESCRIPTION		DATE	SCALE	DESIGN	DRAWN
01580011		8/22/04	1" = 60'	H.L.B.	
SOLID STRUCTURAL SOLUTIONS, INC. P.O. BOX 051880 MESQUITE, TX 75165-1880 PHONE: 814.417.8580 FAX: 972.288.6714					
DIMENSION CONTROL PLAN KEY MAP THE HARBOR - ROCKWALL CITY OF ROCKWALL					
SHEET NO. 7 26 JOB NO. 0136					