
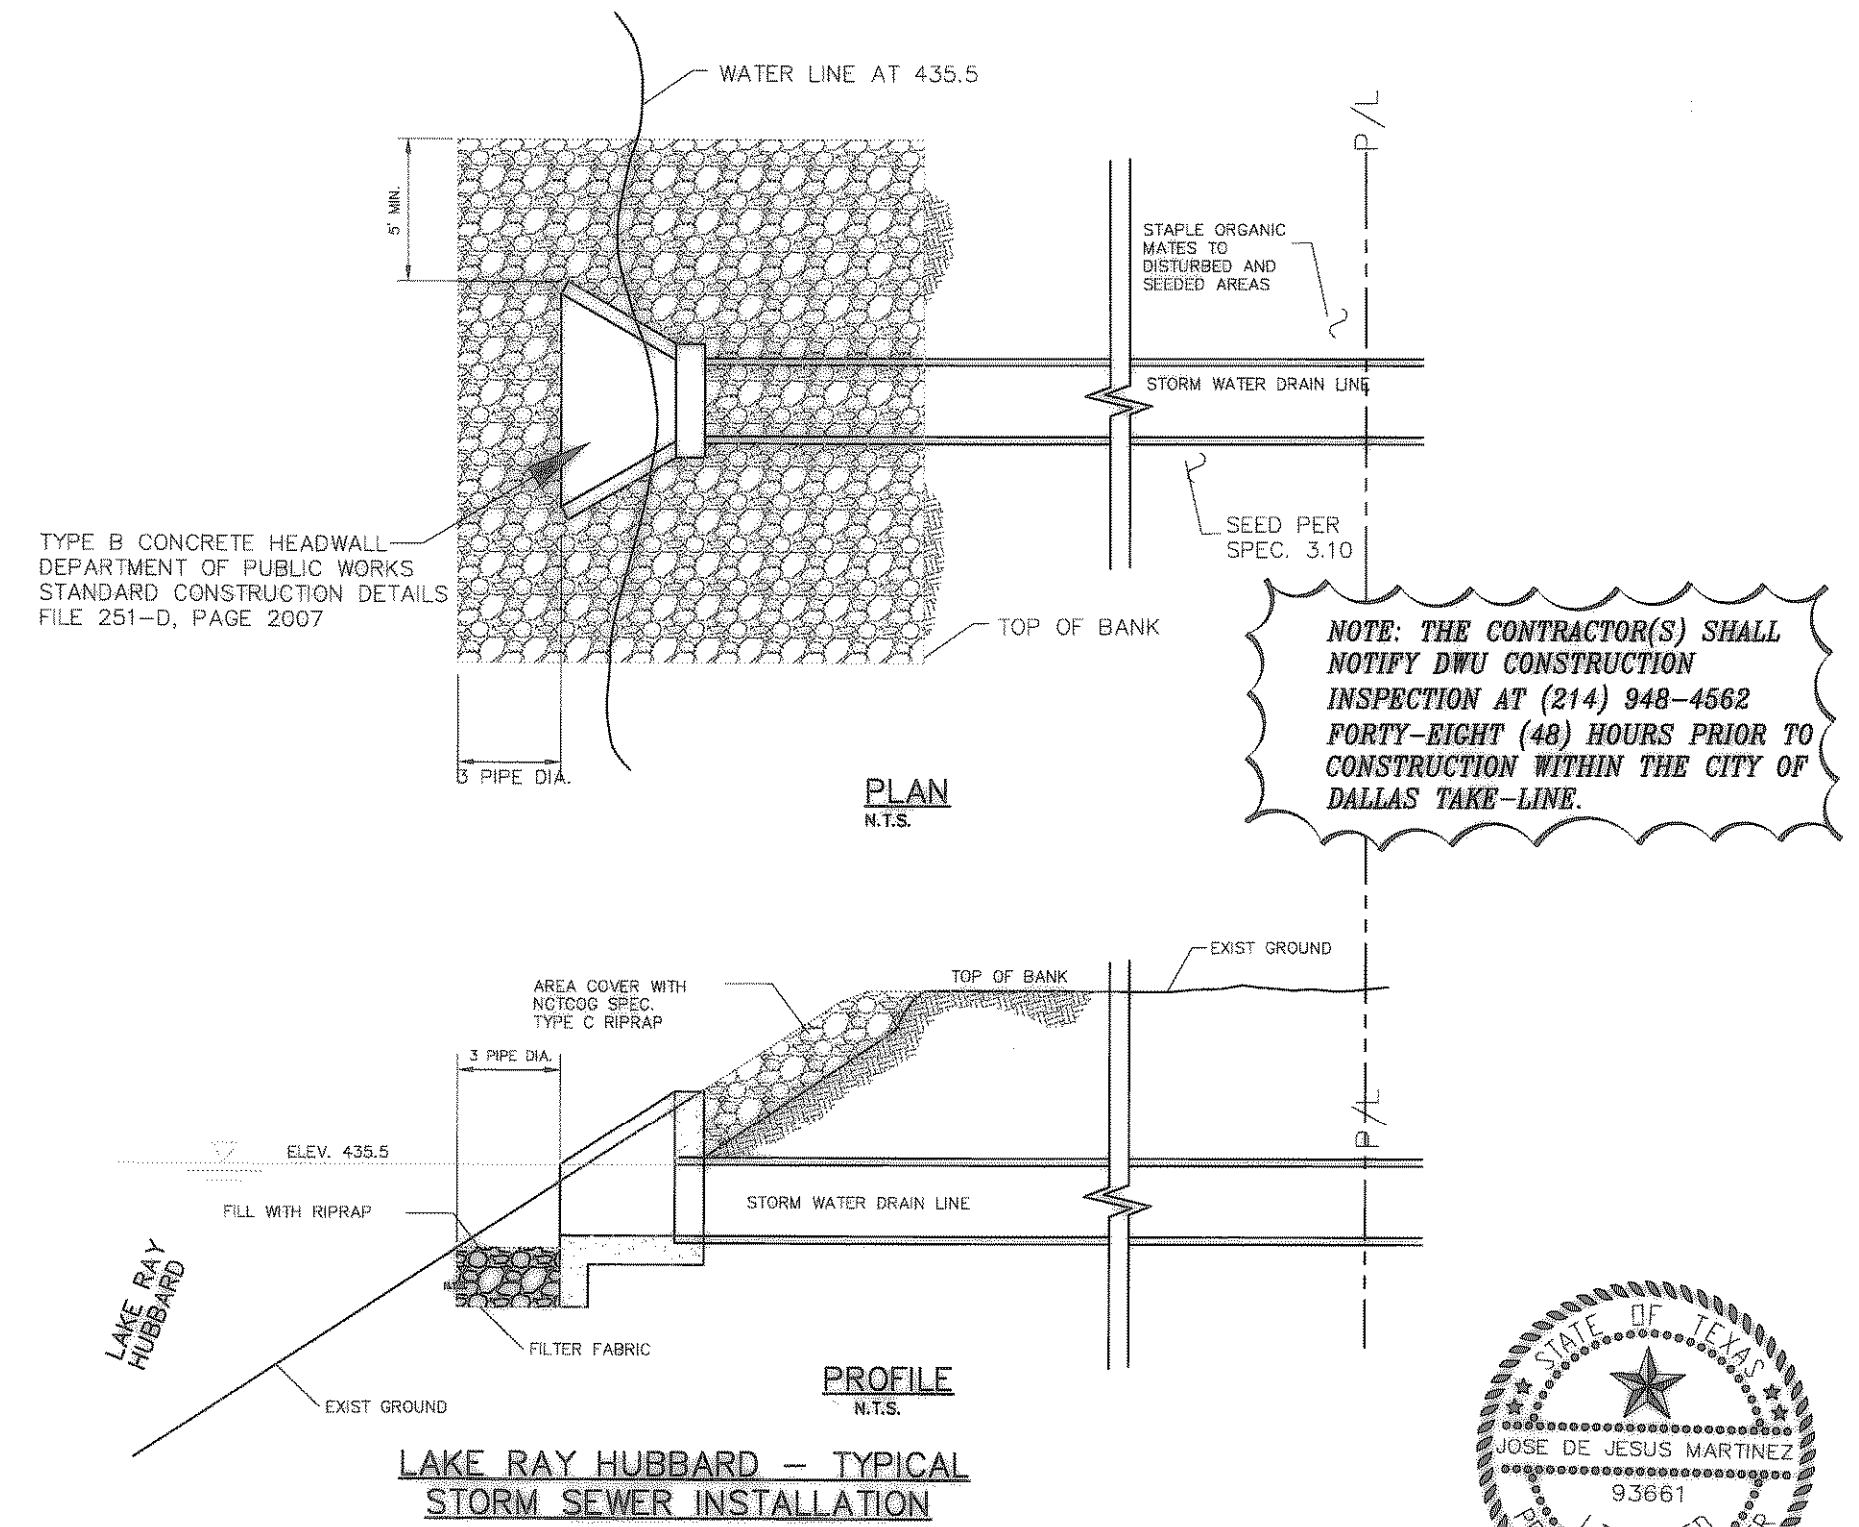
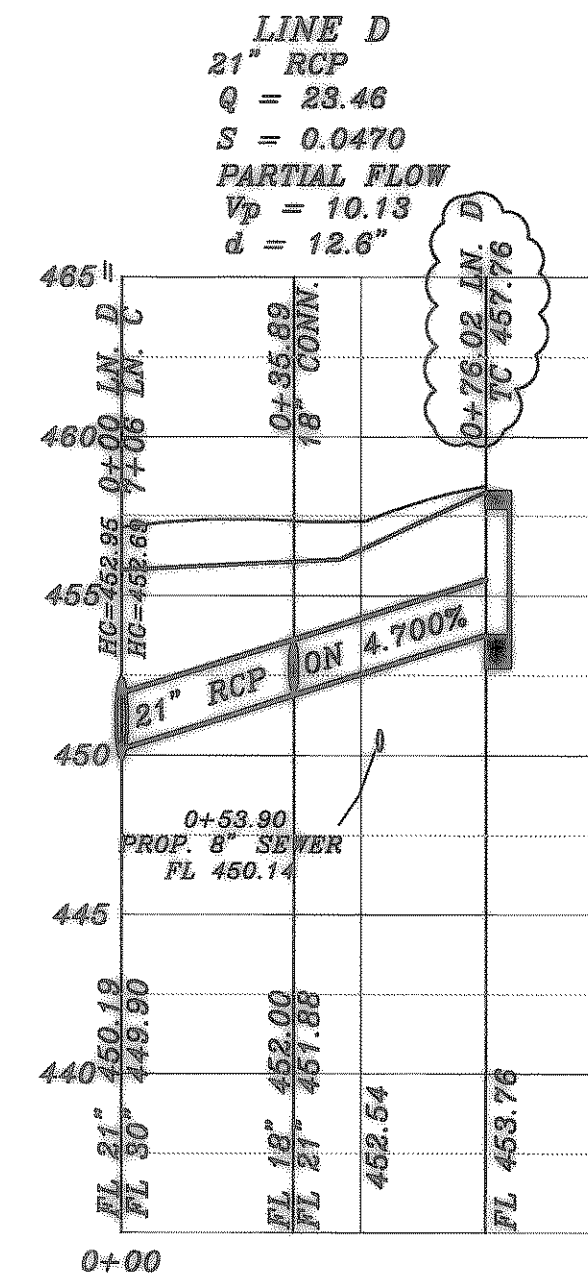


CURVE TABLE					
CURVE	DELTA	RADIUS	TANGENT	LENGTH	BEARING
C1	44°24'00"	100.00	43.31	77.48	N89°40'49" W
C2	7°55'51"	254.00	17.51	35.16	S50°26'45" E
C3	81°13'06"	90.00	77.16	127.58	N84°58'49" E
C4	20°39'24"	100.00	18.22	36.05	S54°46'19" W
C5	20°33'52"	100.00	18.14	35.89	N30°23'52" W
C6	11°10'03"	58.50	5.72	11.40	S25°41'58" E
C7	16°27'38"	100.00	14.48	28.73	N28°03'11" W

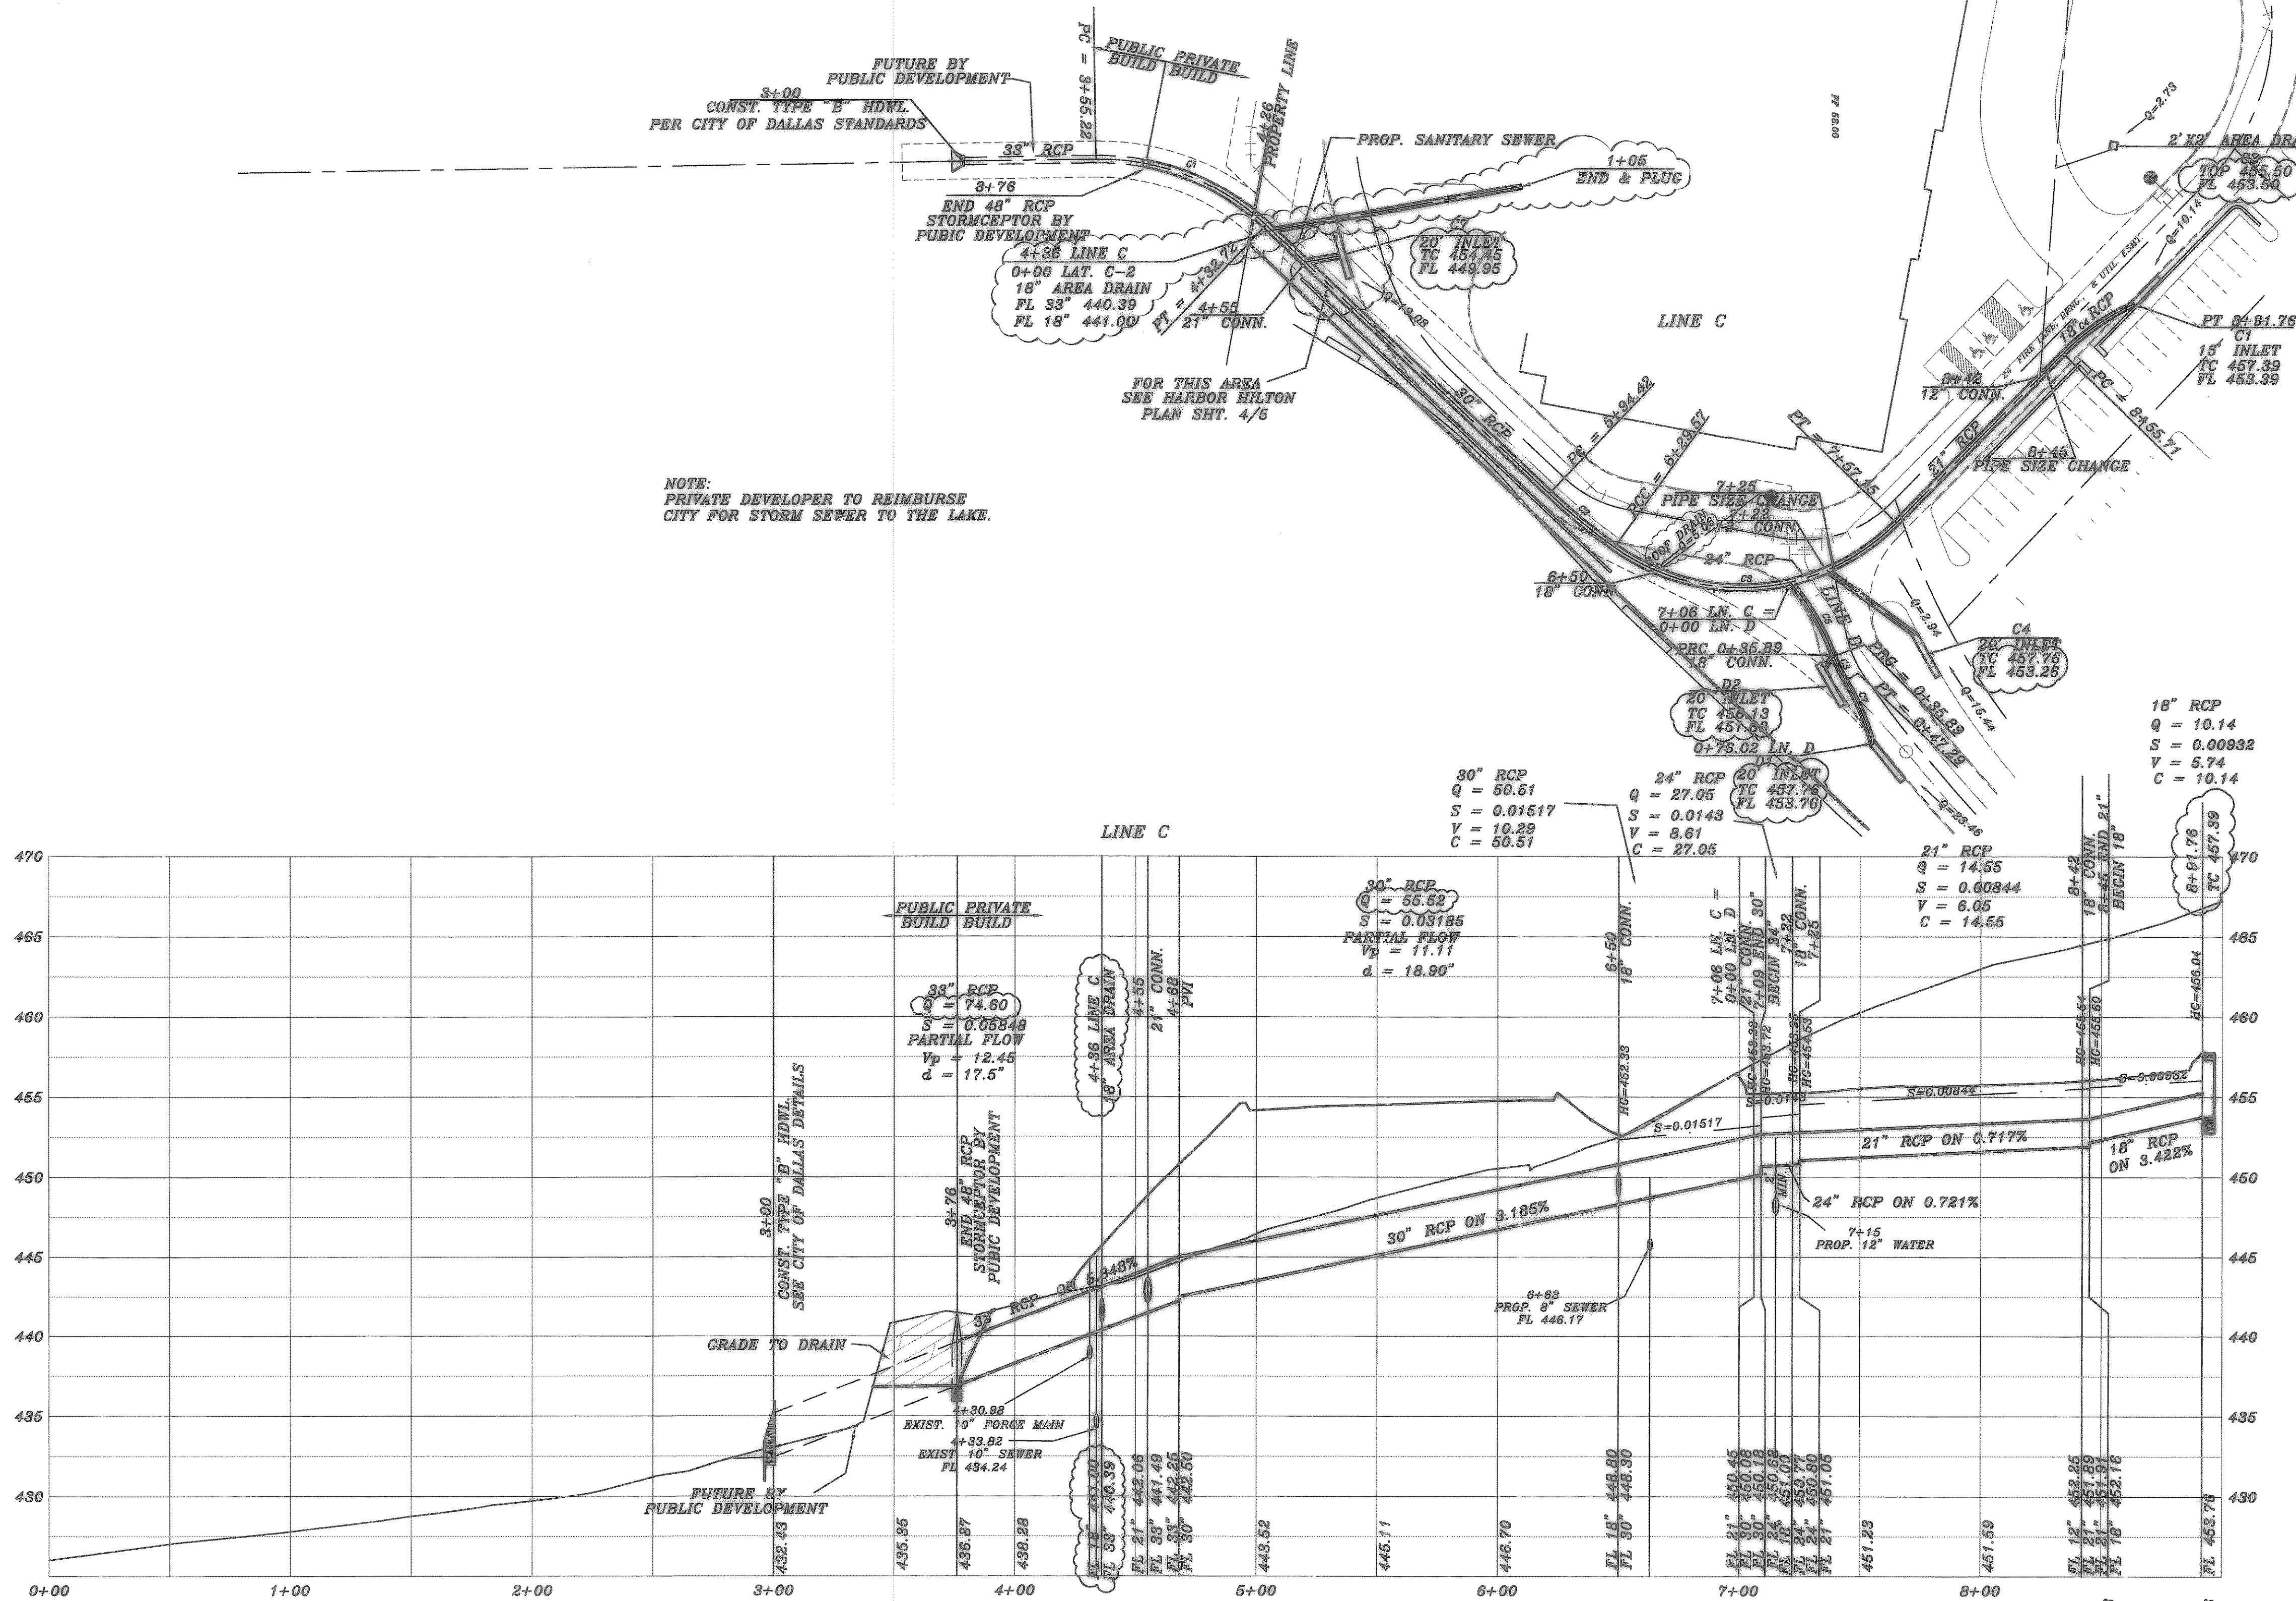

Received from Engineer ~ 8/15/08
RECORD DRAWINGS

REV.	REVISION DESCRIPTION	DATE	SCALE	DESIGN	DRAWN
REV.		7/25/05			
REV.		7/27/04			
REV.		5/14/04			
REV.		4/15/04			
REV.		3/30/04			
REV.		3/22/04			

SOLID STRUCTURAL SOLUTIONS, INC.
P.O. BOX 551030
MESQUITE, TX 76155-1030
PHONE: 214-417-6250
FAX: 972-388-5714

PROPOSED DRAINAGE		SHEET NO.
LINE C & LINE D		19
THE HARBOR - ROCKWALL		26
CITY OF ROCKWALL		JOB NO.
		0136

