


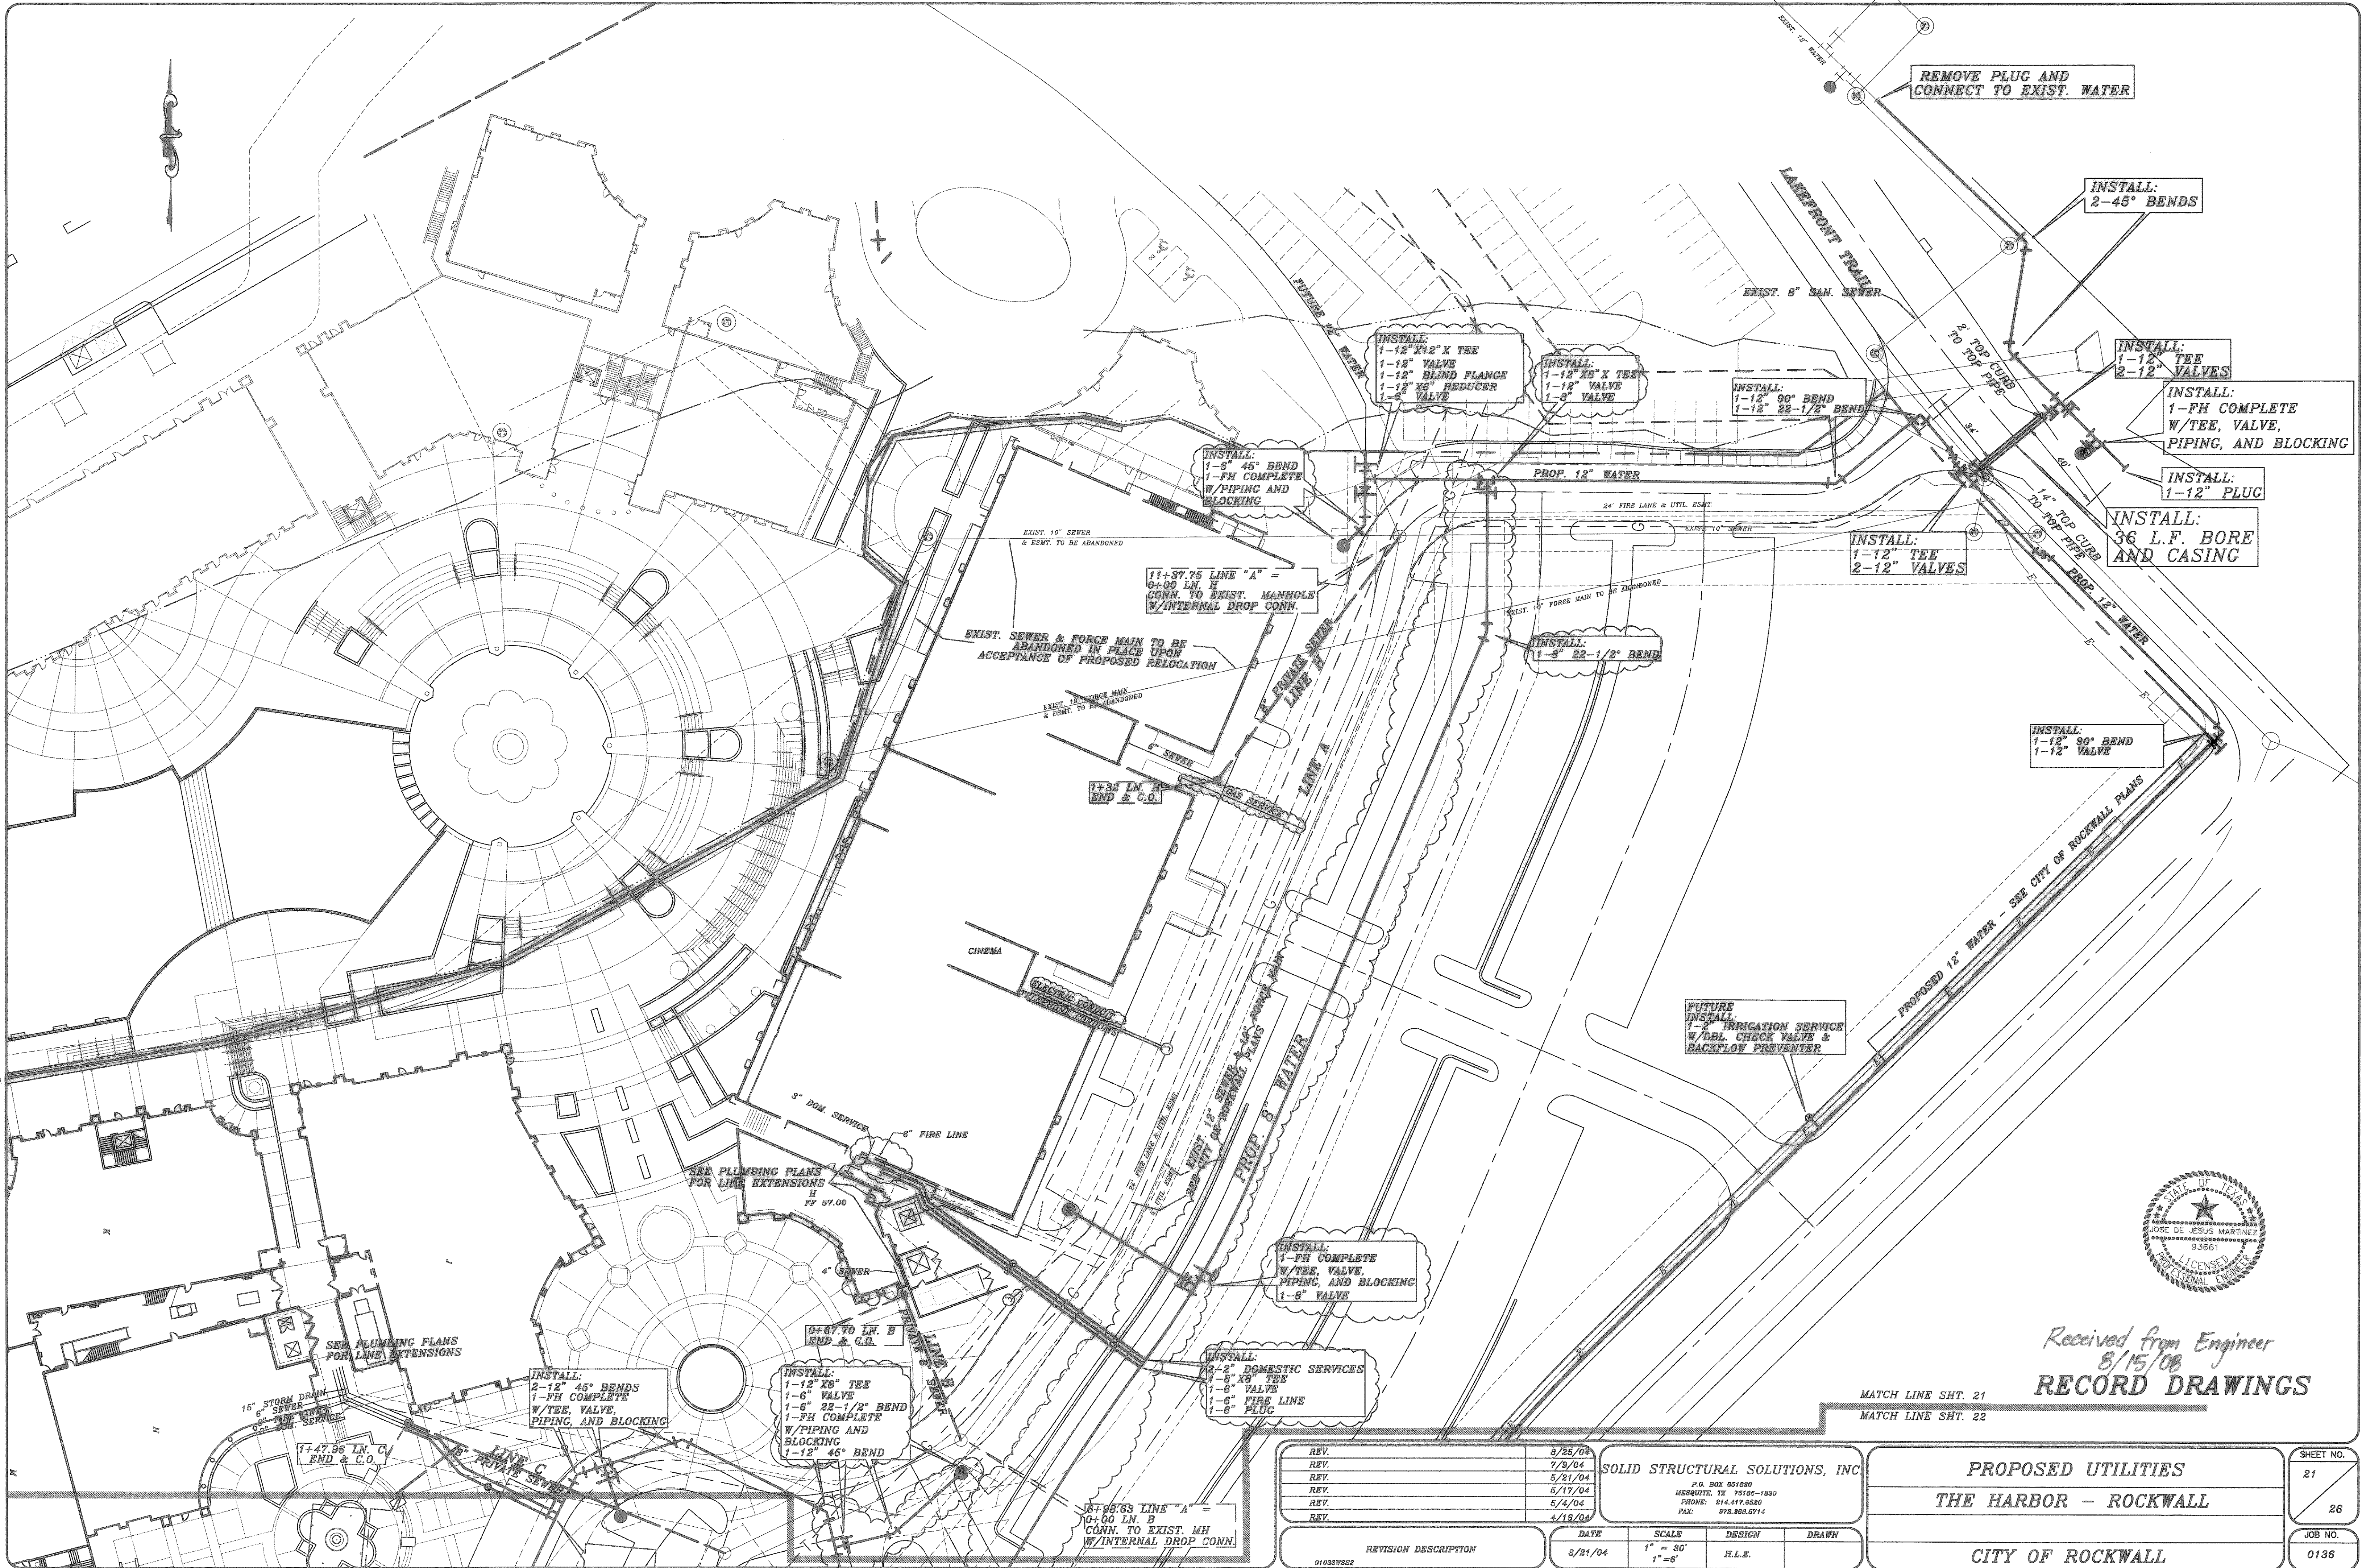

Received from Engineer
8/15/08
RECORD DRAWINGS

MATCH LINE SHT. 21
MATCH LINE SHT. 22

REV.	3/25/04
REV.	7/9/04
REV.	5/21/04
REV.	5/17/04
REV.	5/4/04
REV.	4/15/04

SOLID STRUCTURAL SOLUTIONS, INC.
P.O. BOX 061690
MESQUITE, TX 75165-1690
PHONE: 514.417.0650
FAX: 972.868.5714

REVISION DESCRIPTION	DATE	SCALE	DESIGN	DRAWN
01086VSS2	3/21/04	1" = 30' 1" = 6"	R.L.E.	

PROPOSED UTILITIES THE HARBOR - ROCKWALL	SHEET NO. 21
CITY OF ROCKWALL	JOB NO. 0136