

SUMMER LEE DRIVE

PROPOSED 12" WATER - SEE CITY OF ROCKWALL PLANS

INCLUDED IN HARBOR CONSTRUCTION

INSTALL:
1-12" VALVE
1-12" BLIND FLANGE
1-8" IRRIGATION SERVICE
W/DBL. CHECK VALVE &
BACKFLOW PREVENTER
1-12" 45° BEND

INSTALL:
2-8" 45° BENDS

INSTALL:
1-12" X12" TEE
1-12" 45° BEND
1-12" VALVE
1-12" X8" REDUCER
1-8" VALVE

INSTALL:
1-FH COMPLETE
W/TEE, VALVE,
PIPING, AND BLOCKING

INSTALL:
1-FH COMPLETE
W/TEE, VALVE,
PIPING, AND BLOCKING
1-12" VALVE

INSTALL:
2-12" 45° BENDS

INSTALL:
1-FH COMPLETE
W/TEE, VALVE,
PIPING, AND BLOCKING
1-12" X12" TEE
1-12" VALVE
1-12" X8" REDUCER
1-8" VALVE

21-56.44 LINE "A" =
0+00 LN. E & 0+00 LN. G
CONN. TO EXIST. MH WITH
INTERNAL DROP CONNECTION

CONVENTION DROP-OFF

LINE E
8" PRIVATE SEWER

LINE G
8" PRIVATE SEWER

INSTALL:
1-FH COMPLETE
W/TEE, VALVE,
PIPING, AND BLOCKING

0+47.26 LN. G
1-12" 45° BEND

0+85.37 LN. G
INSTALL C.O.

0+97.68 LN. G
END AND PLUG

INSTALL:
1-FH COMPLETE
W/TEE, VALVE,
PIPING, AND BLOCKING
1-12" 45° BEND
1-12" VALVE

1-12" 45° BEND
1-12" VALVE
1-12" X8" REDUCER
1-8" VALVE

1-12" 45° BEND
1-12" VALVE
1-12" X8" REDUCER
1-8" VALVE

INSTALL:
1-FH COMPLETE
W/TEE, VALVE,
PIPING, AND BLOCKING

1-12" 45° BEND
1-12" VALVE
1-12" X8" REDUCER
1-8" VALVE

1-12" 45° BEND
1-12" VALVE
1-12" X8" REDUCER
1-8" VALVE


1-12" 45° BEND
1-12" VALVE
1-12" X8" REDUCER
1-8" VALVE

1-12" 45° BEND
1-12" VALVE
1-12" X8" REDUCER
1-8" VALVE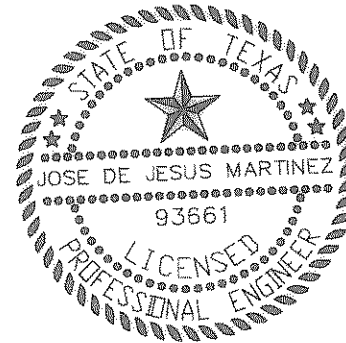

Received from Engineer - 8/15/08
RECORD DRAWINGS

REV.	LINE D	DATE
1	ADDED SEWER SERVICE FOR BLOC	1/10/04
2		10/19/04
3		10/2/04
4		8/25/04
5		7/9/04
6		5/17/04
7		5/4/04

SOLID STRUCTURAL SOLUTIONS, INC.
P.O. BOX 651080
MESQUITE, TX 75165-1080
PHONE: 214.417.6620
FAX: 972.288.5714

REVISION DESCRIPTION	DATE	SCALE	DESIGN	DRAWN
	3/21/04	1" = 30'	H.L.E.	

PROPOSED UTILITIES		SHEET NO.
THE HARBOR - ROCKWALL		22
CITY OF ROCKWALL		26
		JOB NO.
		0136