


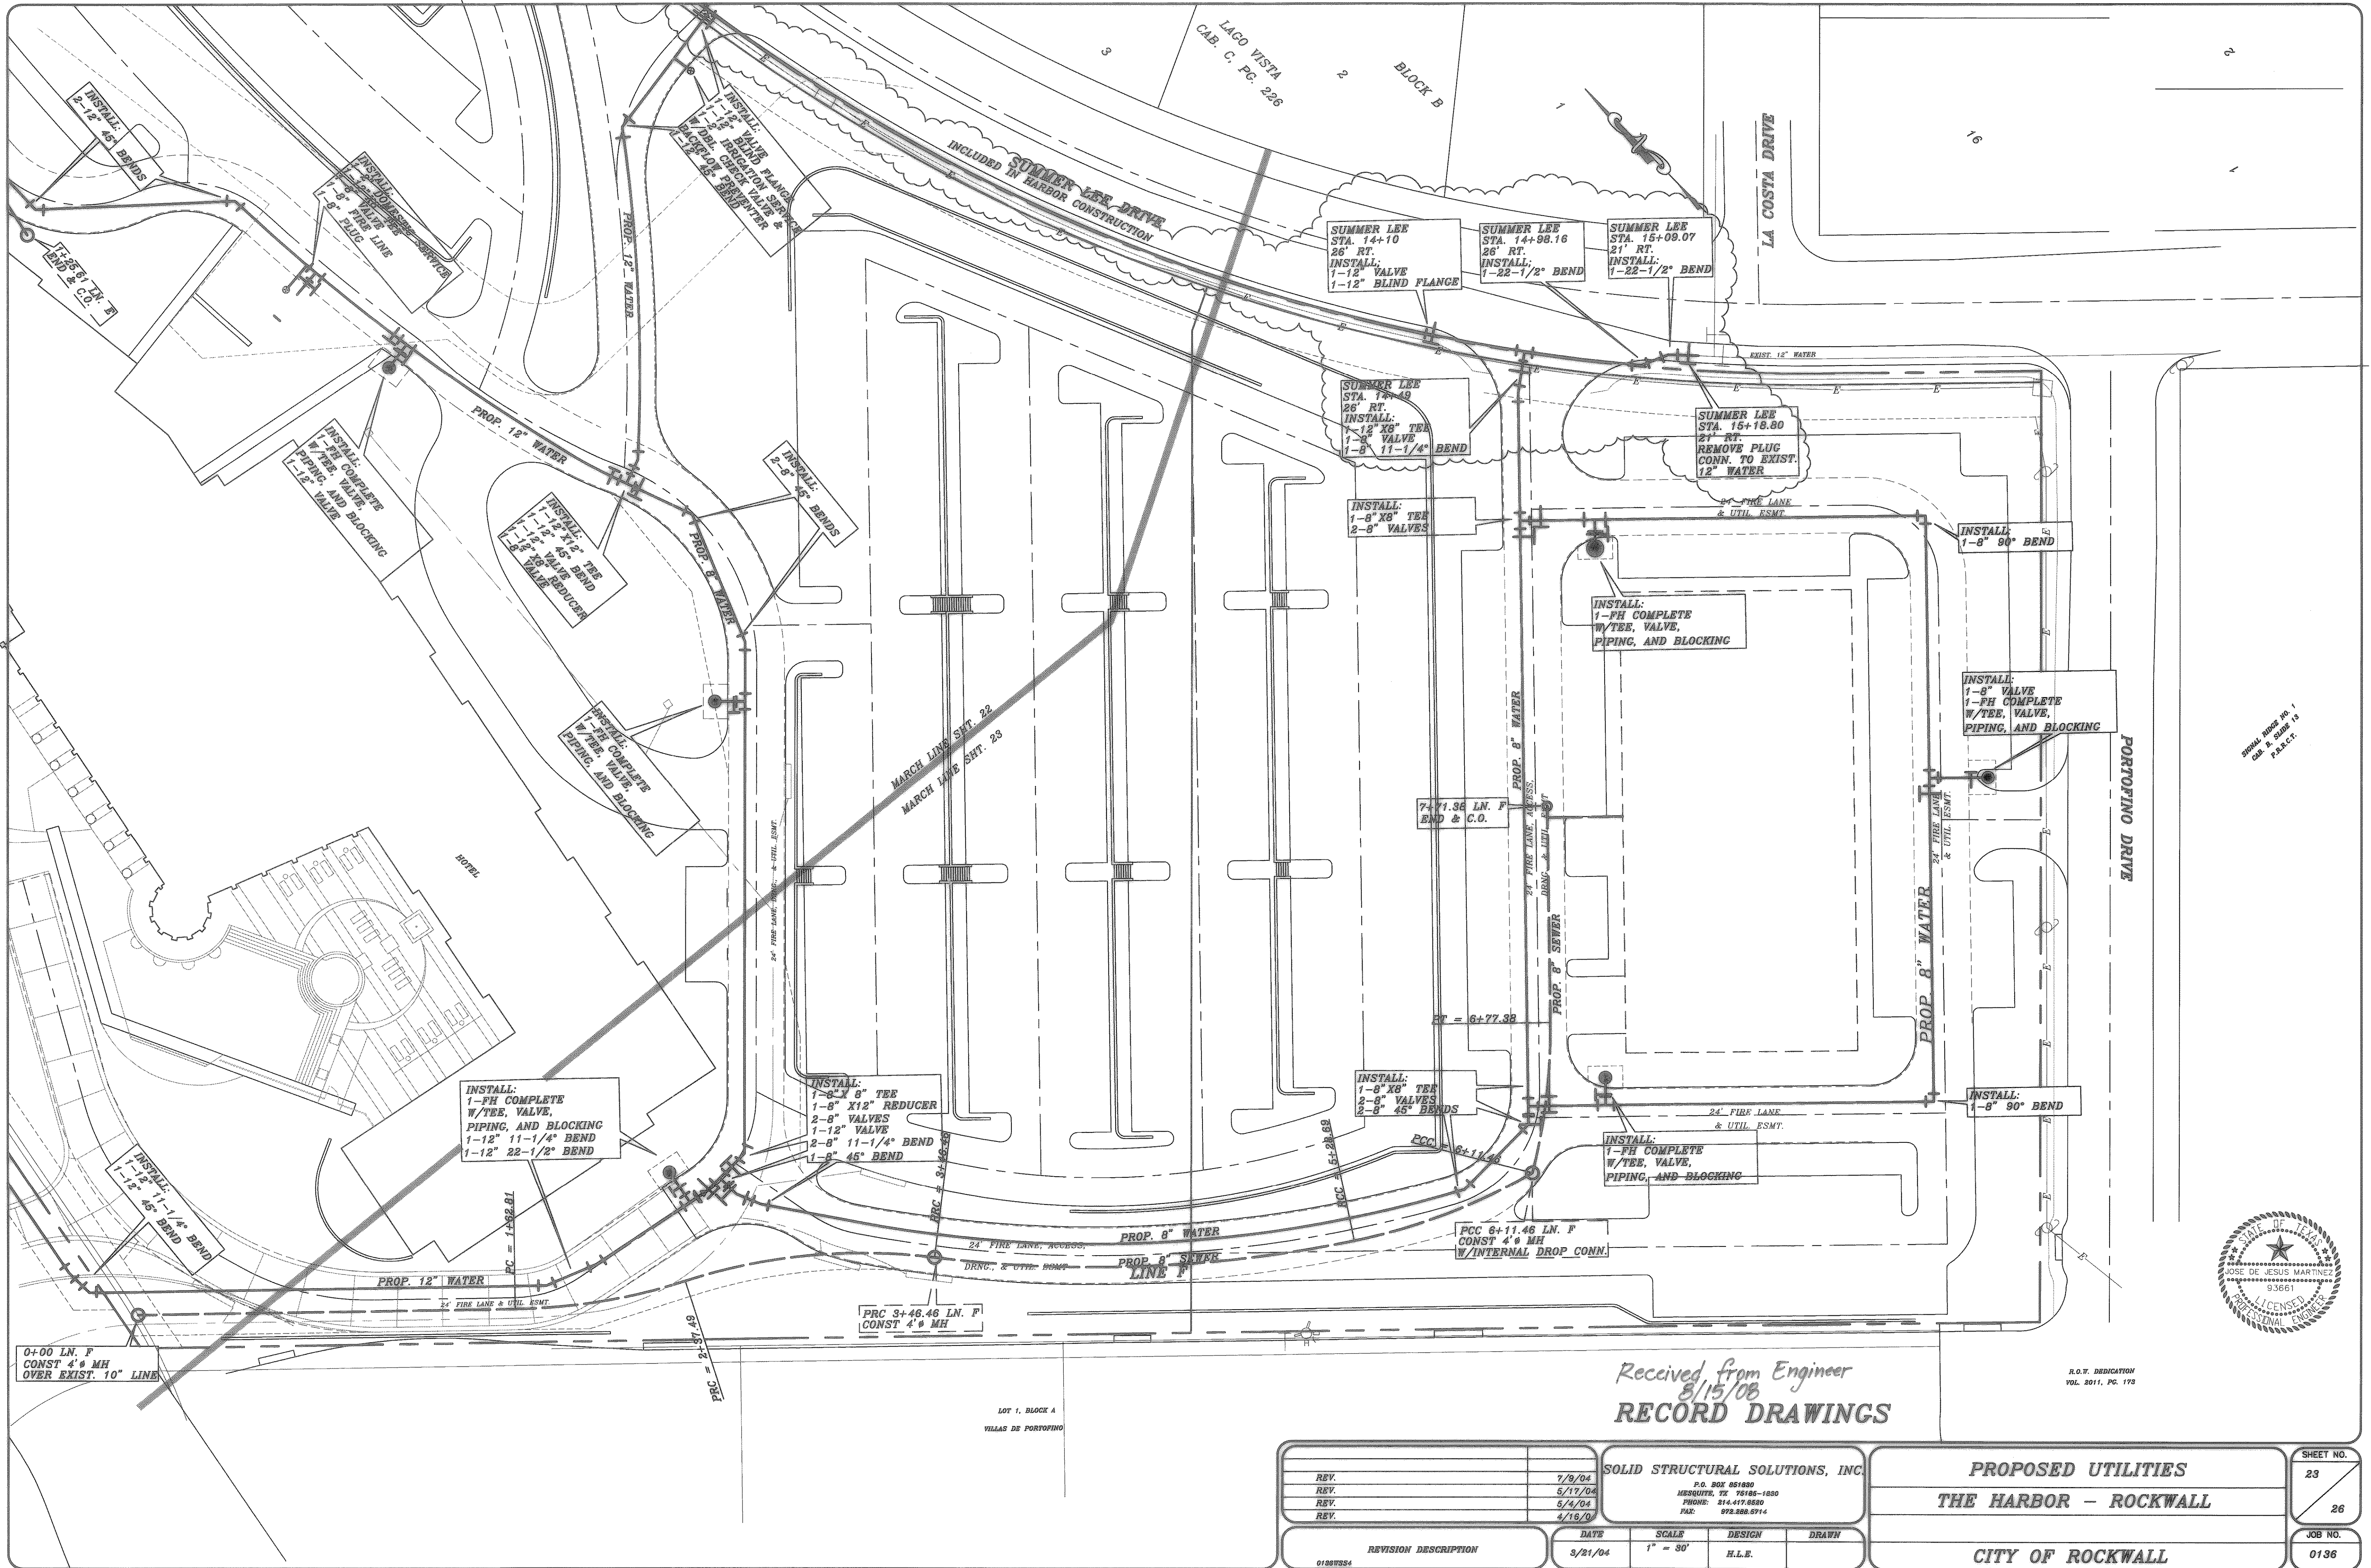

Received from Engineer
8/15/08
RECORD DRAWINGS

D.O.T. DEDICATION
VOL. 2011, PG. 173

REVISION DESCRIPTION		DATE	SCALE	DESIGN	DRAWN
REV. 1		7/9/04	1" = 30'	H.L.B.	
REV. 2		5/17/04			
REV. 3		5/4/04			
REV. 4		4/16/04			

SOLID STRUCTURAL SOLUTIONS, INC.	
P.O. BOX 951880	
MESQUITE, TX 75185-1880	
PHONE: 514.417.8550	
FAX: 972.388.5714	

PROPOSED UTILITIES THE HARBOR - ROCKWALL		SHEET NO. 23
CITY OF ROCKWALL		26
		JOB NO. 0136