


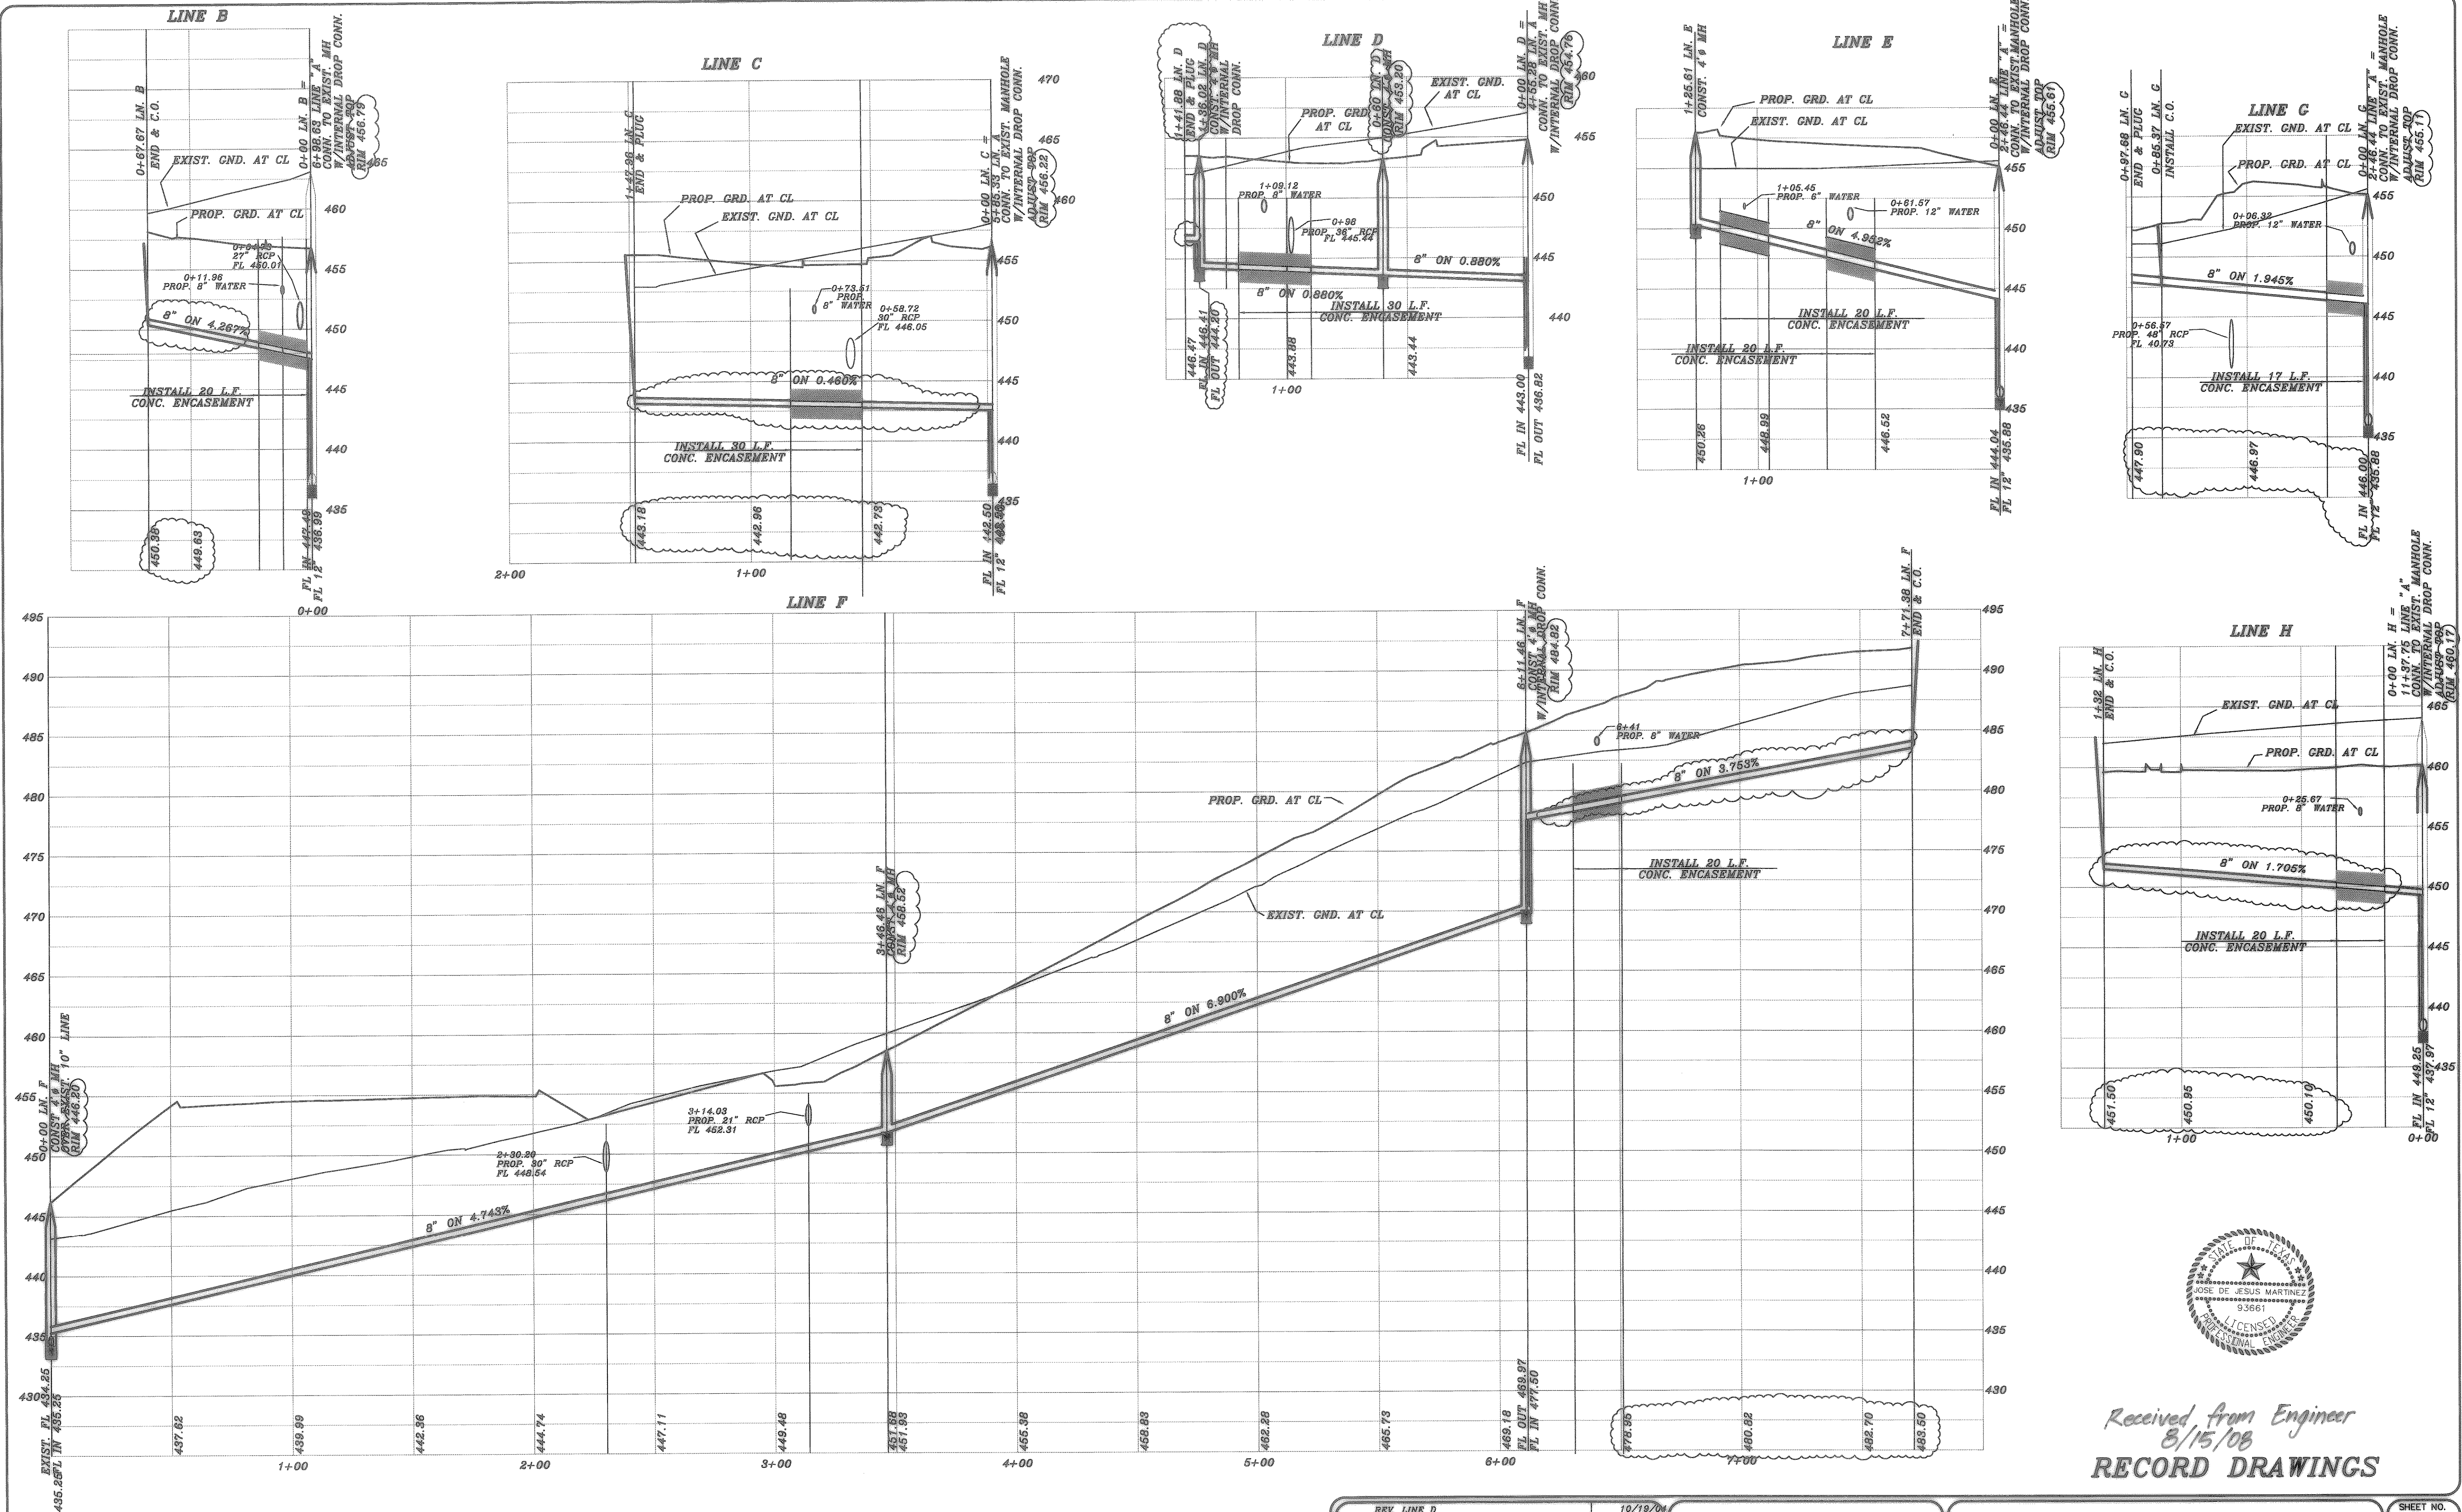

Received from Engineer
8/15/08
RECORD DRAWINGS

REV. LINE D10/19/04 REV.9/17/04 REV.7/27/04 REV.5/20/04 REV.5/17/04 REV.5/4/04		SOLID STRUCTURAL SOLUTIONS, INC. P.O. BOX 551890 MESQUITE, TX 75185-1890 PHONE: 214-417-6620 FAX: 972-558-5714		PROPOSED UTILITIES THE HARBOR - ROCKWALL CITY OF ROCKWALL		SHEET NO. 24 26 JOB NO. 0136	
REVISION DESCRIPTION 0155WSS5		DATE 3/23/04	SCALE 1" = 30' 1" = 6'	DESIGN H.L.E.	DRAWN		