
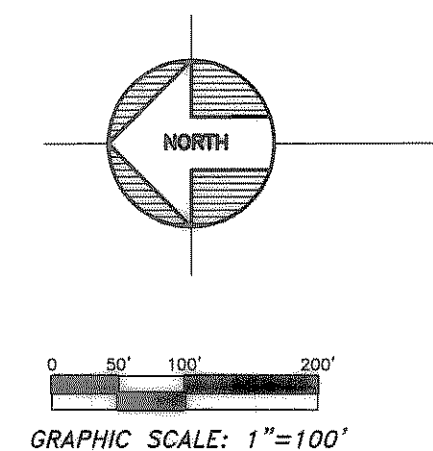


NO.	BEARING	DISTANCE
L1	S 46°27'03" E	64.43'
L2	S 07°13'29" W	49.64'
L3	N 52°52'11" E	79.47'
L4	S 22°26'54" E	109.69'
L5	N 45°35'28" W	67.69'
L6	S 29°38'53" E	9.99'
L7	S 34°51'05" E	89.41'
L8	S 44°35'10" E	116.83'
L9	S 64°39'37" W	24.61'
L10	N 80°10'12" E	239.28'
L11	N 74°42'54" E	63.28'
L12	N 60°54'03" E	162.25'
L13	N 17°08'00" E	87.29'
L14	N 48°52'49" W	18.61'
L15	N 02°59'22" E	38.81'
L16	N 36°31'05" E	17.64'
L17	N 75°07'26" E	12.97'

NO.	BEARING	DISTANCE
L18	N 68°51'13" E	13.20'
L19	S 82°39'16" E	17.59'
L20	N 87°31'10" E	18.75'
L21	N 86°11'31" E	22.15'
L22	S 77°04'50" E	17.50'
L23	N 80°59'47" E	19.85'
L24	S 34°51'05" E	45.00'
L25	N 79°06'40" E	21.35'
L26	S 89°33'05" E	208.59'
L27	N 53°32'14" E	47.25'
L28	S 39°17'43" W	31.81'
L29	S 46°38'20" W	35.25'
L30	S 52°34'46" W	29.00'
L31	N 83°14'57" W	128.96'
L32	N 10°22'39" E	49.96'
L33	N 04°52'35" W	17.69'

NO.	RADIUS	DELTA	ARC	CH. BEARING	CHORD
G1	785.00'	91°51'54"	1258.63'	S 00°31'07" E	1128.08'
C1A	785.00'	45°47'34"	627.40'	S 22°31'03" E	610.83'
C1B	785.00'	34°03'04"	466.53'	S 17°24'16" E	459.69'
C1C	785.00'	12°01'16"	164.70'	S 40°26'26" E	164.40'
C2	680.00'	28°28'29"	337.94'	S 43°53'08" E	334.48'
C3	620.00'	12°35'09"	136.19'	S 51°49'47" E	135.92'
C4	620.00'	10°41'10"	115.63'	S 40°11'39" E	115.47'
C5	680.00'	07°13'27"	85.74'	S 40°58'27" E	85.68'
C6	87.47'	29°44'50"	45.41'	S 67°27'11" W	44.90'
C8	968.00'	17°03'41"	288.25'	N 01°43'56" W	287.18'
C9	680.00'	09°44'05"	115.53'	S 39°43'08" E	115.40'
C10	116.35'	78°02'08"	158.46'	S 77°26'33" E	146.50'
C11	116.35'	143°59'57"	292.41'	S 33°34'30" W	221.31'
C12	116.35'	222°02'05"	450.88'	S 05°26'34" E	217.22'
C13	680.00'	02°30'38"	29.80'	S 36°06'24" E	29.80'

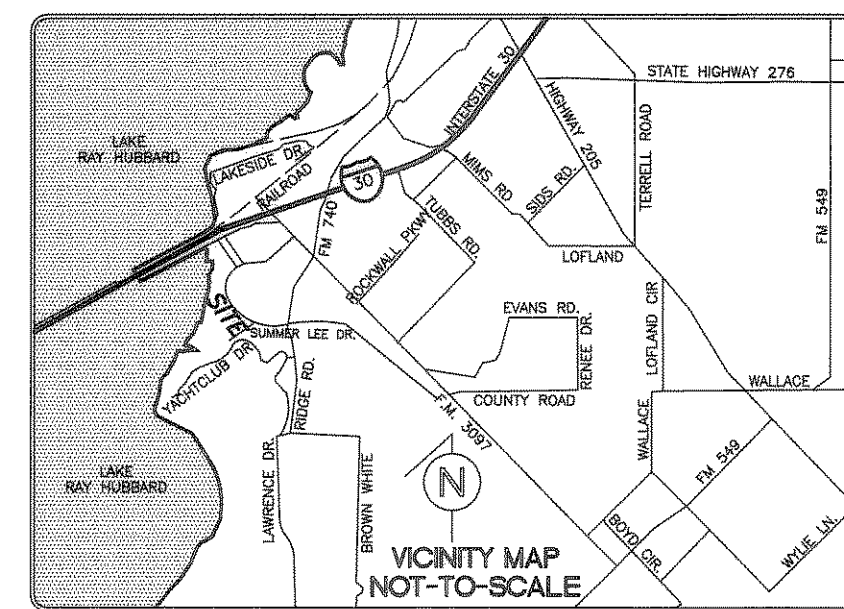

INTERSTATE HIGHWAY NO. 30

SHORELINE TRAIL
(PO NOT RIGHT OF WAY)

LOT 1 BLOCK A SHORELINE PLAZA ADDITION
CAB. F. SL. 309

LOT 3 BLOCK A SHORELINE PLAZA ADDITION
CAB. F. SL. 309

LOT 4 BLOCK A SHORELINE PLAZA ADDITION
CAB. F. SL. 309

LOT 5 BLOCK A SHORELINE PLAZA ADDITION
CAB. F. SL. 309

LOT 6 BLOCK A SHORELINE PLAZA ADDITION
CAB. F. SL. 309

LOT 7 BLOCK A SHORELINE PLAZA ADDITION
CAB. F. SL. 309

LOT 8 BLOCK A SHORELINE PLAZA ADDITION
CAB. F. SL. 309

LOT 9 BLOCK A SHORELINE PLAZA ADDITION
CAB. F. SL. 309

LOT 10 BLOCK A SHORELINE PLAZA ADDITION
CAB. F. SL. 309

LOT 11 BLOCK A SHORELINE PLAZA ADDITION
CAB. F. SL. 309

LOT 12 BLOCK A SHORELINE PLAZA ADDITION
CAB. F. SL. 309

LOT 13 BLOCK A SHORELINE PLAZA ADDITION
CAB. F. SL. 309

LOT 14 BLOCK A SHORELINE PLAZA ADDITION
