
CONSTRUCTION PLANS

CITY OF ROCKWALL ROCKWALL COUNTY,

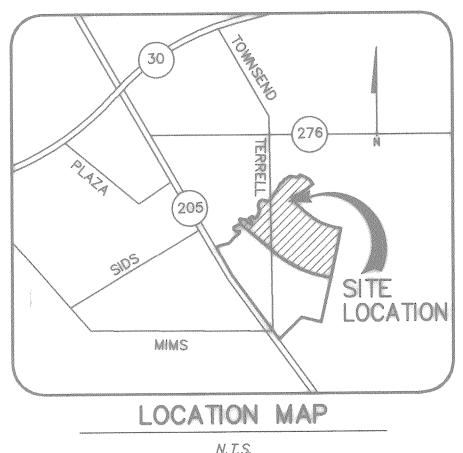

OWNER

HICKORY RIDGE, LTD.

5225 VILLAGE CREEK DRIVE

SUITE 300

(972) 931 - 9537PLANO, TEXAS 75093

DEVELOPER

PAPAGOLOS DEVELOPMENT COMPANY

5225 VILLAGE CREEK DRIVE

SUITE 300

(972) 931 - 9537PLANO, TEXAS

75093

ENGINEER

DOWDEY, ANDERSON & ASSOCIATES, INC.

5225 VILLAGE CREEK DRIVE

SUITE 200

(972) 931-0694 PLANO, TEXAS

75093

THESE CONSTRUCTION PLANS WERE PREPARED UNDER THE RESPONSIBLE SUPERVISION OF DAN M. DOWDEY REGISTERED PROFESSIONAL ENGINEER

RECORD DRAWINGS AUGUST 19, 2002 NOTE: THE INTENT OF THE OWNER AND


ENGINEER WAS TO CONSTRUCT THE

IMPROVEMENTS ACCORDING TO THESE

ROCKWALL. THE LINES AND GRADES WERE SET ON THE GROUND FOR CONSTRUCTION ACCORDING TO SAID

PLANS. WE ARE NOT AWARE OF ANY CHANGES OR REVISION TO THESE PLANS

DURING CONSTRUCTION EXCEPT AS NOTED ON THE PLANS.

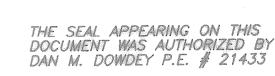

	INDEX
PLATE	DESCRIPTION
The second secon	COVER SHEET
12	FINAL PLAT
3-17	PAVING PLAN & PROFILES
18	BARRIER FREE RAMP DETAILS
19	DRAINAGE AREA MAP
20-25	STORM SEWER PLAN & PROFILES
26	WATER AND SANITARY SEWER PLAN
27-30	SANITARY SEWER PROFILES
31	12" WATER LINE PROFILES
32-34	GRADING PLANS
35	STORMWATER POLLUTION PREVENTION PLAN
36-33	TREE SURVEY PLANS

99-066