



LINE "A"

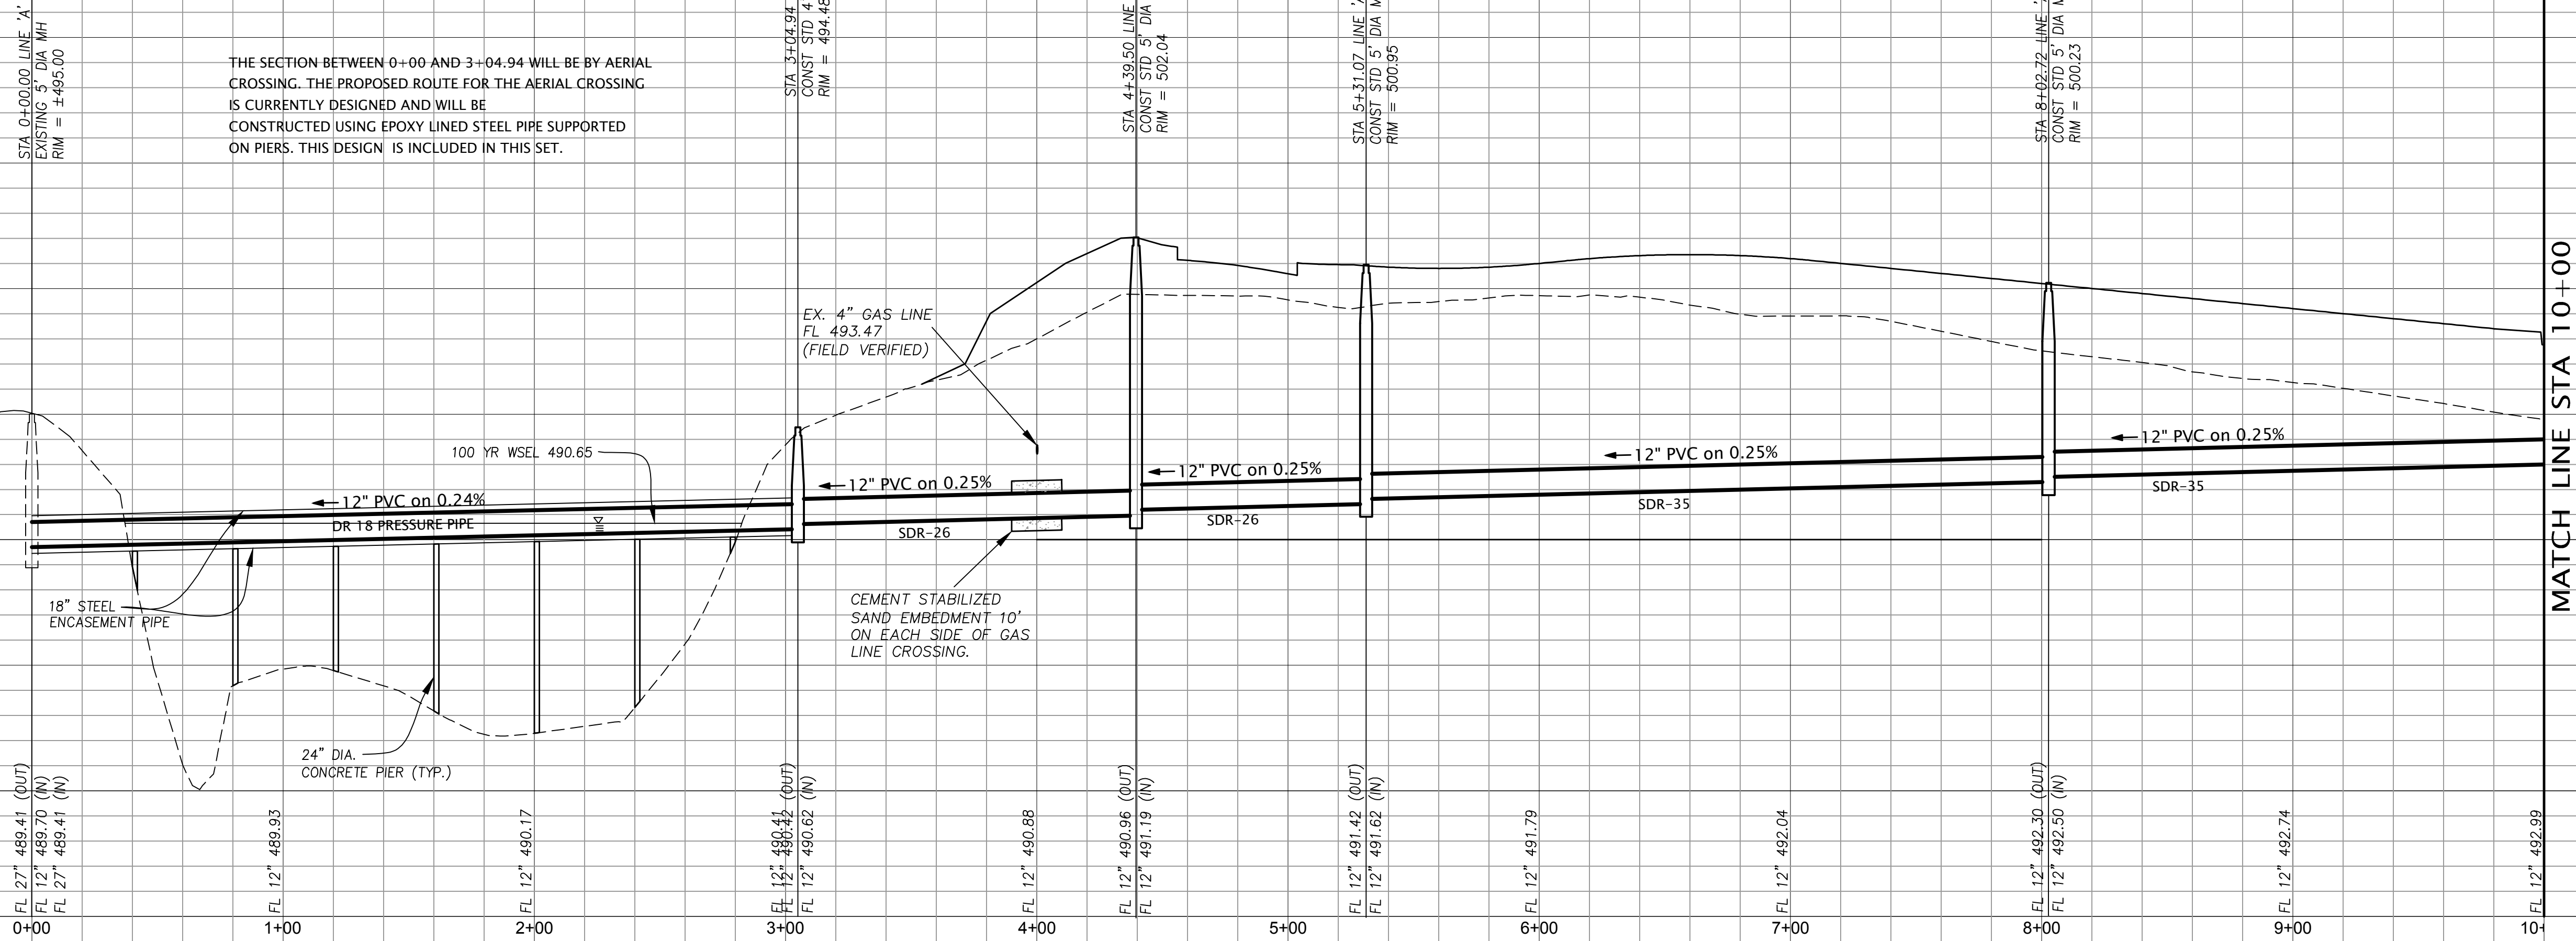

LINE "A"

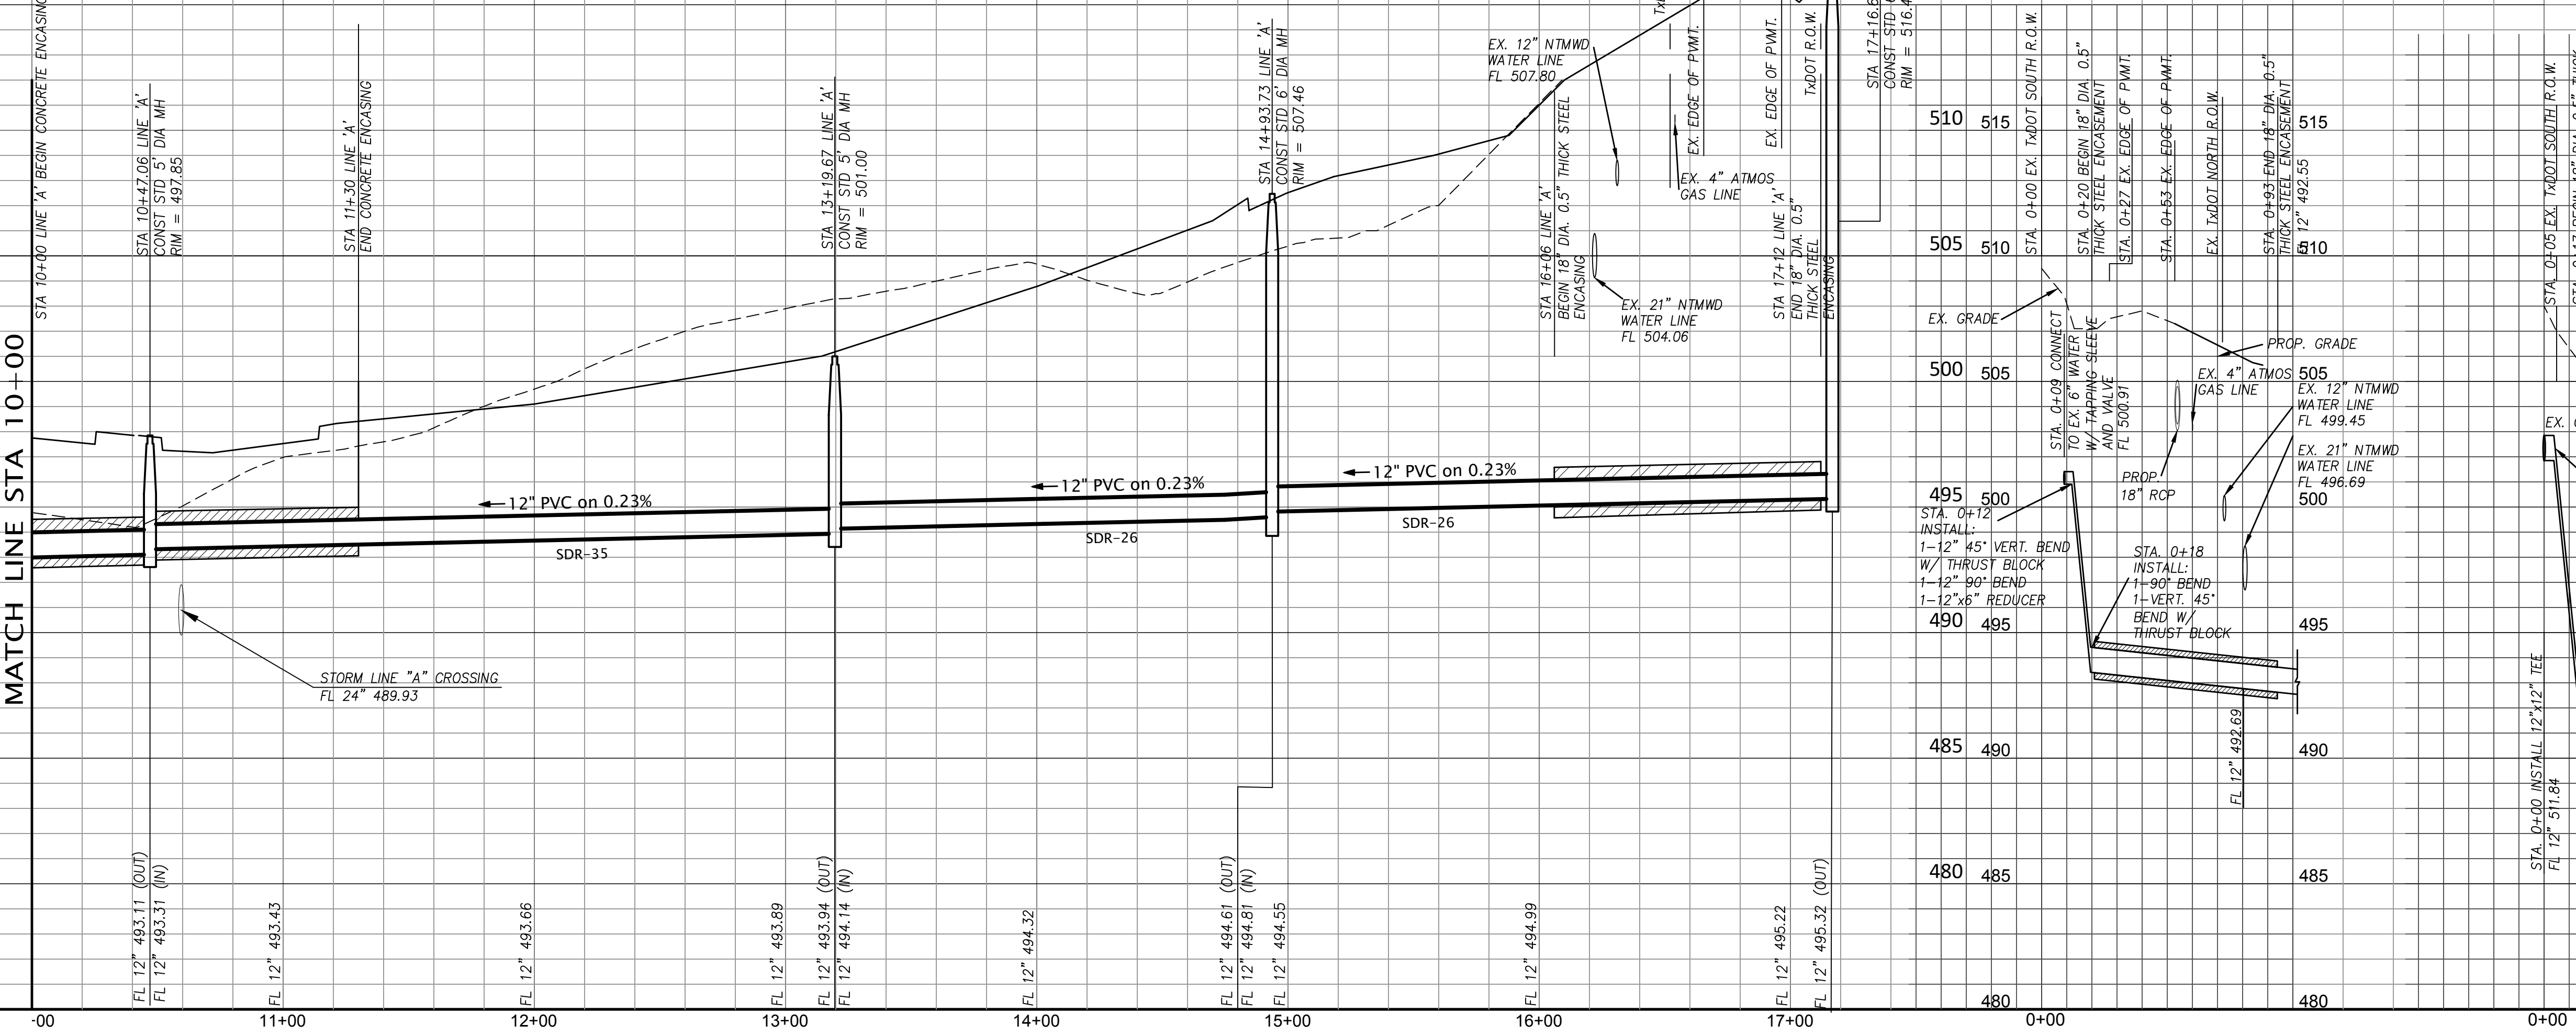

CONSTRUCTION RECORD

Revision	Date	Description

Owner/Developer:

WHITTLE DEVELOPMENT

P.O. Box 369
Rockwall, Texas 75087
Phone 972.771-5253

Engineer:

F.C. CUNY CORPORATION
#2 Horizon Court • Ste. 500 • Heath, Texas 75032
Phone: 469-402-7700
Fax: 469-402-0700
Texas Registered Engineering Firm E-7449

The Highlands
City of Rockwall, Rockwall County, Texas

THE SEAL APPEARING ON THIS DOCUMENT WAS AUTHORIZED BY CHRISTOPHER R. CUNY, P.E. 65642

2/11/2021

Sheet Title:

WATER AND SANITARY SEWER PROFILES

Drawn By: FC CUNY	Checked By: FC CUNY
Date: 08-18	Project No.:
Scale:	Sheet No.:

h: 1"=40'
v: 1"=4'

4 of 12