
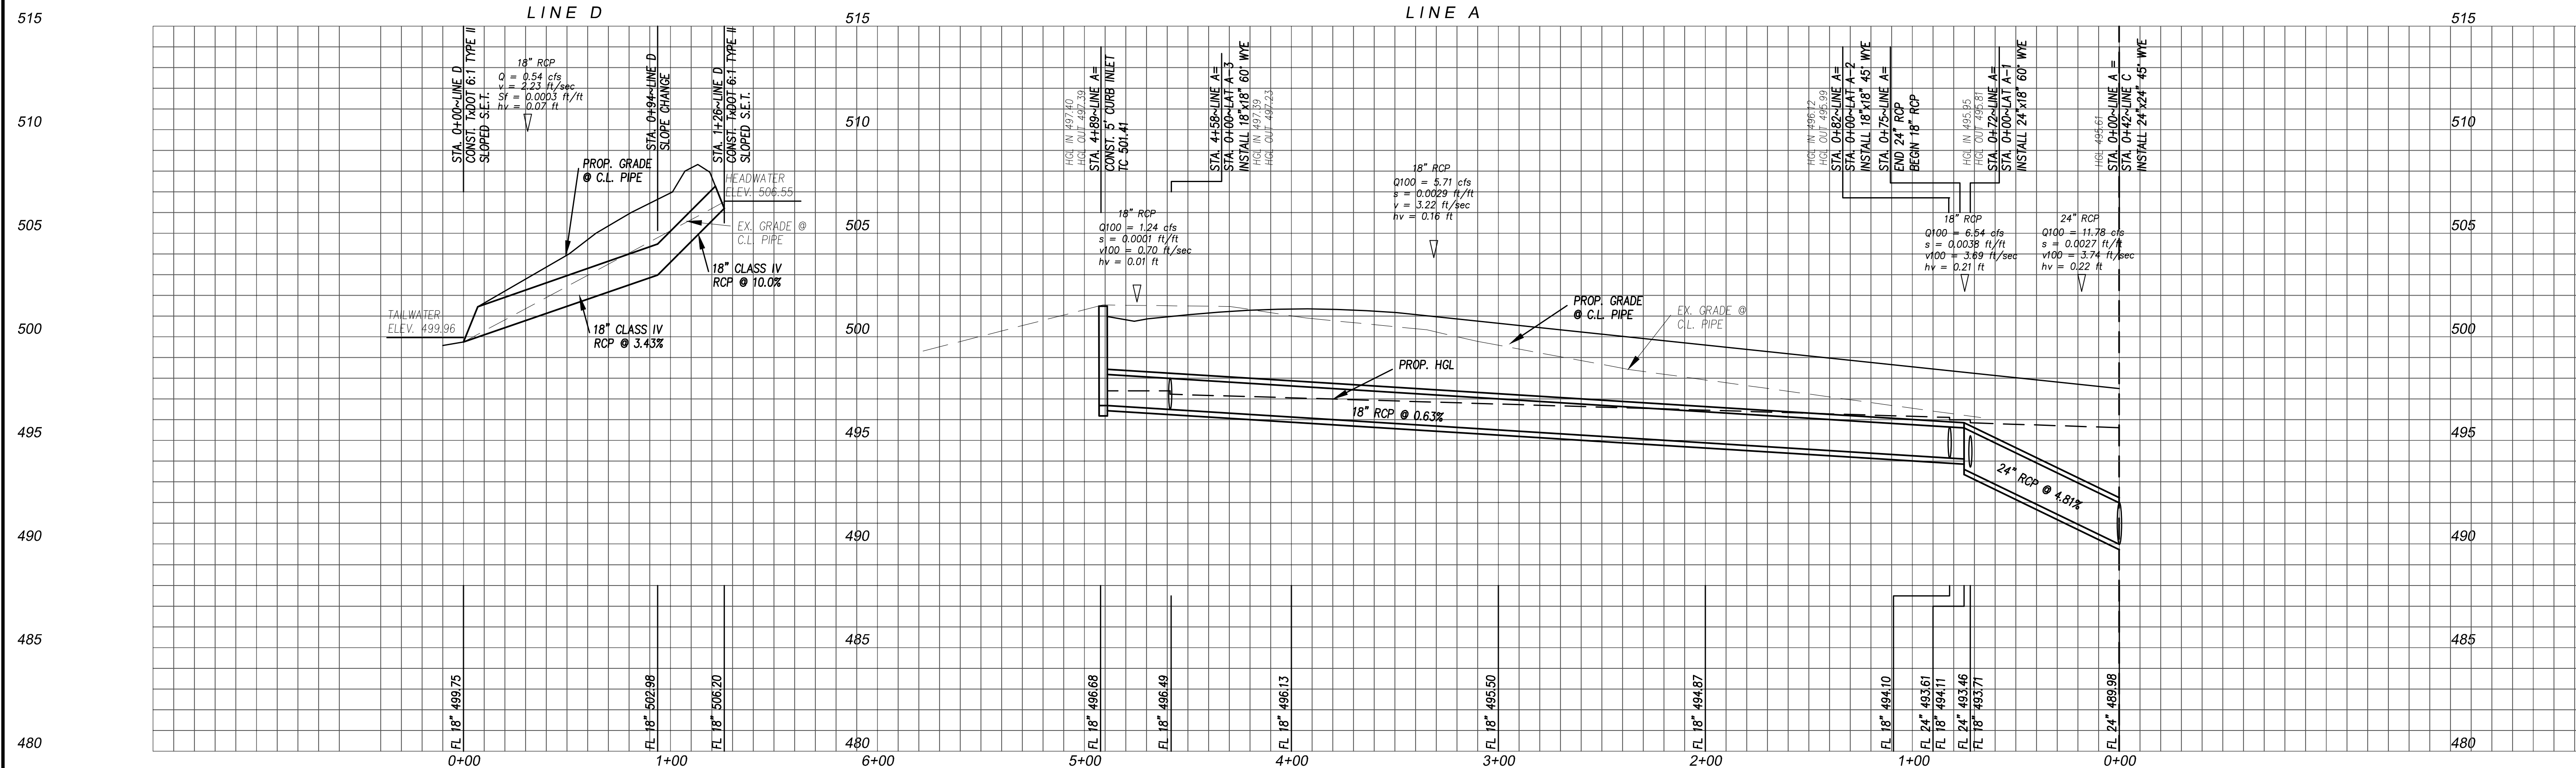
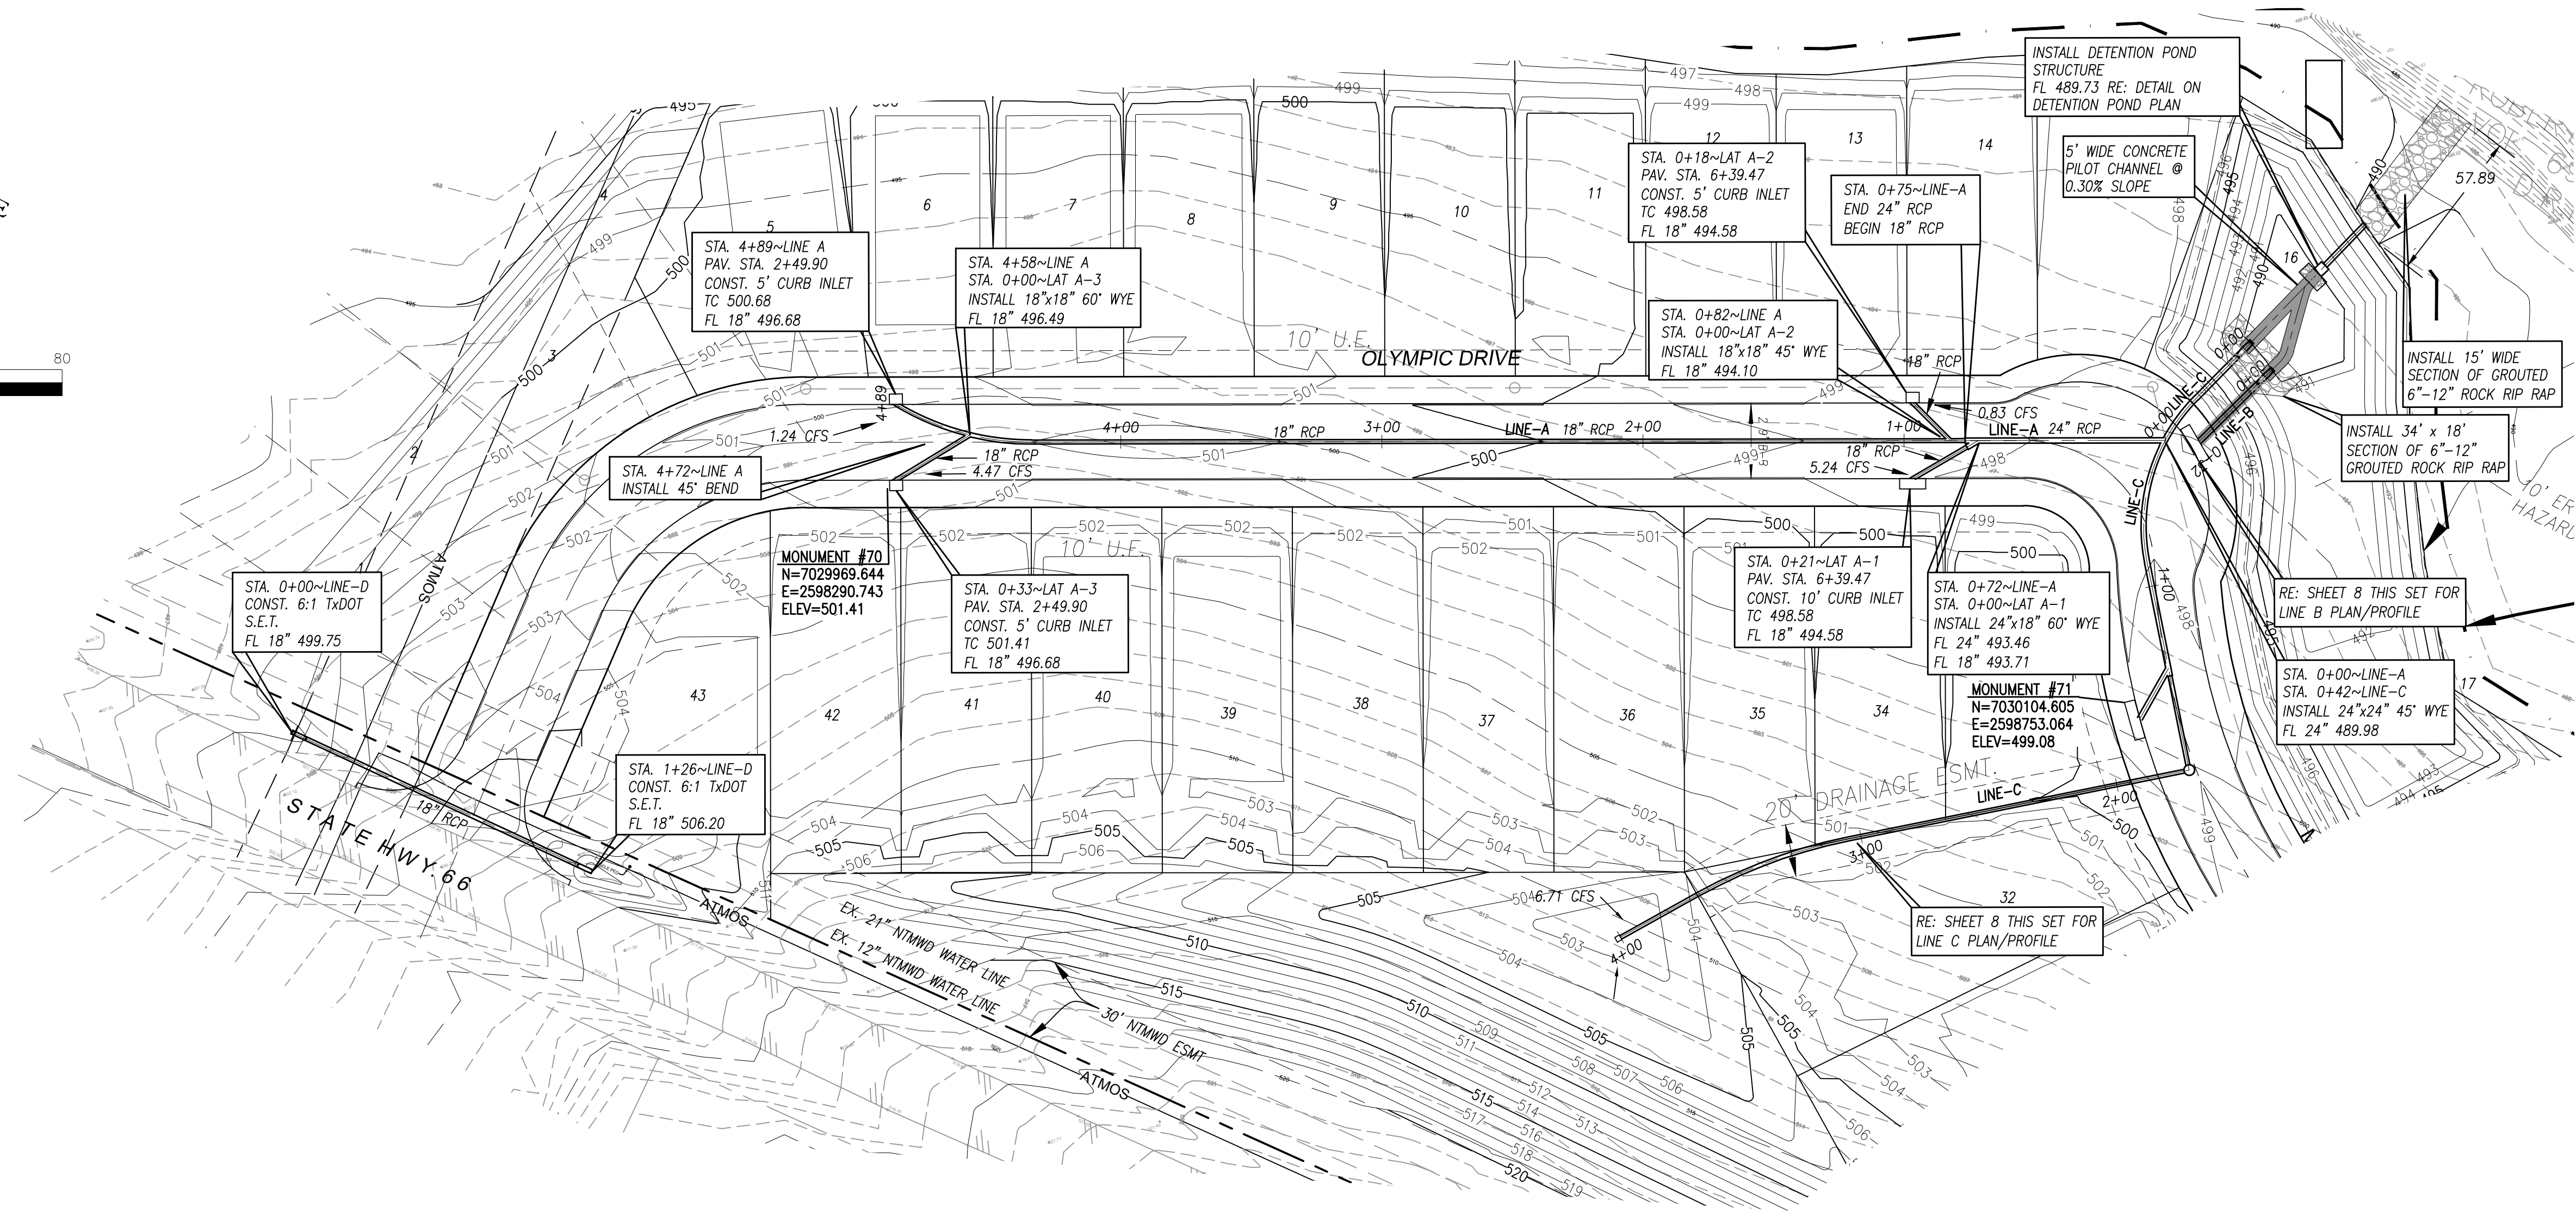


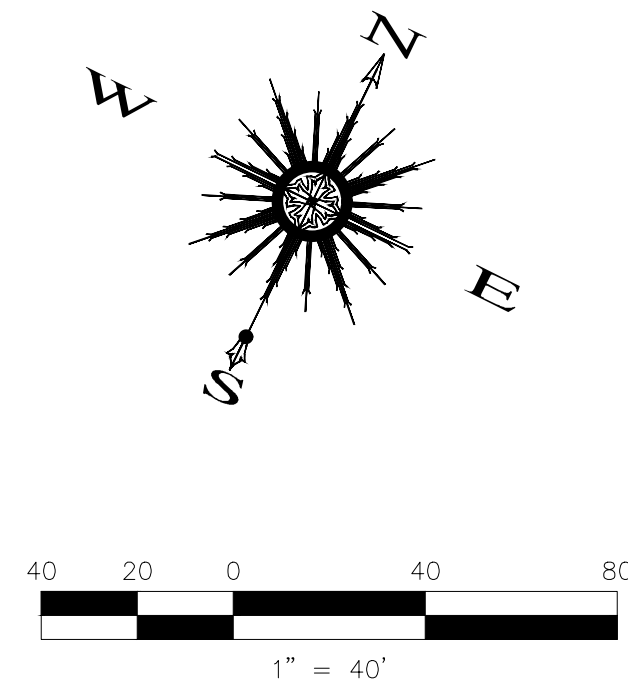

CONSTRUCTION RECORD

Revision	Date	Description

Owner/Developer:

WHITTLE DEVELOPMENT

P.O. Box 369
Rockwall, Texas 75087
Phone 972.771-5253

Engineer:

F.C. CUNY CORPORATION

#2 Horizon Court • Ste. 500 • Heath, Texas 75032
Phone: 469-402-7700
Fax: 469-402-0700
Texas Registered Engineering Firm E-7449

The Highlands

City of Rockwall, Rockwall County, Texas

THE SEAL APPEARING ON THIS DOCUMENT WAS AUTHORIZED BY CHRISTOPHER R. CUNY, P.E. 65642



2/11/2021

Sheet Title:

Storm Line A
Plan and Profile

Drawn By: FC CUNY	Checked By: FC CUNY
Date: 08-18	Project No.:
Scale:	Sheet No.:
h: 1"=40' v: 1"=4'	7A of 12