


515
510
505
500
495
490
485
480

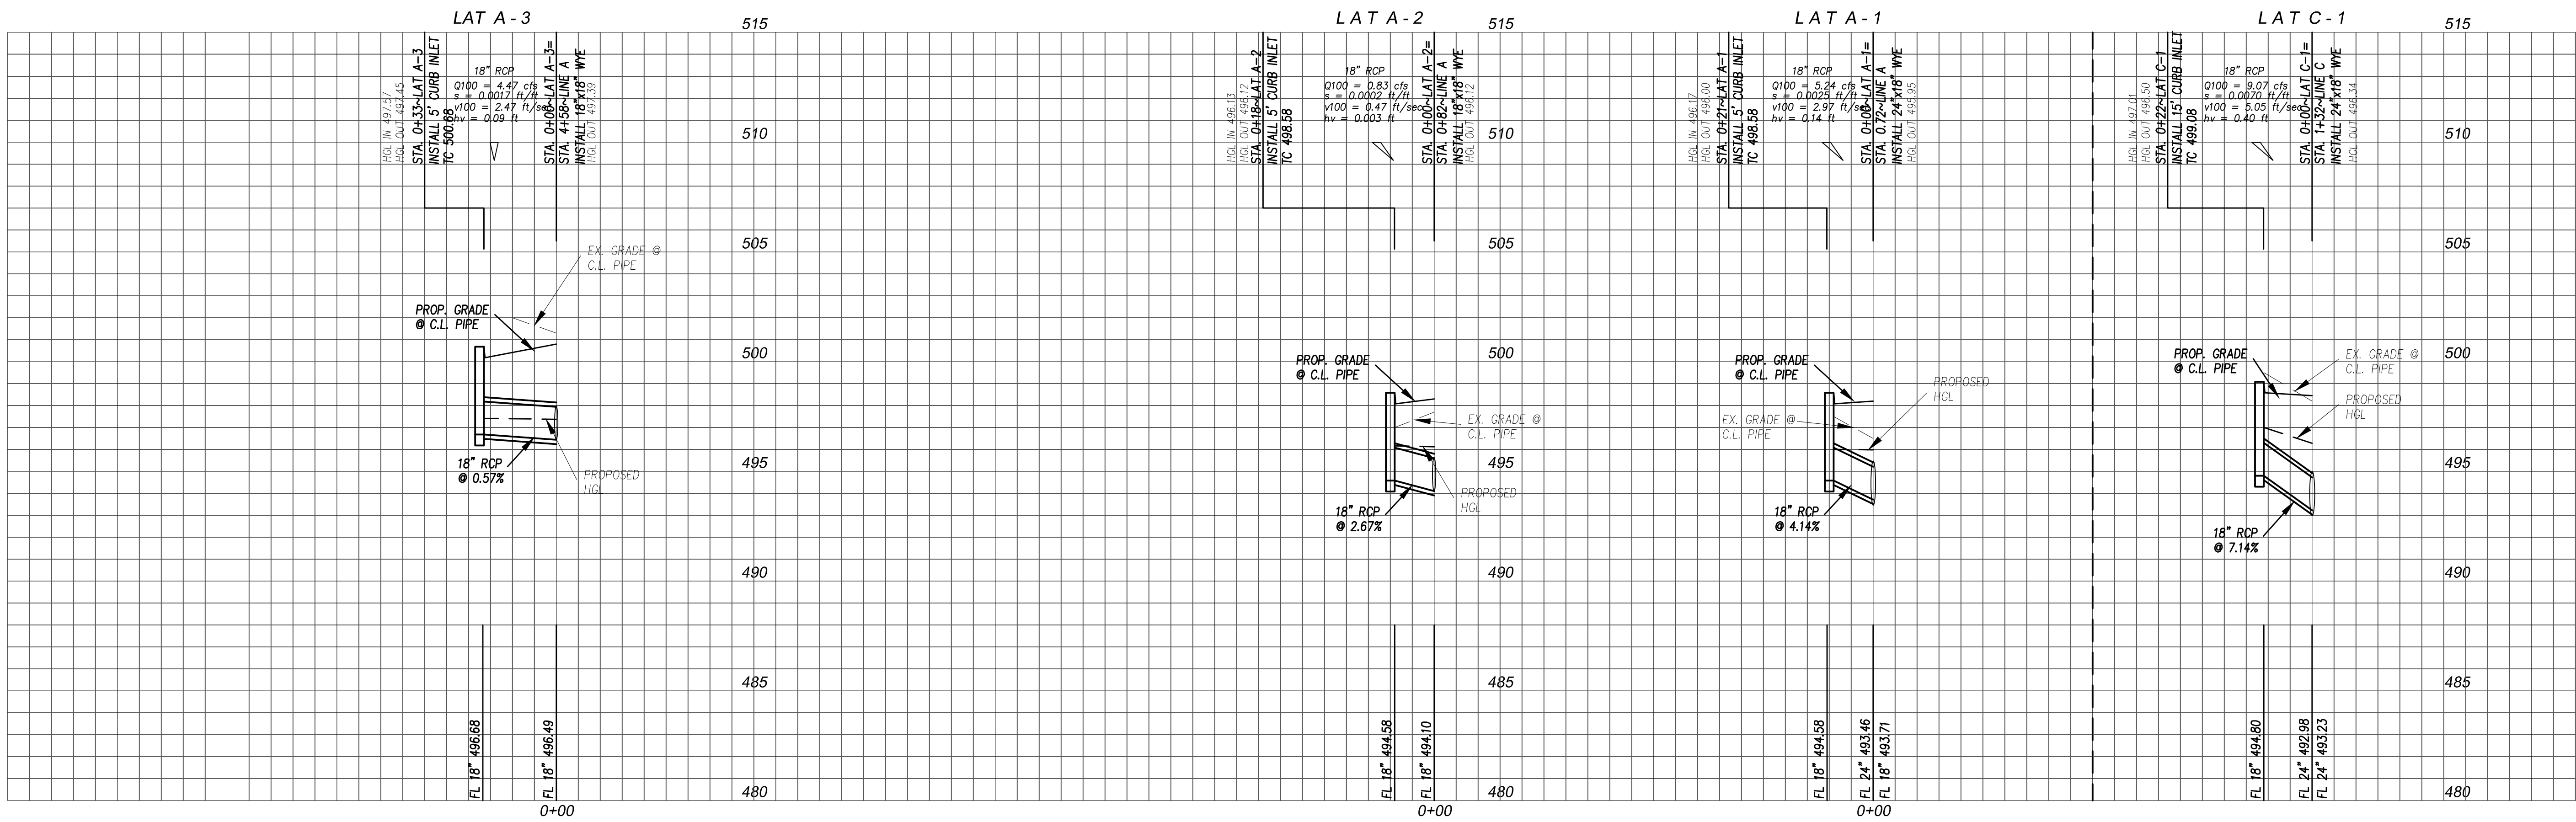

CONSTRUCTION RECORD

Revision	Date	Description

Owner/Developer:
WHITTLE DEVELOPMENT
P.O. Box 369
Rockwall, Texas 75087
Phone 972.771-5253

Engineer:
F.C. CUNY CORPORATION
#2 Horizon Court • Ste. 500 • Heath, Texas 75032
Phone: 469-402-7700
Fax: 469-402-0700
Texas Registered Engineering Firm E-7449

The Highlands
City of Rockwall, Rockwall County, Texas

THE SEAL APPEARING ON THIS DOCUMENT WAS AUTHORIZED BY CHRISTOPHER R. CUNY, P.E. 65642



2/11/2021

Sheet Title:

Storm Lateral
Profiles

Drawn By:
FC CUNY

Checked By:
FC CUNY

Date:
08-18

Project No.:

Scale:

Sheet No.:

h: 1"=40'
v: 1"=4'

7B of 12