



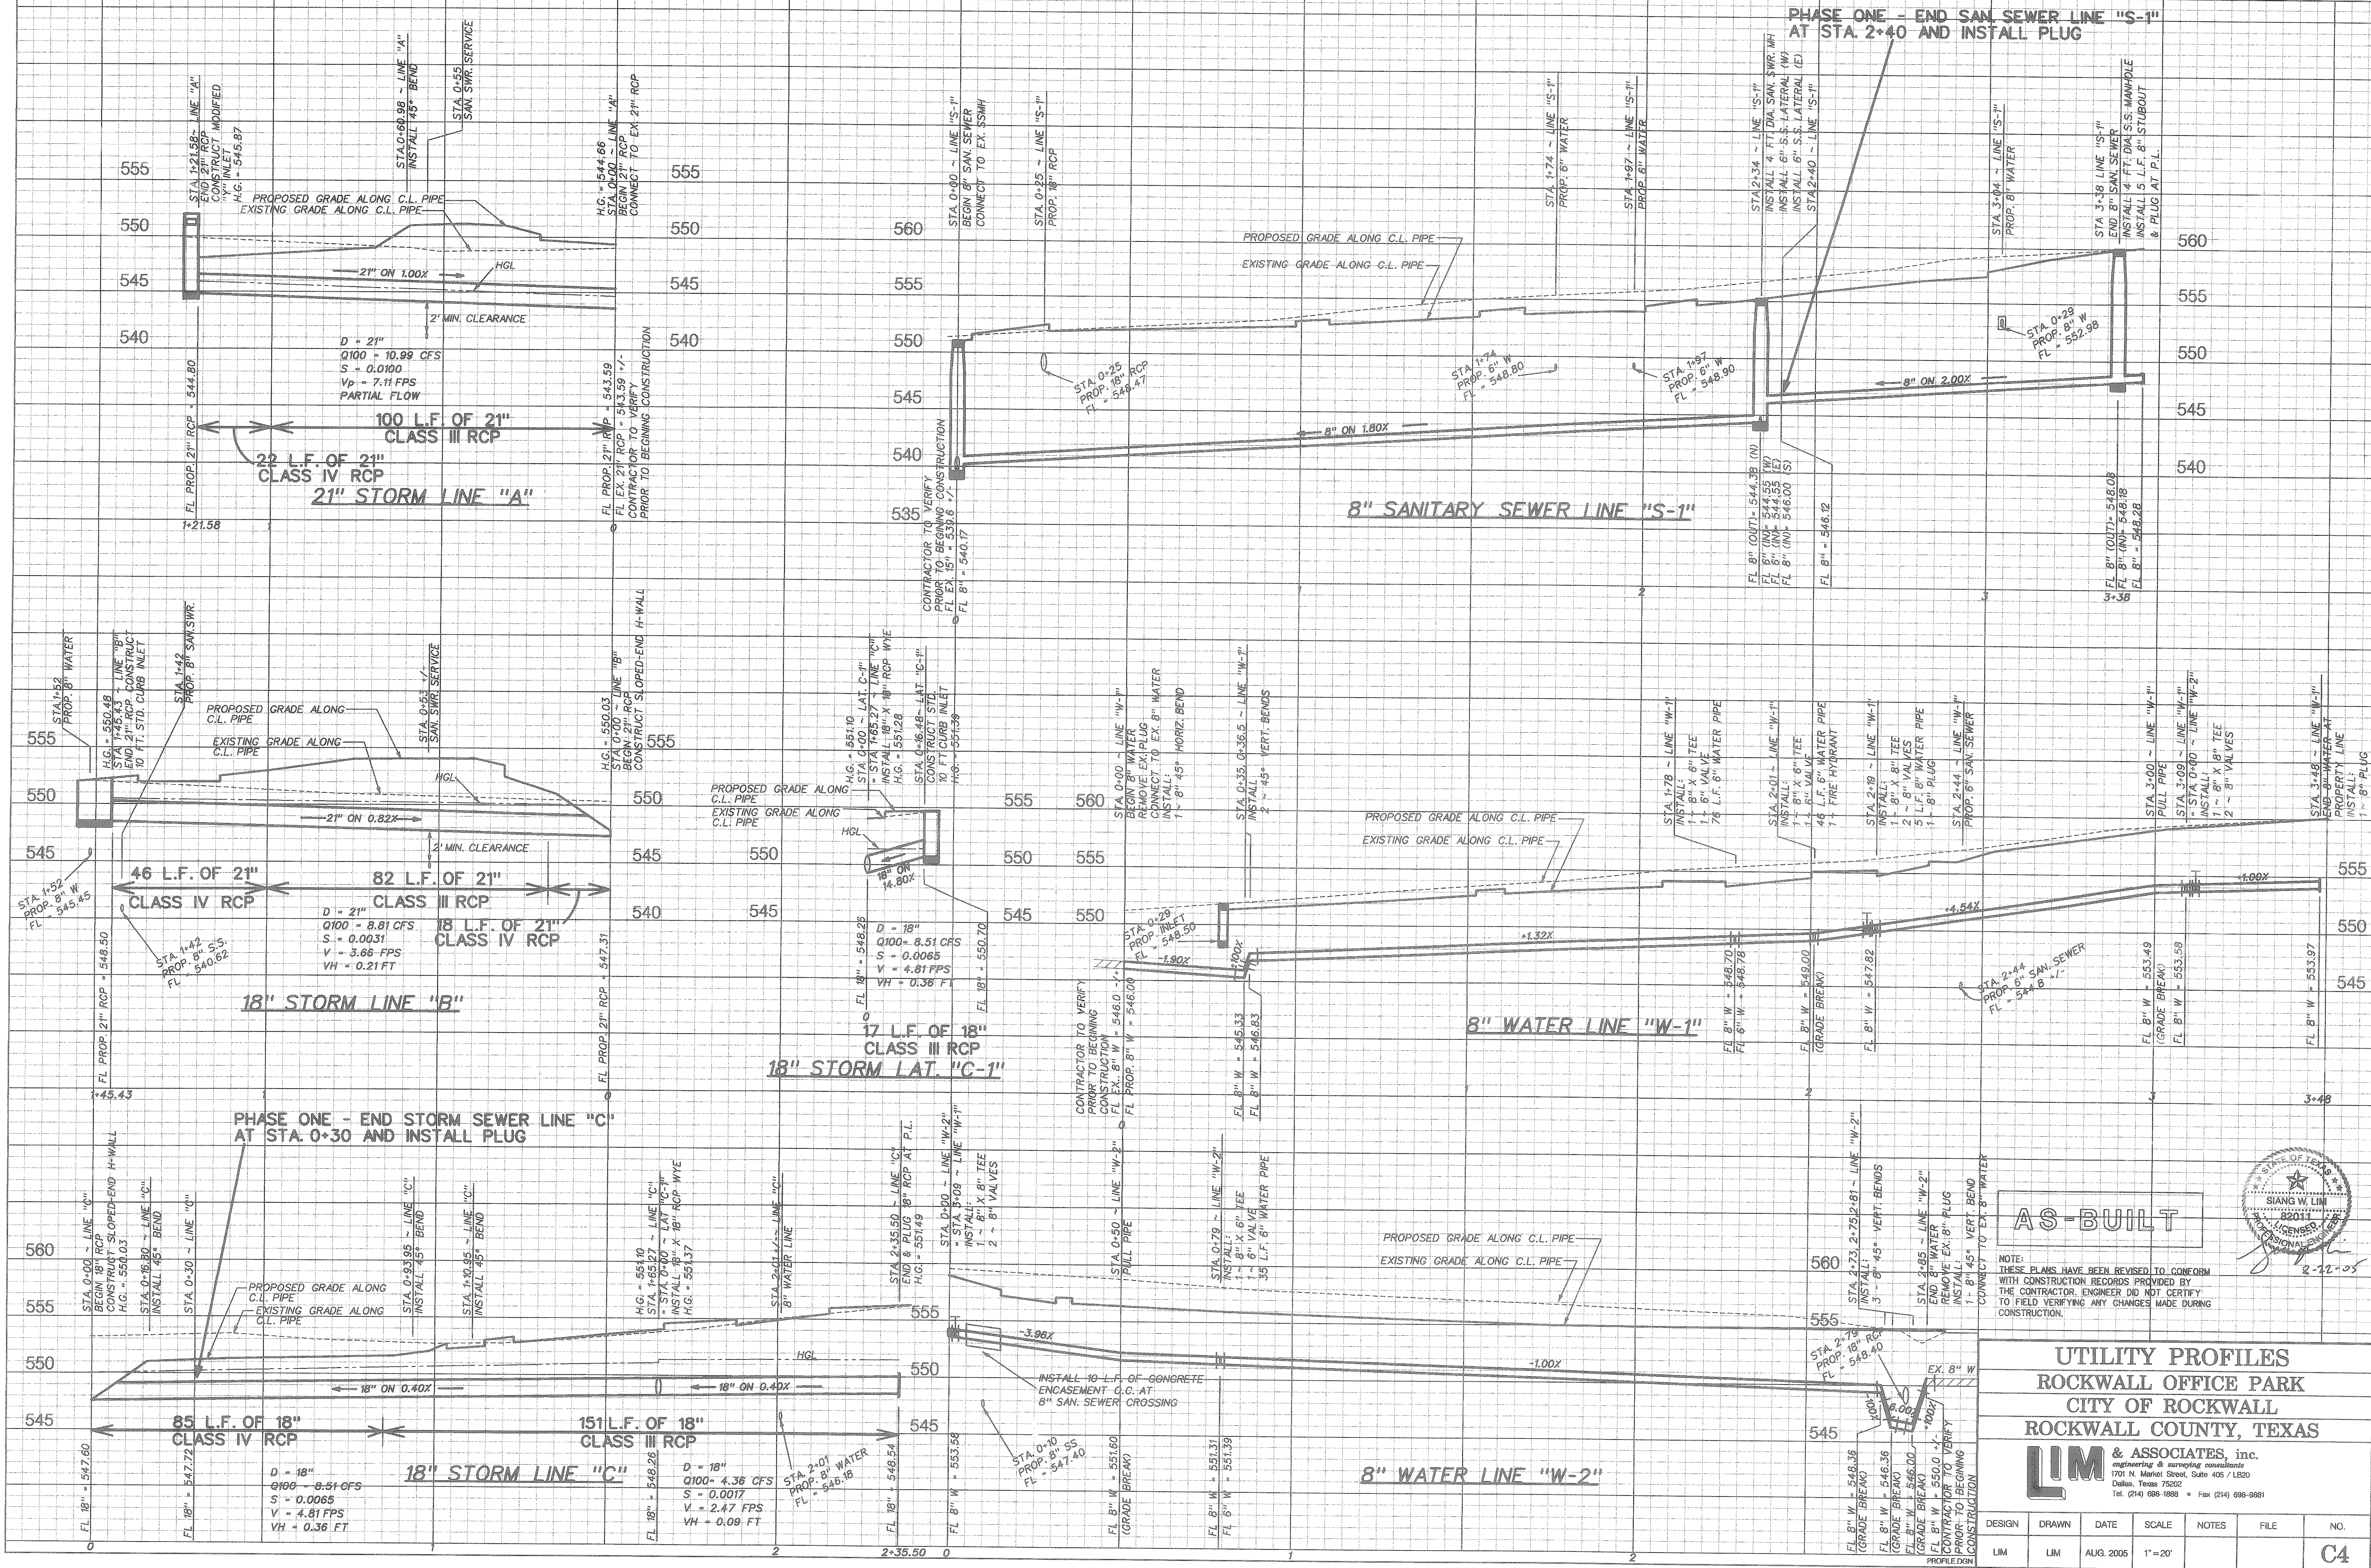

AS-BUILT

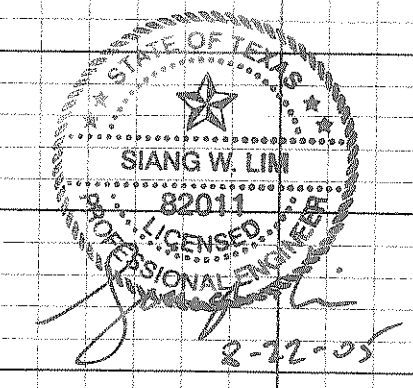

NOTE: THESE PLANS HAVE BEEN REVISED TO CONFORM WITH CONSTRUCTION RECORDS PROVIDED BY THE CONTRACTOR. ENGINEER DID NOT CERTIFY TO FIELD VERIFYING ANY CHANGES MADE DURING CONSTRUCTION.

UTILITY PROFILES
ROCKWALL OFFICE PARK
CITY OF ROCKWALL
ROCKWALL COUNTY, TEXAS

LIM & ASSOCIATES, inc.
 engineering & surveying consultants
 1701 N. Main Street, Suite 405 / LB20
 Dallas, Texas 75202
 Tel. (214) 698-1888 • Fax (214) 698-9881

DESIGN	DRAWN	DATE	SCALE	NOTES	FILE	NO.
LIM	LIM	AUG. 2005	1"=20'			C4