AS-BUILT

THIS RECORD DRAWING IS COMPILATION OF A COPY OF THE SEALED ENGINEERING DRAWING FOR THIS PROJECT: MODIFIED BY ADDENDA, CHANGE ORDERS, AND INFORMATION FURNISHED BY THE CONTRACTOR. THE INFORMATION SHOWN ON THE RECORD DRAWINGS IS PROVIDED BASED ON SURVEYING AT THE SITE AND INFORMATION PROVIDED BY THE CONTRACTOR OR OTHERS NOT ASSOCIATED WITH THE DESIGN ENGINEER. THE ORIGINAL SEALED DRAWING ARE ON FILE AT THE OFFICES OF WINKELMANN AND ASSOCIATES, INC.

WINKELMANN AND ASSOCIATES, INC.

10-19-2016 DATE

KROGER GRADING NOTES

3.9 IMPORTING OF OFF-SITE MATERIAL

"IMPORTING FILL MATERIAL FROM AN OFF-SITE LOCATION WITHOUT PRIOR WRITTEN APPROVAL FROM THE KROGER PROJECT MANAGER IS STRICTLY PROHIBITED. IDENTIFICATION OF OFF-SITE BORROW LOCATIONS AND MATERIAL MUST BE COORDINATED AND DOCUMENTED WITH THE SWPPP. A KROGER APPROVED TESTING FIRM MUST VERIFY THE SUITABILITY OF ALL OFF-SITE MATERIAL. THIS INCLUDES AN ANALYSIS TO INSURE THAT NO ENVIRONMENTAL CONTAMINATION IS PRESENT. IF ANY MATERIAL IS BROUGHT ON SITE WITHOUT PRIOR WRITTEN APPROVAL OF THE KROGER PROJECT MANAGER, THE CONTRACTOR WILL BEAR ALL COSTS ASSOCIATED WITH REMOVING THE MATERIAL, TESTING FOR CONTAMINATION, MONITORING THE CLEAN-UP OPERATION, DISPOSAL IN AN APPROVED LANDFILL, AND CERTIFYING THAT THE KROGER SITE IS ENVIRONMENTALLY CLEAN. IF REQUESTED, THE KROGER PROJECT MANAGER OR KROGER'S CONSULTANTS MUST BE GRANTED UNFETTERED ACCESS TO ANY AND ALL BORROW SITES"

3.10 KROGER BUILDING PAD

"THE KROGER APPROVED TESTING AGENCY AND PROJECT SURVEYOR MUST CERTIFY THE BUILDING PAD USING THE "PAD CERTIFICATION FORM", INCLUDED IN THE PROJECT SPECIFICATIONS, PRIOR TO THE COMMENCEMENT OF BUILDING FOUNDATIONS. COMPACTED BUILDING PAD(S) MUST EXTENDING A MINIMUM OF TEN (10) FEET BEYOND THE BUILDING FOOTPRINT, INCLUDING CANOPIES OR OTHER STRUCTURAL APPENDAGES, UNTIL THE PERIMETER FOUNDATIONS AND WALLS ARE CONSTRUCTED AND BACKFILLED. THE EXTENDED PORTION OF THE BUILDING PAD SUBGRADE MUST THEN BE REMOVED/REGRADED TO MEET THE FINAL GRADE AND MATERIAL REQUIREMENTS AROUND THE BUILDINGS' PERIMETER."

-WATER INJECTION IS NOT AN ACCEPTABLE METHOD OF MOISTURE CONDITION BENEATH THE SLAB.

-REFER TO PROJECT MANUAL, DIVISION 31, SECTION 31 25 00.


BENCH MARKS:

BM#1 - "X" cut inside of " \square " cut at the centerline of a curb inlet, southeasterly curb line of Quail Run, ± 23.6 feet northeast of the POINT OF BEGINNING.

ELEVATION - 482.71 feet

BM#2 - "X" cut at the southeast end of a curb inlet, northeasterly curb line of Memorial Drive, ± 13.4 feet southeast of the southeast property corner.

ELEVATION - 472.19 feet

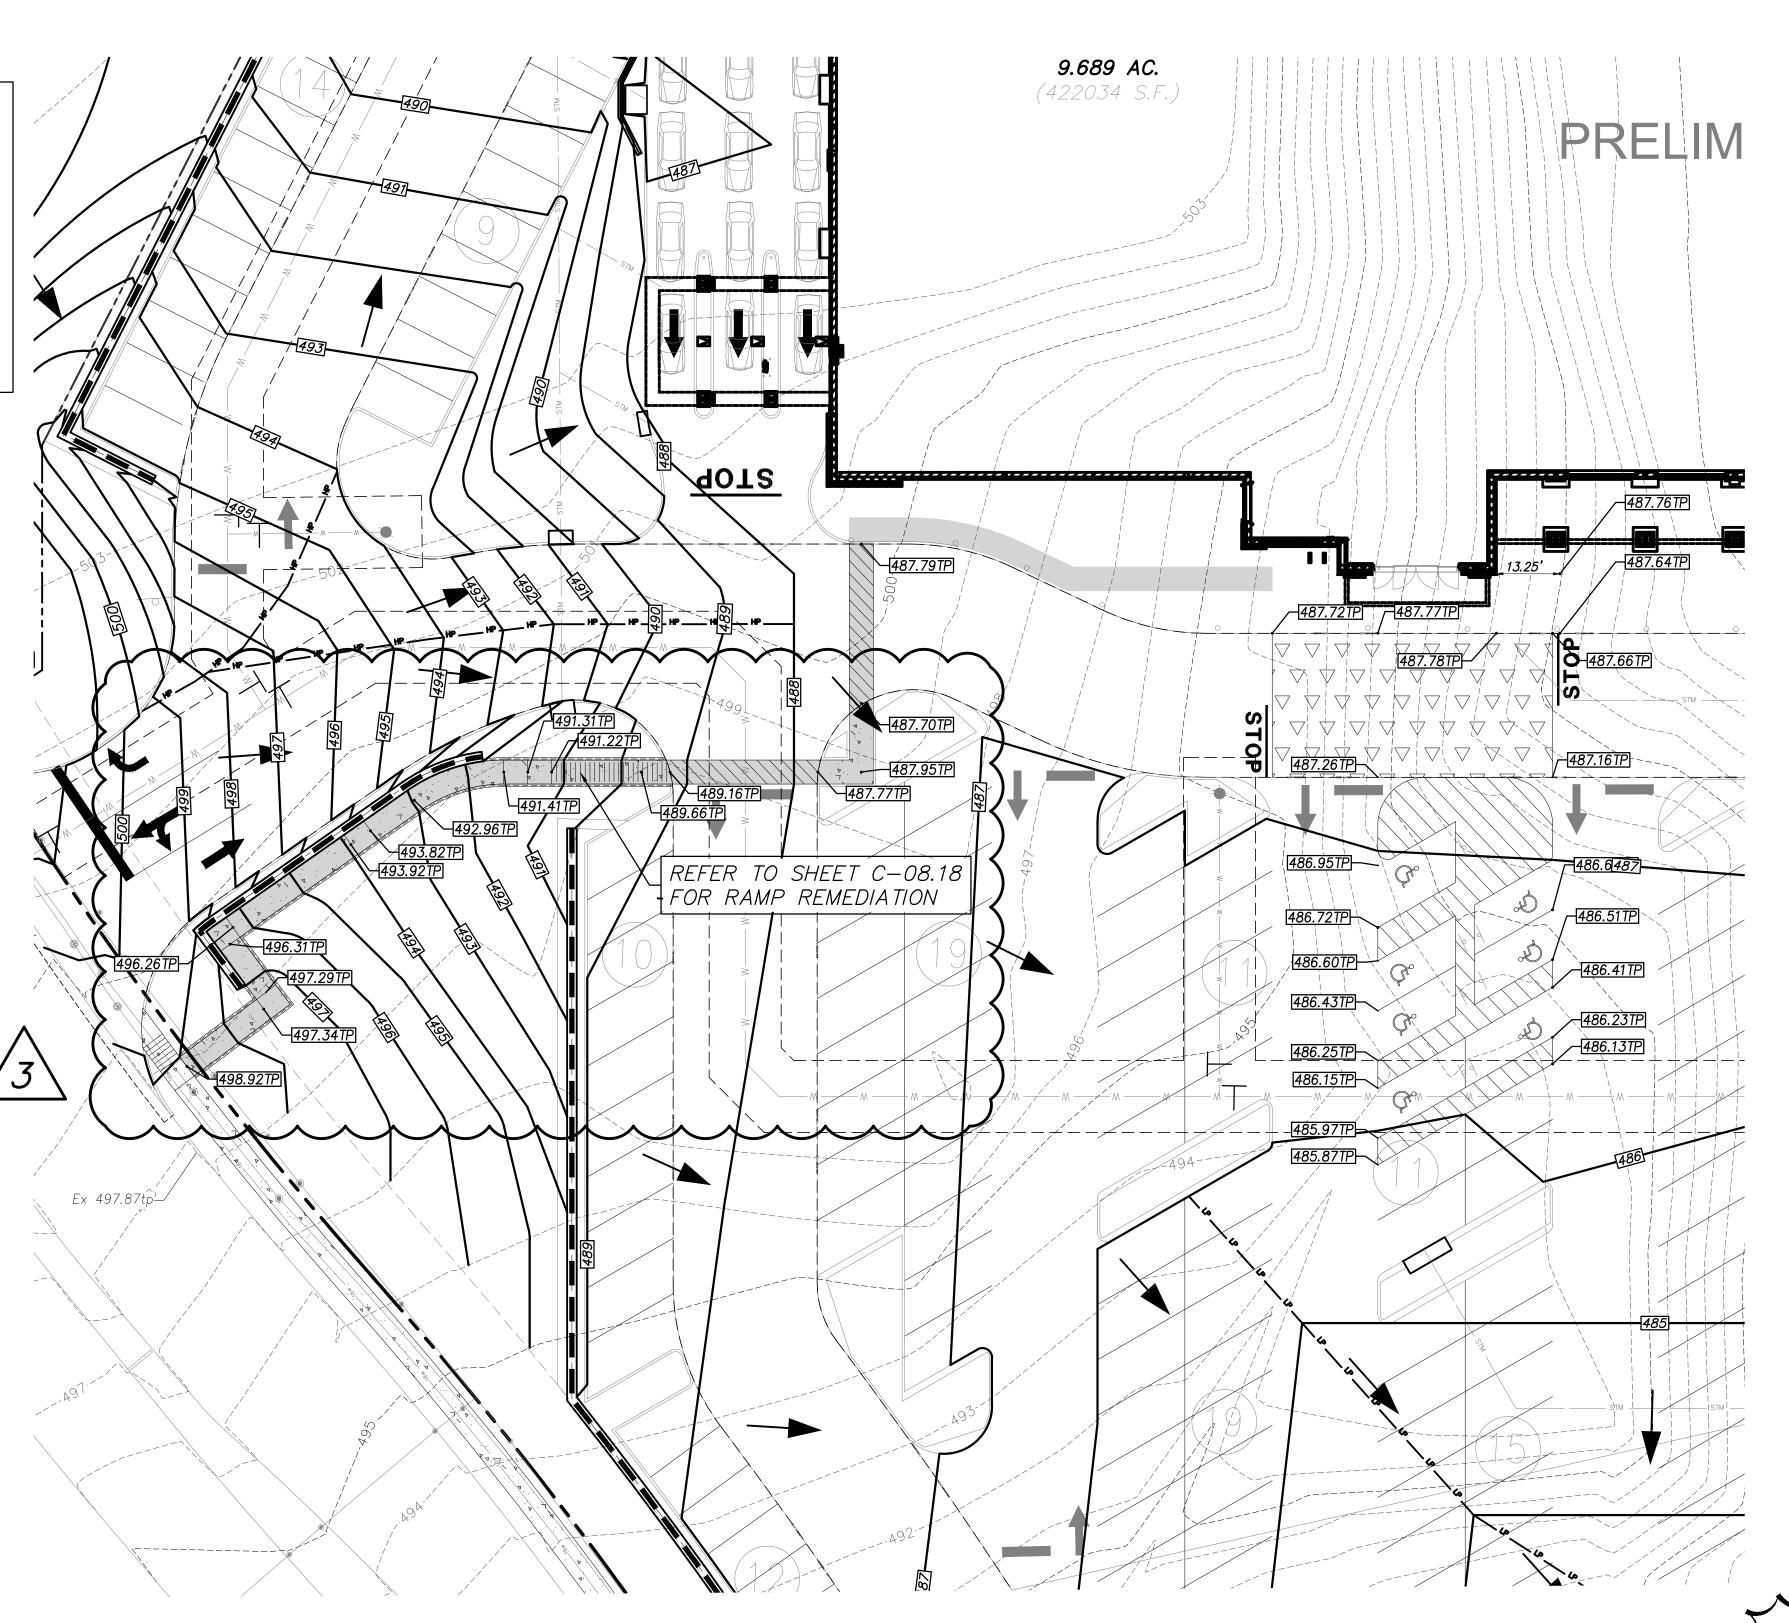

REFER TO BUILDING PLANS FOR PERMIT

ALL RESPONSIBILITY FOR ADEQUACY OF DESIGN REMAINS WITH THE DESIGN ENGINEER. THE CITY OF ROCKWALL, IN REVIEWING AND RELEASING PLANS FOR CONSTRUCTION, ASSUMES NO RESPONSIBILITY FOR ADEQUACY OR ACCURACY OF DESIGN.

LEGEND

CM | Control Monument


IRF | Iron Rod Found PP | Power Pole GW | Guy Wire IRS | Iron Rod Set CIRS Iron Rod Set w/ cap "WAI"
CIRF Iron Rod Found w/ cap
IXCS "X" Cut in Concrete Set
XCF "X" Cut in Concrete Found
PKS PK Nail Set
PKF PK Nail Found
SS Sanitary Sewer MH Manhole WV | Water Valve TP | Telephone Pedestal WM | Water Meter FH Fire Hydrant LP | Light Pole IV | Irrigation Valve Storm Sewer CO Clean Out
AC Air Conditioner
TV Cable Box Transformer pad GM | Gas Meter GMK Gas Marker TSN Traffic Sign UGC Underground Cable Marker EB Electric Box SB Signal Box SP Signal Pole SN Sign

EM | Electric Meter

EXISTING UNDERGROUND/BURIED PUBLIC, PRIVATE, AND FRANCHISE UTILITIES/FACILITIES AFFECT THIS SITE, AND ARE DEPICTED ON THE PLANS PER THE BEST AVAILABLE INFORMATION AT THE TIME THE PLANS WERE PRODUCED. WINKELMANN & ASSOC., INC. SHALL NOT BE RESPONSIBLE FOR KNOWING THE EXACT LOCATION OF ALL FACILITIES OR DEPICTING EXACT LOCATIONS OF SAID FACILITIES ON THE PLANS BEYOND WHAT IS STATED ABOVE.

TO BEGINNING WORK ON THE SITE, AND SHALL NOT BEGIN ANY EXCAVATION OR DEMOLITION ACTIVITES UNTIL AFTER SAID FACILITIES HAVE BEEN MARKED AND/OR FLAGGED PER "811" OR THE FACILITY

CONTRACTOR(S) SHALL BE WHOLLY RESPONSIBLE FOR ANY DAMAGE THAT MAY OCCUR TO SAID FACILITIES DUE TO WORK BEING DONE

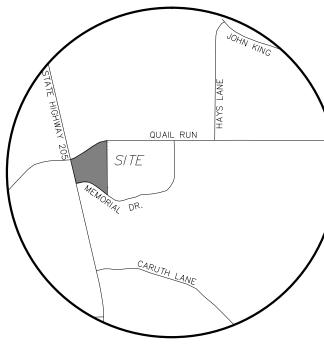

VICINITY MAP NOT TO SCALE



SCALE: 1" = 20'

LEGEND



GRADING LEGEND

- - - 493 - - EXISTING CONTOURS 488 PROP. CONTOURS

RETAINING WALL *y* 475.50tc Ex. Spot Grade

470.50TC PROP. TOP OF CURB 470.00TP PROP. TOP OF PAVEMENT PROP. TOP OF CURB 470.00G | PROP. FINISHED GRADE

── FLOW ARROW

NOTICES TO CONTRACTOR

CONTRACTOR(S) SHALL CALL "811" A MINIMUM OF 48 HOURS PRIOR

WITHOUT FOLLOWING THE PROCEDURES ABOVE.

C - 08.05DAL574

*

MARIA C. BONILLA-NICHOLLS

ONAL ENGINEER

10-19-2016

THE SEAL APPEARING ON THIS DOCUMENT WAS AUTHORIZED B MARIA C. BONILLA-NICHOLLS

P.E. # 100106

Q

AND

709

ROCI

CESSIBILI

Ö

100106 CENSE ::