


VICINITY MAP NOT TO SCALE



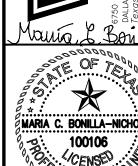

100106 CENSED CONAL ENGINEERS 10-19-2016 THE SEAL APPEARING ON THIS DOCUMENT WAS AUTHORIZED BY MARIA C. BONILLA—NICHOLLS P.E. # 100106

QUAIL NOIT SE

AND T. A RD. TE. GOLIAD ST RUN H ROCKWALL,

SE

CROSS DRIVE

NOR

NOTICES TO CONTRACTOR

EXISTING UNDERGROUND/BURIED PUBLIC, PRIVATE, AND FRANCHISE UTILITIES/FACILITIES AFFECT THIS SITE, AND ARE DEPICTED ON THE PLANS PER THE BEST AVAILABLE INFORMATION AT THE TIME THE PLANS WERE PRODUCED. WINKELMANN & ASSOC., INC. SHALL NOT BE RESPONSIBLE FOR KNOWING THE EXACT LOCATION OF ALL FACILITIES OR DEPICTING EXACT LOCATIONS OF SAID FACILITIES ON THE PLANS BEYOND WHAT IS STATED ABOVE.

BENCH MARKS:

CONTRACTOR(S) SHALL CALL "811" A MINIMUM OF 48 HOURS PRIOR TO BEGINNING WORK ON THE SITE, AND SHALL NOT BEGIN ANY EXCAVATION OR DEMOLITION ACTIVITES UNTIL AFTER SAID FACILITIES HAVE BEEN MARKED AND/OR FLAGGED PER "811" OR THE FACILITY

CONTRACTOR(S) SHALL BE WHOLLY RESPONSIBLE FOR ANY DAMAGE THAT MAY OCCUR TO SAID FACILITIES DUE TO WORK BEING DONE WITHOUT FOLLOWING THE PROCEDURES ABOVE.

SEALED ENGINEERING DRAWING FOR THIS PROJECT; MODIFIED BY ADDENDA, CHANGE ORDERS, AND INFORMATION FURNISHED BY THE CONTRACTOR. THE INFORMATION SHOWN ON THE RECORD DRAWINGS IS PROVIDED BASED ON SURVEYING AT THE SITE AND INFORMATION PROVIDED BY THE CONTRACTOR OR OTHERS NOT ASSOCIATED WITH THE DESIGN ENGINEER. THE ORIGINAL SEALED DRAWING ARE ON FILE AT THE OFFICES

AS-BUILT

THIS RECORD DRAWING IS COMPILATION OF A COPY OF THE

OF WINKELMANN AND ASSOCIATES, INC. Maria L. Boulla 10-19-2016 WINKELMANN AND ASSOCIATES, INC. DATE

DAL574

FOR CONSTRUCTION, ASSUMES NO RESPONSIBILITY FOR ADEQUACY OR ACCURACY OF DESIGN. LEGEND

PP | Power Pole

GW | Guy Wire

MH | Mánhole

ALL RESPONSIBILITY FOR ADEQUACY OF DESIGN REMAINS WITH THE DESIGN ENGINEER. THE CITY OF ROCKWALL, IN REVIEWING AND RELEASING PLANS

> IRF Iron Rod Found
> IRS Iron Rod Set IRS Iron Rod Set
> CIRS Iron Rod Set w/ cap "WAI"
> CIRF Iron Rod Found w/ cap
> IXCS "X" Cut in Concrete Set
> XCF "X" Cut in Concrete Found
> PKS PK Nail Set
> PKF PK Nail Found
> SS Sanitary Sewer
> SW Storm Sewer
> TF Transformer pad
> GM Gas Meter

WV | Water Valve TP | Telephone Pedestal WM Water Meter FH| Fire Hydrant LP Light Pole IV Irrigation Valve CO Clean Out

AC | Air Conditioner GM | Gas Meter GM Gas meter
GMK Gas Marker
TSN Traffic Sign
UGC Underground Cable Marker
EB Electric Box
EM Electric Meter TV | Cable Box

SB Signal Box
SP Signal Pole
SN Sign
CM Control Monument