

## HYDROMULCH NOTES

- All lawn areas to be Hydromulch Bermudgrass, unless noted otherwise on drawings.
- Contractor shall scarify, rip, loosen all areas to be hydromulched to a minimum depth of 4" prior to topsoil and hydromulch installation.
- Bermudagrass seed shall be extra hulled and treated lawn type and shall be delivered to the site in its original unopened container, and shall meet Texas State Law requirements.
- Fiber: Shall be one hundred (100%) percent Wood Cellulose Fiber, delivered to the site in its original unopened container. 'Conweb' or organia.
- Fiber Tack: Shall be delivered to the site in its original unopened container, and shall be 'Terro-Tack one', as manufactured by Growers, Inc., or equal.
- Hydromulch with Bermudagrass seed at a rate of two (2) pounds per one thousand (1000) square foot.
- 7. Use a 4'x8' batter board against all beds areas.
- If installation occurs between September 1 and April 1, all
  hydromulch areas to be Winter Ryegrass, at a rate of four (4) pounds
  per one thousand (1000) square feet. Contractor shall be required to
  re-hydromulch with Bermudagrass the following growing season.
- All lawn areas to be hydromulched, shall have one hundred (100 %)
  9. percent coverage prior to final acceptance.
- Contractor shall maintain all lawn areas until final acceptance. This

  10. shall include but not be limited to: mowing, watering, weeding, cultivating, cleaning, and replacing dead or bare areas to keep plants in a vigorous, healthy condition.
- Contractor shall guarantee establishment of an acceptable turf area 11. and shall provide replacement from local supply as necessary.

## **GENERAL LAWN NOTES**

- 1. Fine grade areas to achieve final contours indicated.
- Adjust contours to achieve positive drainage away from buildings.
   Provide uniform rounding at top and bottom of slopes and other
   breaks in grade. Correct irregularities and areas where water may
   stand.
- All lawn areas to receive solid sod shall be left in a maximum of 1" below final finish grade. Contractor to coordinate operations with on-site Construction Manager.
- Contractor shall provide (2") two inches of imported topsoil on all areas to receive lawn. ADD ALTERNATE
- Imported topsoil shall be natural, friable soil from the region, known as bottom land soil, free from lumps, clay, toxic substances, roots, debris, vegetation, stones, containing no salt and black to brown in color.
- All lawn areas to be fine graded, irrigation trenches completely settled, and finish grade approved by the Architect prior to installation.

## PLANT LEGEND


PLANT TYPE

SYMBOL PLANT TYPE

B.C. Baid Cypress
C.E. Cedar Elm
W.M. Wax Myrtle 'Tree Form'
D.W.M. Dwarf Wax Myrtle
L.C. Leyland Cypress


W.M.S. Wax Myrtle Shrub
WM Wax Myrtle
CM Crepe Myrtle 'Red

IH Indian Hawthorne 'Cli
LIR Liriope 'Big Blue'

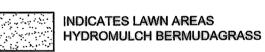

No trees to be planted within 5' of any utitlities

Provide 2' overhang for all parking areas abutting landscape edge and or screening hedge.

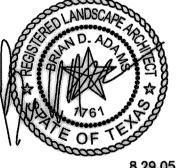

8.29 **nr** 

0 20 40 80

landscape architects, inc.
1708 N. Griffin Street
Dallas, Texas 75202
Tel 214.871.0083
Fax 214.871.0545
Email smr@smr-la.com

