
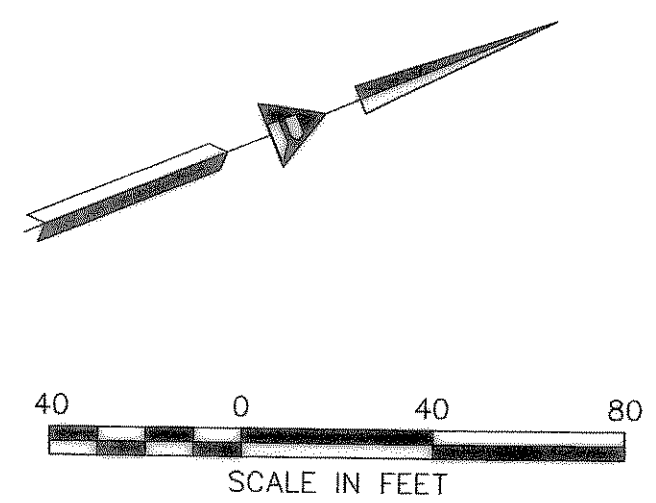


10c - spell check

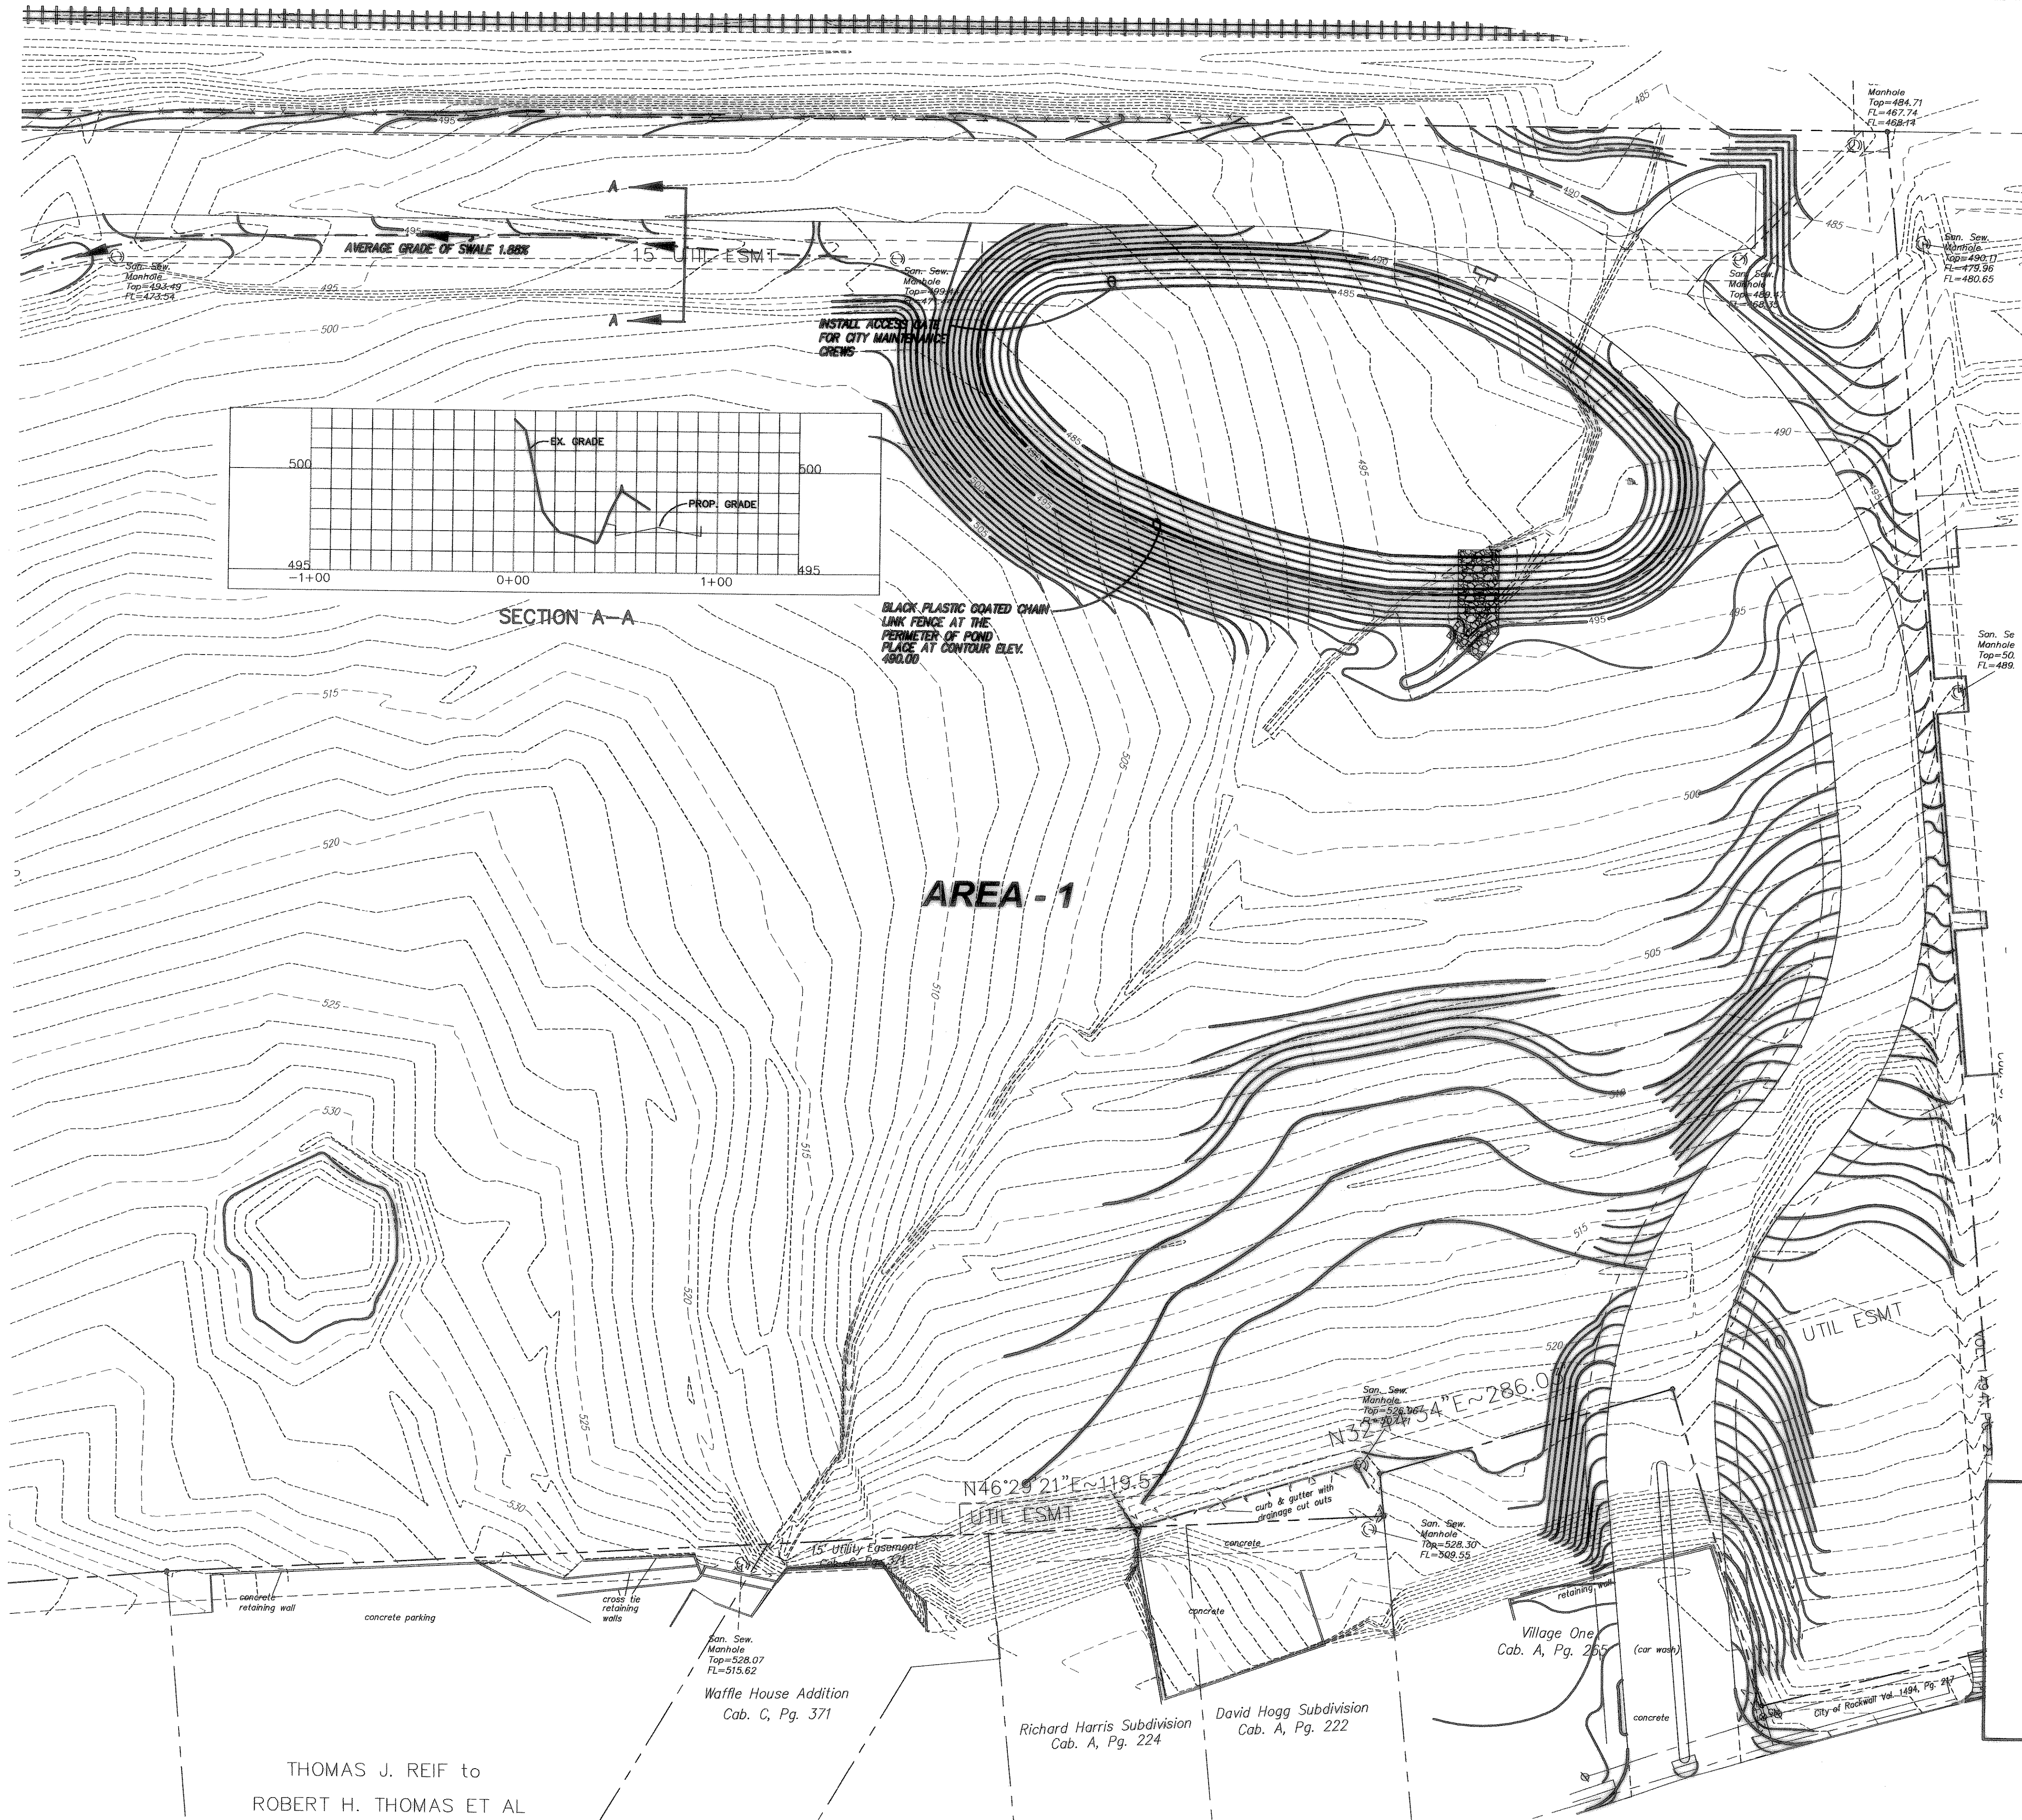


EXISTING TREE TO REMOVE

NOTE:
ALL FILL SHALL BE COMPACTED
W/ SHEEPSFOOT ROLLER TO
95% STD. PROCTOR MIN.

NOTE:
SEE TREE MITIGATION PLAN FOR
PROTECTED TREES AND TREE
REMOVAL CLARIFICATION

RECORD DRAWINGS
AS PROVIDED BY:
I.C.S. COMMERCIAL
Michael S. Allen
MICHAEL S. ALLEN, P.E.
DATE: 9/25/03

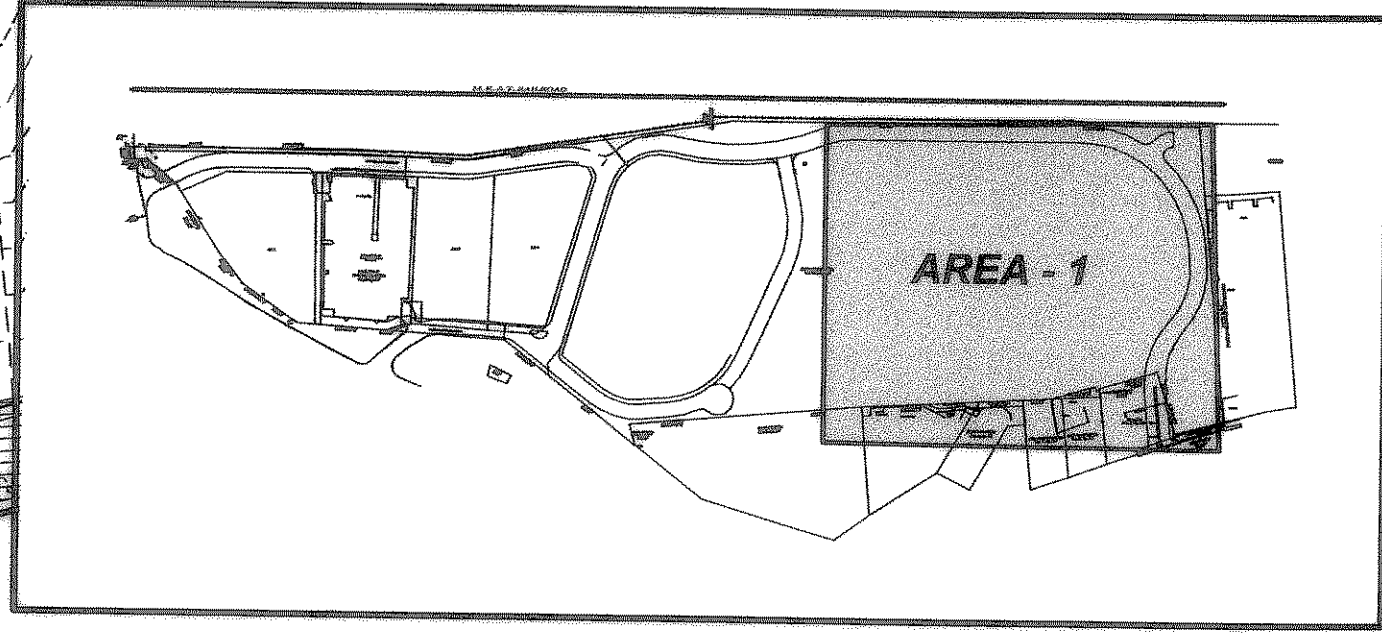

VICINITY MAP
N.T.S.

THOMAS J. REIF to
ROBERT H. THOMAS ET AL

No.	Date	Revisions	App.

Allen & Ridinger Consulting, Inc.
109 W. Main Street
Lewisville, Texas 75057
Tel. No. (972) 353-8000
Fax No. (972) 353-8011

STATE OF TEXAS
MICHAEL S. ALLEN
86188
LICENSED PROFESSIONAL ENGINEER
Michael S. Allen
9/25/03

La Jolla Pointe Addition
ROCKWALL, TEXAS

GRADING PLAN

Scale: 1"=40' HOR., 1"=4' VERT.
Designed by: MSA
Drawn by: MSA
Checked by: MSA
Date: April 1, 2003
Project No. 018-001

SHEET
C-11
OF **25**